

**Notes:**


- Data were collected by APTIM on the following dates:  
 October 29 through November 1, 2019  
 November 18 through November 21, 2019  
 December 17 through December 19, 2019  
 March 23 through March 27, 2020
- Dashed lines represent interpreted subsurface pipelines and were not surveyed in the field.
- Elevations are in feet NAVD88.
- Background imagery is ESRI's World Imagery basemap.

**Legend:**

**Stormwater Survey**

- ▲ Outfall
- ▲ Outfall with Backflow
- Culvert
- Inlet
- Ⓟ Pump

- ⊕ Manhole
- Pipe with Lid
- ⊕ Top of Path
- ◇ Weir
- Ditch
- - - Unverified Subsurface Pipelines
- Wall with Backflow
- Weir
- Retention Pond
- Mangrove Habitat (FWCC)

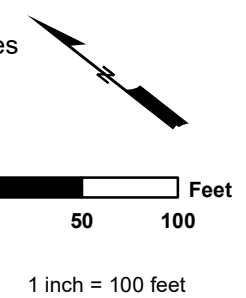

TITLE: **Longboat Key Stormwater Atlas Aerial Map**

**APTIM**  
**Environmental & Infrastructure, LLC.**  
 2481 N. W. Boca Raton Boulevard  
 Boca Raton, FL 33431  
 Ph. (561) 391-8102  
 Fax (561) 391-9116  
 COA#9317

Date: April 2020 | By: HMV | Comm No. : 631005068 | **Figure 1**

E:\631005068\Mxd\Final Maps\Figure\_1.mxd