


**Notes:**

- Data were collected by APTIM on the following dates:  
 October 29 through November 1, 2019  
 November 18 through November 21, 2019  
 December 17 through December 19, 2019  
 March 23 through March 27, 2020
- Dashed lines represent interpreted subsurface pipelines and were not surveyed in the field.
- Elevations are in feet NAVD88.
- Background imagery is ESRI's World Imagery basemap.

**Legend:**


**Stormwater Survey**

- ▲ Outfall
- ▲ (green) Outfall with Backflow
- (blue) Culvert
- (blue) Inlet
- Ⓟ Pump
- ⬡ (grey) Manhole
- (green) Pipe with Lid
- ⊕ Top of Path
- ◇ (yellow) Weir
- (dashed orange) Ditch
- (dashed blue) Unverified Subsurface Pipelines
- (solid orange) Wall with Backflow
- (solid blue) Weir
- (light blue) Retention Pond
- (green with cross-hatch) Mangrove Habitat (FWCC)

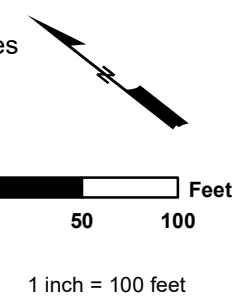

TITLE:

## Longboat Key Stormwater Atlas Aerial Map



**APTIM**  
**Environmental & Infrastructure, LLC.**  
 2481 N. W. Boca Raton Boulevard  
 Boca Raton, FL 33431  
 Ph. (561) 391-8102  
 Fax (561) 391-9116  
 COA#9317

Date: April 2020 | By: HMV | Comm No. : 631005068 | **Figure 3**

E:\631005068\Mxd\Final Maps\Figure\_3.mxd