

Matchline Figure 2

Matchline Figure 8

Notes:

- Data were collected by APTIM on the following dates:
 October 29 through November 1, 2019
 November 18 through November 21, 2019
 December 17 through December 19, 2019
 March 23 through March 27, 2020
- Dashed lines represent interpreted subsurface pipelines and were not surveyed in the field.
- Elevations are in feet NAVD88.
- Background imagery is ESRI's World Imagery basemap.


Legend:

Stormwater Survey

- Outfall
- Outfall with Backflow
- Culvert
- Inlet
- Pump

- Manhole
- Pipe with Lid
- Top of Path
- Weir

- Ditch
- Unverified Subsurface Pipelines
- Wall with Backflow
- Weir
- Retention Pond
- Mangrove Habitat (FWCC)

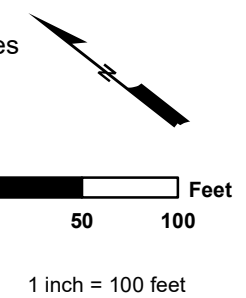

TITLE: **Longboat Key Stormwater Atlas Aerial Map**

APTIM
Environmental & Infrastructure, LLC.
 2481 N. W. Boca Raton Boulevard
 Boca Raton, FL 33431
 Ph. (561) 391-8102
 Fax (561) 391-9116
 COA#9317

Date: April 2020 | By: HMV | Comm No. : 631005068 | **Figure 5**

E:\631005068\Mxd\Final Maps\Figure_5.mxd