

AS-BUILT SURVEY FOR TOWNWIDE
OVERHEAD UTILITY UNDERGROUNDING
PHASE 1 - LONG BOAT KEY
THE MAP AND REPORT ARE NOT FULL AND
COMPLETE WITHOUT THE OTHER.

END GULF OF MEXICO DRIVE
145+54.89

ALIGNMENT: GULF OF MEXICO DRIVE:
START=0+00 N=1091127.539' E=466628.902'
BEARING=N 38° 01' 10" W DISTANCE=299.29'
PC=2+99.29 N=1091363.319' E=466744.562'
CENTRAL ANGLE=29° 09' 00" LEFT
RADIUS=1105.92'
LENGTH=562.65' TANGENT= 287.555'
CHORD DISTANCE= 556.60' COURSE= N 52° 35' 40" W
PT= 8+61.94 N=1091701.430' E=466362.422'
BEARING=N 67° 10' 10" W DISTANCE: 3581.55'
PC= 44+43.49 N=1093091.103' E=463001.462'
CENTRAL ANGLE=24° 08' 58" RIGHT
RADIUS=3437.75'
LENGTH=1448.97' TANGENT=735.405'
CHORD DISTANCE=1438.27' CHORD BEARING= N 55° 05' 41" W
PT=58+92.46 N=1093914.114' E=461821.941'
BEARING= N 43° 01' 12" W DISTANCE=2030.10'
PT=79+22.567 N=1095398.357' E=460436.900'
BEARING= N 43° 28' 38" W DISTANCE=842.40'
PI=87+64.97 N=1096009.642' E=459857.273'
BEARING= N 44° 09' 12" W DISTANCE=5789.92'
END=145+54.89 N=1100163.793' E=455824.135'

ALIGNMENT: CHANNEL LANE
START=160+00.00 N=1092580.290' E=464214.822'
BEARING=N 22° 47' 23" E DISTANCE=560.25'
END=165+60.25 N=1093096.799' E=464431.833'

ALIGNMENT: SLOOP LANE
START=170+00.00 N=1092725.072' E=463870.915'
BEARING= N 22° 48' 34" E DISTANCE=617.62'
END= 176+17.62 N=1093294.392' E=464110.344'

ALIGNMENT: KETCH LANE
START=180+00.00 N=1092863.203' E=463542.805'
BEARING= N 22° 48' 34" E DISTANCE=652.94'
END= 186+52.94 N=1093465.060' E=463795.926'

ALIGNMENT: SCHOONER LANE
START=190+00.00 N=1093005.602' E=463204.557'
BEARING= N 22° 48' 34" E DISTANCE=777.80'
END= 197+77.80 N=1093722.578' E=463506.083'

ALIGNMENT: YAWL
START=200+00.00 N=1093151.793' E=462865.603'
BEARING= N 22° 48' 34" E DISTANCE=926.48'
END= 209+26.482 N=1094005.824' E=463224.767'


ALIGNMENT: CUTTER LANE
START=210+00.00 N=1093328.470' E=462538.943'
BEARING= N 22° 48' 34" E DISTANCE=976.89'
END= 219+76.89 N=1094228.966' E=462917.649'

ALIGNMENT: OUTRIGGER LANE
START=220+00.00 N=1093562.010' E=462204.251'
BEARING= N 25° 27' 43" E DISTANCE=864.57'
END= 228+64.57 N=1094342.606' E=462575.940'

ALIGNMENT: GUNWALE LANE
START=230+00.00 N=1093841.869' E=461891.355'
BEARING= N 30° 46' 07" E DISTANCE=800.93'
END= 238+00.93 N=1094530.063' E=462301.089'

ALIGNMENT: HORNBLOWER LANE
START=240+00.00 N=1094140.573' E=461610.616'
BEARING= N 36° 03' 47" E DISTANCE=812.50'
END= 248+12.50 N=1094797.377' E=462088.916'

ALIGNMENT: SPINNAKER LANE
START=250+00.00 N=1094430.095' E=461340.446'
BEARING= N 41° 22' 26" E DISTANCE=903.89'
END= 258+03.89 N=1095033.342' E=461871.792'

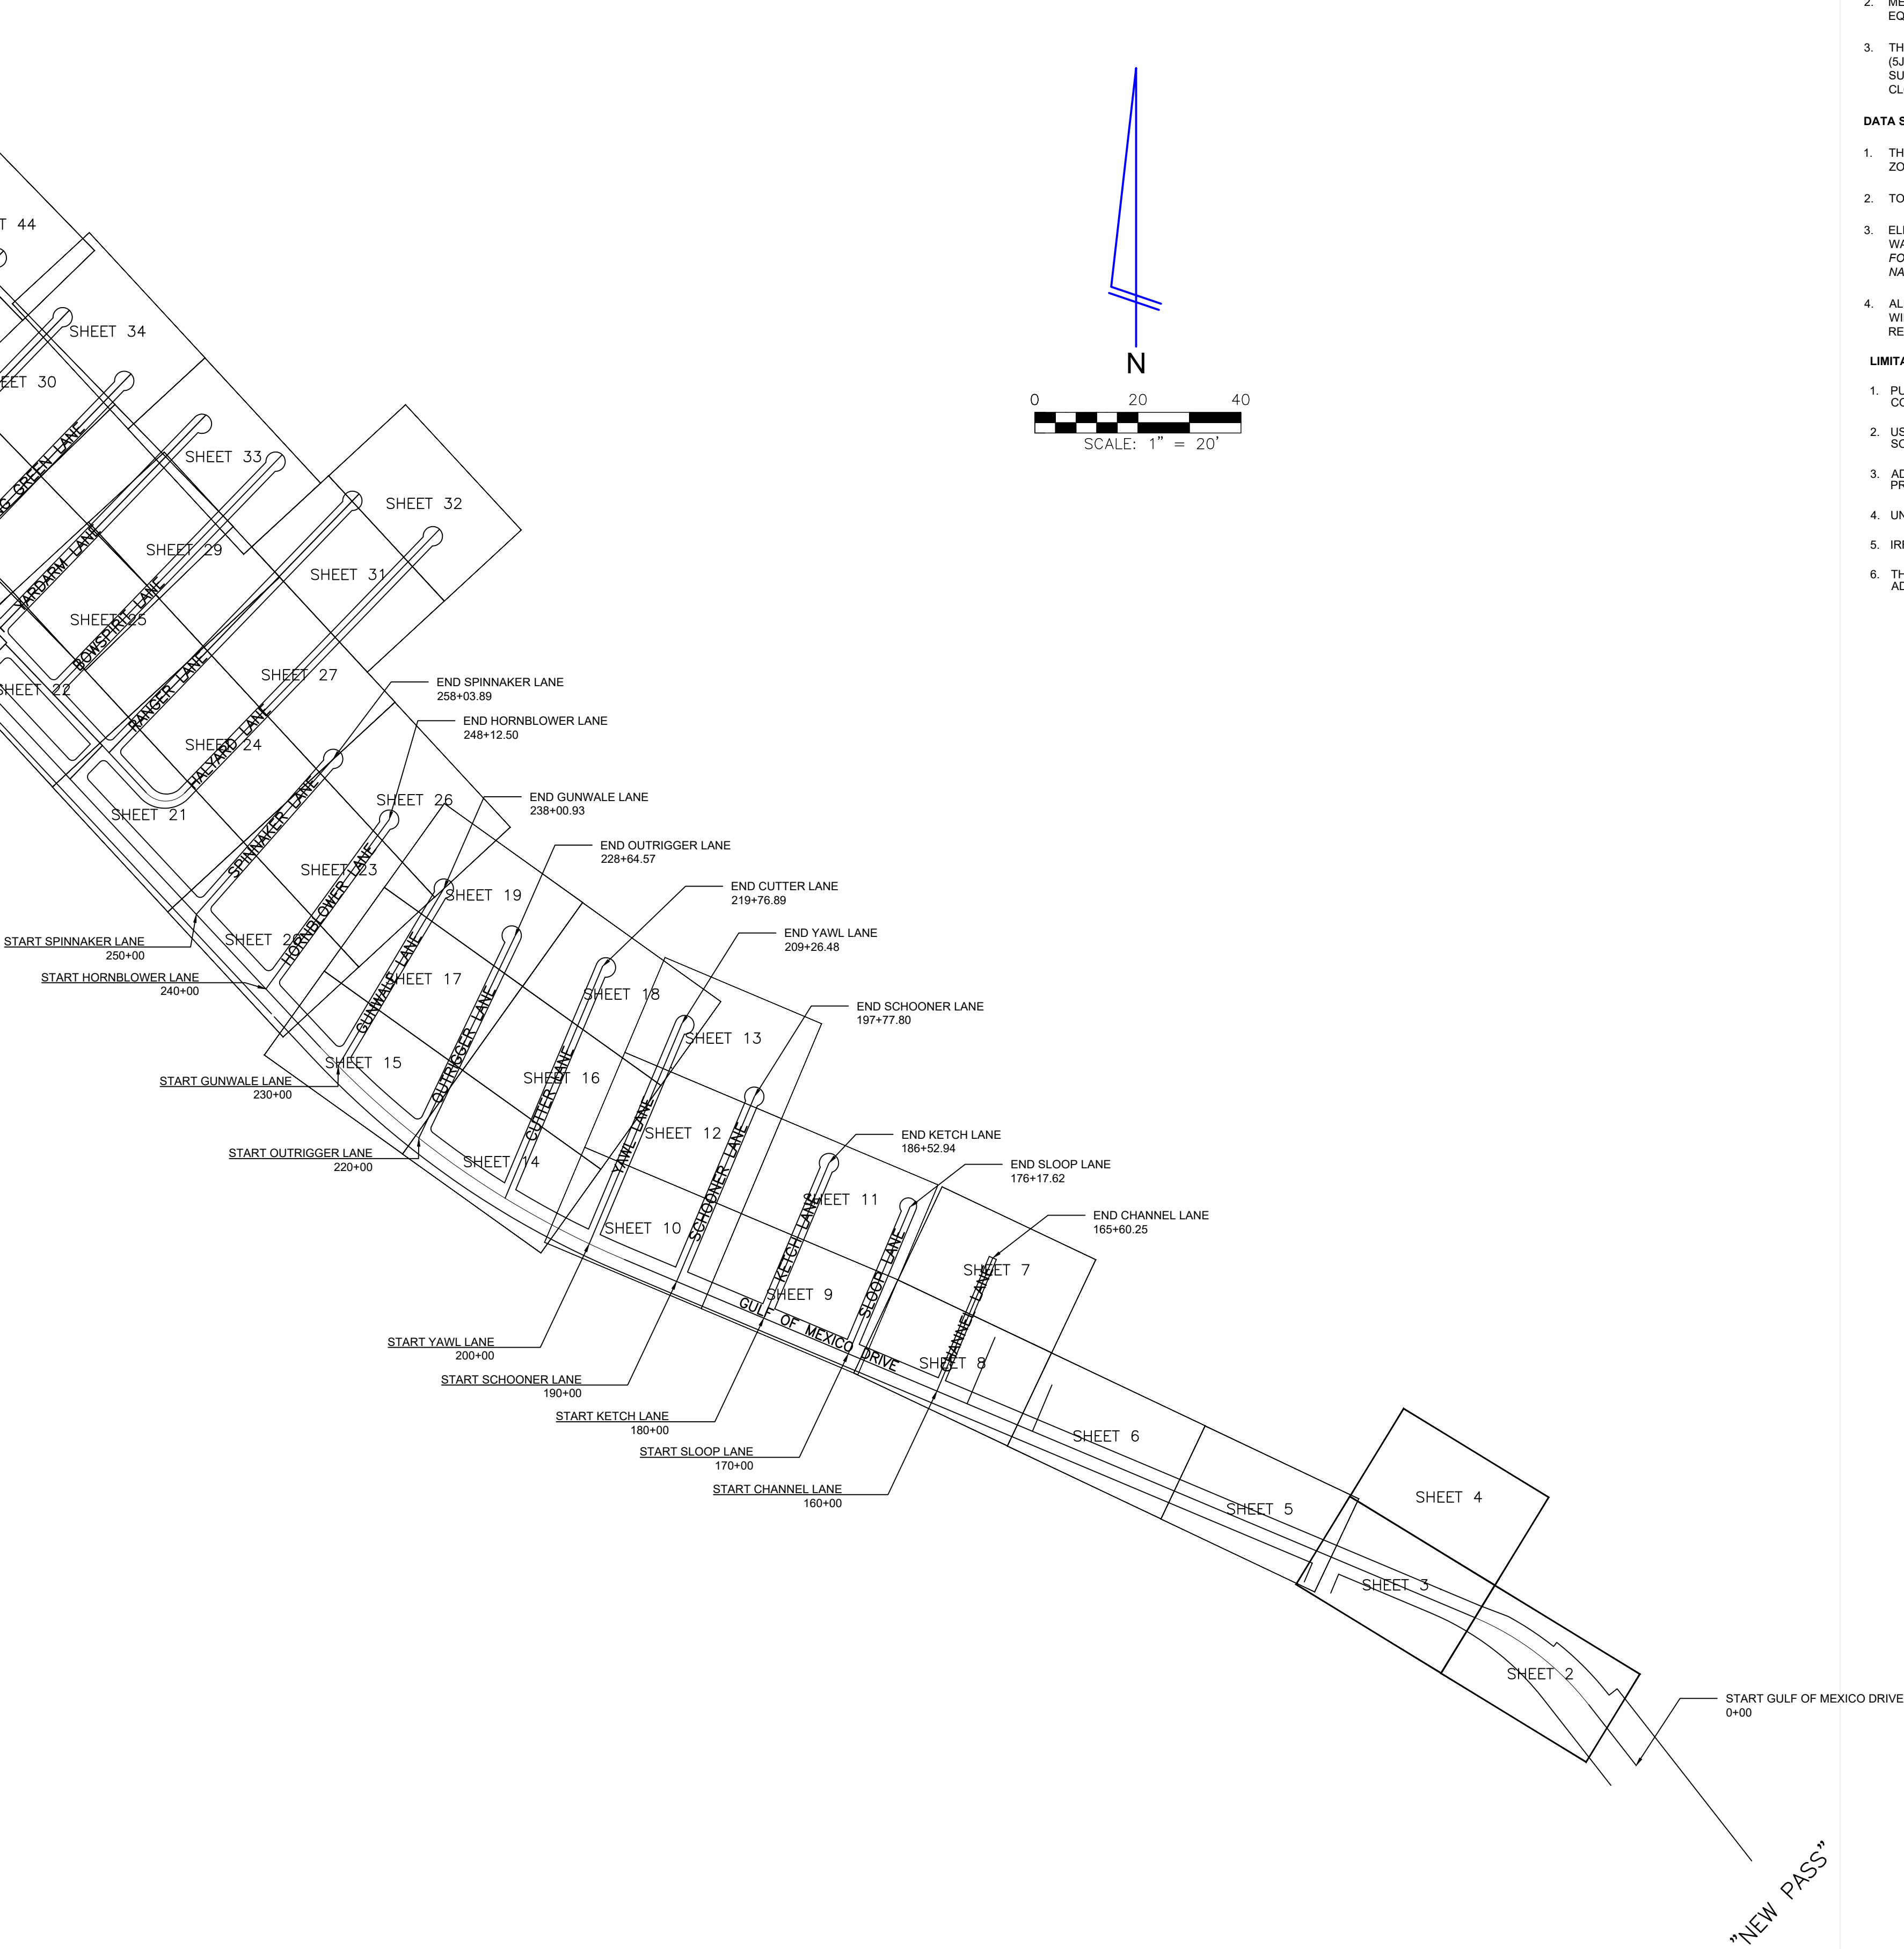

SURVEYOR'S REPORT

ACCURACY:

- ALL MEASUREMENTS, DISTANCES, ELEVATIONS (IF SHOWN) AND FEATURES WERE PERFORMED IN STRICT ACCORDANCE WITH THE MINIMUM STANDARDS OF PRACTICE SET FORTH IN CHAPTER 5J-17 FLORIDA ADMINISTRATIVE CODE (5J-17FAC).
- METHODS FOR ALL CONTROL MEASUREMENTS WERE MADE WITH A TRANSIT AND STEEL TAPE, OR DEVICES WITH EQUIVALENT OR HIGHER DEGREES OF ACCURACY.
- THE ACCURACY STANDARD USED FOR THIS SURVEY, AS CLASSIFIED IN THE MINIMUM STANDARDS OF PRACTICE (5J-17 FAC), IS "COMMERCIAL/HIGH RISK". THE MINIMUM RELATIVE DISTANCE ACCURACY FOR THIS TYPE OF SURVEY IS 1 FOOT IN 10,000 FEET. THE ACCURACY OBTAINED BY MEASUREMENT AND CALCULATION OF A CLOSED GEOMETRIC FIGURE MET THIS REQUIREMENT.

DATA SOURCES:

- THIS SURVEY IS REFERENCED TO A PROJECTION OF THE STATE PLANE COORDINATE SYSTEM OF FLORIDA WEST ZONE (NAD 1983/2011 ADJUSTMENT).
- TOPOGRAPHIC SURVEY BY HYATT SURVEY SERVICES, PROJECT 16-2040, DATE 01/2017.
- ELEVATIONS BASED ON LOCALIZATION OF CONTROL POINTS FROM DATA SOURCE 2, WHOSE ELEVATION DATUM WAS NOTED AS SUCH. THE FOLLOWING NOS VERTICAL CONTROL POINTS WERE RECOVERED AND UTILIZED FOR THE ELEVATIONS INDICATED HEREIN: "GIS 086" NAVD 88 EL 5.04' "Z 689" NAVD 88 ELEVATION 6.47' "Y 689" NAVD 88 ELEVATION 3.90'."
- ALL LOCATIONS AND DEPTHS FOR THE UNDERGROUND UTILITIES WERE PROVIDED BY THE CONTRACTOR AND WILCO UNDERGROUND UTILITY CONTRACTORS AND TRANPOSED ONTO THIS DRAWING TO SERVE AS THE RECORD DRAWINGS.

LIMITATIONS:


- PURPOSE OF SURVEY: TO DOCUMENT HORIZONTAL AND/OR VERTICAL DIMENSIONAL DATA SO THAT CONSTRUCTED IMPROVEMENTS MAY BE LOCATED AND DELINEATED.
- USE OF THIS SURVEY BY ANYONE OTHER THAN THOSE PREPARED FOR / CERTIFIED TO, WILL BE THE RE-USERS SOLE RISK WITHOUT LIABILITY TO THE SURVEYOR.
- ADDITIONS OR DELETIONS TO SURVEY MAPS OR REPORTS BY OTHER THAN THE SIGNING PARTY OR PARTIES IS PROHIBITED WITHOUT WRITTEN CONSENT OF THE SIGNING PARTY OR PARTIES.
- UNDERGROUND FOUNDATIONS AND THEIR LOCATIONS HAVE NOT BEEN DETERMINED.
- IRRIGATION EQUIPMENT AND / OR THEIR APPURTENANCES HAVE NOT BEEN MAPPED.
- THIS SURVEY PERFORMED WITHOUT THE BENEFIT OF A COMMITMENT FOR TITLE INSURANCE. THERE MAY EXIST ADDITIONAL EASEMENTS AND/OR RESTRICTIONS THAT CAN BE FOUND IN THE PUBLIC RECORDS OF THIS COUNTY.

TITLE: AS-BUILT SURVEY "LONGBOAT KEY UNDERGROUND" (PHASE 1 SOUTH)

LOCATION: SECTIONS 16, 21 & 22, TOWNSHIP 36 SOUTH, RANGE 17 EAST, SARASOTA COUNTY, FLORIDA

THIS SURVEY IS NOT VALID WITHOUT THE SIGNATURE AND ORIGINAL RAISED SEAL OF A FLORIDA LICENSED SURVEYOR AND MAPPER.

GEORGE R. MARTIN, P.S.M.
FLORIDA SURVEYORS REGISTRATION NO. 6019

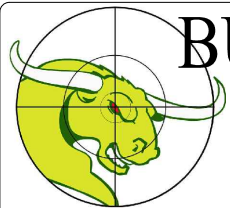

BULLSEYE SURVEYING, INC.

LB 7818
2198 NE COACHMAN ROAD, UNIT F, CLEARWATER, FL 33765
Phone: (727) 475-8088

FILE: 19-040-AS-BUILTS
PROJECT NUMBER: 19-040

Drawn By: GRM/AMW
Date: 10/26/2020

Scale: 1" = 400'

SHEET


1

OF 45

NEW PASS PARK A PARCEL OF LAND
LYING IN THE S 1/2 OF SEC 22-36-1
7 NLY OF GULF OF MEXICO DR DESC
IN OR 1828/18 & 1828/21 & BEG SW
DEED: O.R.B. 1828/0018, S.C.P.R.
PID: 0012-05-0001
ADDRESS: 280 GULF OF MEXICO DR




THE CHART HOUSE RESTAURANT
PARCEL C-2 CONTAINING 3 AC M/L
LONGBOAT KEY CLUB UNIT 4
DEED: O.R.B. 1947/2225, S.C.P.R.
PID: 0012-11-0004
ADDRESS: 201 GULF OF MEXICO DR

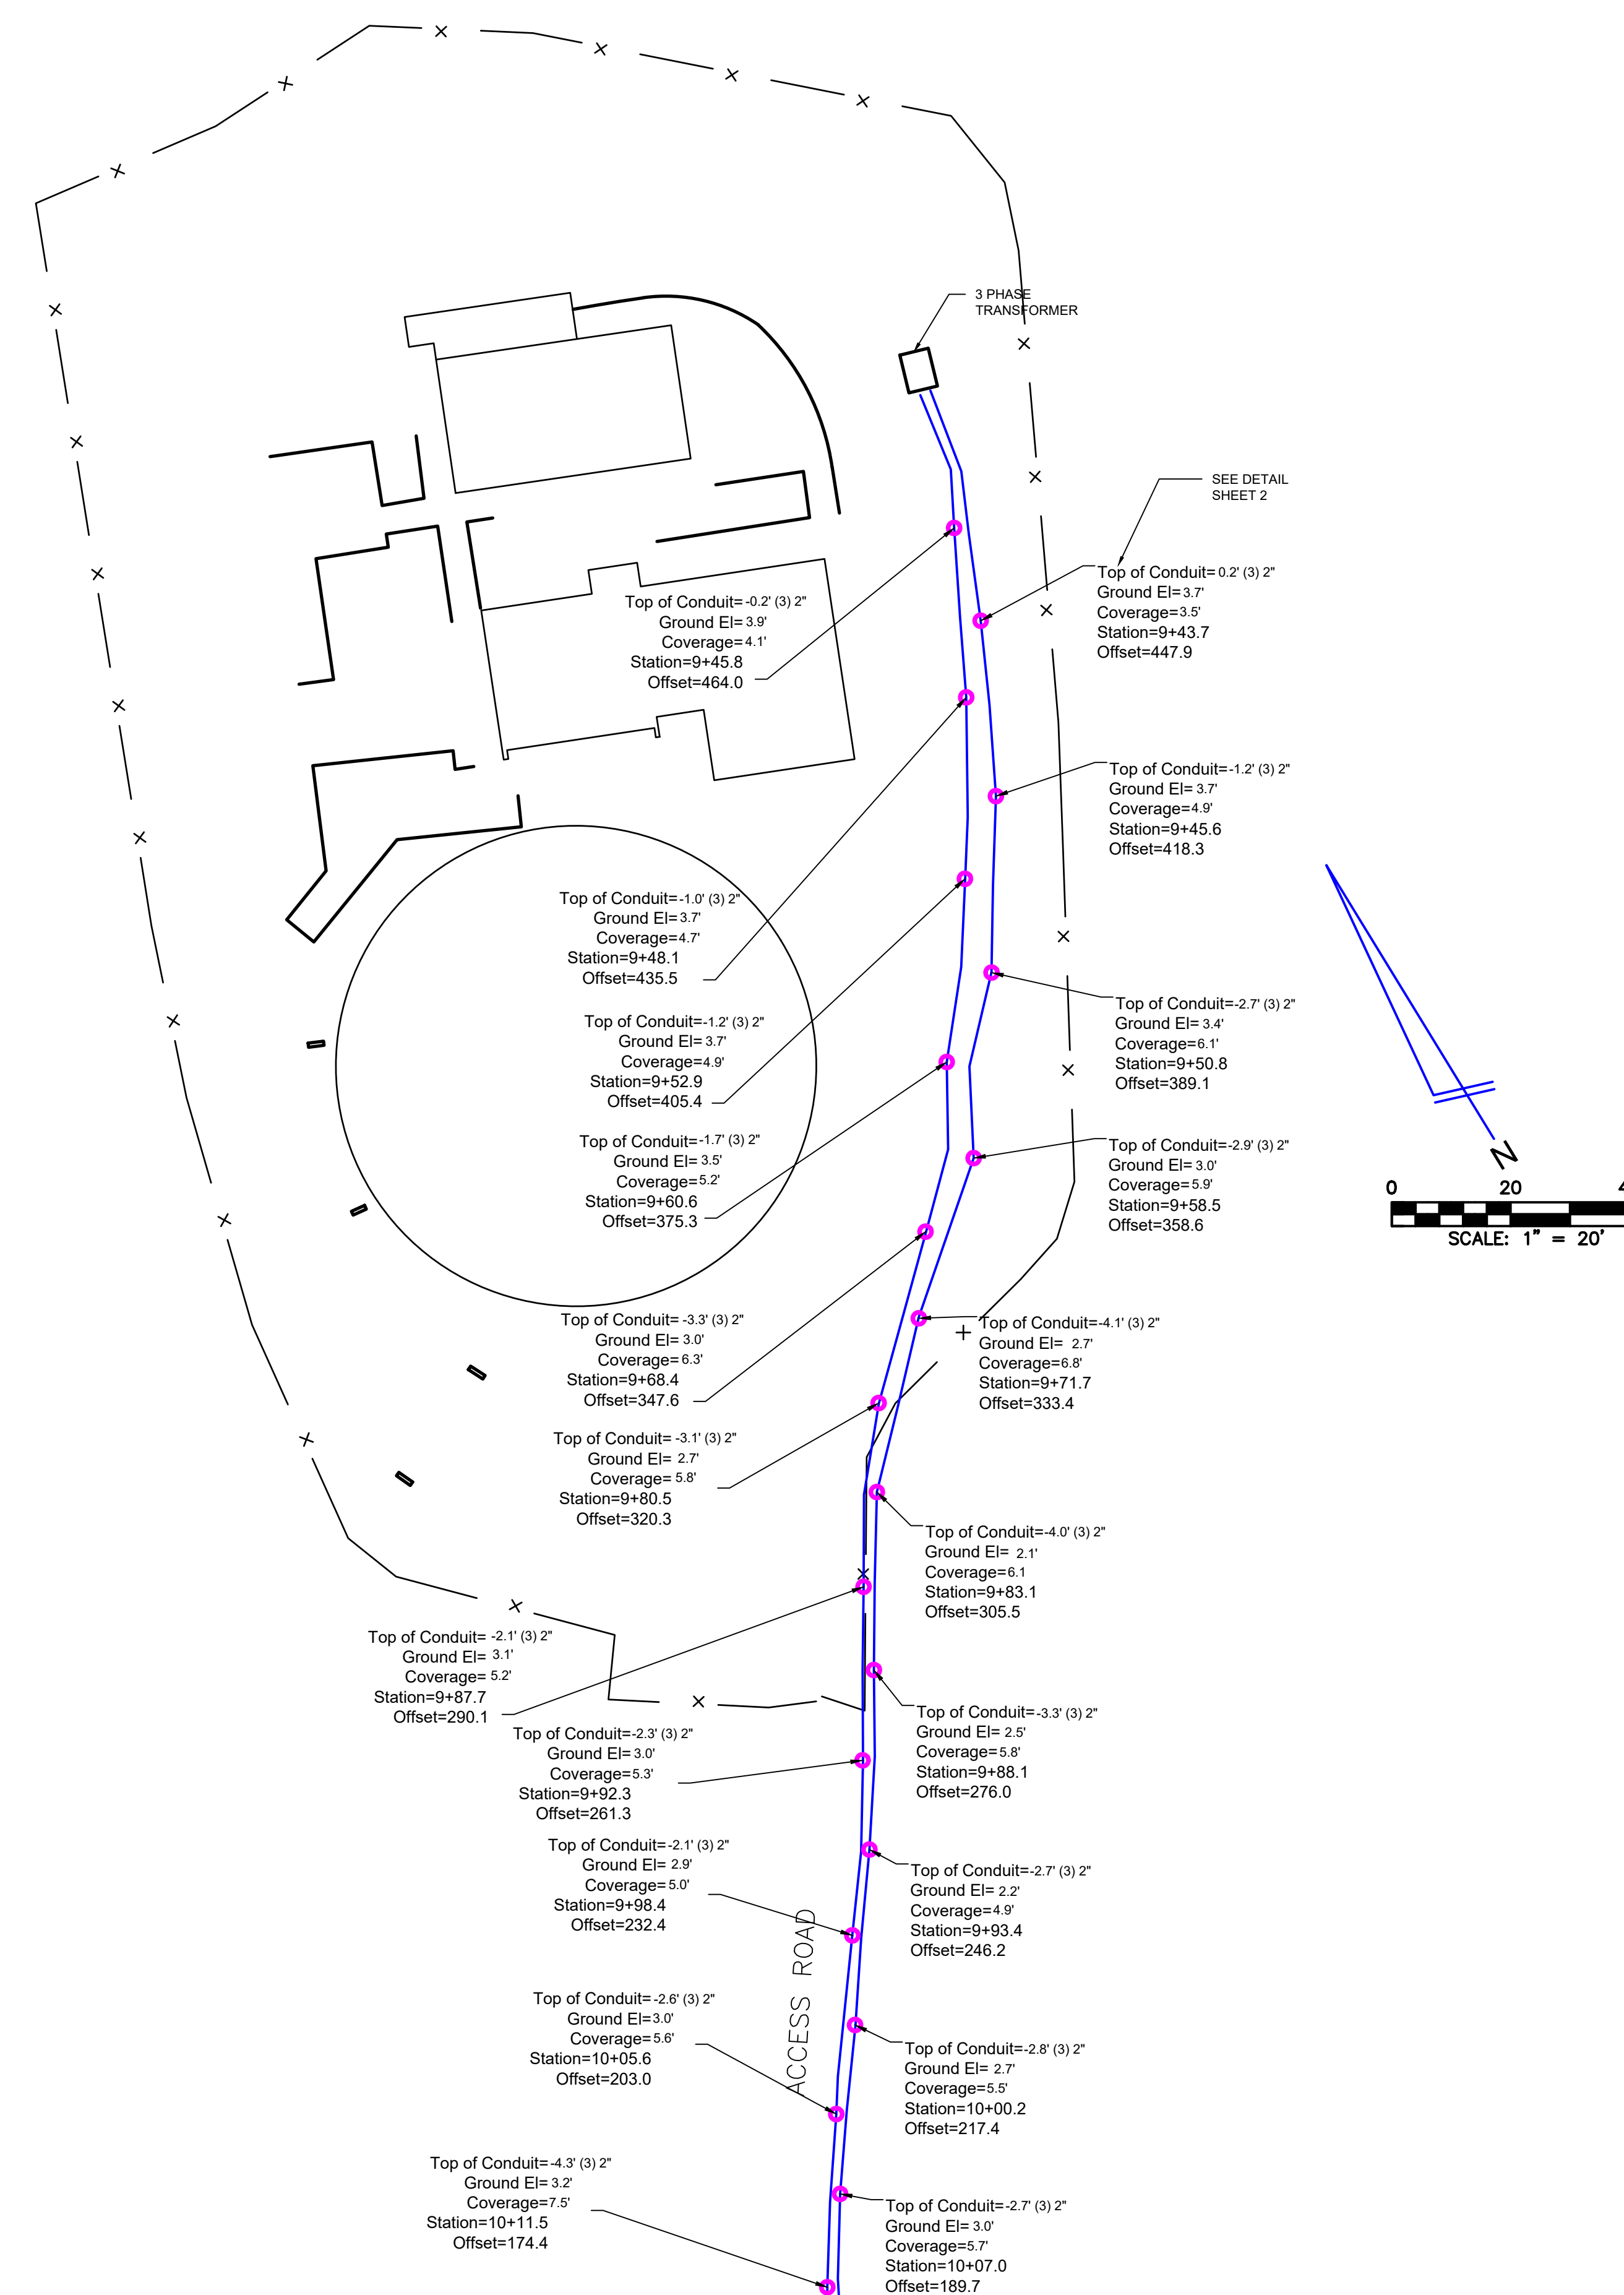

MATCH SHEET 3

TITLE: AS-BUILT SURVEY "LONGBOAT KEY UNDERGROUND" (PHASE 1 SOUTH)

LOCATION: SECTIONS 16, 21 & 22, TOWNSHIP 36 SOUTH, RANGE 17 EAST, SARASOTA COUNTY, FLORIDA

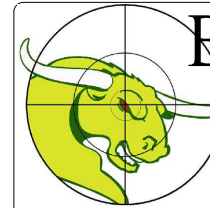


BULLSEYE SURVEYING, INC.
LB 7818
2198 NE COACHMAN ROAD, UNIT F, CLEARWATER, FL 33765
Phone: (727) 475-8088

FILE: 19-040-AS-BUILTS	Drawn By: GRM/AMW
PROJECT NUMBER: 19-040	Date: 10/26/2020 Scale: 1" = 20'


SHEET
4
OF 45

MATCH SHEET 6

T ROADWAY

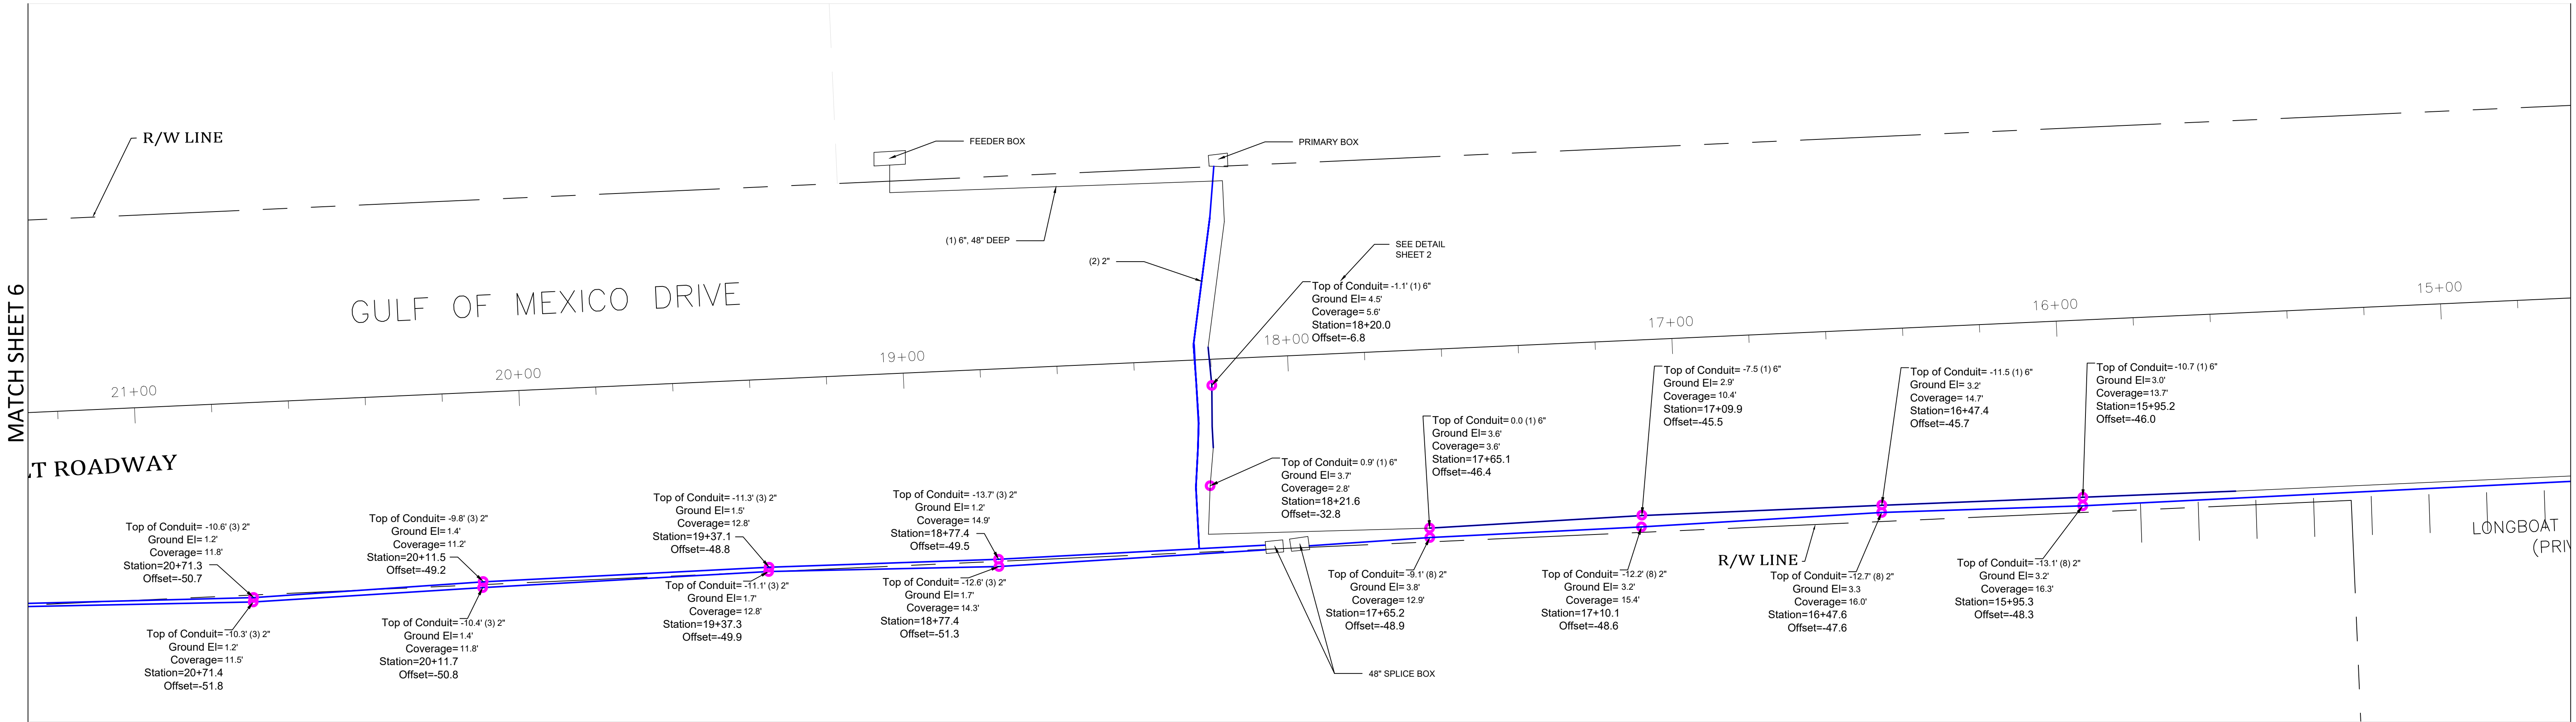

SHEET 5

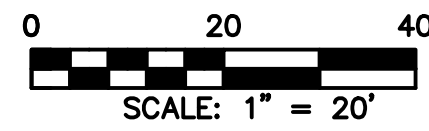


TITLE: AS-BUILT SURVEY "LONGBOAT KEY UNDERGROUND" (PHASE 1 SOUTH)

LOCATION: SECTIONS 16, 21 & 22, TOWNSHIP 36 SOUTH, RANGE 17 EAST, SARASOTA COUNTY, FLORIDA



BULLSEYE SURVEYING, INC.
LB 7818
2198 NE COACHMAN ROAD, UNIT F, CLEARWATER, FL 33765
Phone: (727) 475-8088

FILE: 19-040-AS-BUILTS	Drawn By: GRM/AMW
PROJECT NUMBER: 19-040	Date: 10/26/2020 Scale: 1" = 20'

SHEET
5
OF 45

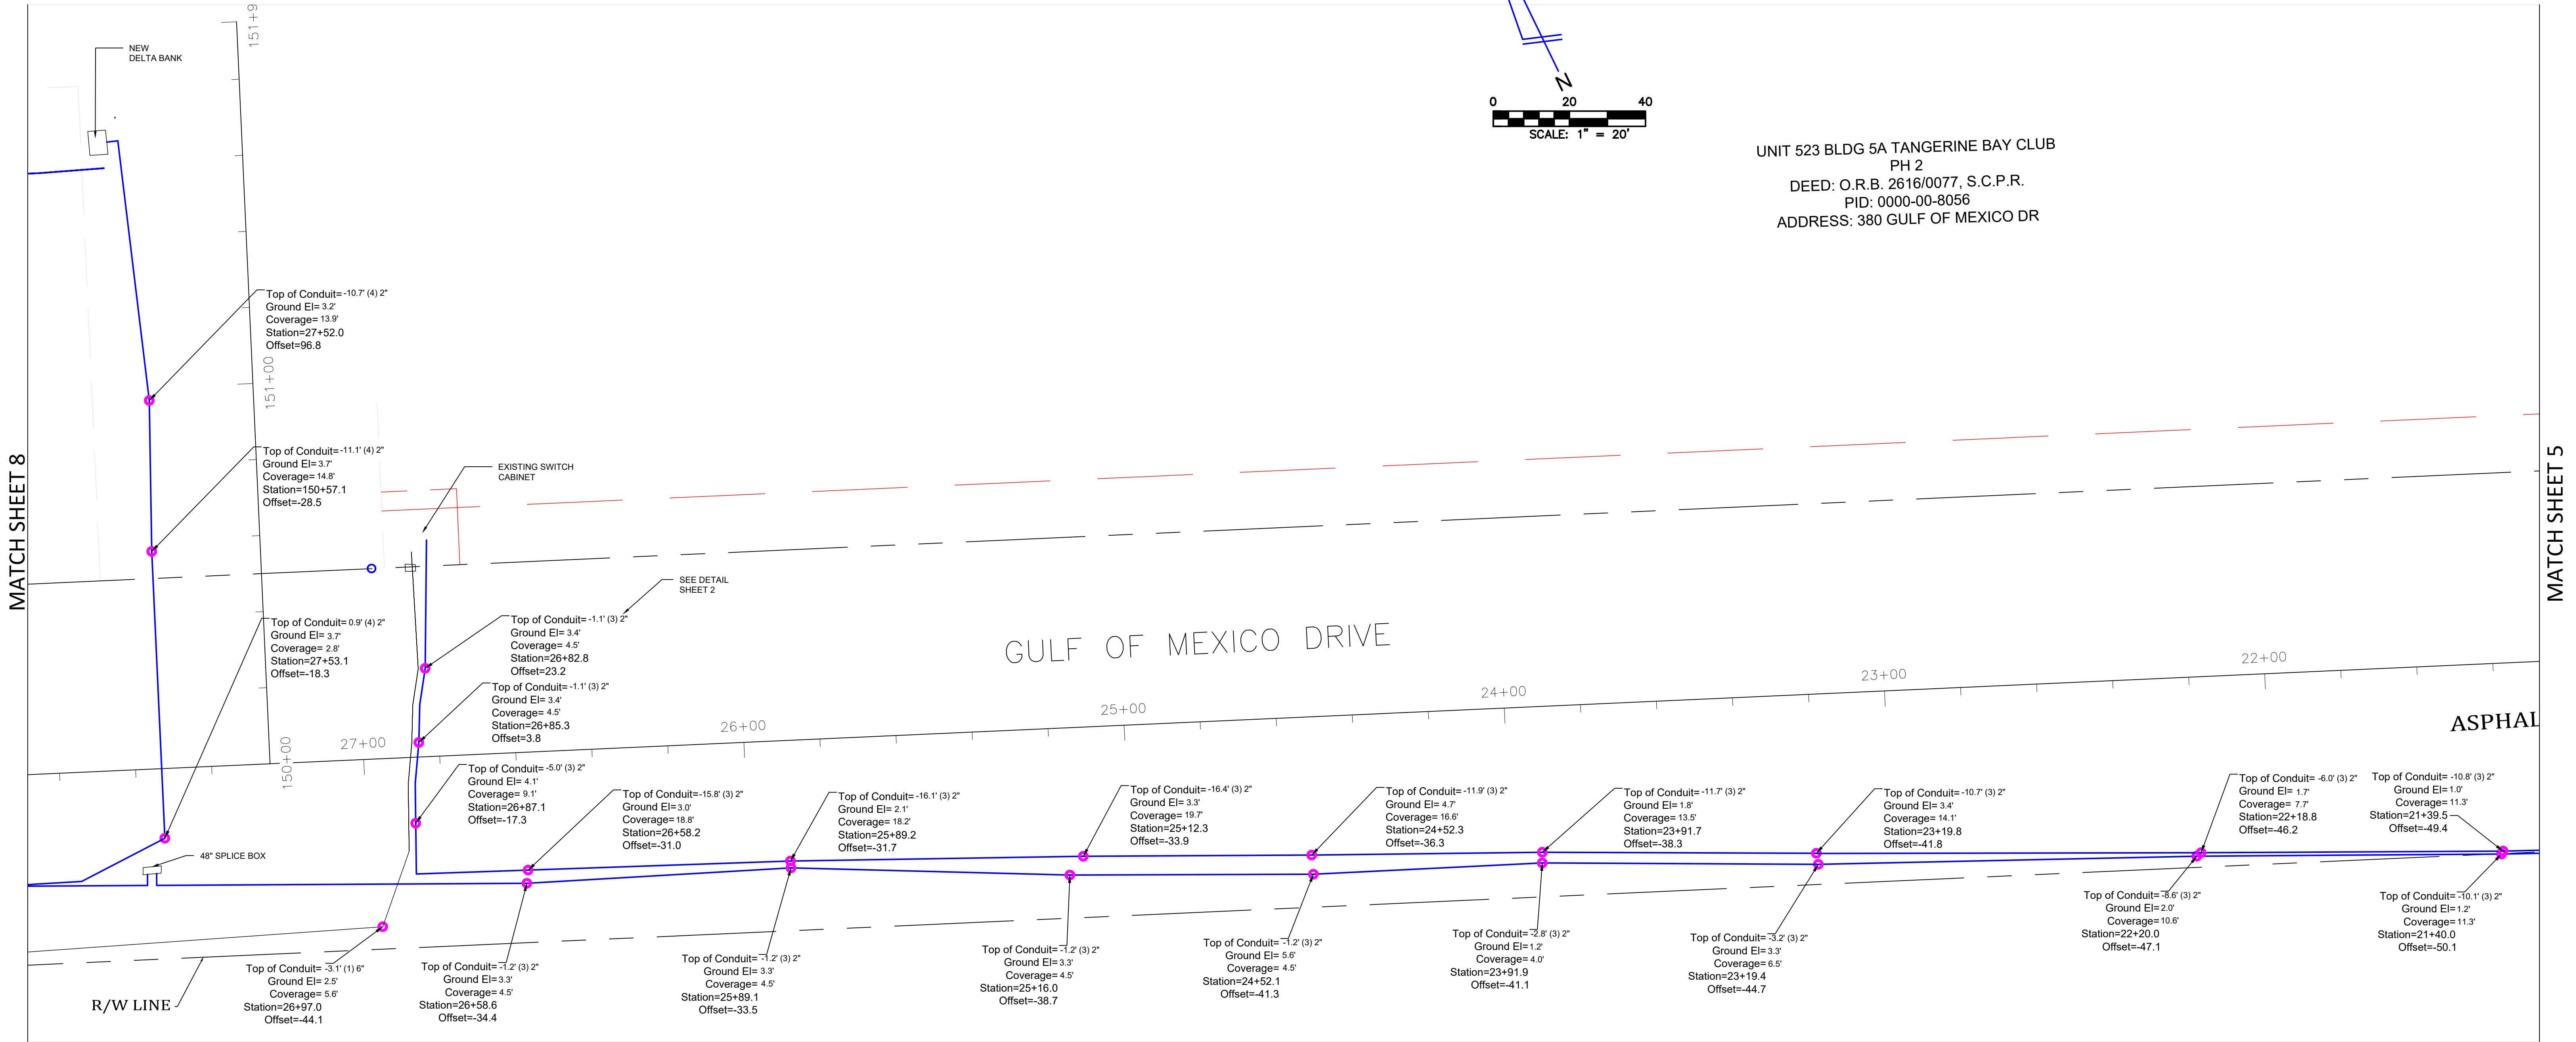


UNIT 523 BLDG 5A TANGERINE BAY CLUB
PH 2
DEED: O.R.B. 2616/0077, S.C.P.R.
PID: 0000-00-8056
ADDRESS: 380 GULF OF MEXICO DR

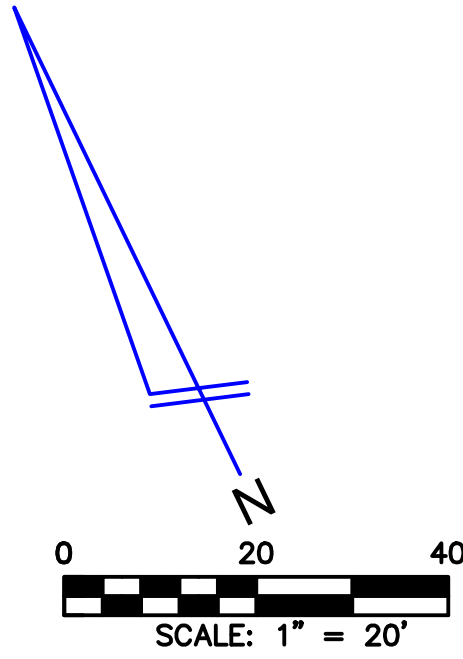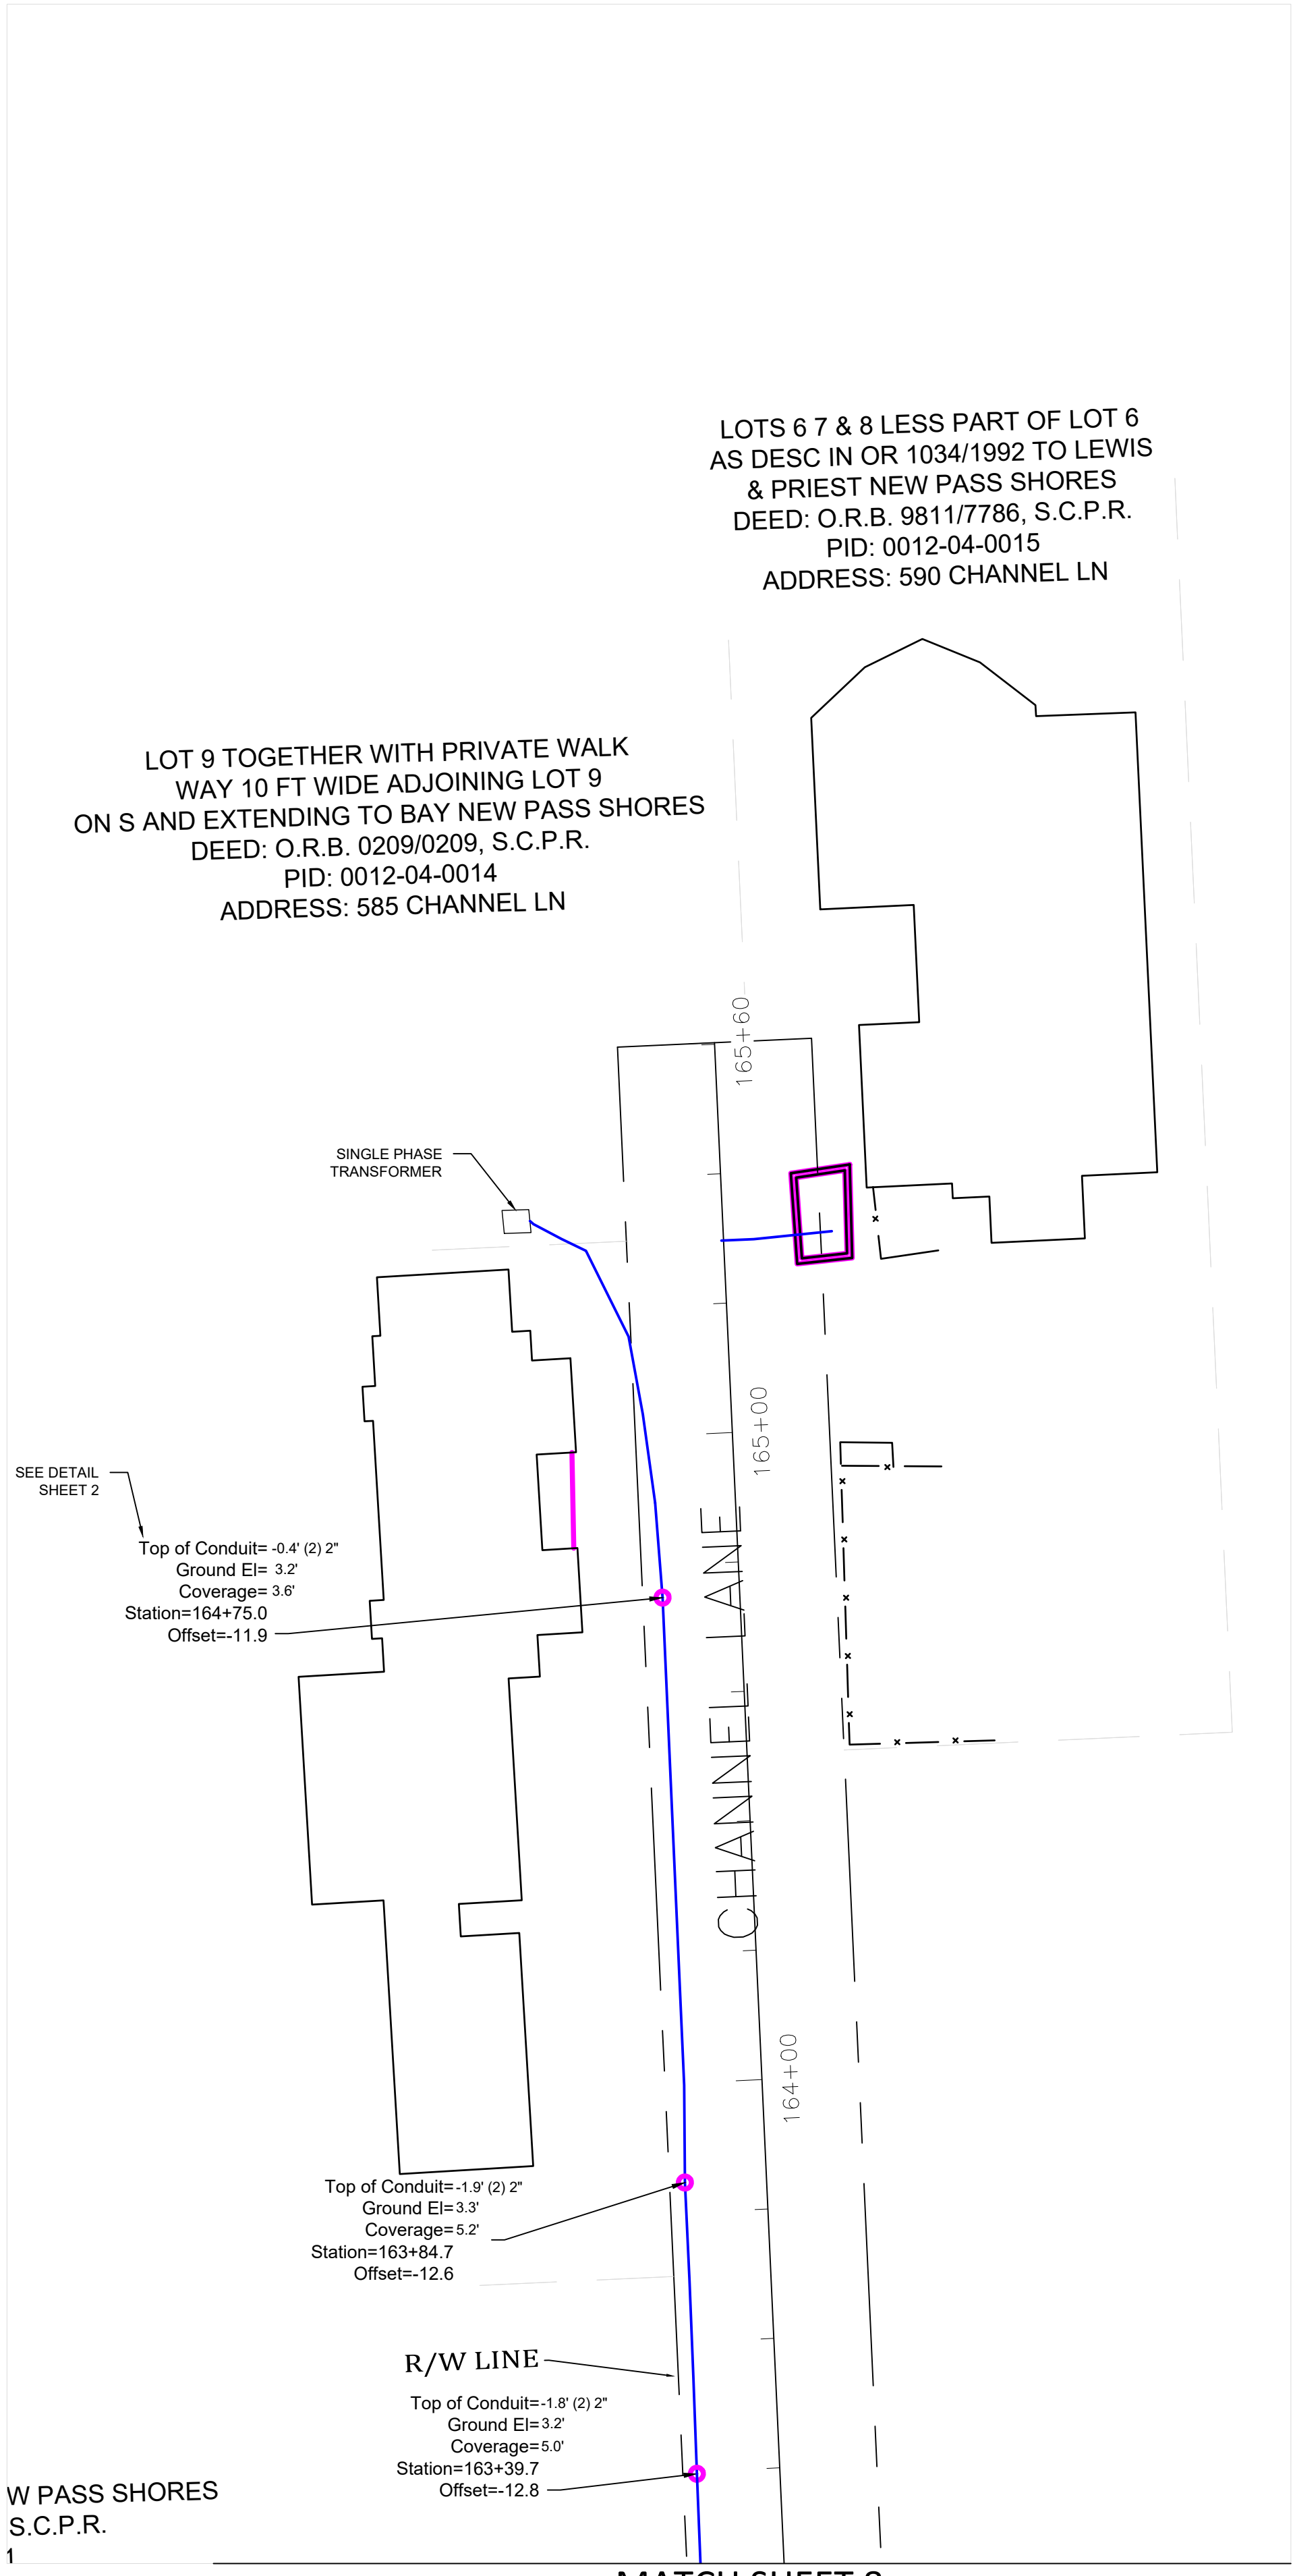

TITLE: AS-BUILT SURVEY "LONGBOAT KEY UNDERGROUND" (PHASE 1 SOUTH)

LOCATION: SECTIONS 16, 21 & 22, TOWNSHIP 36 SOUTH, RANGE 17 EAST, SARASOTA COUNTY, FLORIDA

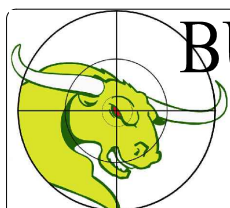

BULLSEYE SURVEYING, INC.


LB 7818
2198 NE COACHMAN ROAD, UNIT F, CLEARWATER, FL 33765
Phone: (727) 475-8088

FILE: 19-040-AS-BUILTS
PROJECT NUMBER: 19-040

Drawn By: GRM/AMW
Date: 10/26/2020

Scale: 1" = 20'

SHEET
7
OF 45

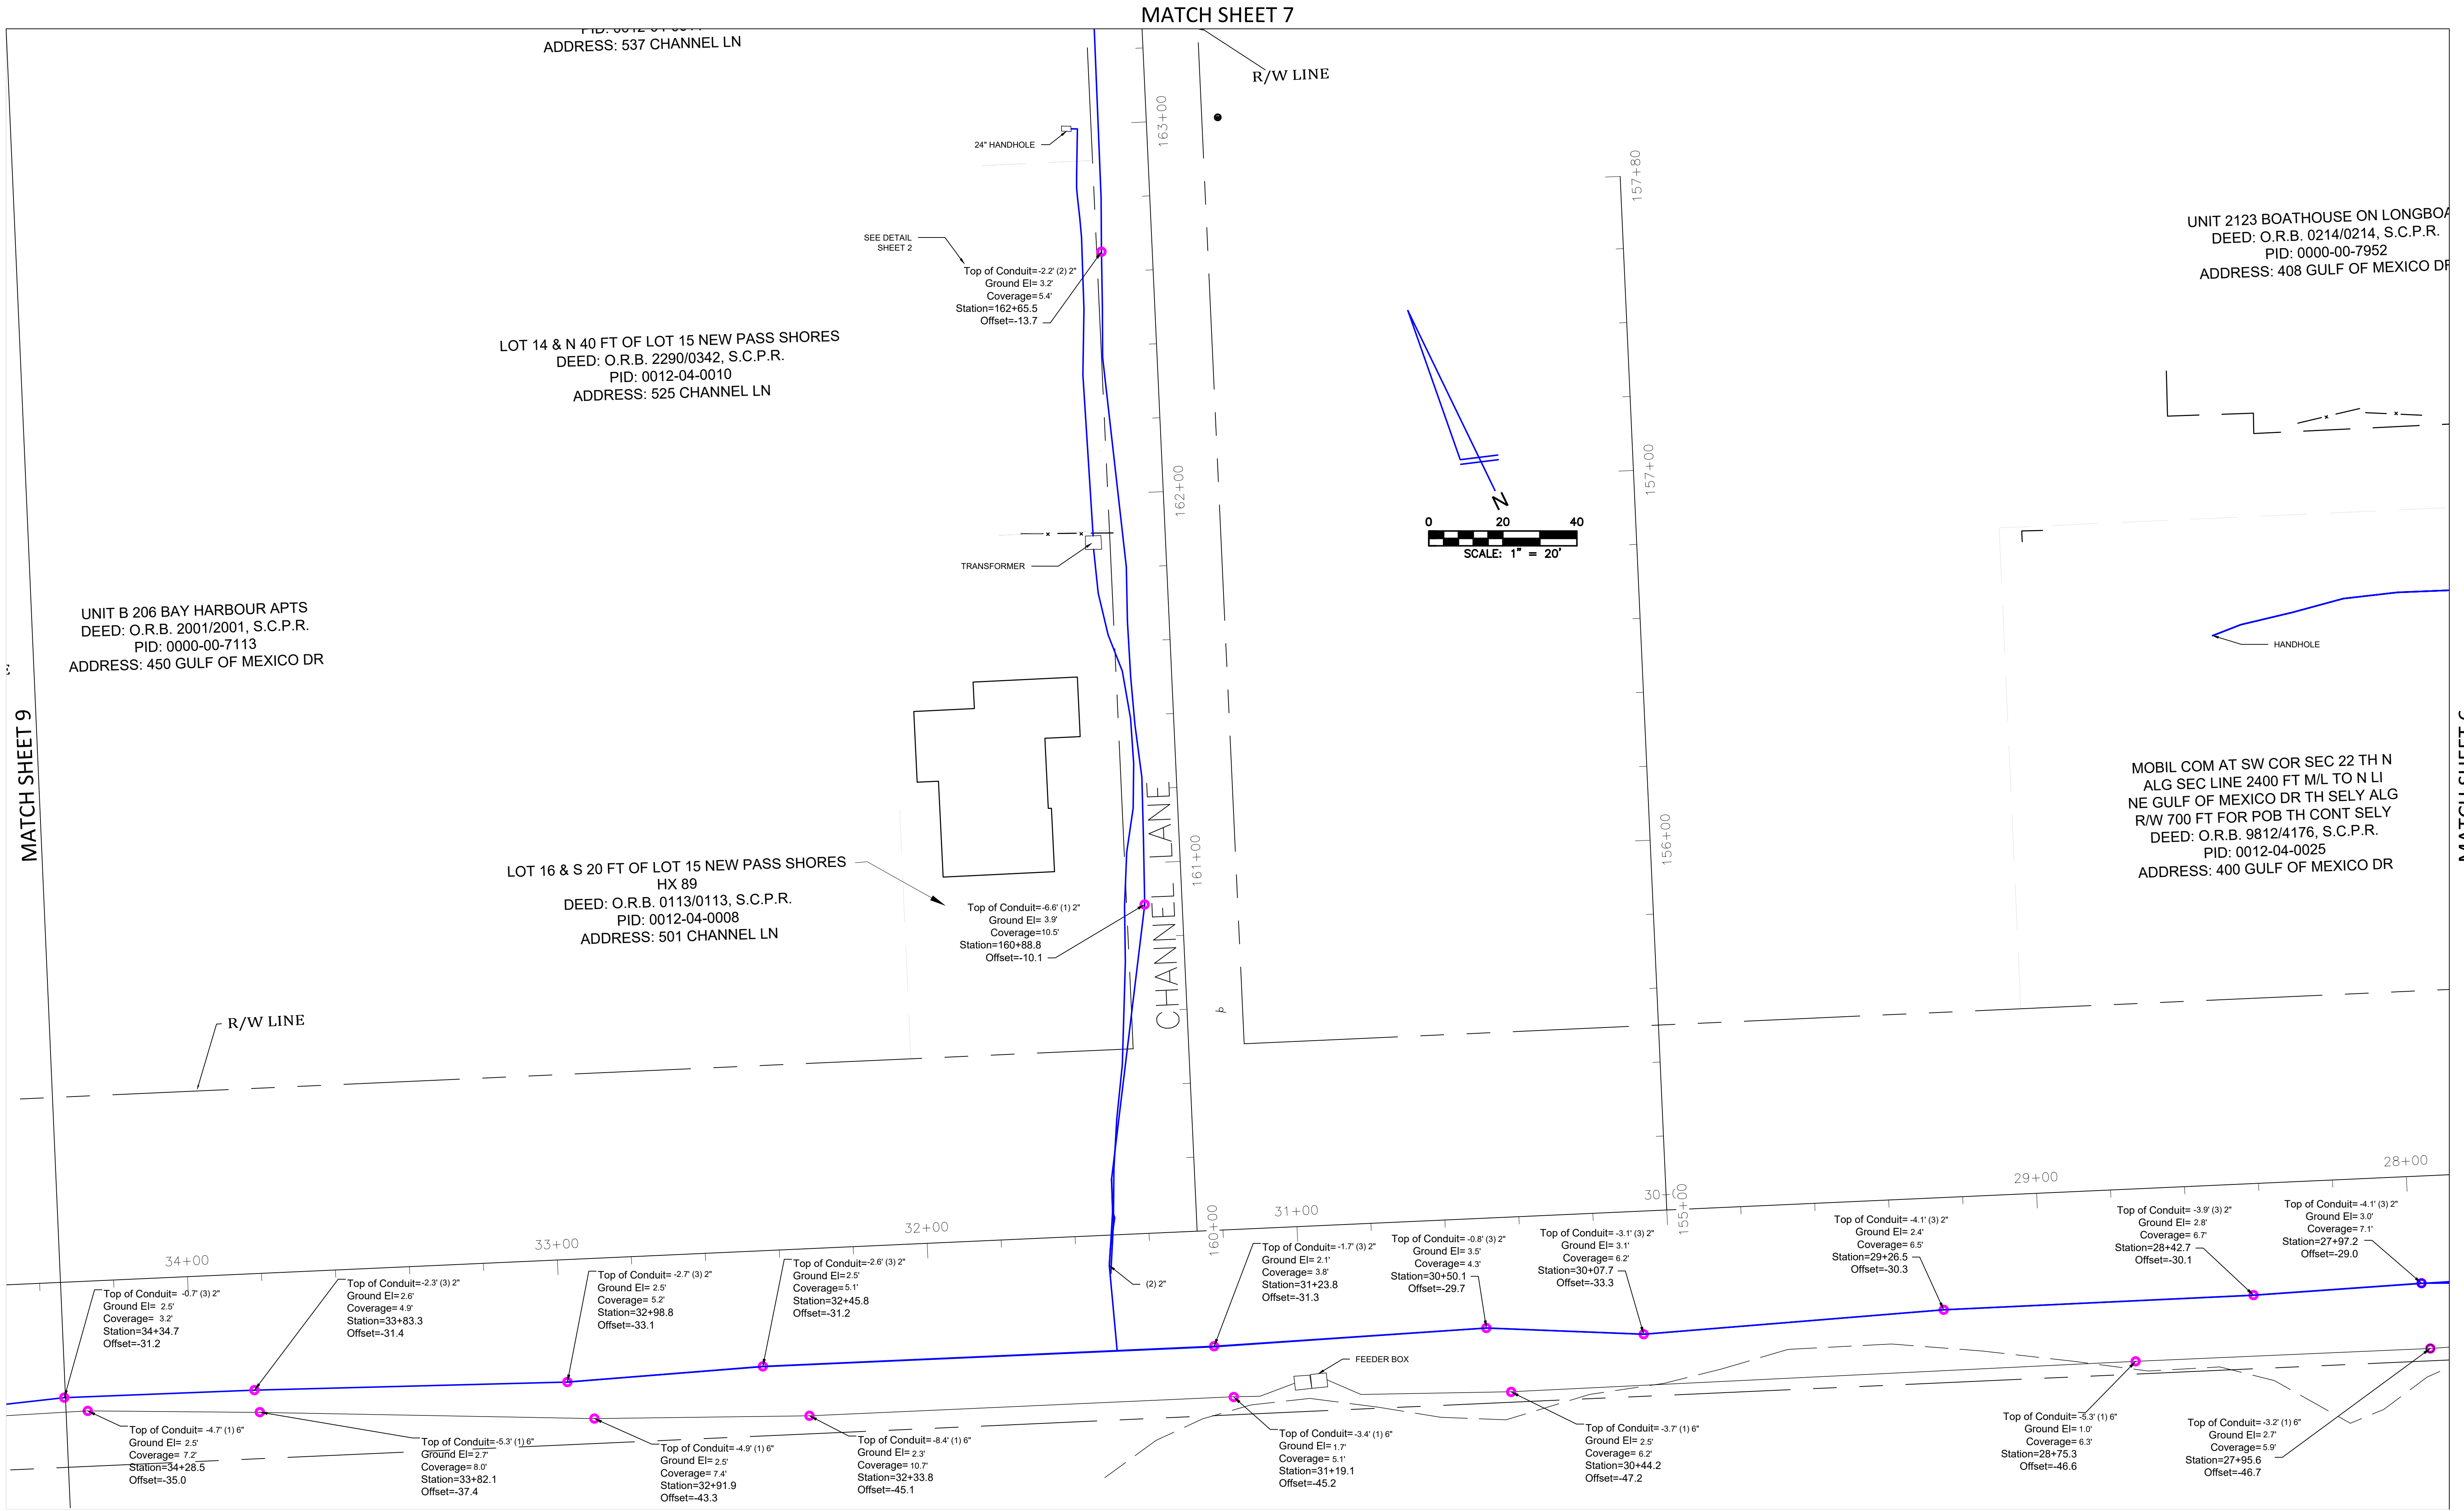

TITLE: AS-BUILT SURVEY "LONGBOAT KEY UNDERGROUND" (PHASE 1 SOUTH)


LOCATION: SECTIONS 16, 21 & 22, TOWNSHIP 36 SOUTH, RANGE 17 EAST, SARASOTA COUNTY, FLORIDA

BULLSEYE SURVEYING, INC.
LB 7818
2198 NE COACHMAN ROAD, UNIT F, CLEARWATER, FL 33765
Phone: (727) 475-8088

FILE: 19-040-AS-BUILTS	Drawn By: GRM/AMW	
PROJECT NUMBER: 19-040	Date: 10/26/2020	Scale: 1" = 20'

SHEET
8
OF 45

MATCH SHEET 11

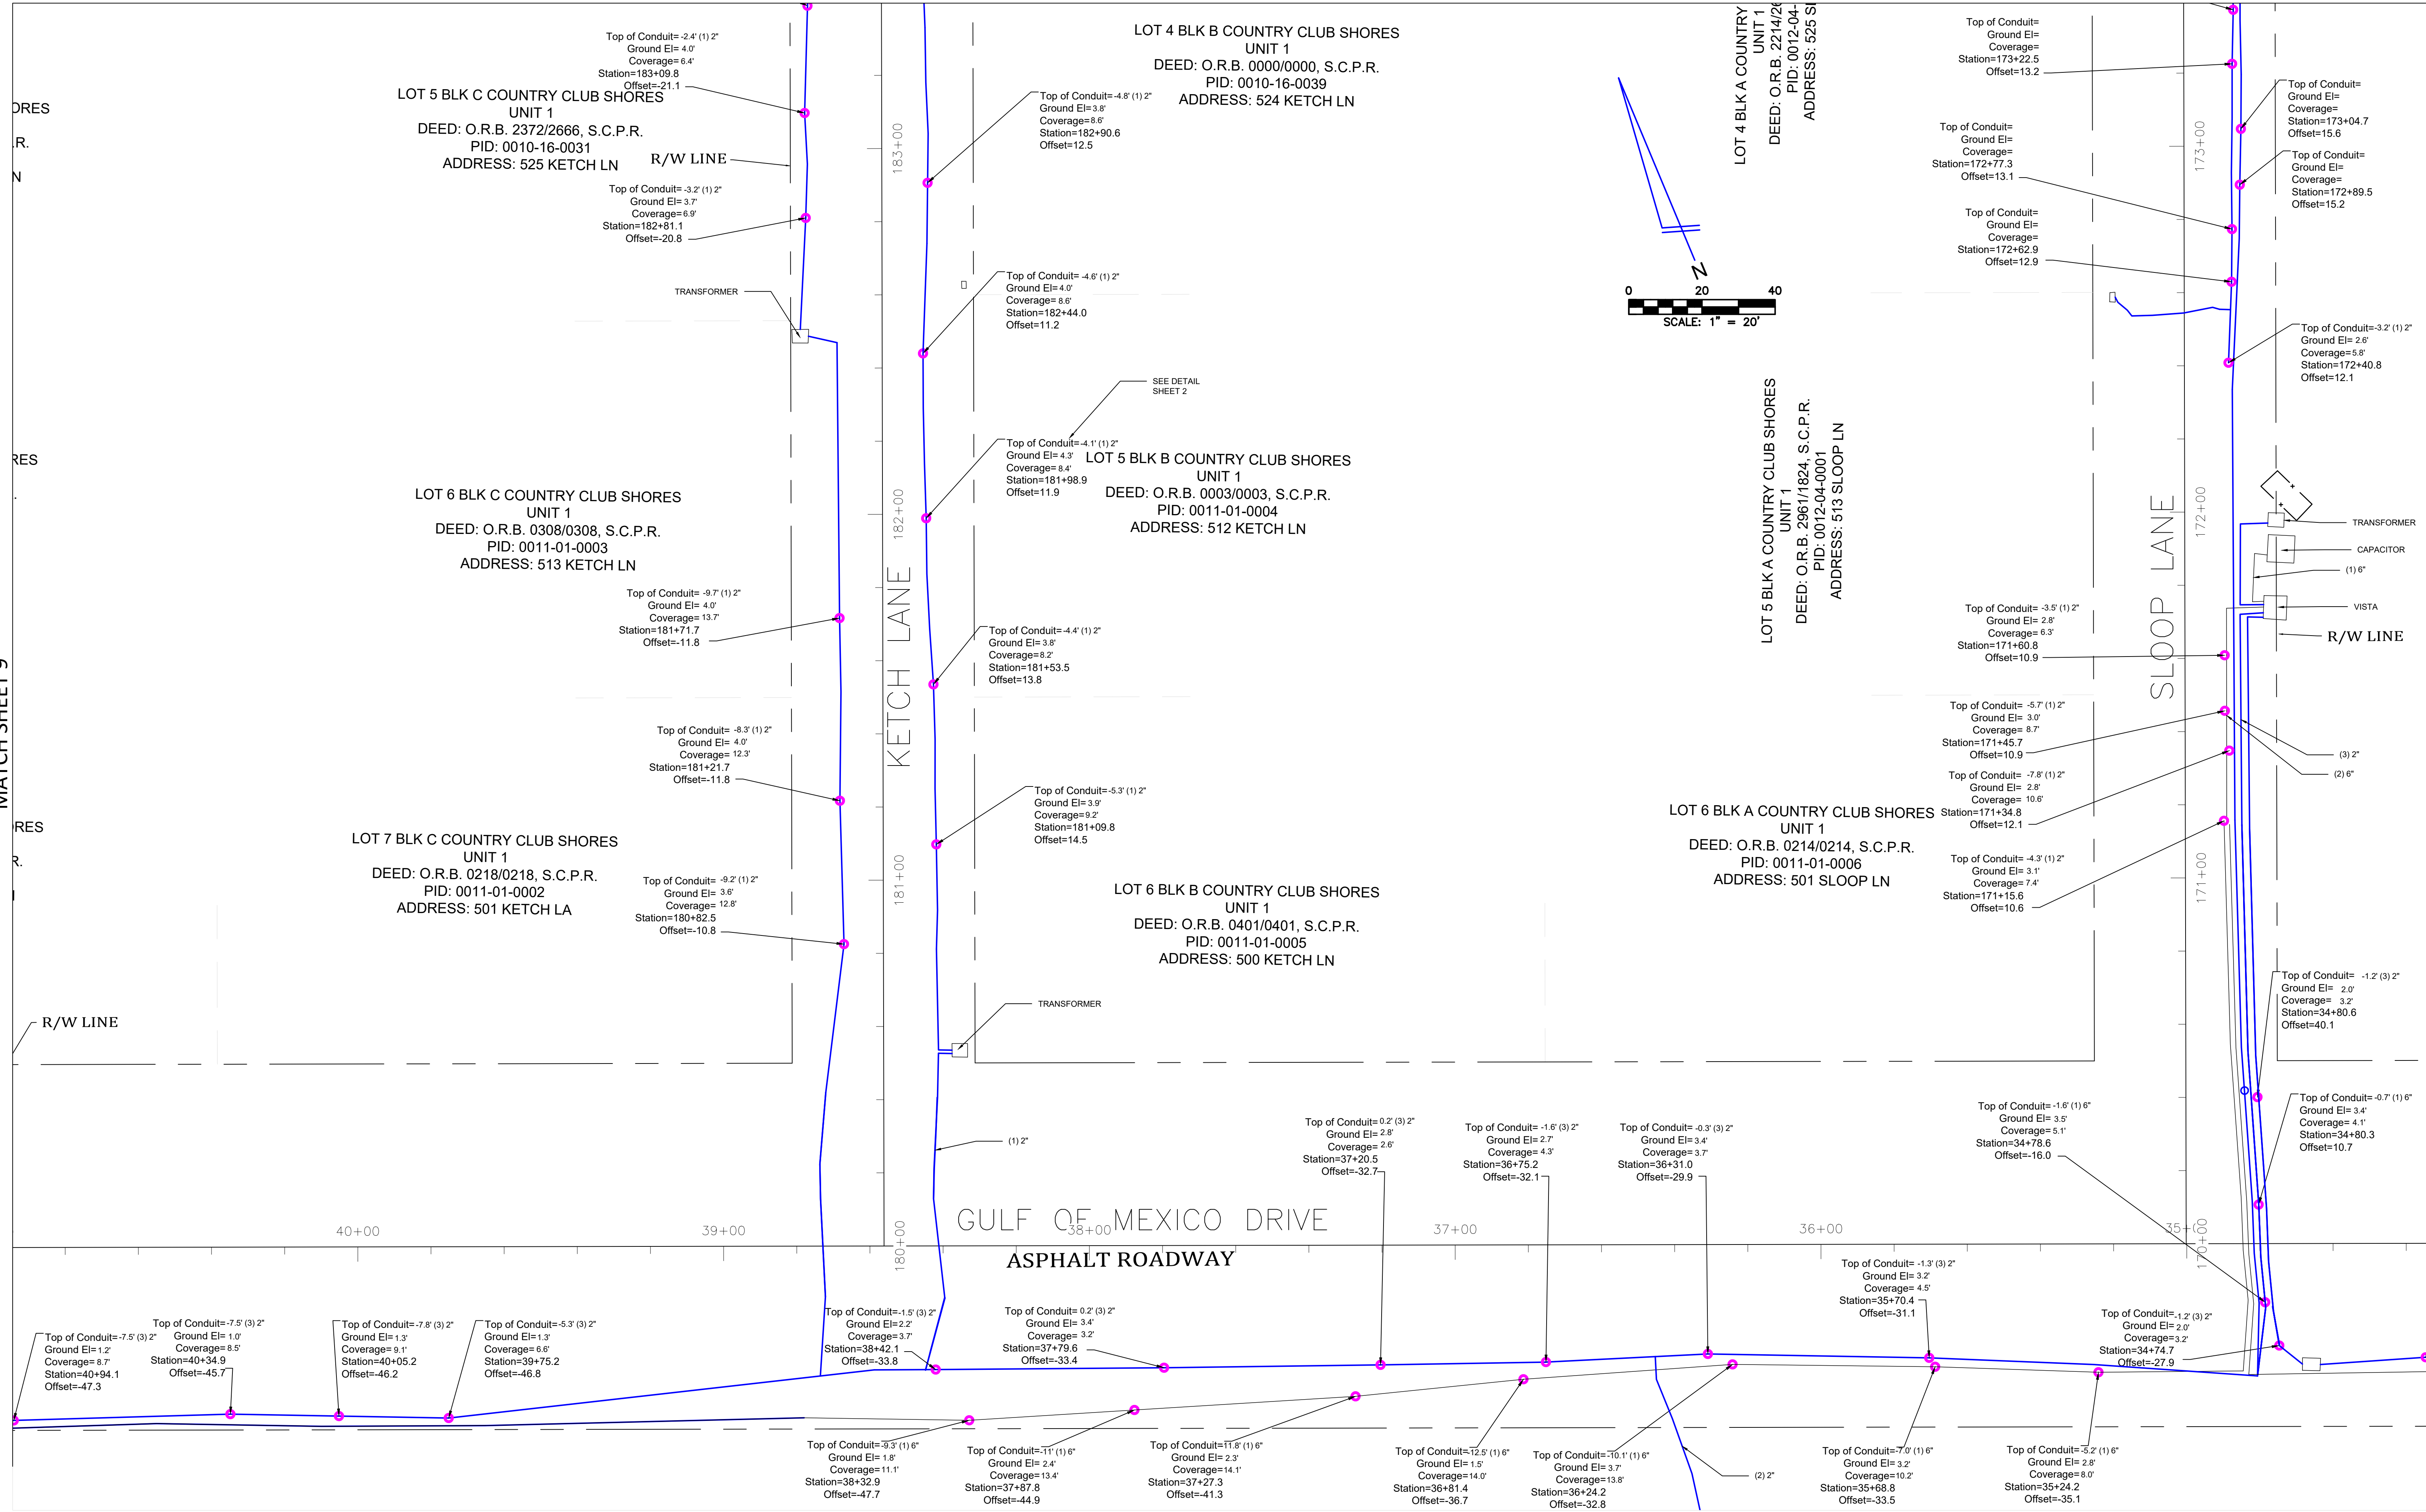


TITLE: AS-BUILT SURVEY "LONGBOAT KEY UNDERGROUND" (PHASE 1 SOUTH)

LOCATION: SECTIONS 16, 21 & 22, TOWNSHIP 36 SOUTH, RANGE 17 EAST, SARASOTA COUNTY, FLORIDA

BULLSEYE SURVEYING, INC.
LB 7818
2198 NE COACHMAN ROAD, UNIT F, CLEARWATER, FL 33765
Phone: (727) 475-8088

FILE: 19-040-AS-BUILTS	Drawn By: GRM/AMW
PROJECT NUMBER: 19-040	Date: 10/26/2020 Scale: 1" = 20'

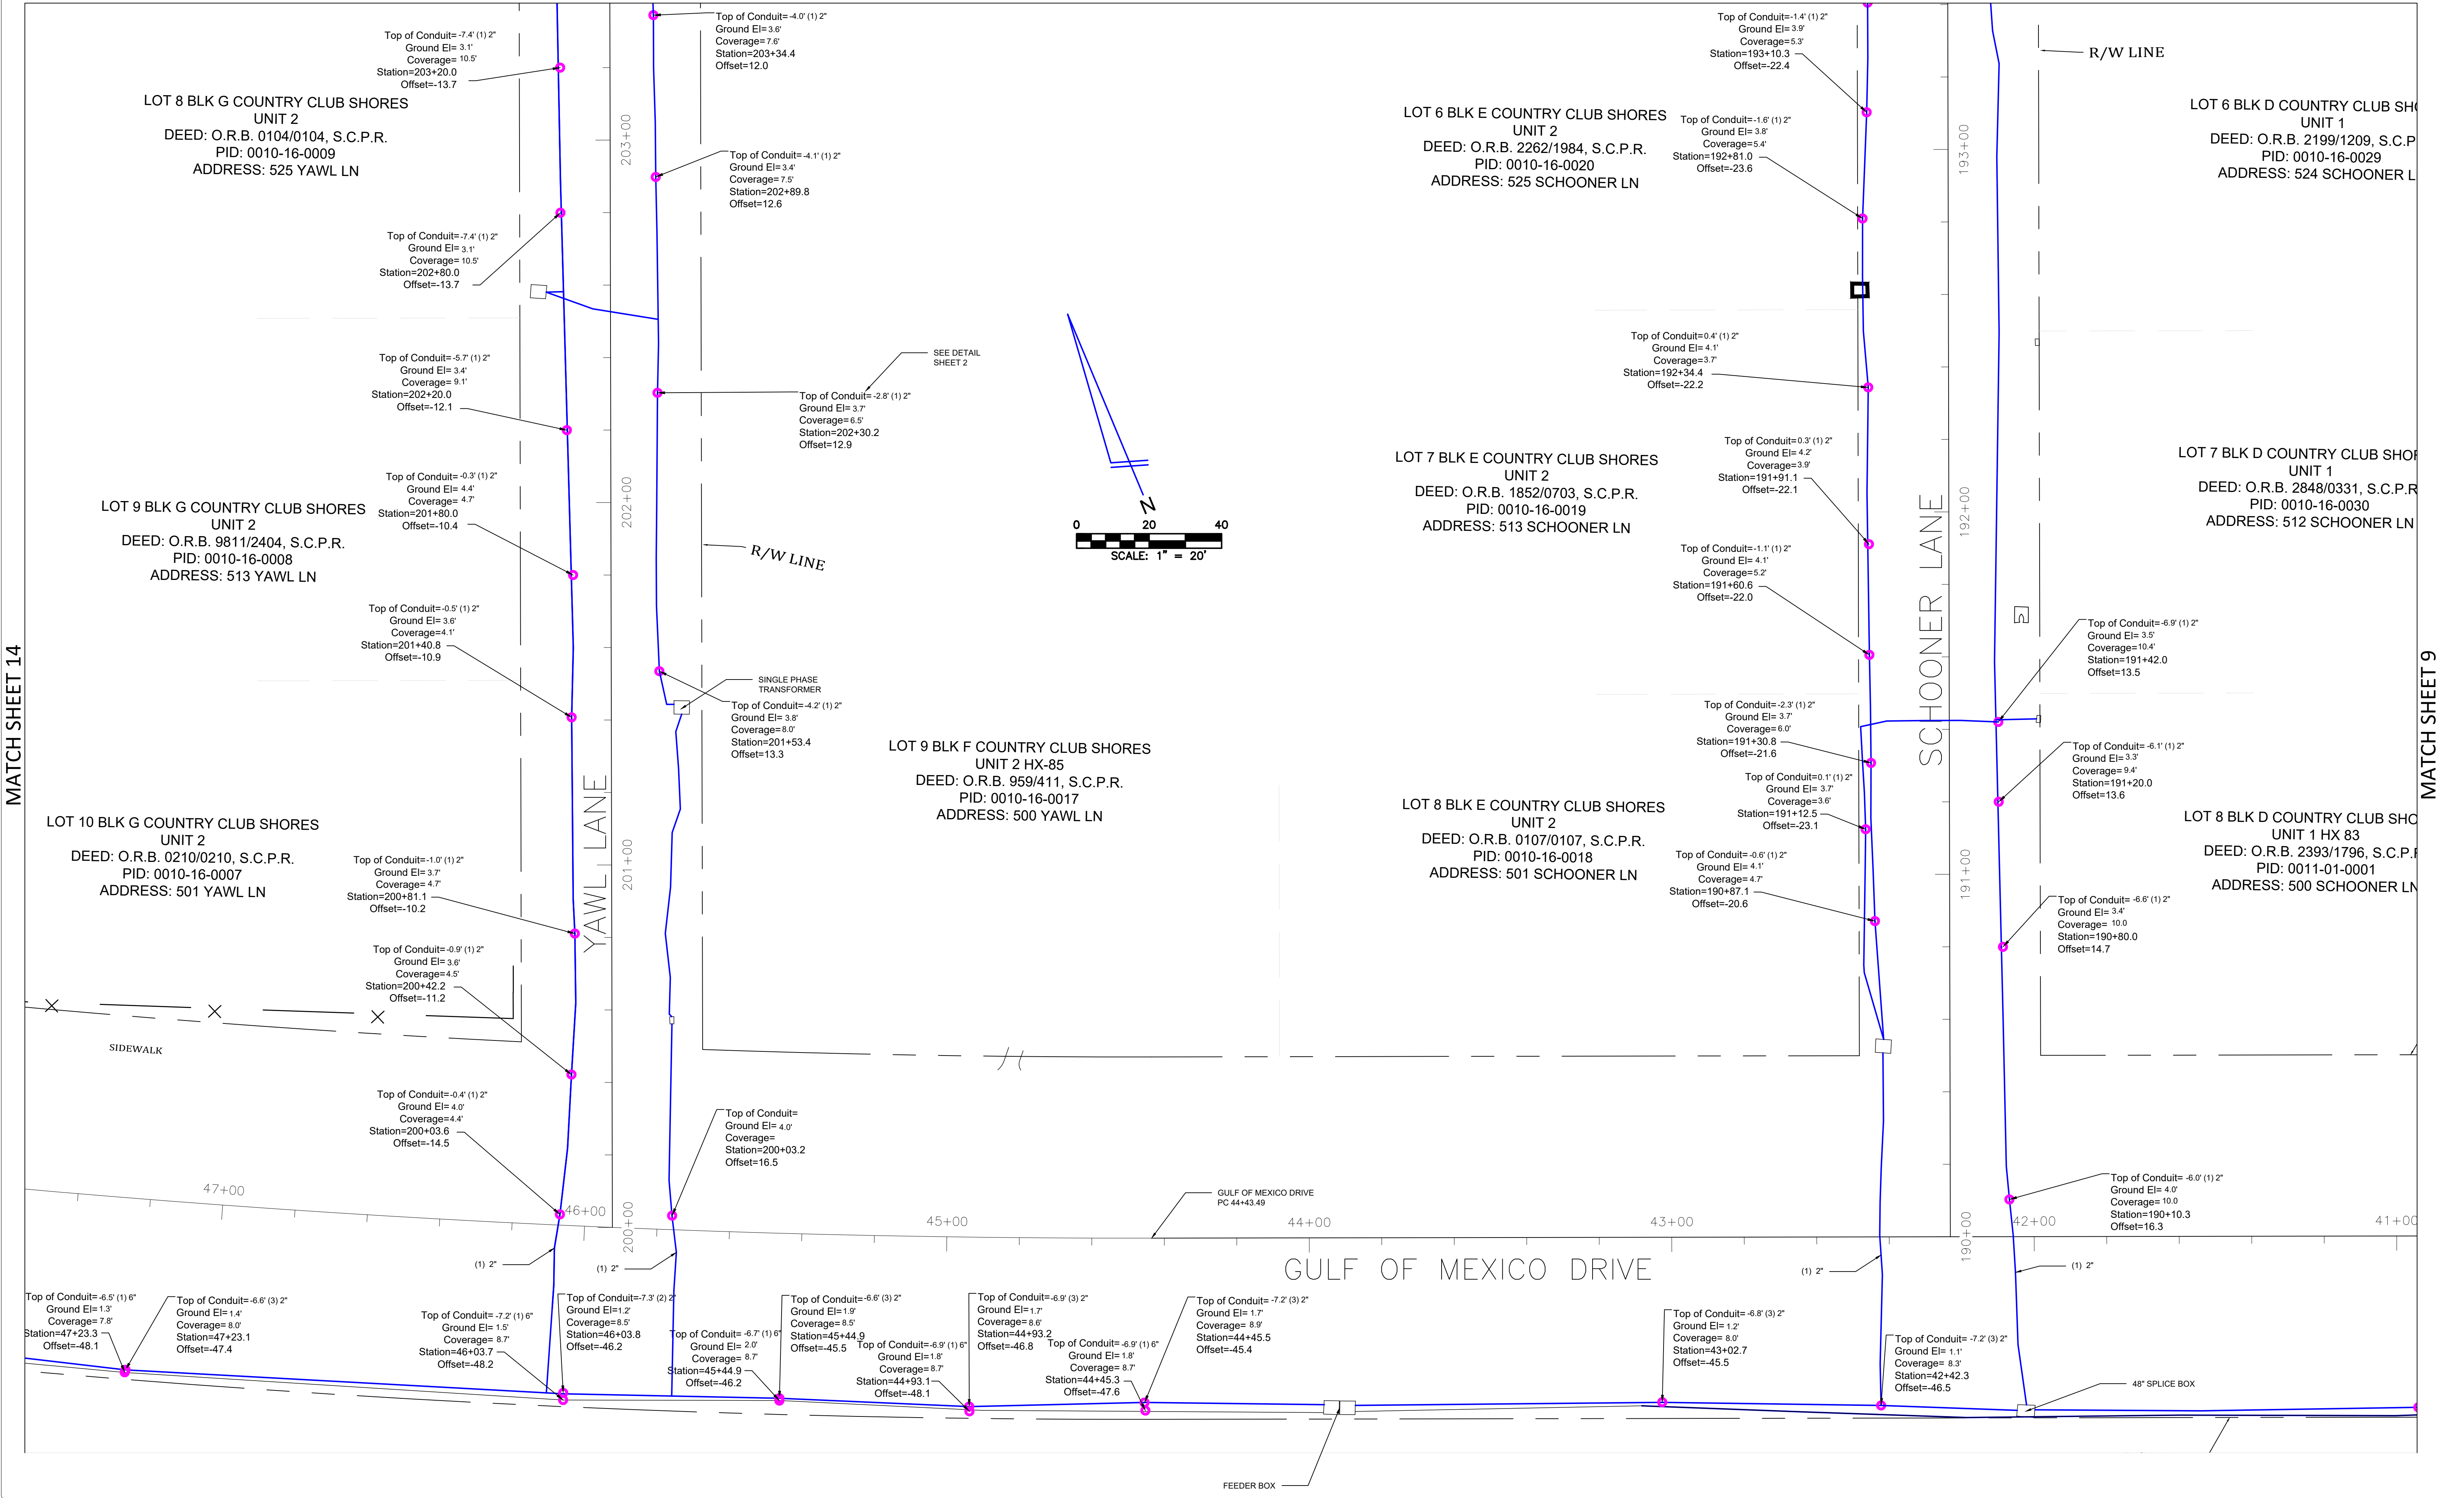


TITLE: AS-BUILT SURVEY "LONGBOAT KEY UNDERGROUND" (PHASE 1 SOUTH)

LOCATION: SECTIONS 16, 21 & 22, TOWNSHIP 36 SOUTH, RANGE 17 EAST, SARASOTA COUNTY, FLORIDA




FILE: 19-040-AS-BUILTS
PROJECT NUMBER: 19-040
Drawn By: GRM/AMW
Date: 10/26/2020
Scale: 1" = 20'

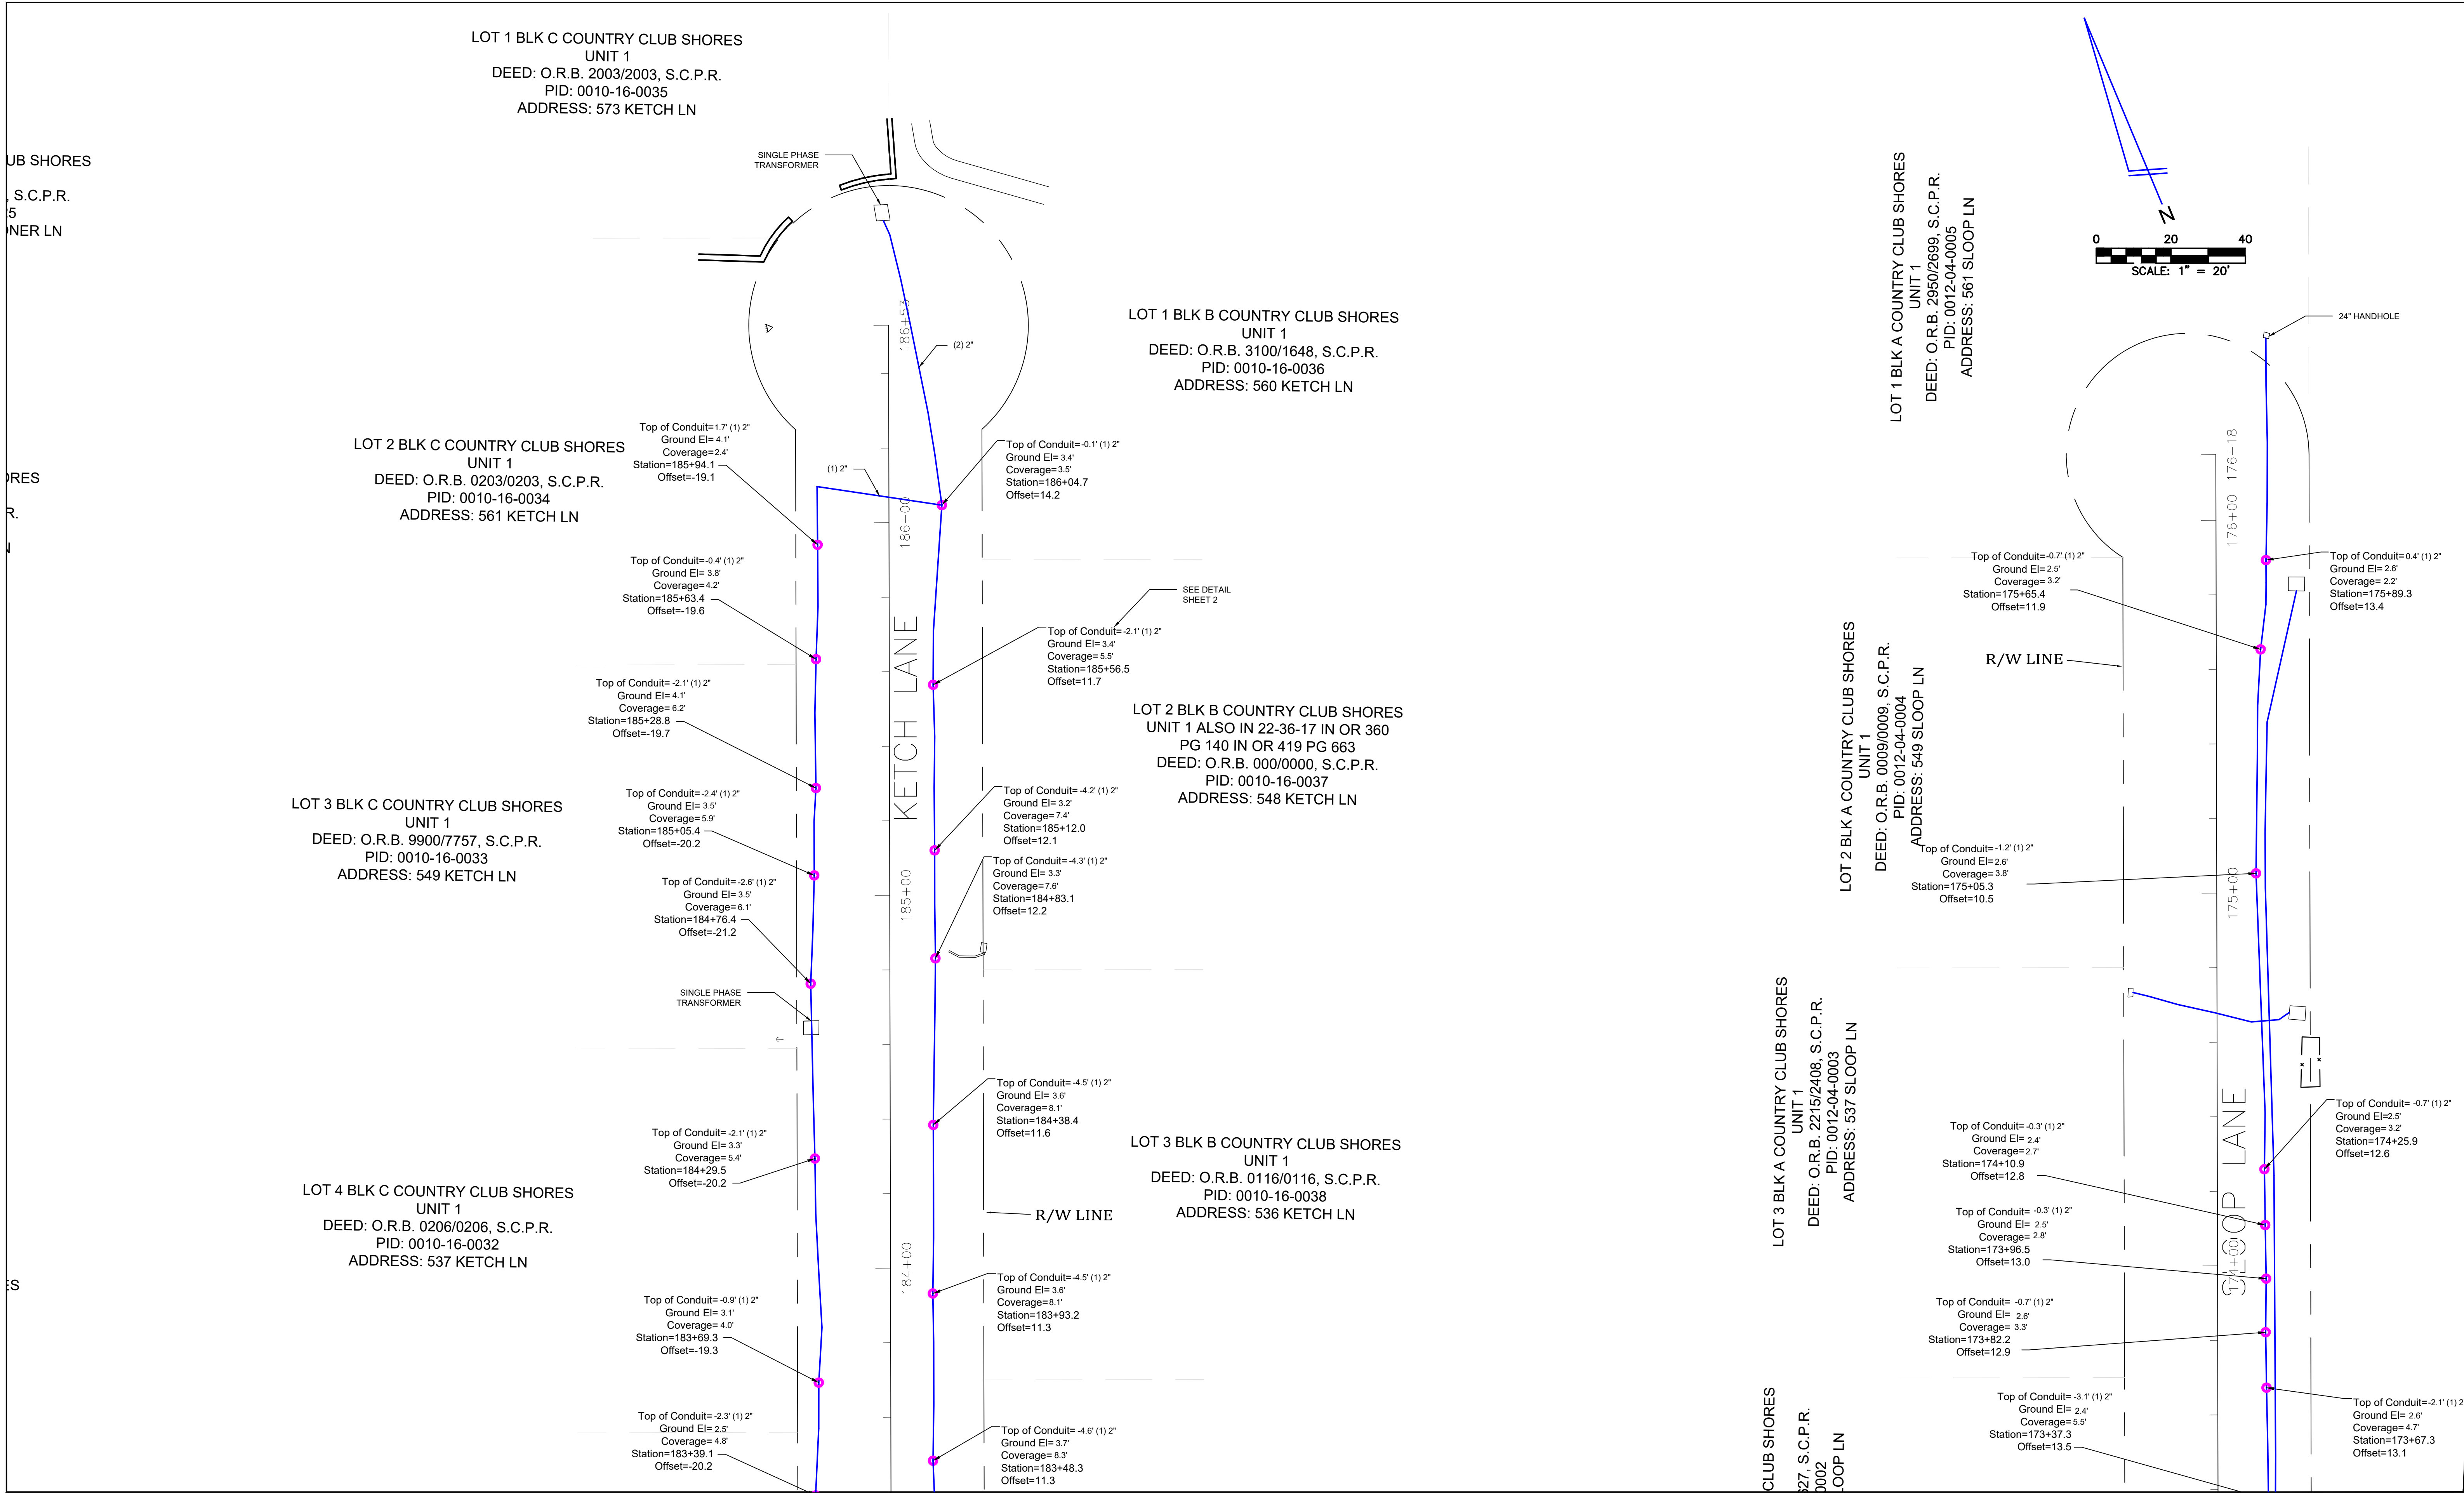

MATCH SHEET 9


TITLE: AS-BUILT SURVEY "LONGBOAT KEY UNDERGROUND" (PHASE 1 SOUTH)


LOCATION: SECTIONS 16, 21 & 22, TOWNSHIP 36 SOUTH, RANGE 17 EAST, SARASOTA COUNTY, FLORIDA

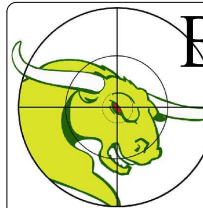

BULLSEYE SURVEYING, INC.
LB 7818
2198 NE COACHMAN ROAD, UNIT F, CLEARWATER, FL 33765
Phone: (727) 475-8088

FILE: 19-040-AS-BUILTS	Drawn By: GRM/AMW
PROJECT NUMBER: 19-040	Date: 10/26/2020
	Scale: 1" = 20'

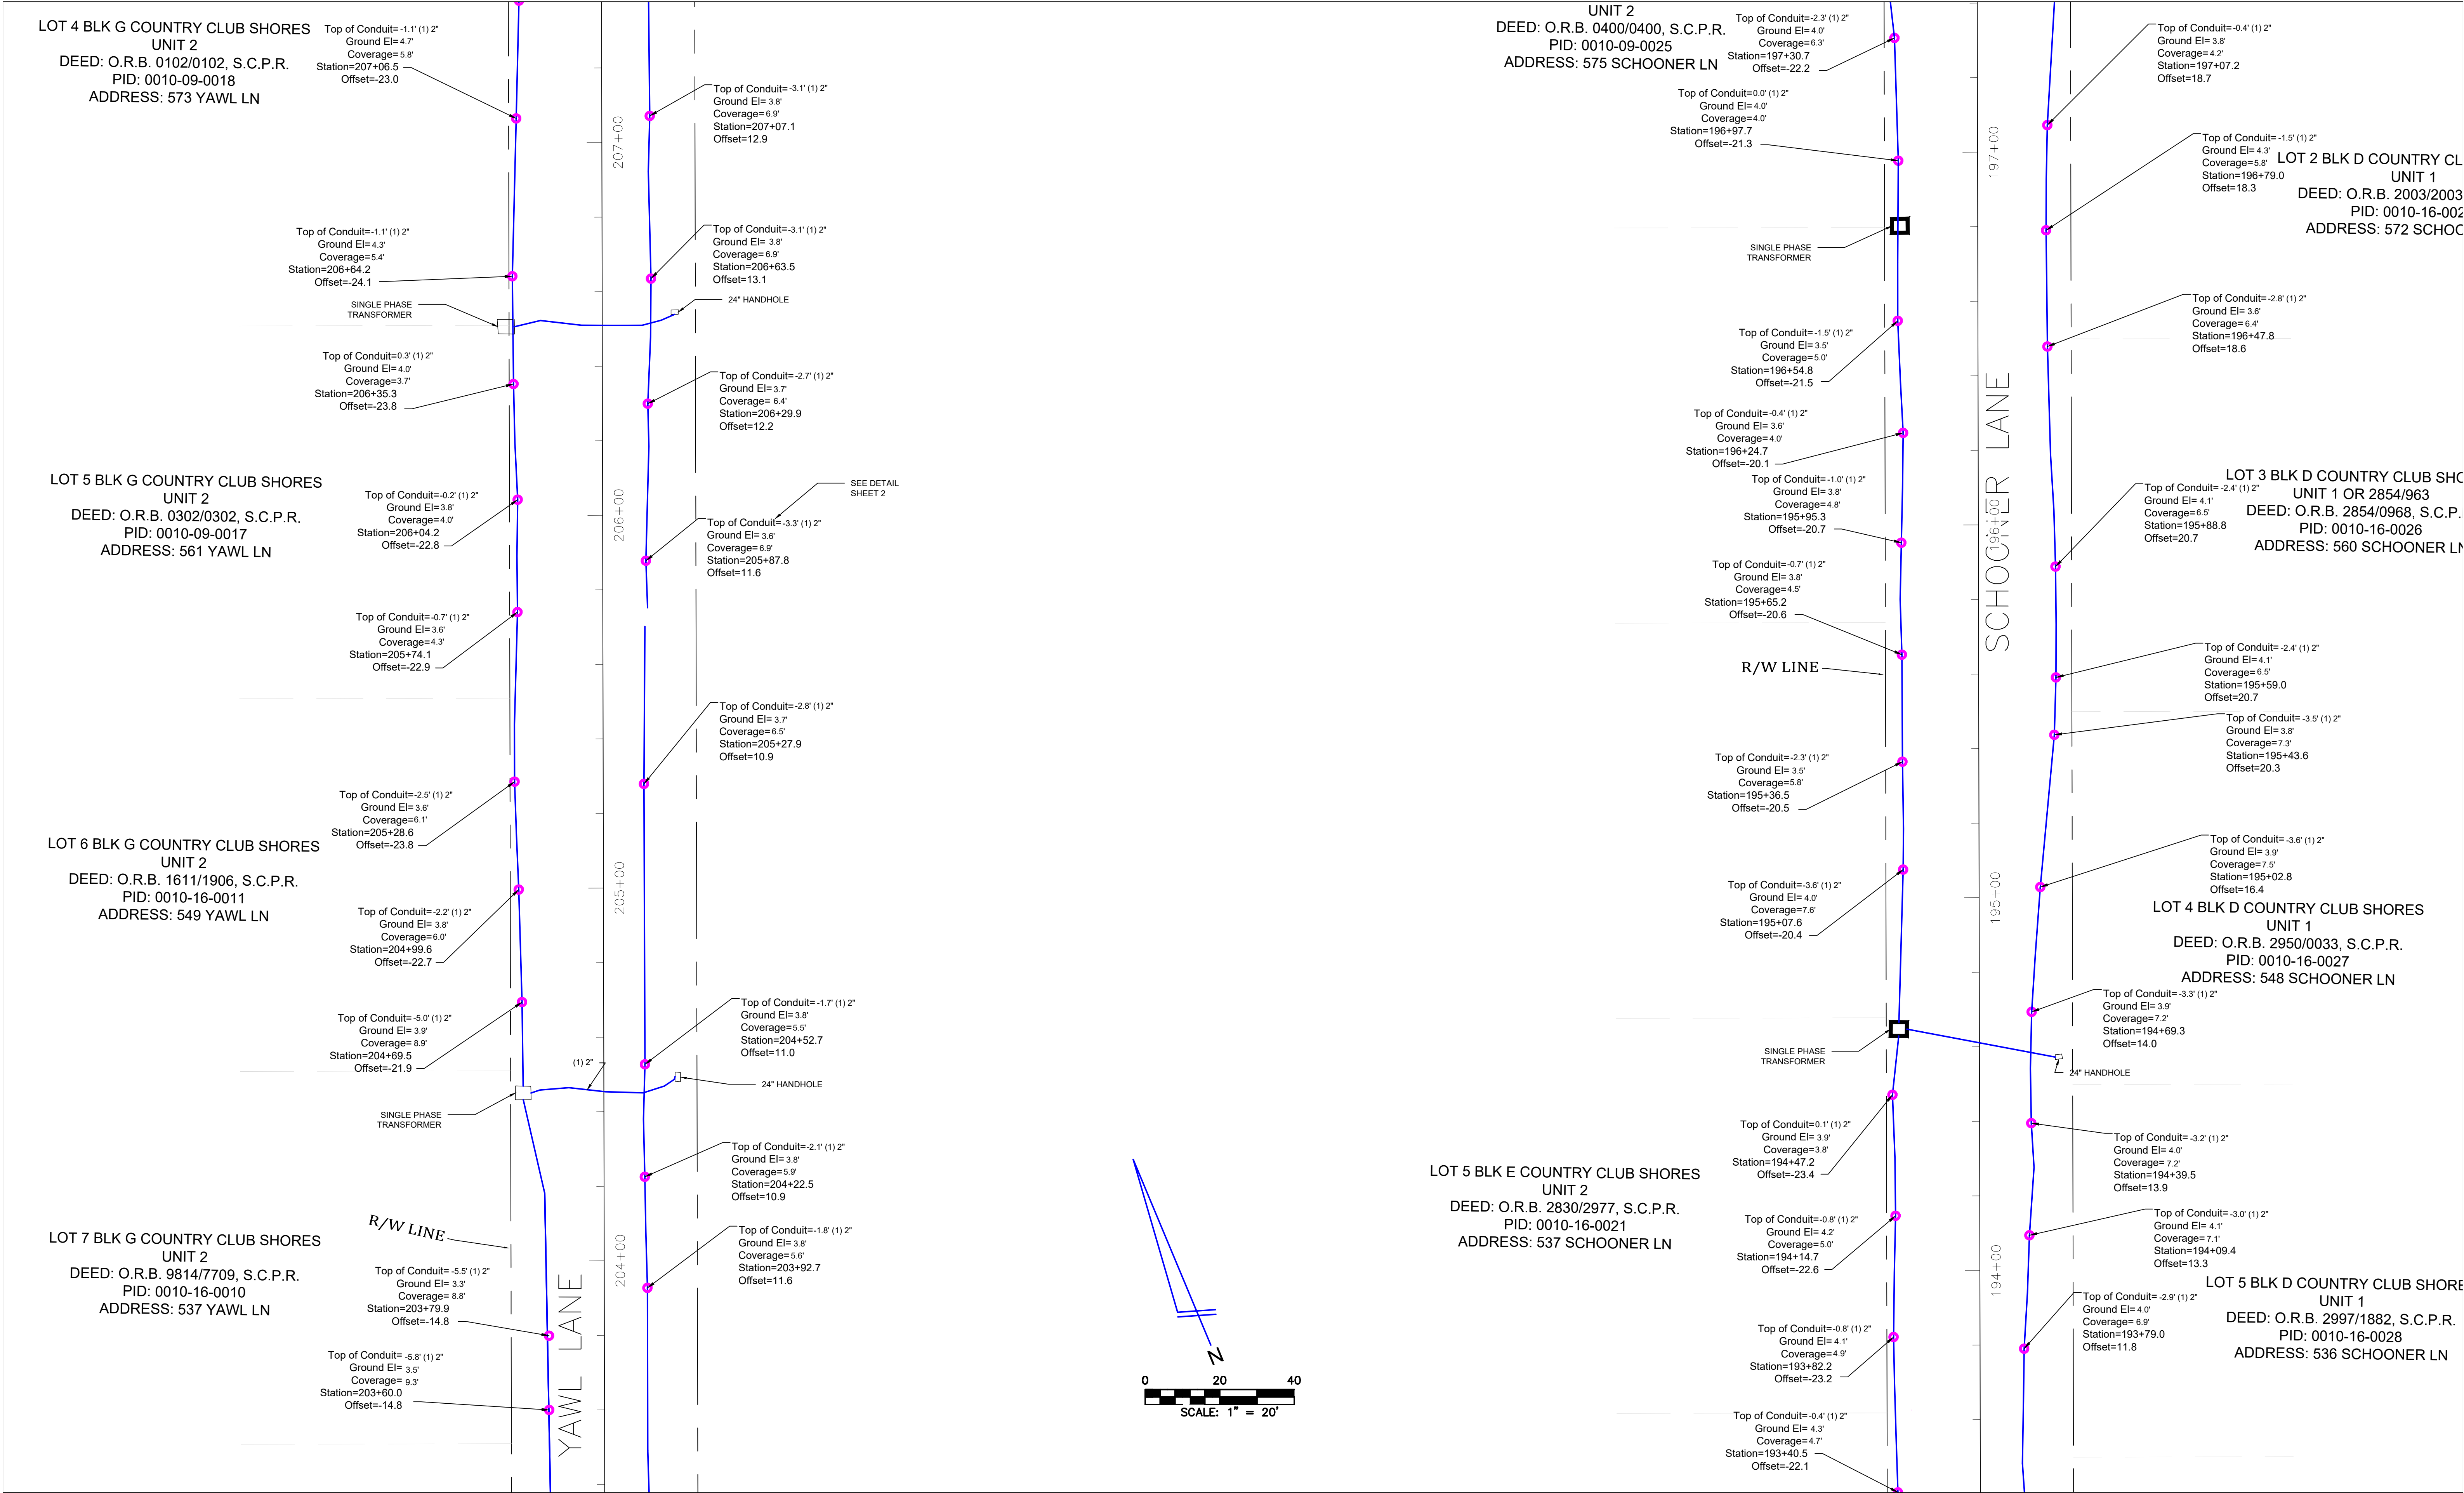


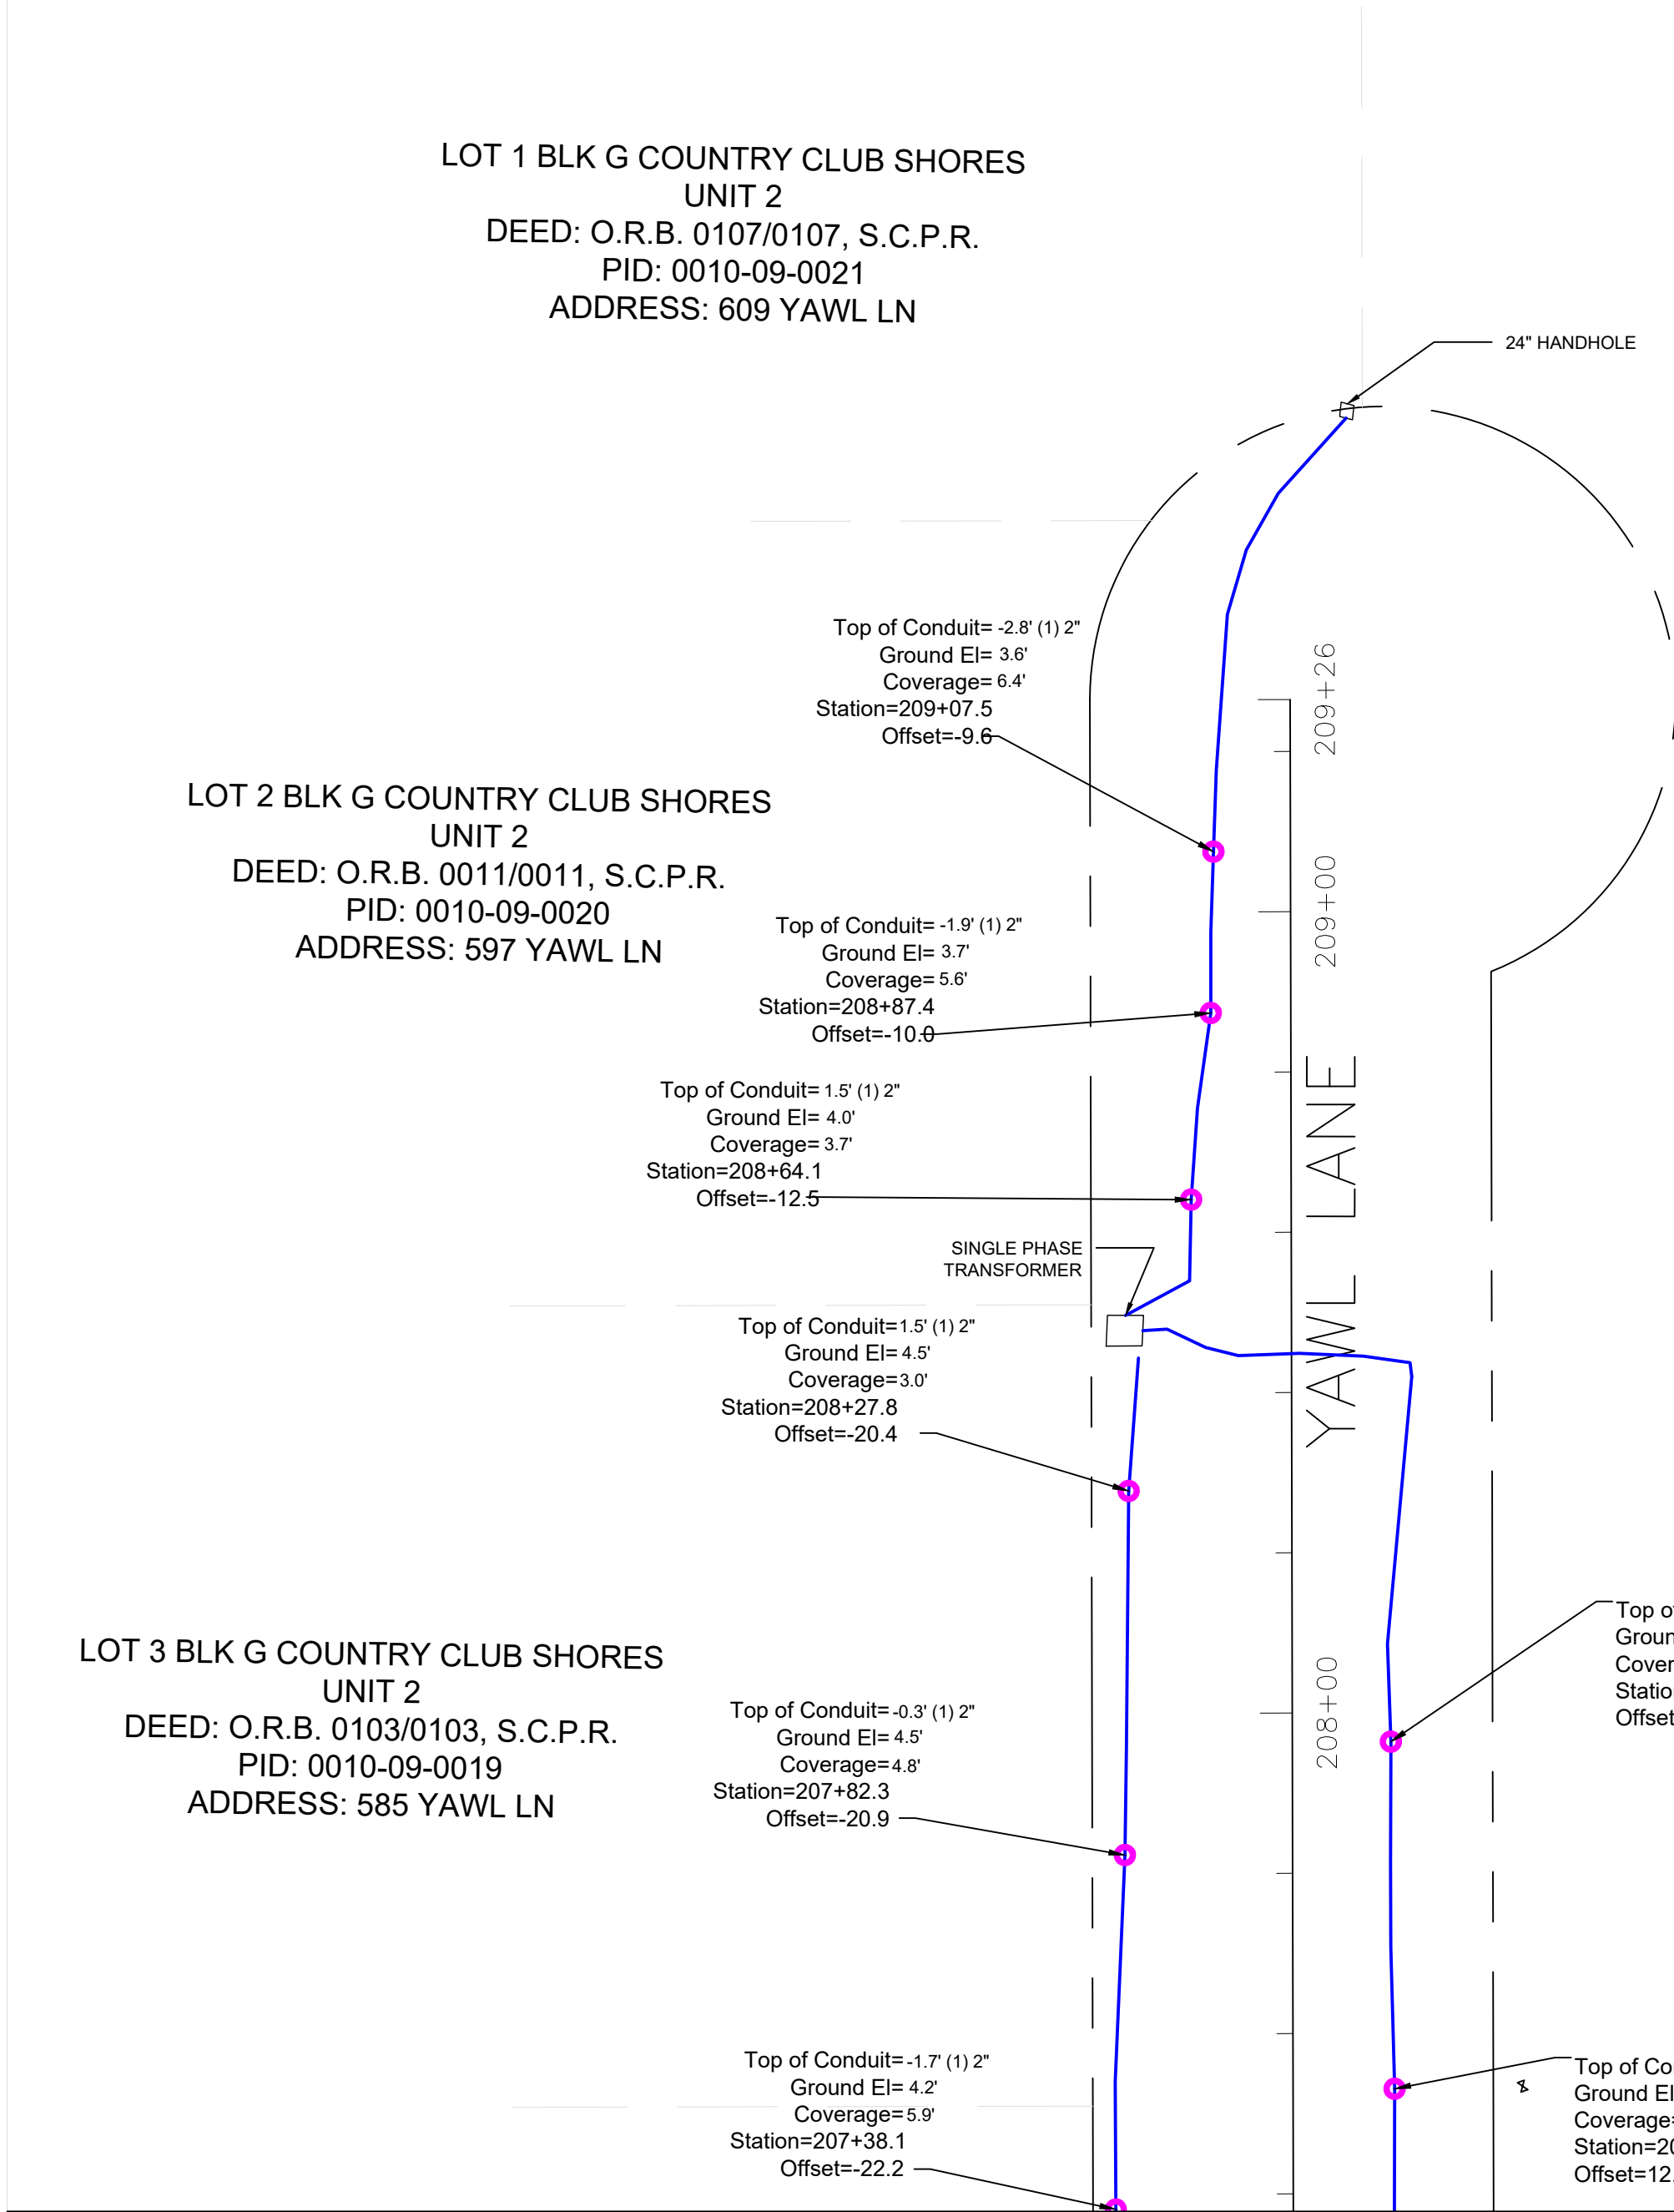

MATCH SHEET 12

LOT 1 BLK E COUNTRY CLUB SHORES
UNIT 2
DEED: O.R.B. 2687/0881, S.C.P.R.
PID: 0010-09-0026
ADDRESS: 585 SCHOONER LN

LOT 1 BLK D COUNTRY CLUB SHORES
UNIT 1
DEED: O.R.B. 3002/2202, S.C.P.R.
PID: 0010-16-0024
ADDRESS: 584 SCHOONER LN

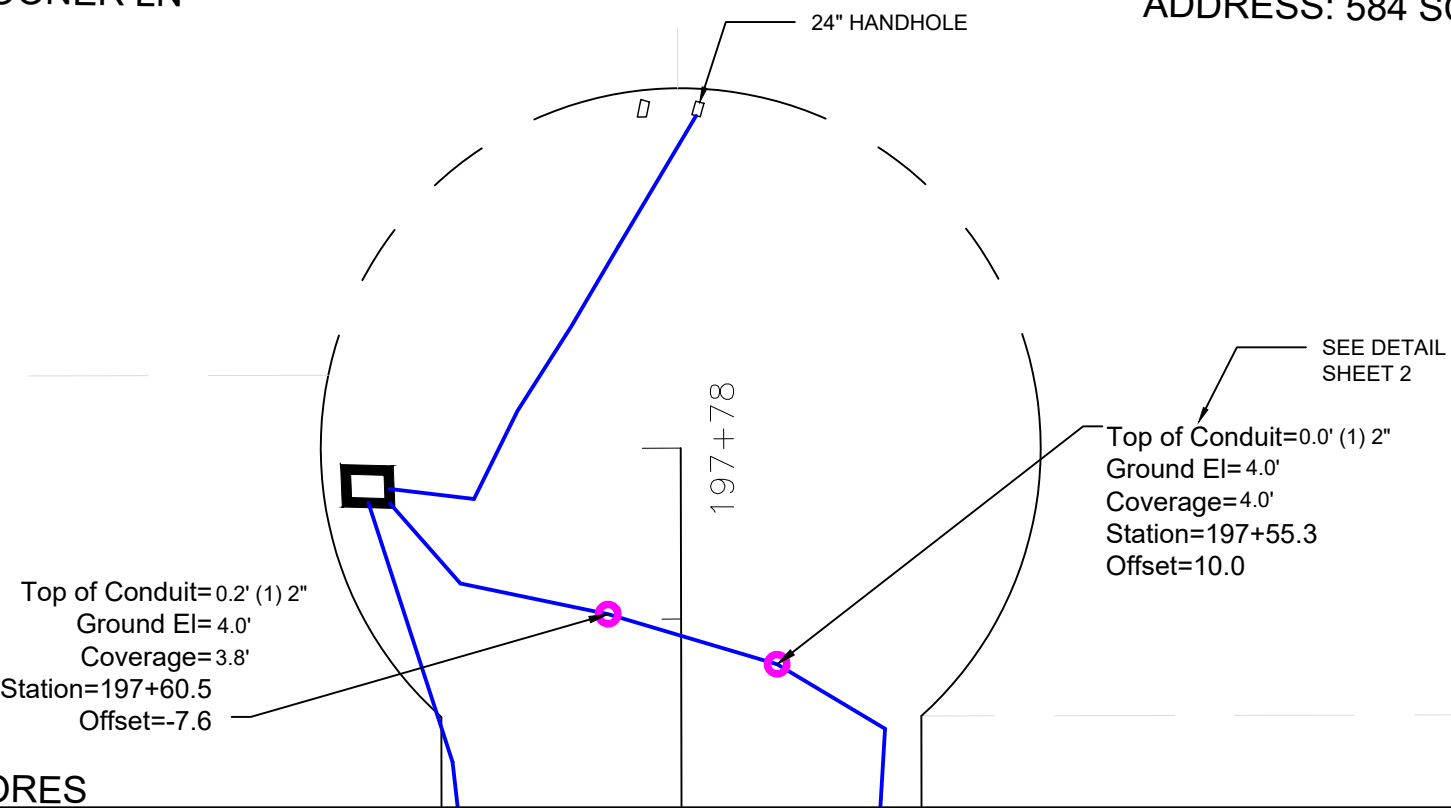

LOT 2 BLK E COUNTRY CLUB SHORES


TITLE: AS-BUILT SURVEY "LONGBOAT KEY UNDERGROUND" (PHASE 1 SOUTH)

LOCATION: SECTIONS 16, 21 & 22, TOWNSHIP 36 SOUTH, RANGE 17 EAST, SARASOTA COUNTY, FLORIDA

BULLSEYE SURVEYING, INC.
LB 7818
2198 NE COACHMAN ROAD, UNIT F, CLEARWATER, FL 33765
Phone: (727) 475-8088


FILE: 19-040-AS-BUILTS	Drawn By: GRM/AMW
PROJECT NUMBER: 19-040	Date: 10/26/2020 Scale: 1" = 20'

SHEET
13
OF 45

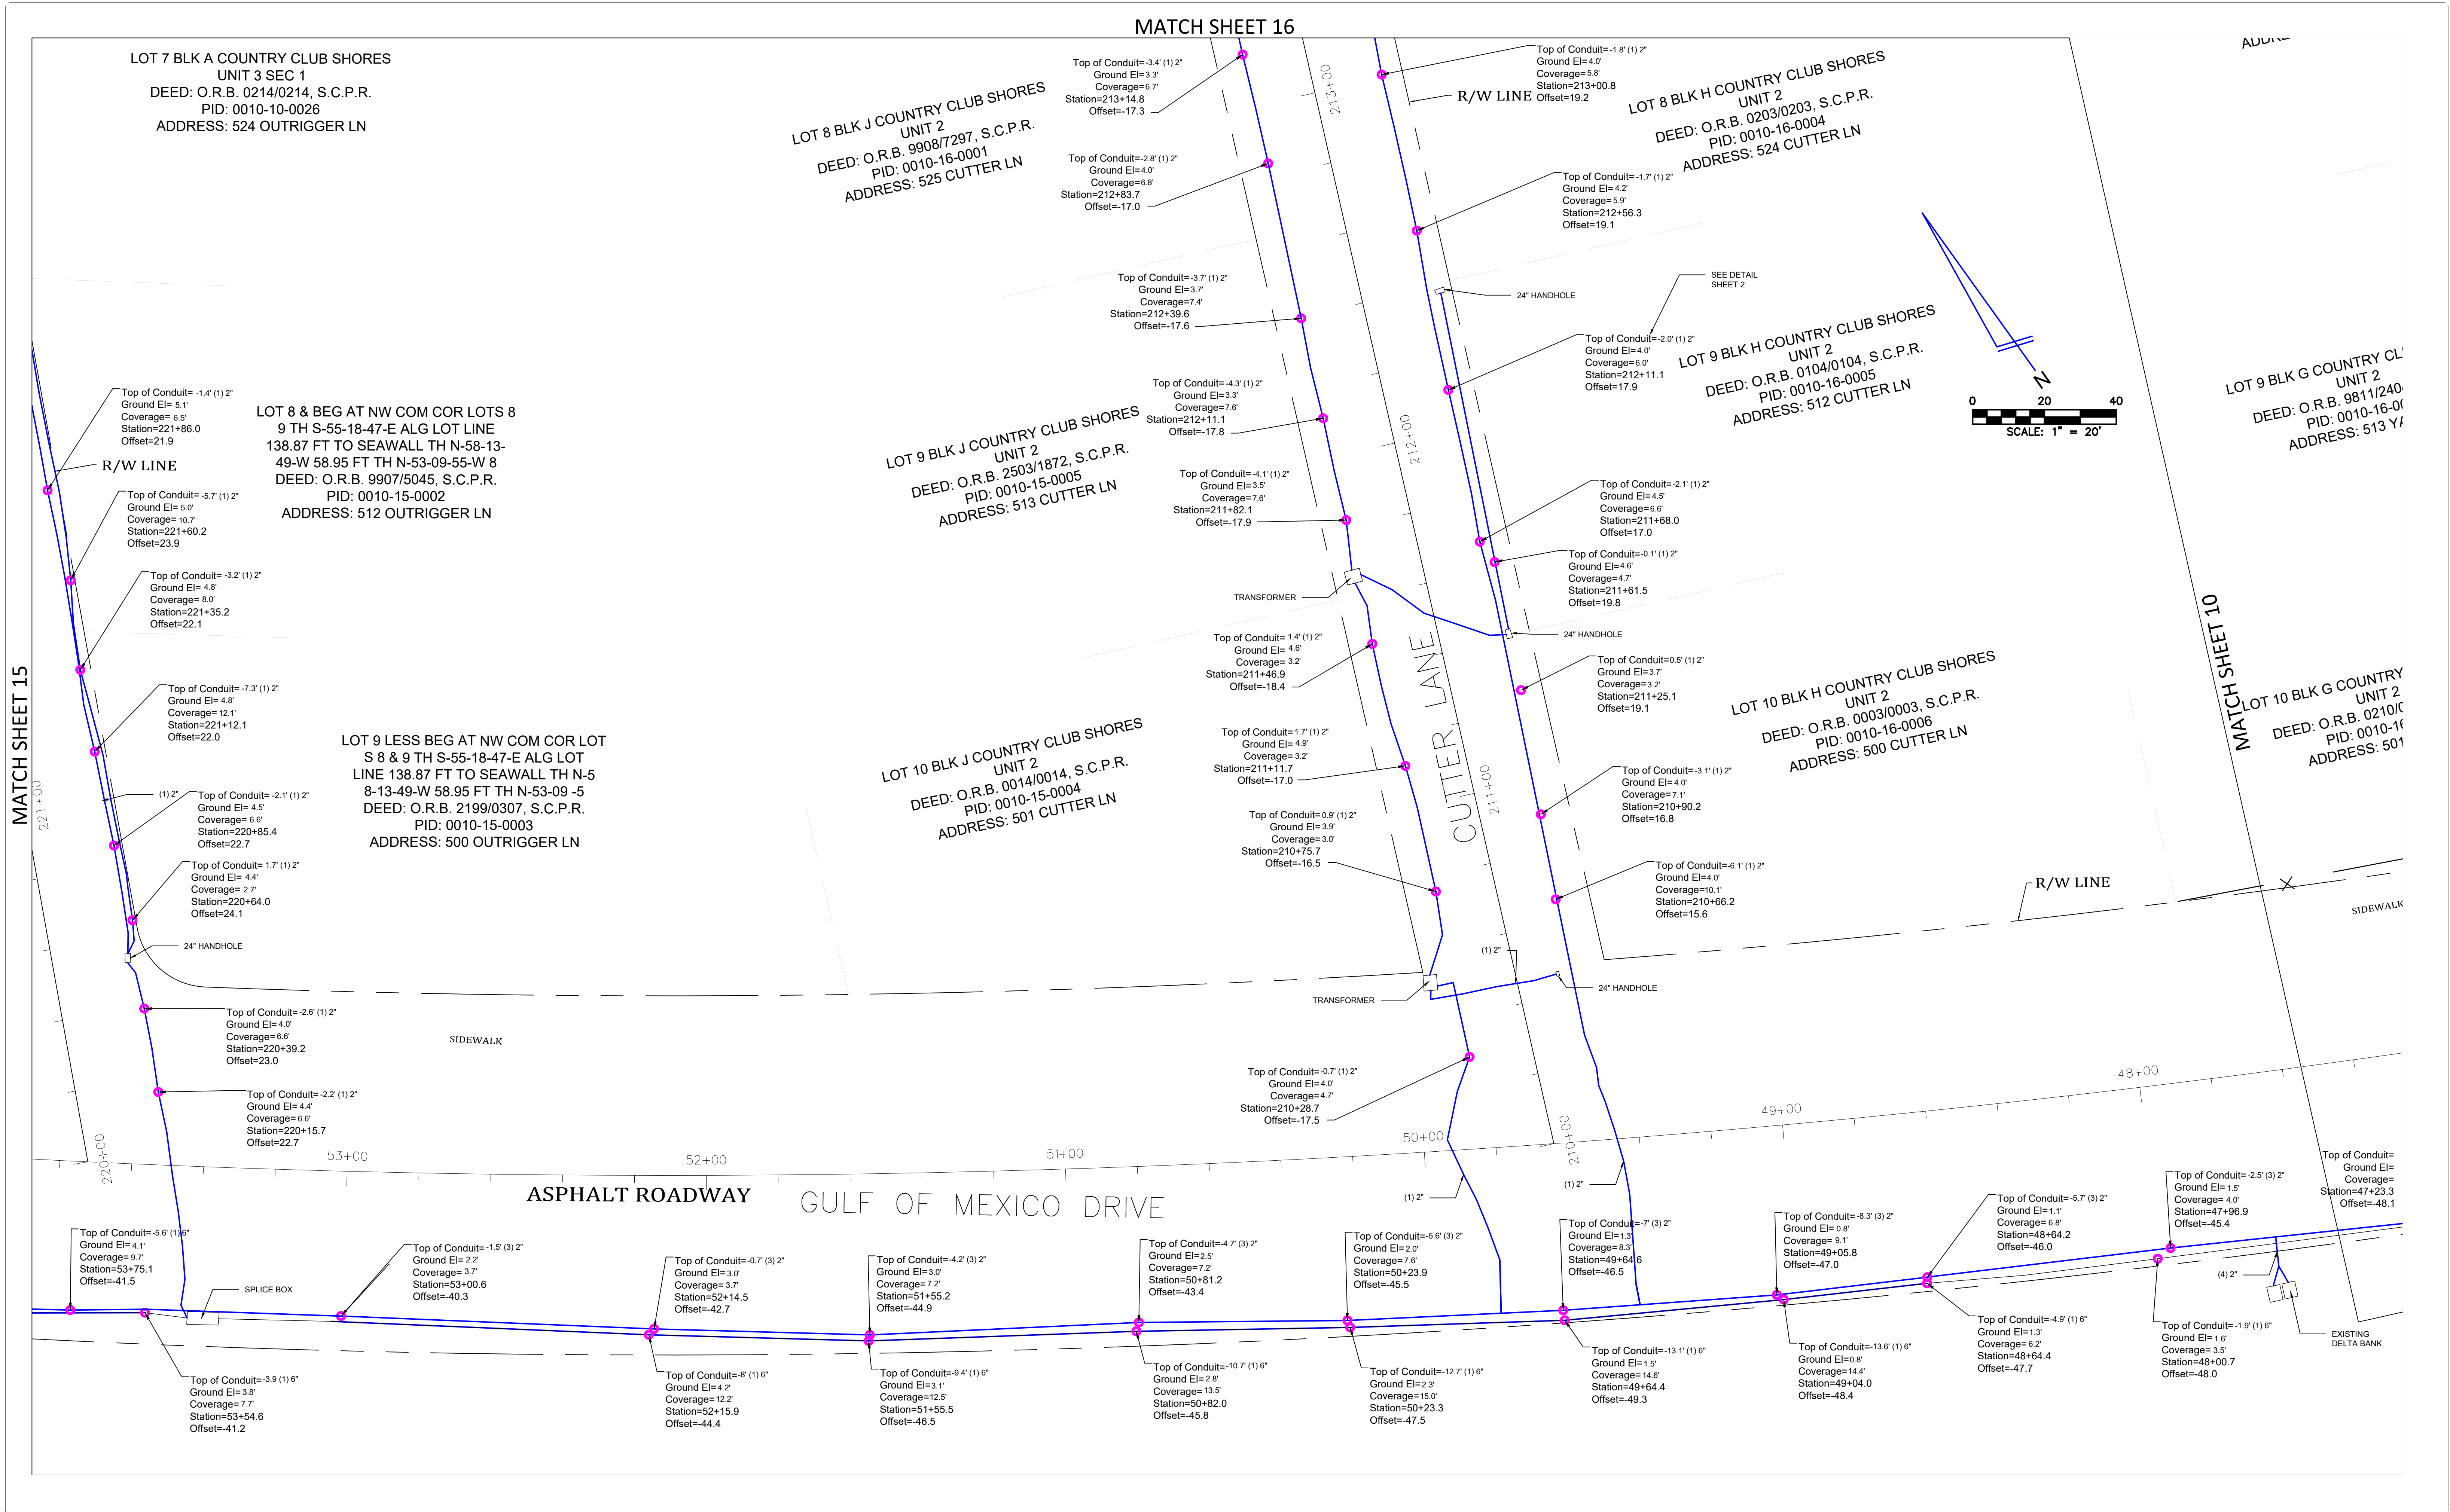

TITLE: AS-BUILT SURVEY "LONGBOAT KEY UNDERGROUND" (PHASE 1 SOUTH)


LOCATION: SECTIONS 16, 21 & 22, TOWNSHIP 36 SOUTH, RANGE 17 EAST, SARASOTA COUNTY, FLORIDA

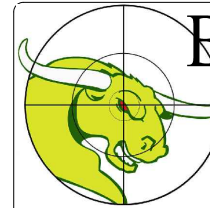

BULLSEYE SURVEYING, INC.
LB 7818
2198 NE COACHMAN ROAD, UNIT F, CLEARWATER, FL 33765
Phone: (727) 475-8088

FILE: 19-040-AS-BUILTS	Drawn By: GRM/AMW	
PROJECT NUMBER: 19-040	Date: 10/26/2020	Scale: 1" = 20'

SHEET
14
OF 45

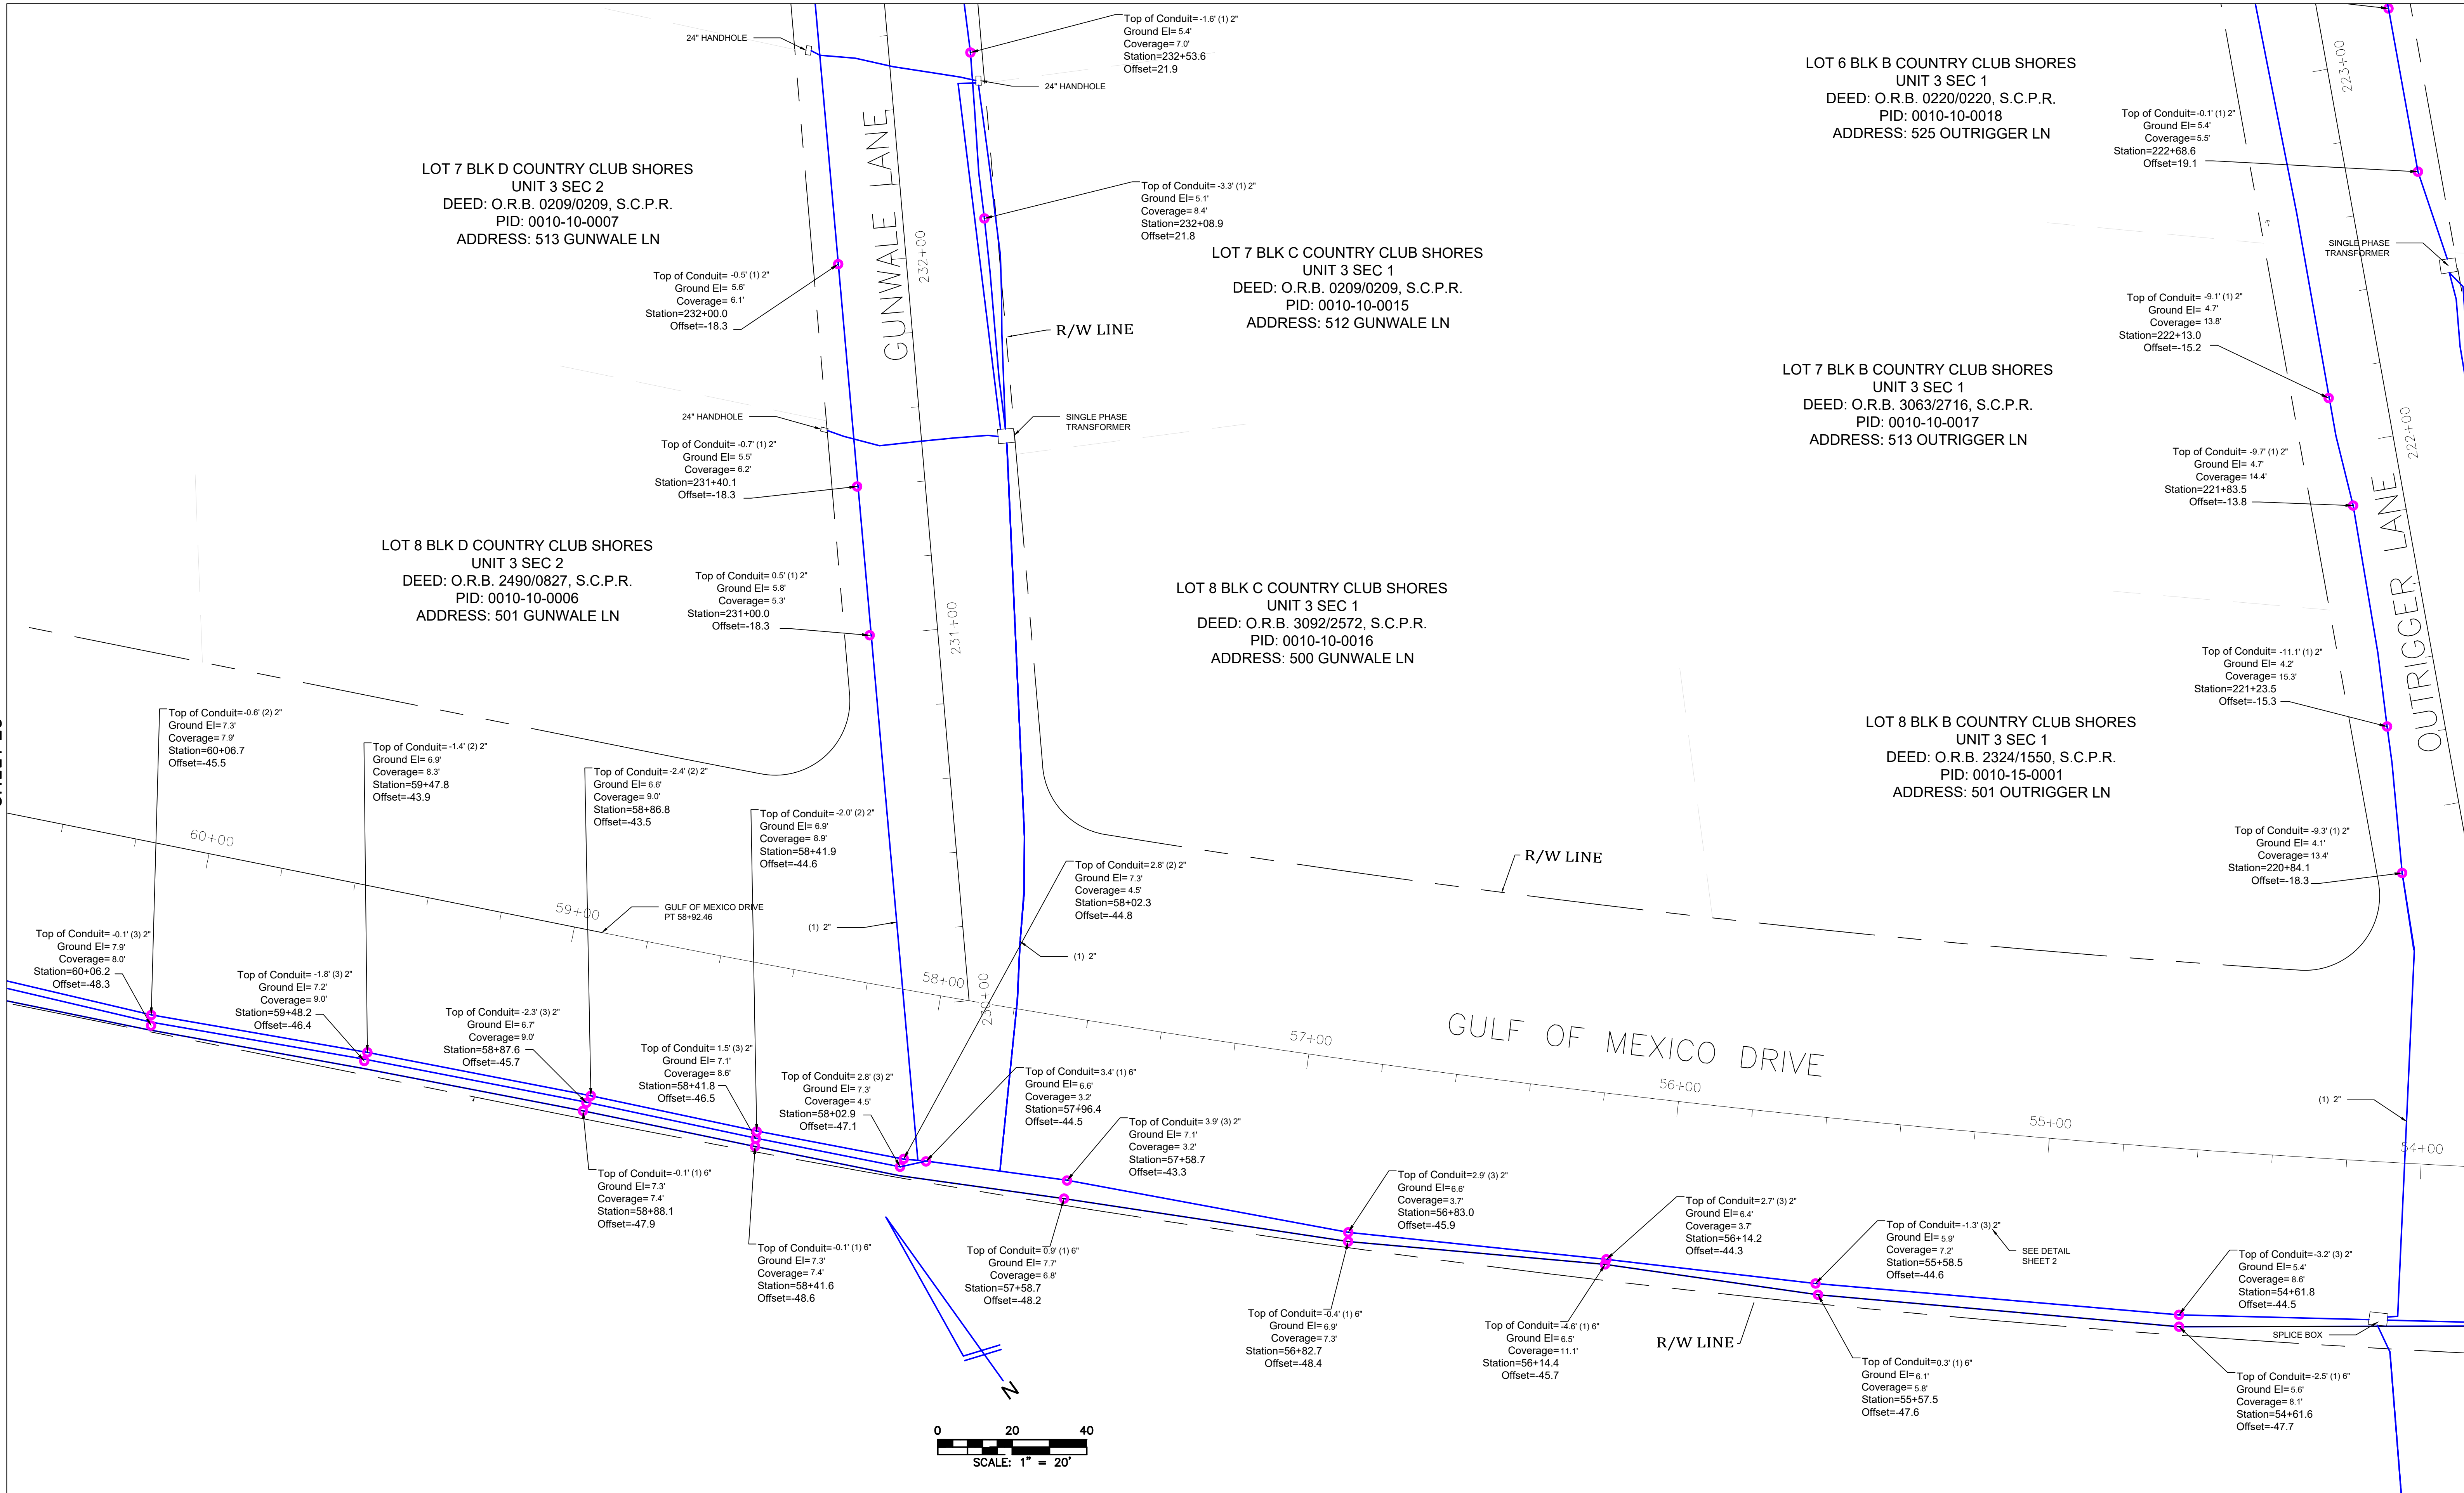

TITLE: AS-BUILT SURVEY "LONGBOAT KEY UNDERGROUND" (PHASE 1 SOUTH)

LOCATION: SECTIONS 16, 21 & 22, TOWNSHIP 36 SOUTH, RANGE 17 EAST, SARASOTA COUNTY, FLORIDA

BULLSEYE SURVEYING, INC.
LB 7818
2198 NE COACHMAN ROAD, UNIT F, CLEARWATER, FL 33765
Phone: (727) 475-8088

FILE: 19-040-AS-BUILTS	Drawn By: GRM/AMW
PROJECT NUMBER: 19-040	Date: 10/26/2020 Scale: 1" = 20'

MATCH SHEET 17

MATCH SHEET 18

LOT 4 BLK J COUNTRY CLUB SHORES
UNIT 2
DEED: O.R.B. 0009/0009, S.C.P.R.
PID: 0010-09-0007
ADDRESS: 573 CUTTER LN

LOT 5 BLK J COUNTRY CLUB SHORES
UNIT 2
DEED: O.R.B. 2988/2042, S.C.P.R.
PID: 0010-09-0006
ADDRESS: 561 CUTTER LN

LOT 6 BLK J COUNTRY CLUB SHORES
UNIT 2
DEED: O.R.B. 0218/0218, S.C.P.R.
PID: 0010-09-0005
ADDRESS: 549 CUTTER LN

LOT 7 BLK J COUNTRY CLUB SHORES
UNIT 2
DEED: O.R.B. 0001/0001, S.C.P.R.
PID: 0010-16-0002
ADDRESS: 537 CUTTER LN

LOT 4 BLK H COUNTRY CLUB SHORES
UNIT 2
DEED: O.R.B. 2942/0970, S.C.P.R.
PID: 0010-09-0014
ADDRESS: 572 CUTTER LA

LOT 5 BLK H COUNTRY CLUB SHORES
UNIT 2
DEED: O.R.B. 2586/0999, S.C.P.R.
PID: 0010-09-0015
ADDRESS: 560 CUTTER LN

LOT 6 BLK H COUNTRY CLUB SHORES
UNIT 2
DEED: O.R.B. 2925/1508, S.C.P.R.
PID: 0010-09-0016
ADDRESS: 548 CUTTER LN

LOT 7 BLK H COUNTRY CLUB SHORES
UNIT 2
DEED: O.R.B. 0006/0006, S.C.P.R.
PID: 0010-16-0003
ADDRESS: 536 CUTTER LN

LOT 5 BLK G COUNTRY CLUB SHORES
UNIT 2
DEED: O.R.B. 0302/0302, S.C.P.R.
PID: 0010-09-0017
ADDRESS: 561 YAWL LN


LOT 6 BLK G COUNTRY CLUB SHORES
UNIT 2
DEED: O.R.B. 1611/1906, S.C.P.R.
PID: 0010-16-0011
ADDRESS: 549 YAWL LN

LOT 7 BLK G COUNTRY CLUB SHORES
UNIT 2
DEED: O.R.B. 9814/7709, S.C.P.R.
PID: 0010-16-0010
ADDRESS: 537 YAWL LN

LOT 8 BLK G COUNTRY CLUB SHORES
UNIT 2
DEED: O.R.B. 0104/0104, S.C.P.
PID: 0010-16-0009
ADDRESS: 525 YAWL LN


MATCH SHEET 14

MATCH SHEET 12

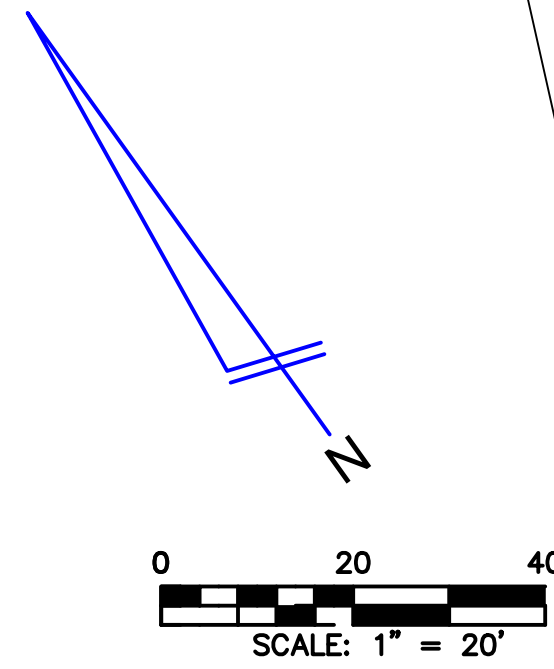

TITLE: AS-BUILT SURVEY "LONGBOAT KEY UNDERGROUND" (PHASE 1 SOUTH)

LOCATION: SECTIONS 16, 21 & 22, TOWNSHIP 36 SOUTH, RANGE 17 EAST, SARASOTA COUNTY, FLORIDA

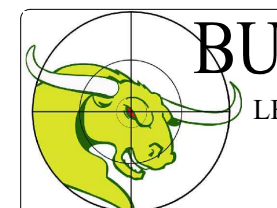

BULLSEYE SURVEYING, INC.


LB 7818
2198 NE COACHMAN ROAD, UNIT F, CLEARWATER, FL 33765
Phone: (727) 475-8088

FILE: 19-040-AS-BUILTS
PROJECT NUMBER: 19-040

Drawn By: GRM/AMW
Date: 10/26/2020


Scale: 1" = 20'

SHEET
16
OF 45

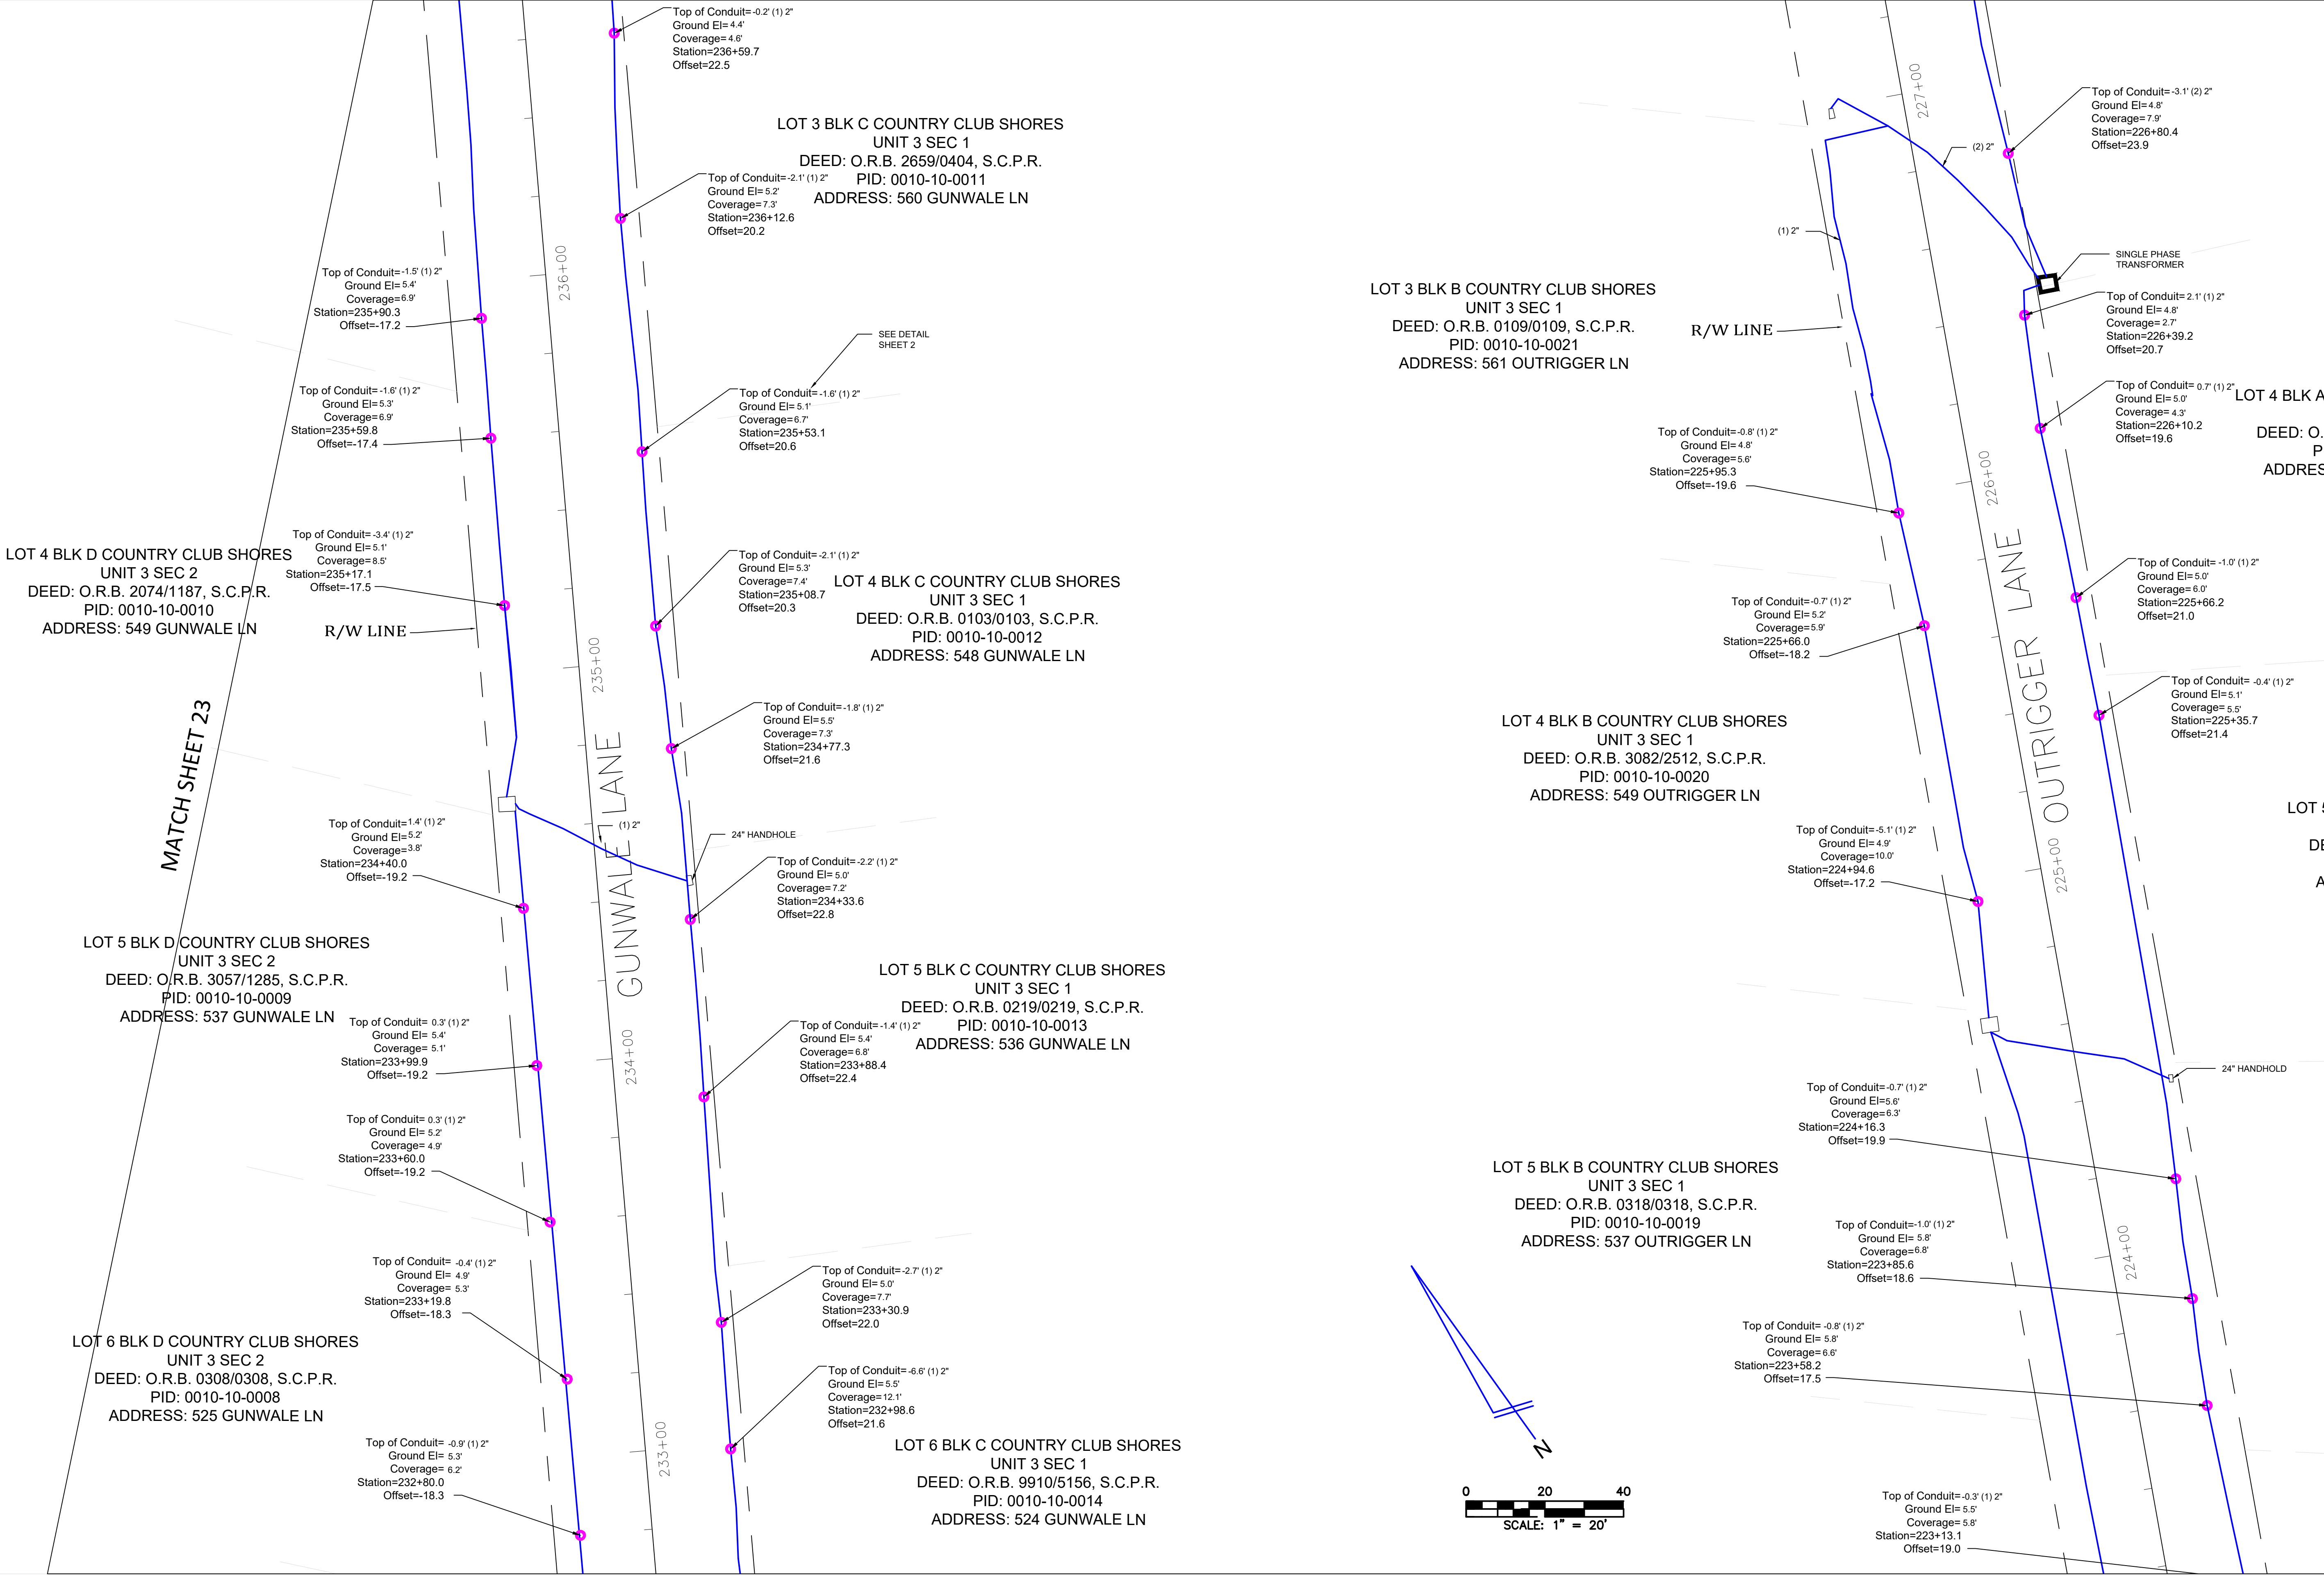

TITLE: AS-BUILT SURVEY "LONGBOAT KEY UNDERGROUND" (PHASE 1 SOUTH)

LOCATION: SECTIONS 16, 21 & 22, TOWNSHIP 36 SOUTH, RANGE 17 EAST, SARASOTA COUNTY, FLORIDA

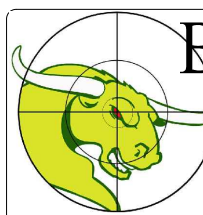

BULLSEYE SURVEYING, INC.
LB 7818
2198 NE COACHMAN ROAD, UNIT F, CLEARWATER, FL 33765
Phone: (727) 475-8088

FILE: 19-040-AS-BUILTS	Drawn By: GRM/AMW	Scale: 1" = 20'
PROJECT NUMBER: 19-040	Date: 10/26/2020	

MATCH SHEET 19

LOT 1 BLK J COUNTRY CLUB SHORES
UNIT 2
DEED: O.R.B. 0306/0306, S.C.P.R.
PID: 0010-09-0010
ADDRESS: 609 CUTTER LN

LOT 1 BLK H COUNTRY CLUB SHORES
UNIT 2
DEED: O.R.B. 0305/0305, S.C.P.R.
PID: 0010-09-0011
ADDRESS: 608 CUTTER LN

LOT 1 BLK G COUNTRY CLUB SHORES
UNIT 2
DEED: O.R.B. 0107/0107, S.C.P.R.
PID: 0010-09-0021
ADDRESS: 609 YAWL LN

LOT 2 BLK J COUNTRY CLUB SHORES
UNIT 2
DEED: O.R.B. 3001/2053, S.C.P.R.
PID: 0010-09-0009
ADDRESS: 597 CUTTER LN

LOT 2 BLK H COUNTRY CLUB SHORES
UNIT 2
DEED: O.R.B. 2478/2008, S.C.P.R.
PID: 0010-09-0012
ADDRESS: 584 CUTTER LN


LOT 2 BLK G COUNTRY CLUB SHORES
UNIT 2
DEED: O.R.B. 0011/0011, S.C.P.R.
PID: 0010-09-0020
ADDRESS: 597 YAWL LN

LOT 3 BLK J COUNTRY CLUB SHORES
UNIT 2 ORI 2001186173
DEED: O.R.B. 0318/0318, S.C.P.R.
PID: 0010-09-0008
ADDRESS: 585 CUTTER LN

LOT 3 BLK H COUNTRY CLUB SHORES
UNIT 2
DEED: O.R.B. 0115/0115, S.C.P.R.
PID: 0010-09-0013
ADDRESS: 576 CUTTER LN

LOT 3 BLK G COUNTRY CLUB SHORES
UNIT 2
DEED: O.R.B. 0103/0103, S.C.P.R.
PID: 0010-09-0019
ADDRESS: 585 YAWL LN

LOT 4 BLK G COUNTRY CLUB SHORES
UNIT 2
DEED: O.R.B. 0102/0102, S.C.P.R.
PID: 0010-09-0018
ADDRESS: 573 YAWL LN

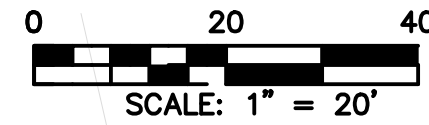


MATCH SHEET 16

MATCH SHEET 13

TITLE: AS-BUILT SURVEY "LONGBOAT KEY UNDERGROUND" (PHASE 1 SOUTH)


LOCATION: SECTIONS 16, 21 & 22, TOWNSHIP 36 SOUTH, RANGE 17 EAST, SARASOTA COUNTY, FLORIDA

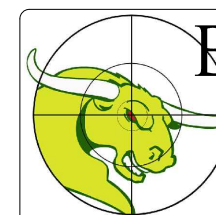

BULLSEYE SURVEYING, INC.
LB 7818
2198 NE COACHMAN ROAD, UNIT F, CLEARWATER, FL 33765
Phone: (727) 475-8088

FILE: 19-040-AS-BUILTS	Drawn By: GRM/AMW
PROJECT NUMBER: 19-040	Date: 10/26/2020
	Scale: 1" = 20'


SHEET
18
OF 45

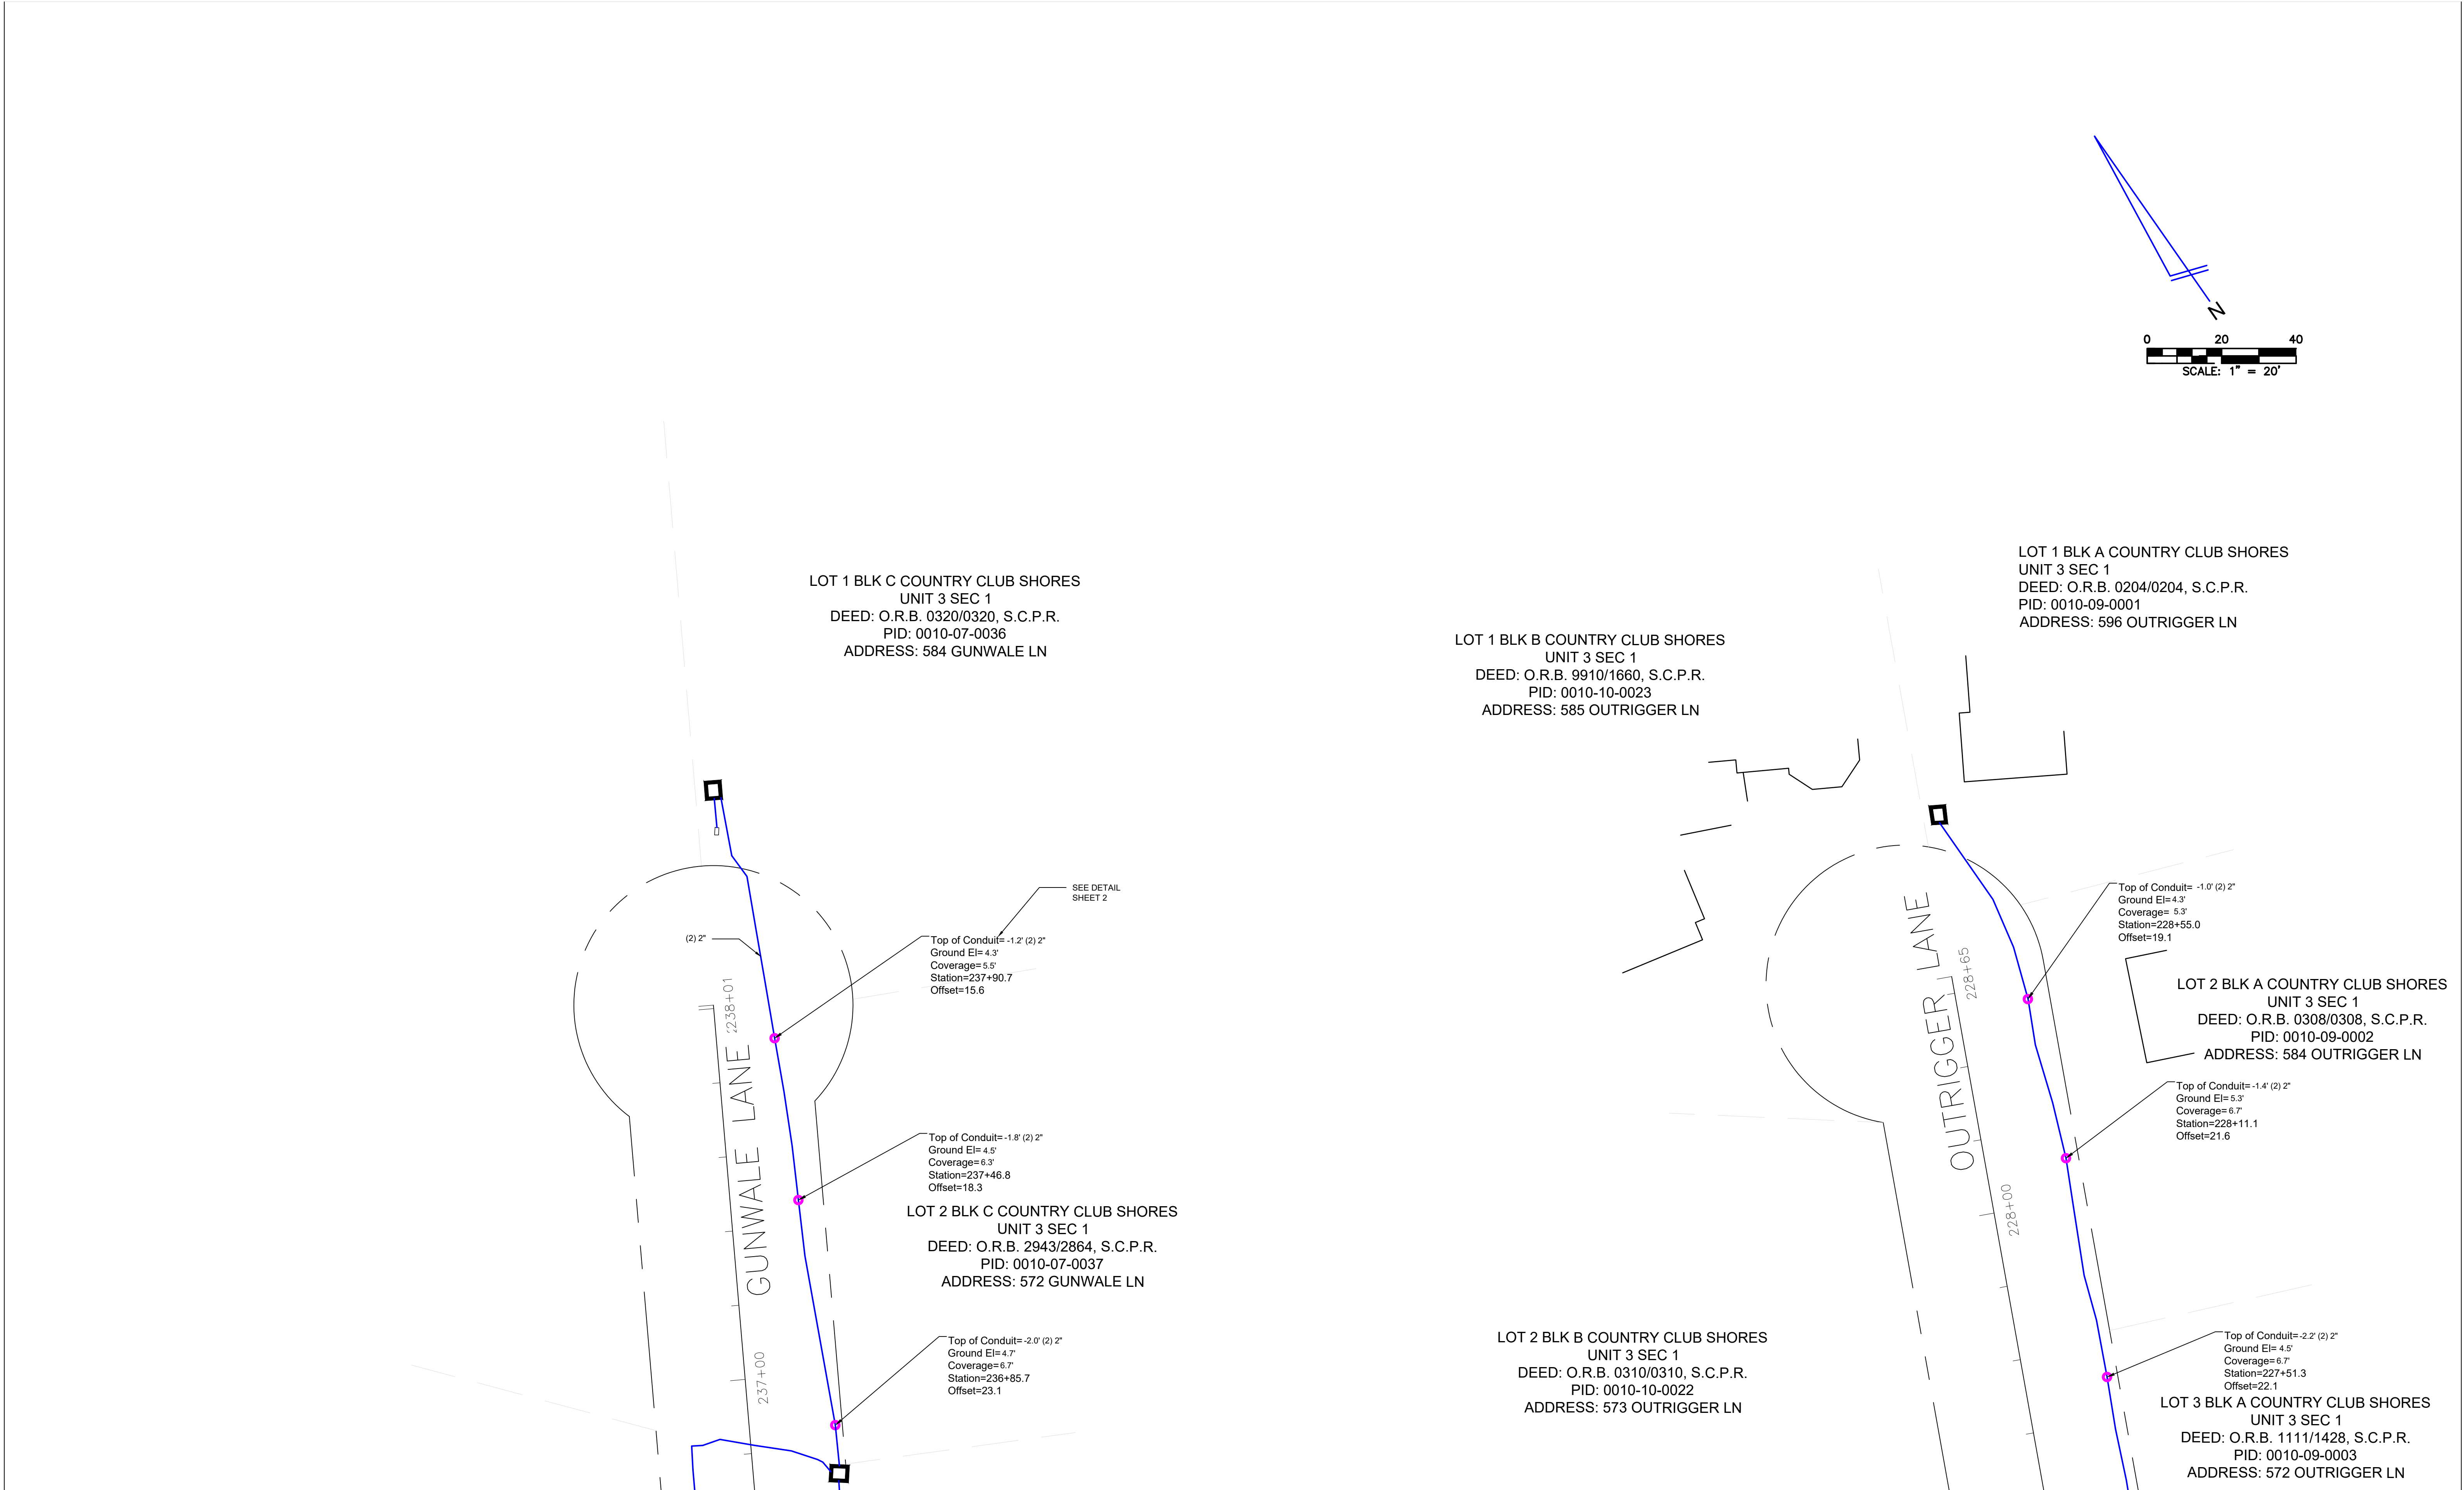

MATCH SHEET 17

TITLE: AS-BUILT SURVEY "LONGBOAT KEY UNDERGROUND" (PHASE 1 SOUTH)

LOCATION: SECTIONS 16, 21 & 22, TOWNSHIP 36 SOUTH, RANGE 17 EAST, SARASOTA COUNTY, FLORIDA

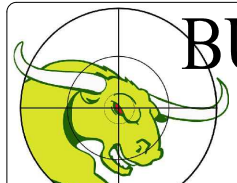


BULLSEYE SURVEYING, INC.
LB 7818
2198 NE COACHMAN ROAD, UNIT F, CLEARWATER, FL 33765
Phone: (727) 475-8088

FILE: 19-040-AS-BUILTS	Drawn By: GRM/AMW
PROJECT NUMBER: 19-040	Date: 10/26/2020
	Scale: 1" = 20'

MATCH SHEET 23

MATCH SHEET 23

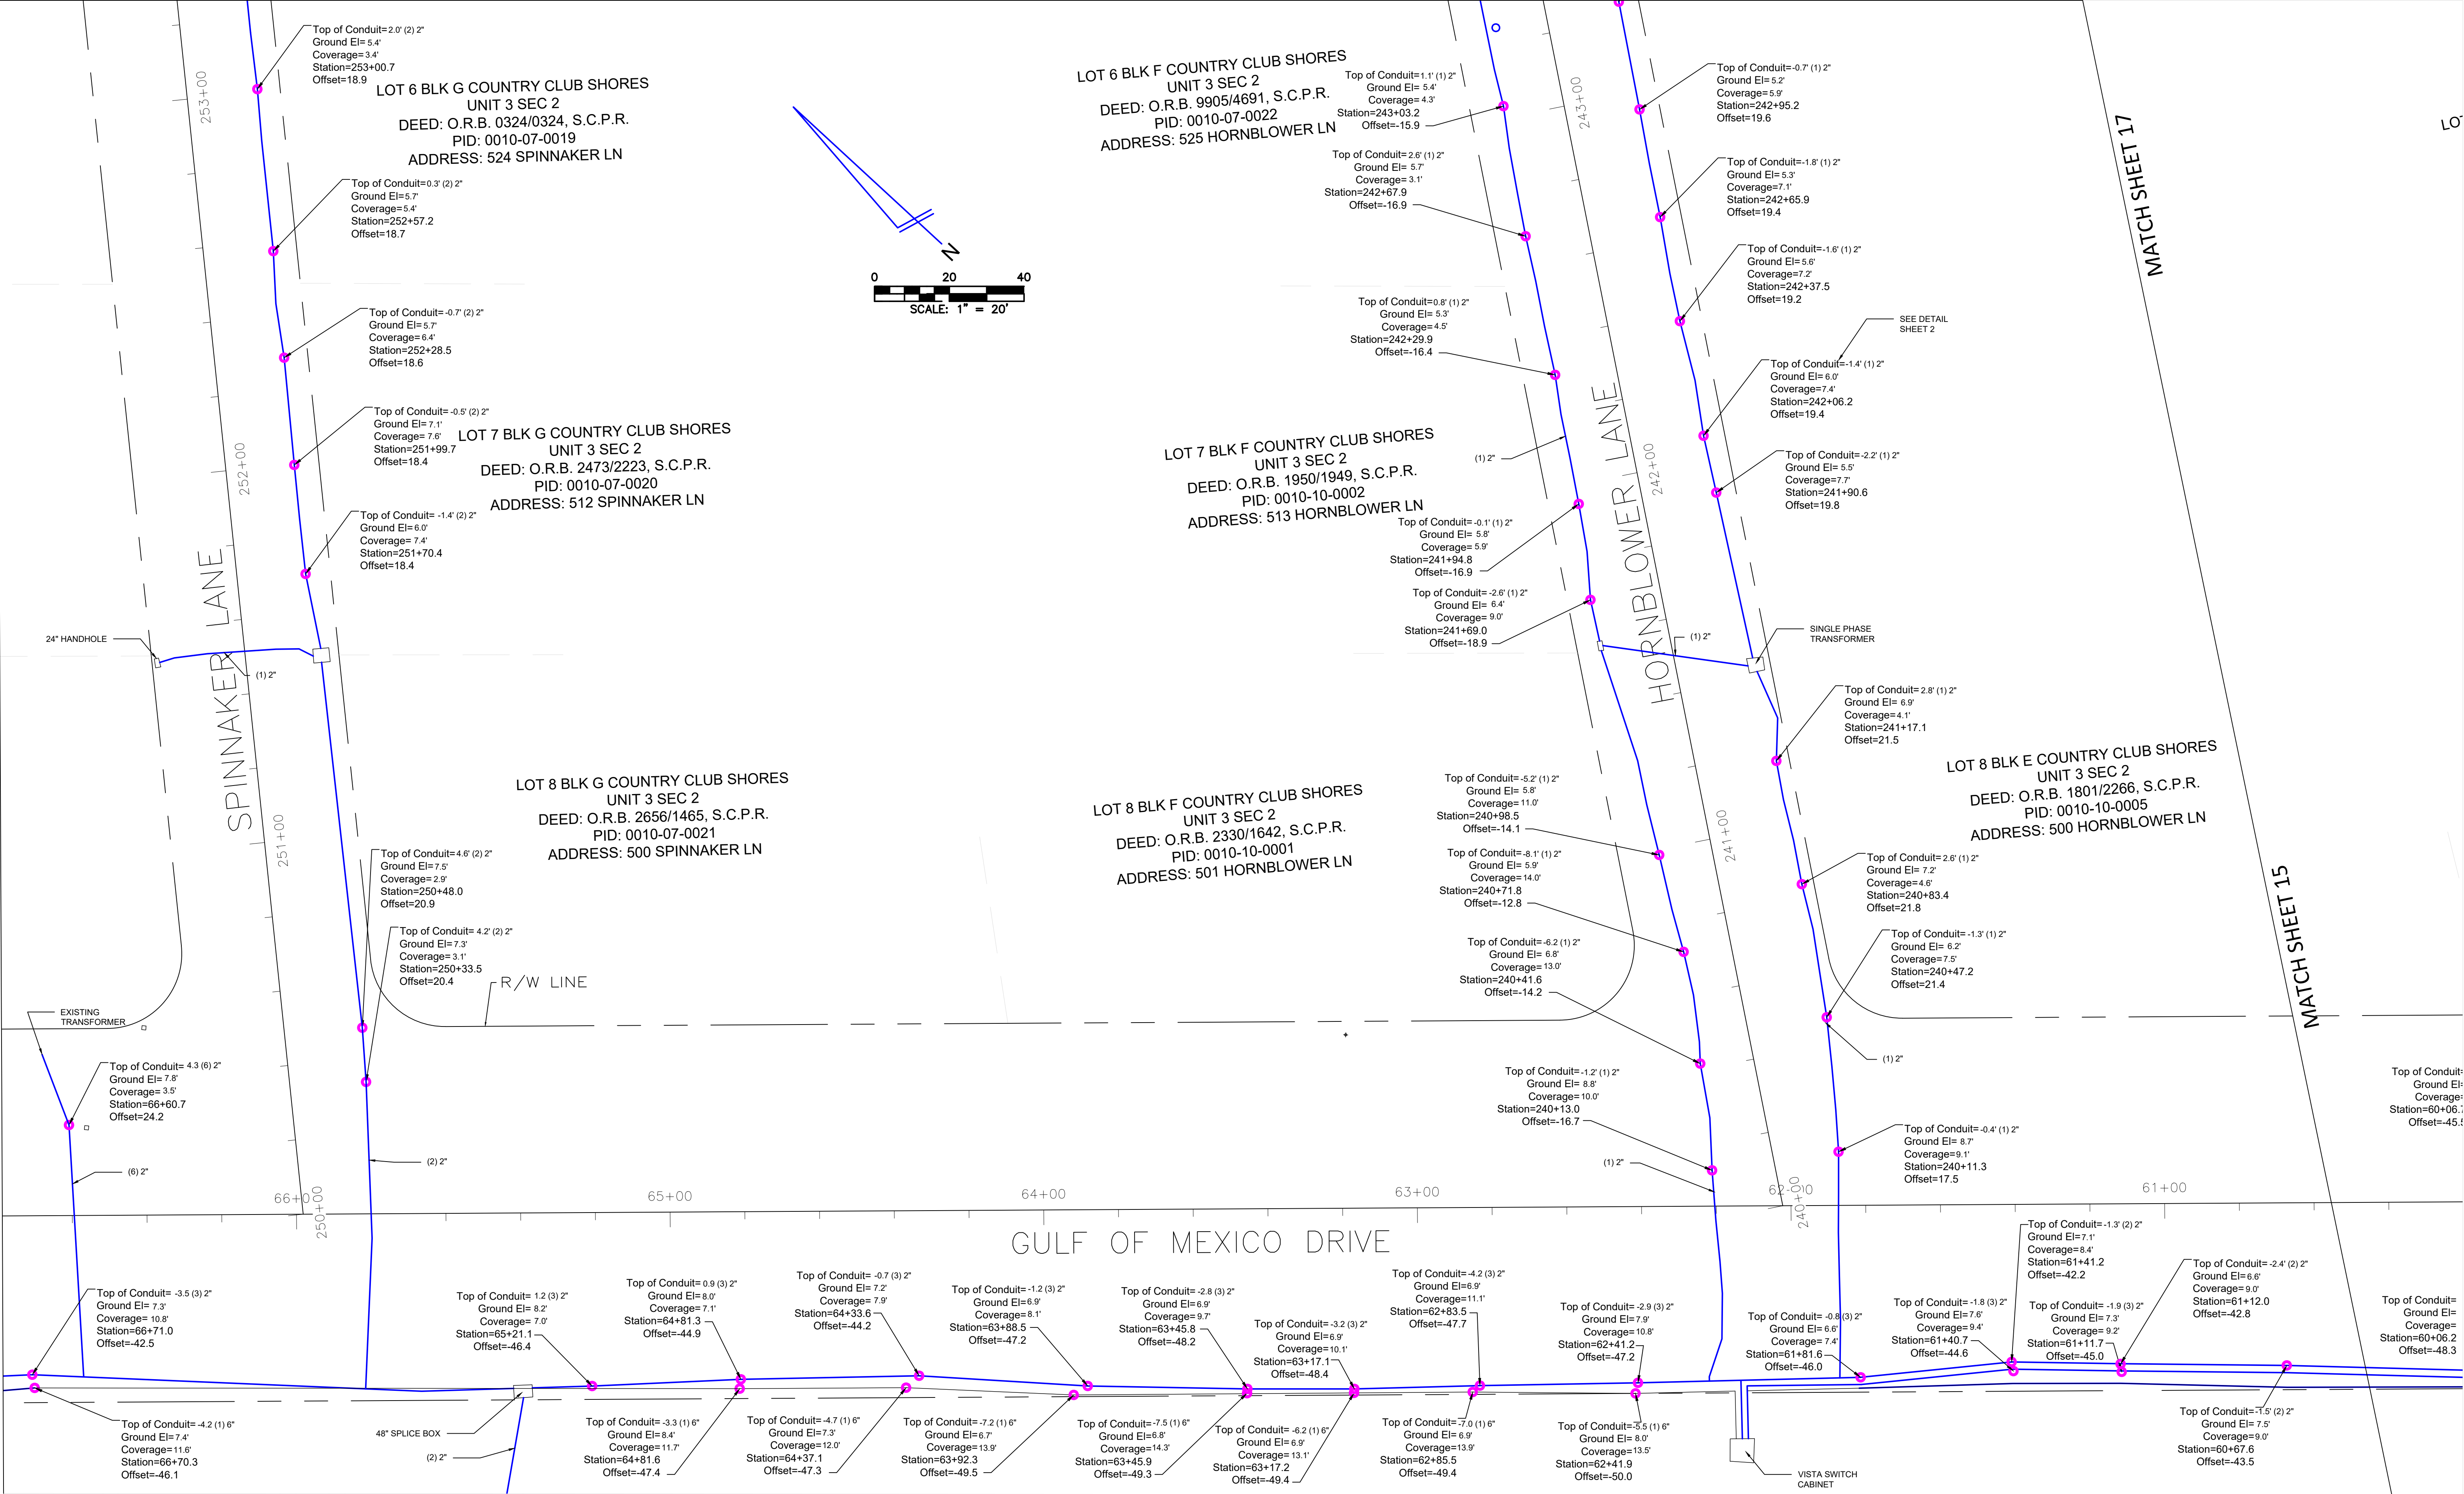

TITLE: AS-BUILT SURVEY "LONGBOAT KEY UNDERGROUND" (PHASE 1 SOUTH)

LOCATION: SECTIONS 16, 21 & 22, TOWNSHIP 36 SOUTH, RANGE 17 EAST, SARASOTA COUNTY, FLORIDA


BULLSEYE SURVEYING, INC.
LB 7818
2198 NE COACHMAN ROAD, UNIT F, CLEARWATER, FL 33765
Phone: (727) 475-8088


FILE: 19-040-AS-BUILTS
PROJECT NUMBER: 19-040


Drawn By: GRM/AMW
Date: 10/26/2020

Scale: 1" = 20'

SHEET
20
OF 45

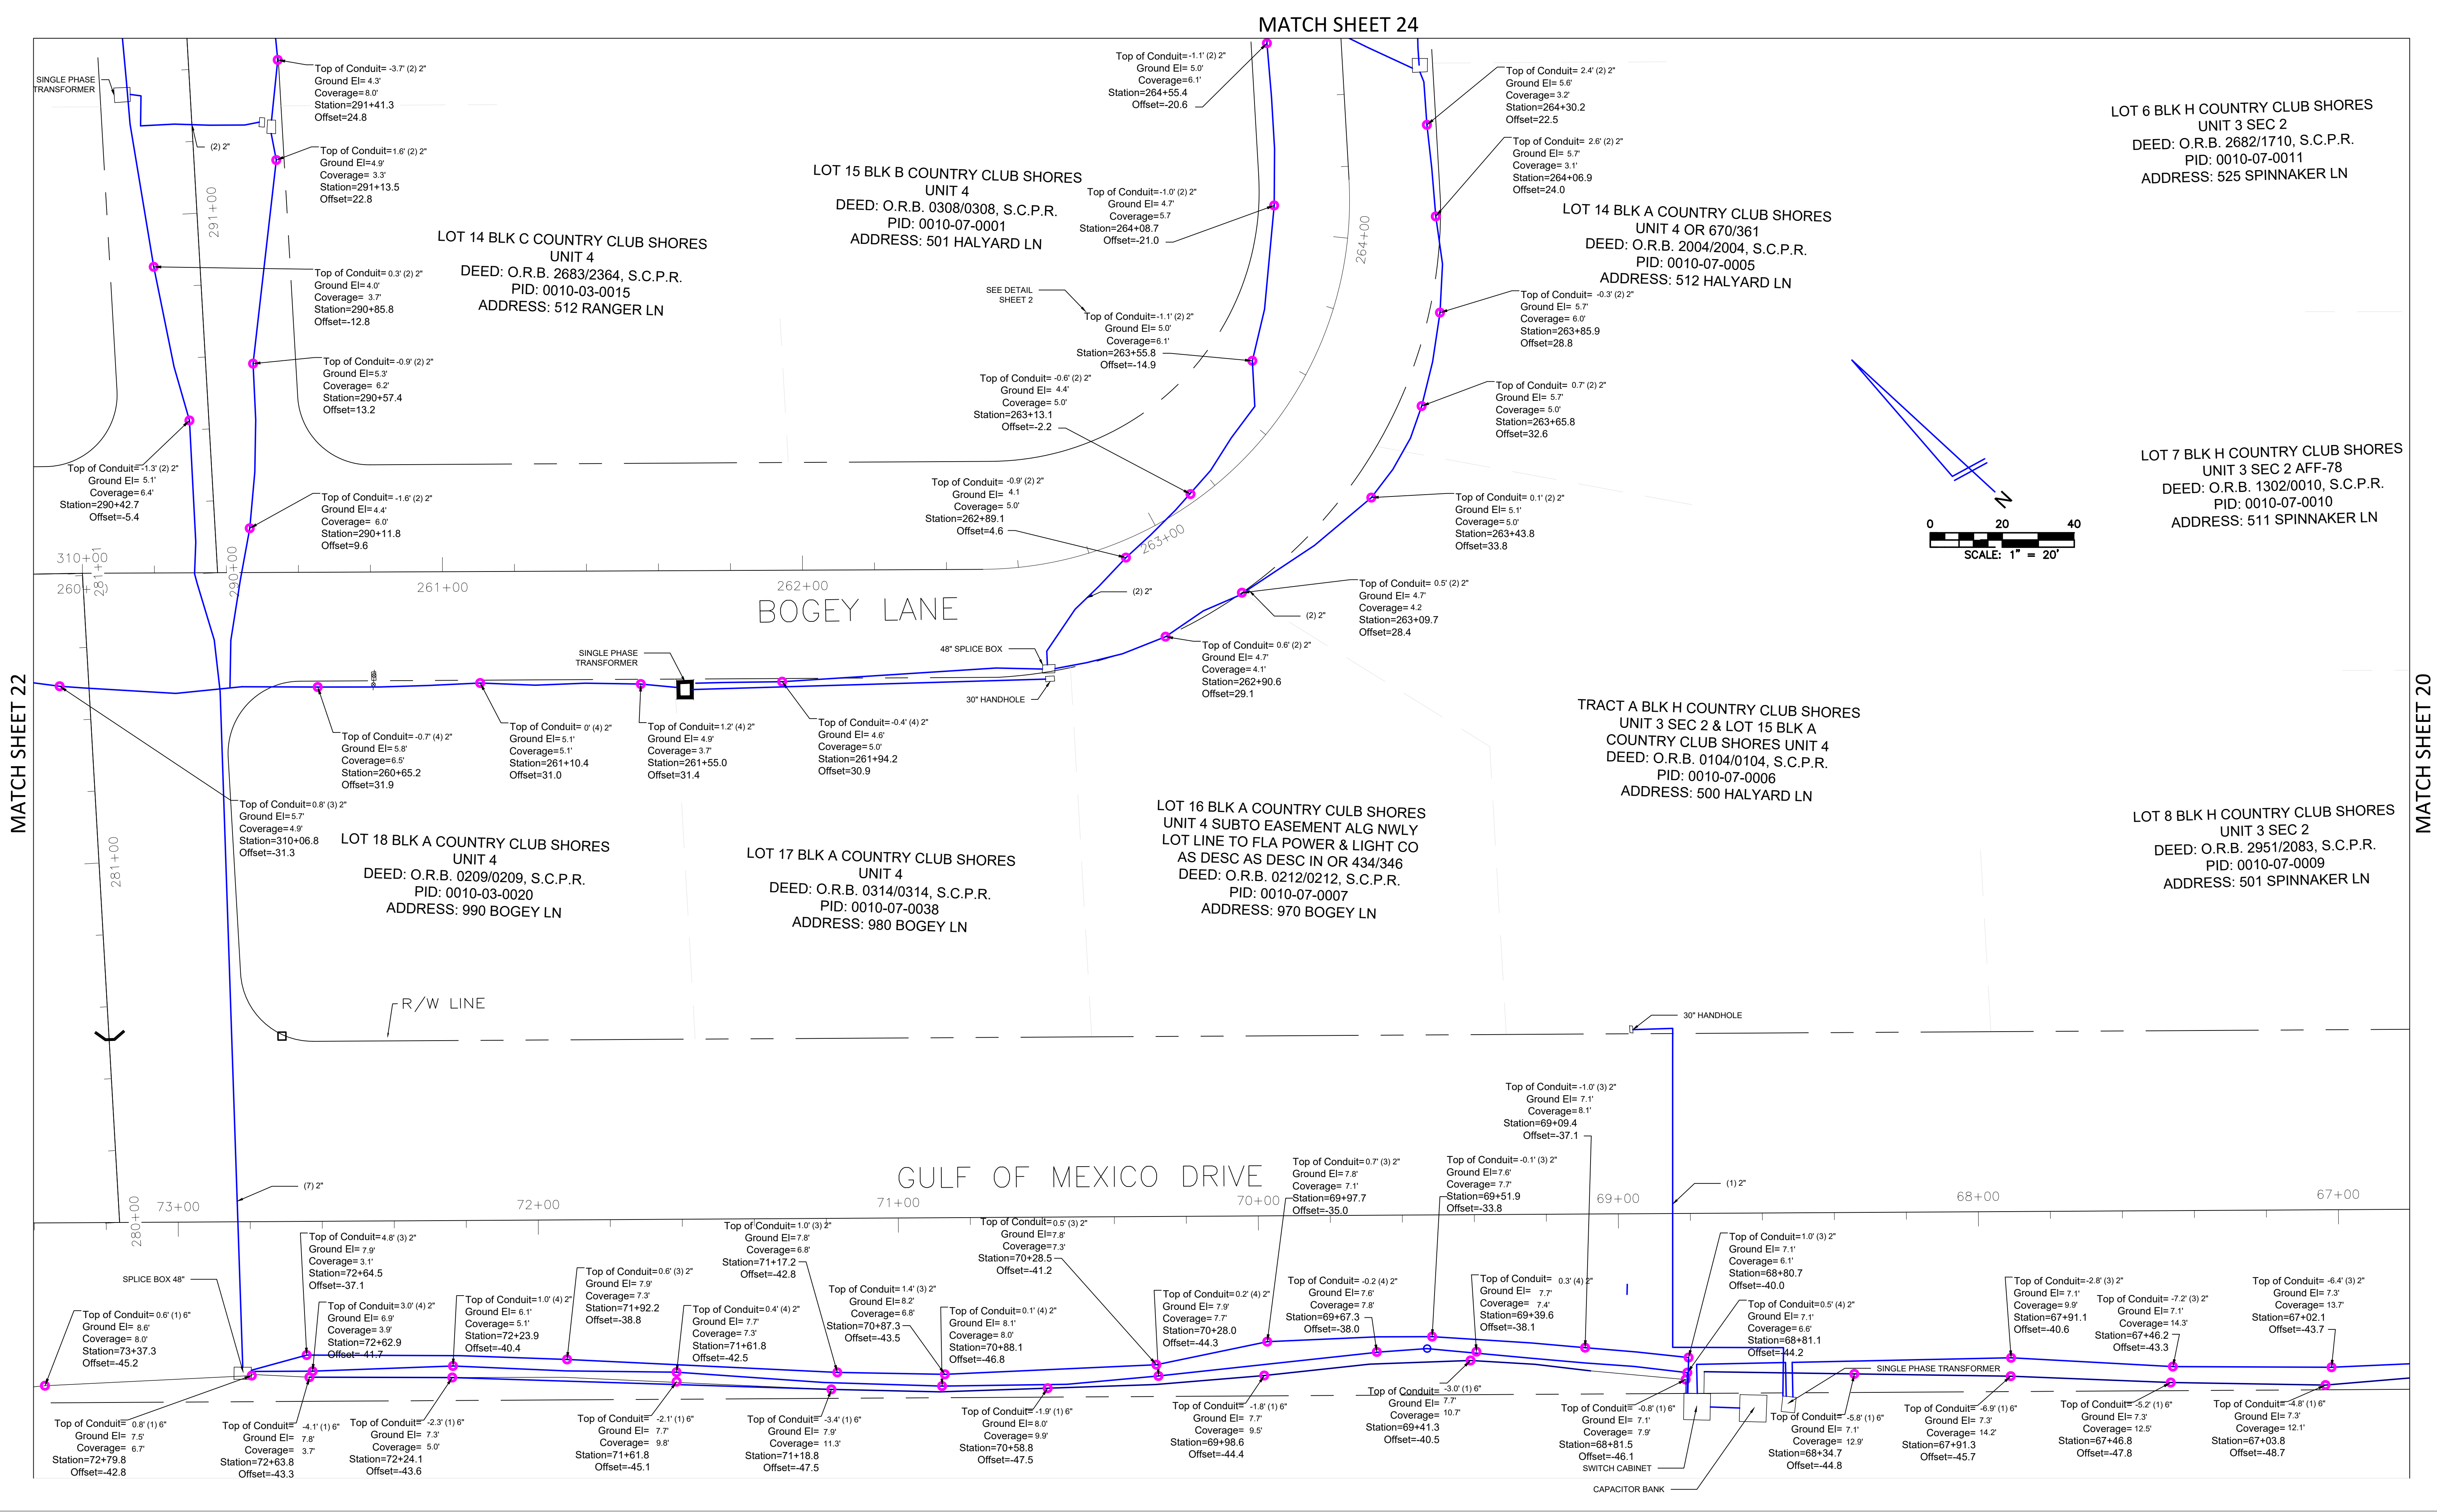


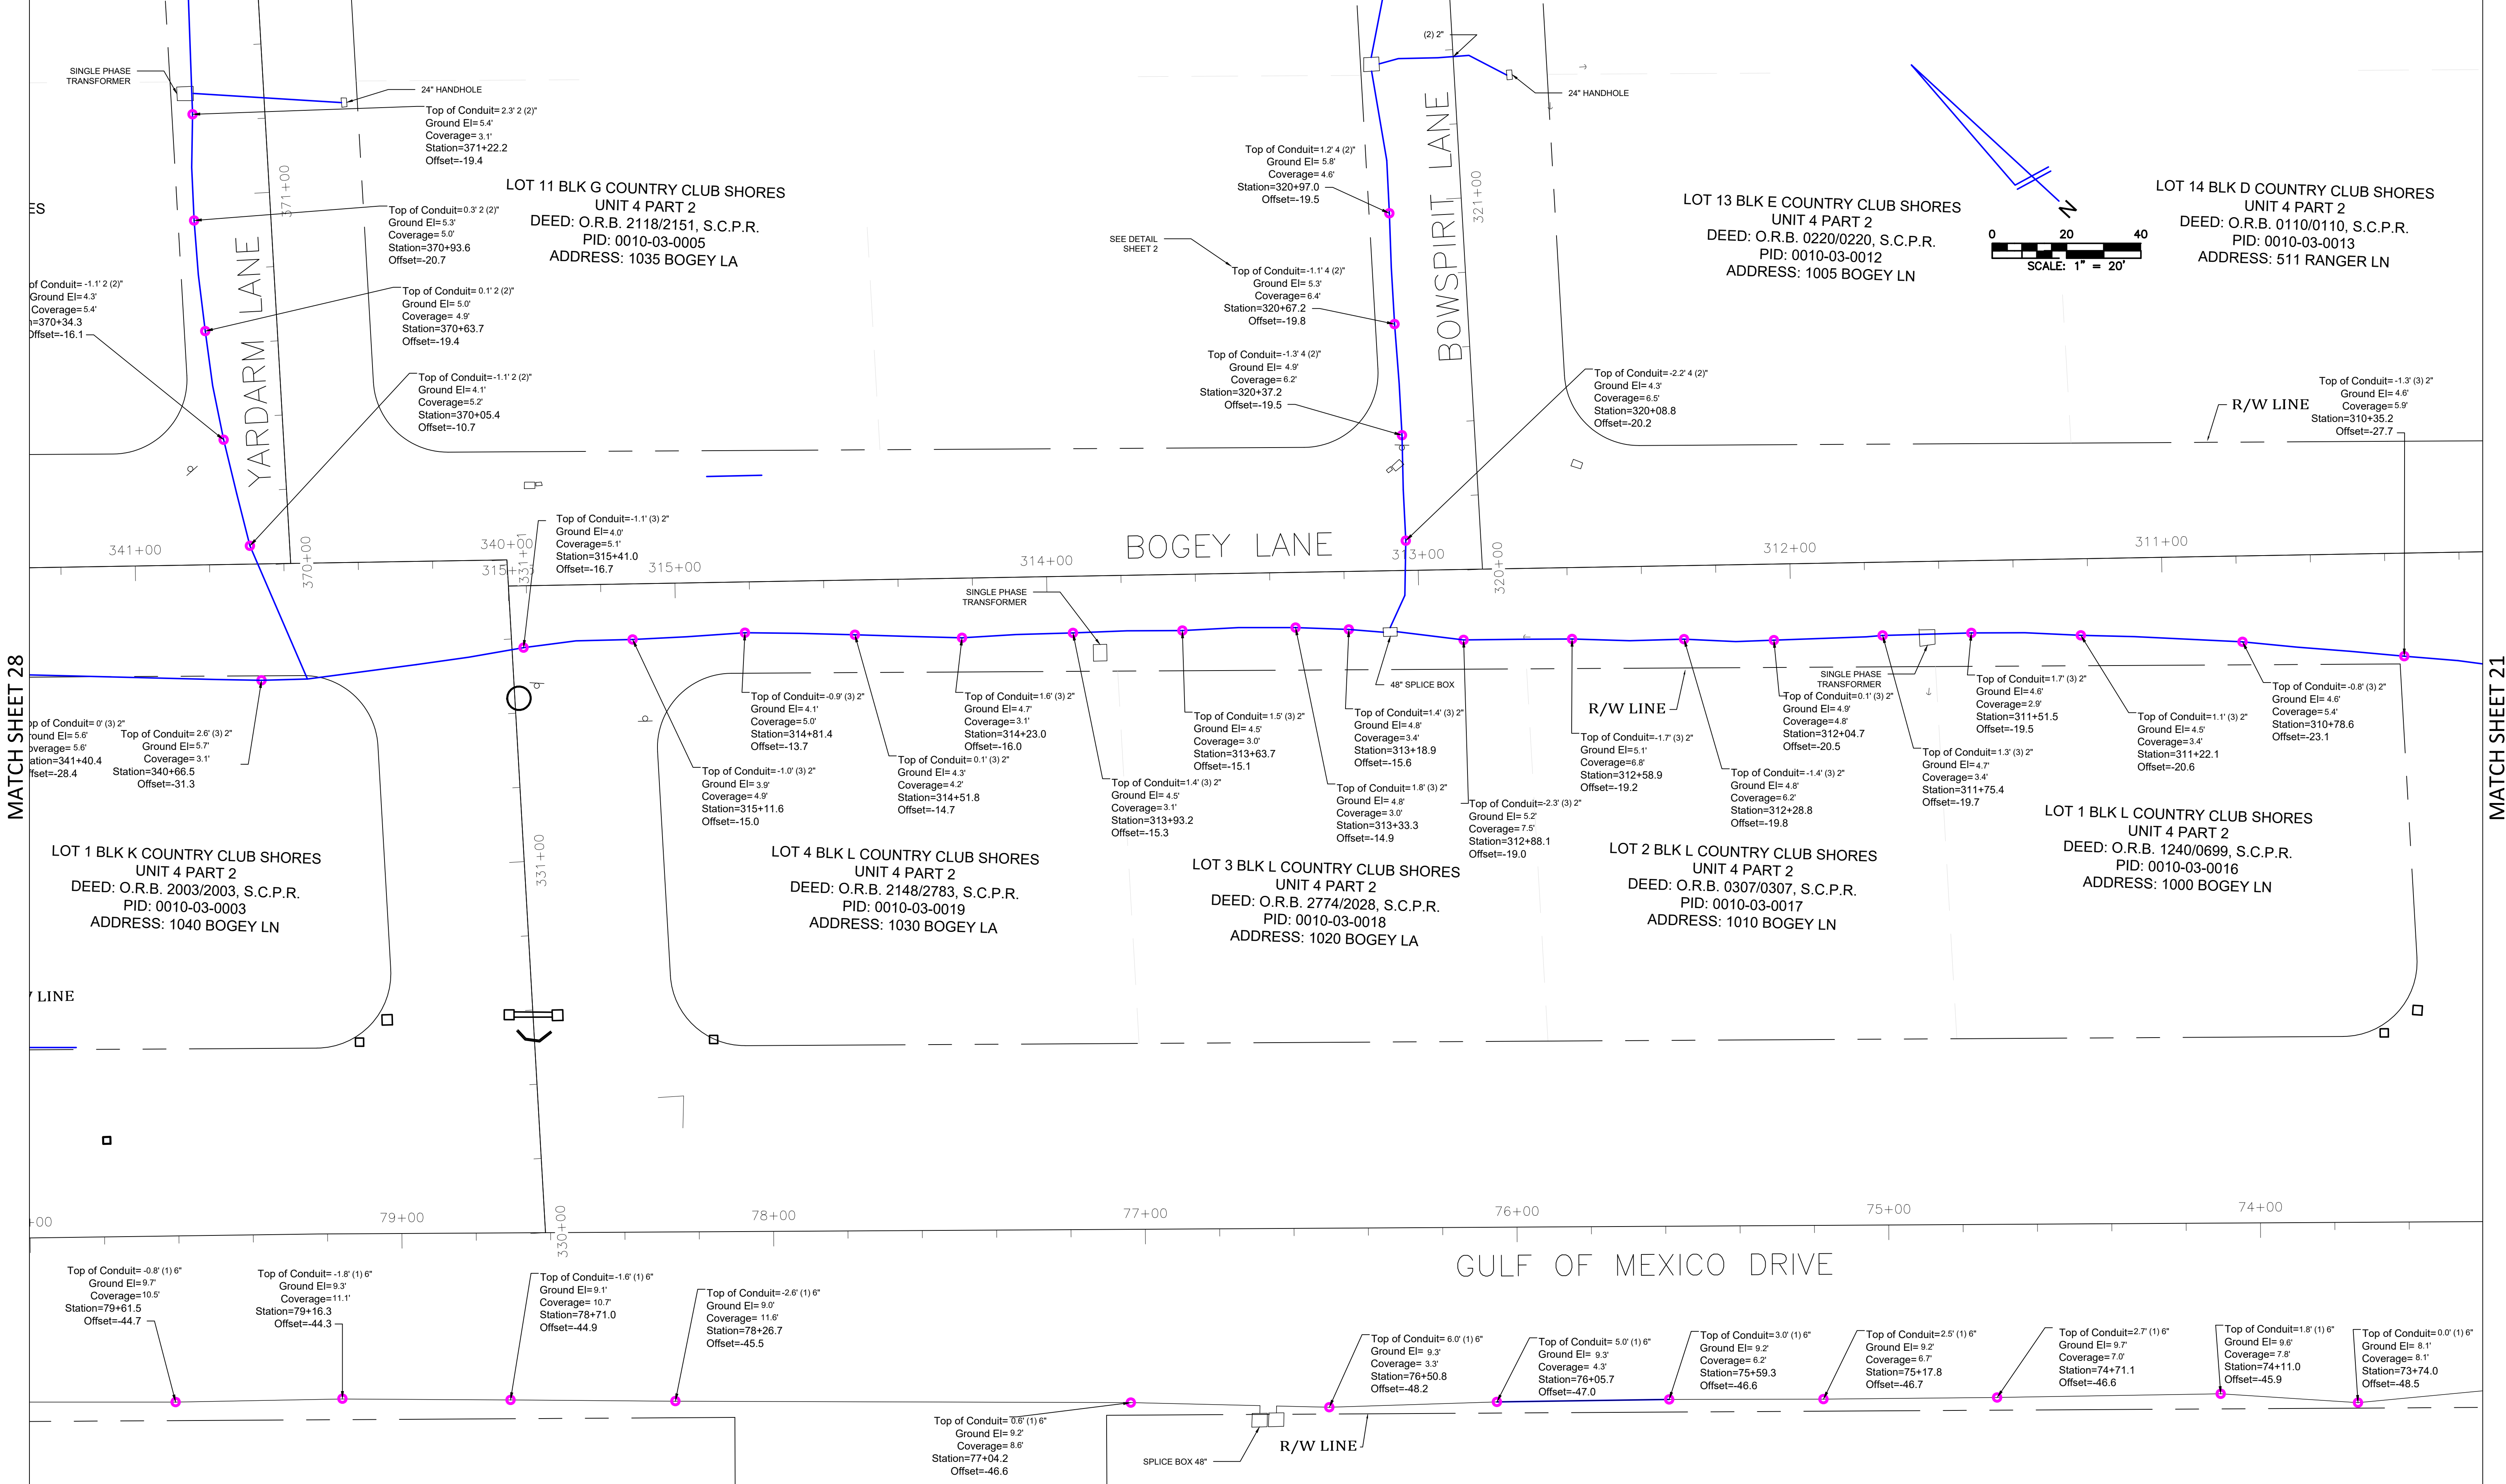


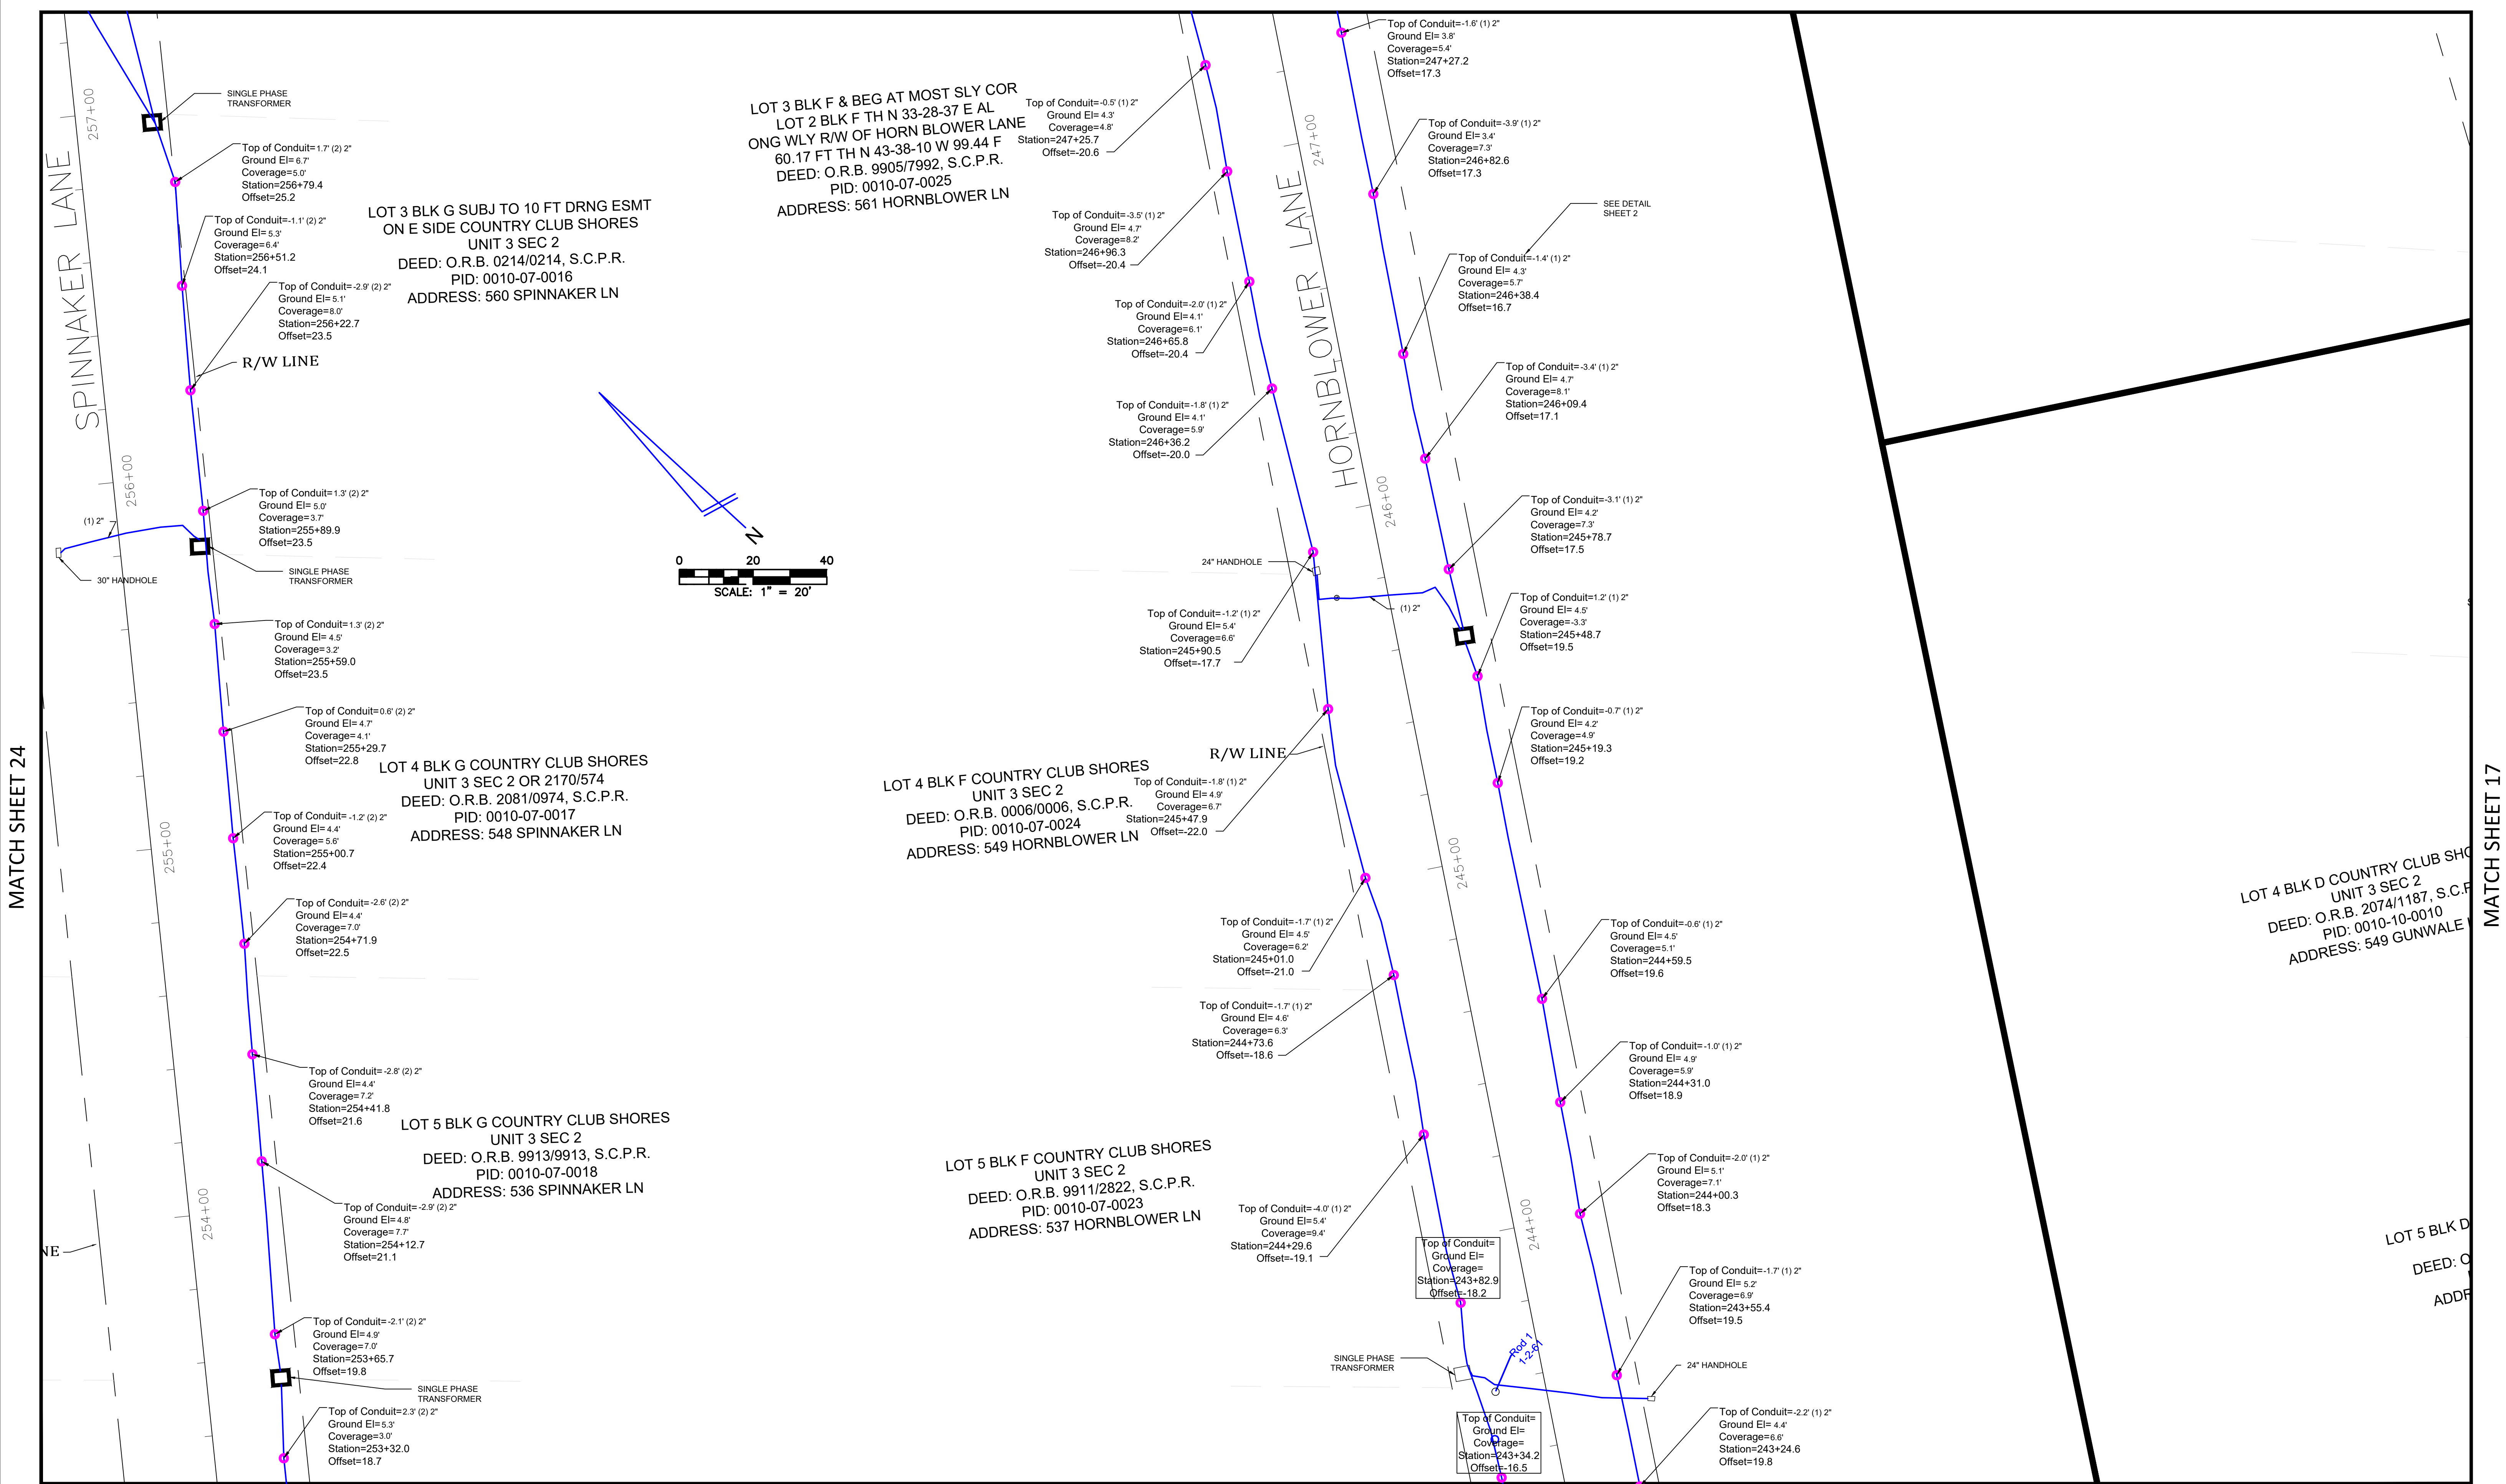

MATCH SHEET 25

MATCH SHEET 27

MATCH SHEET 23

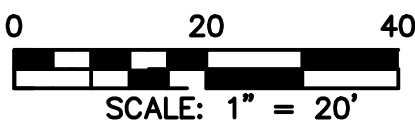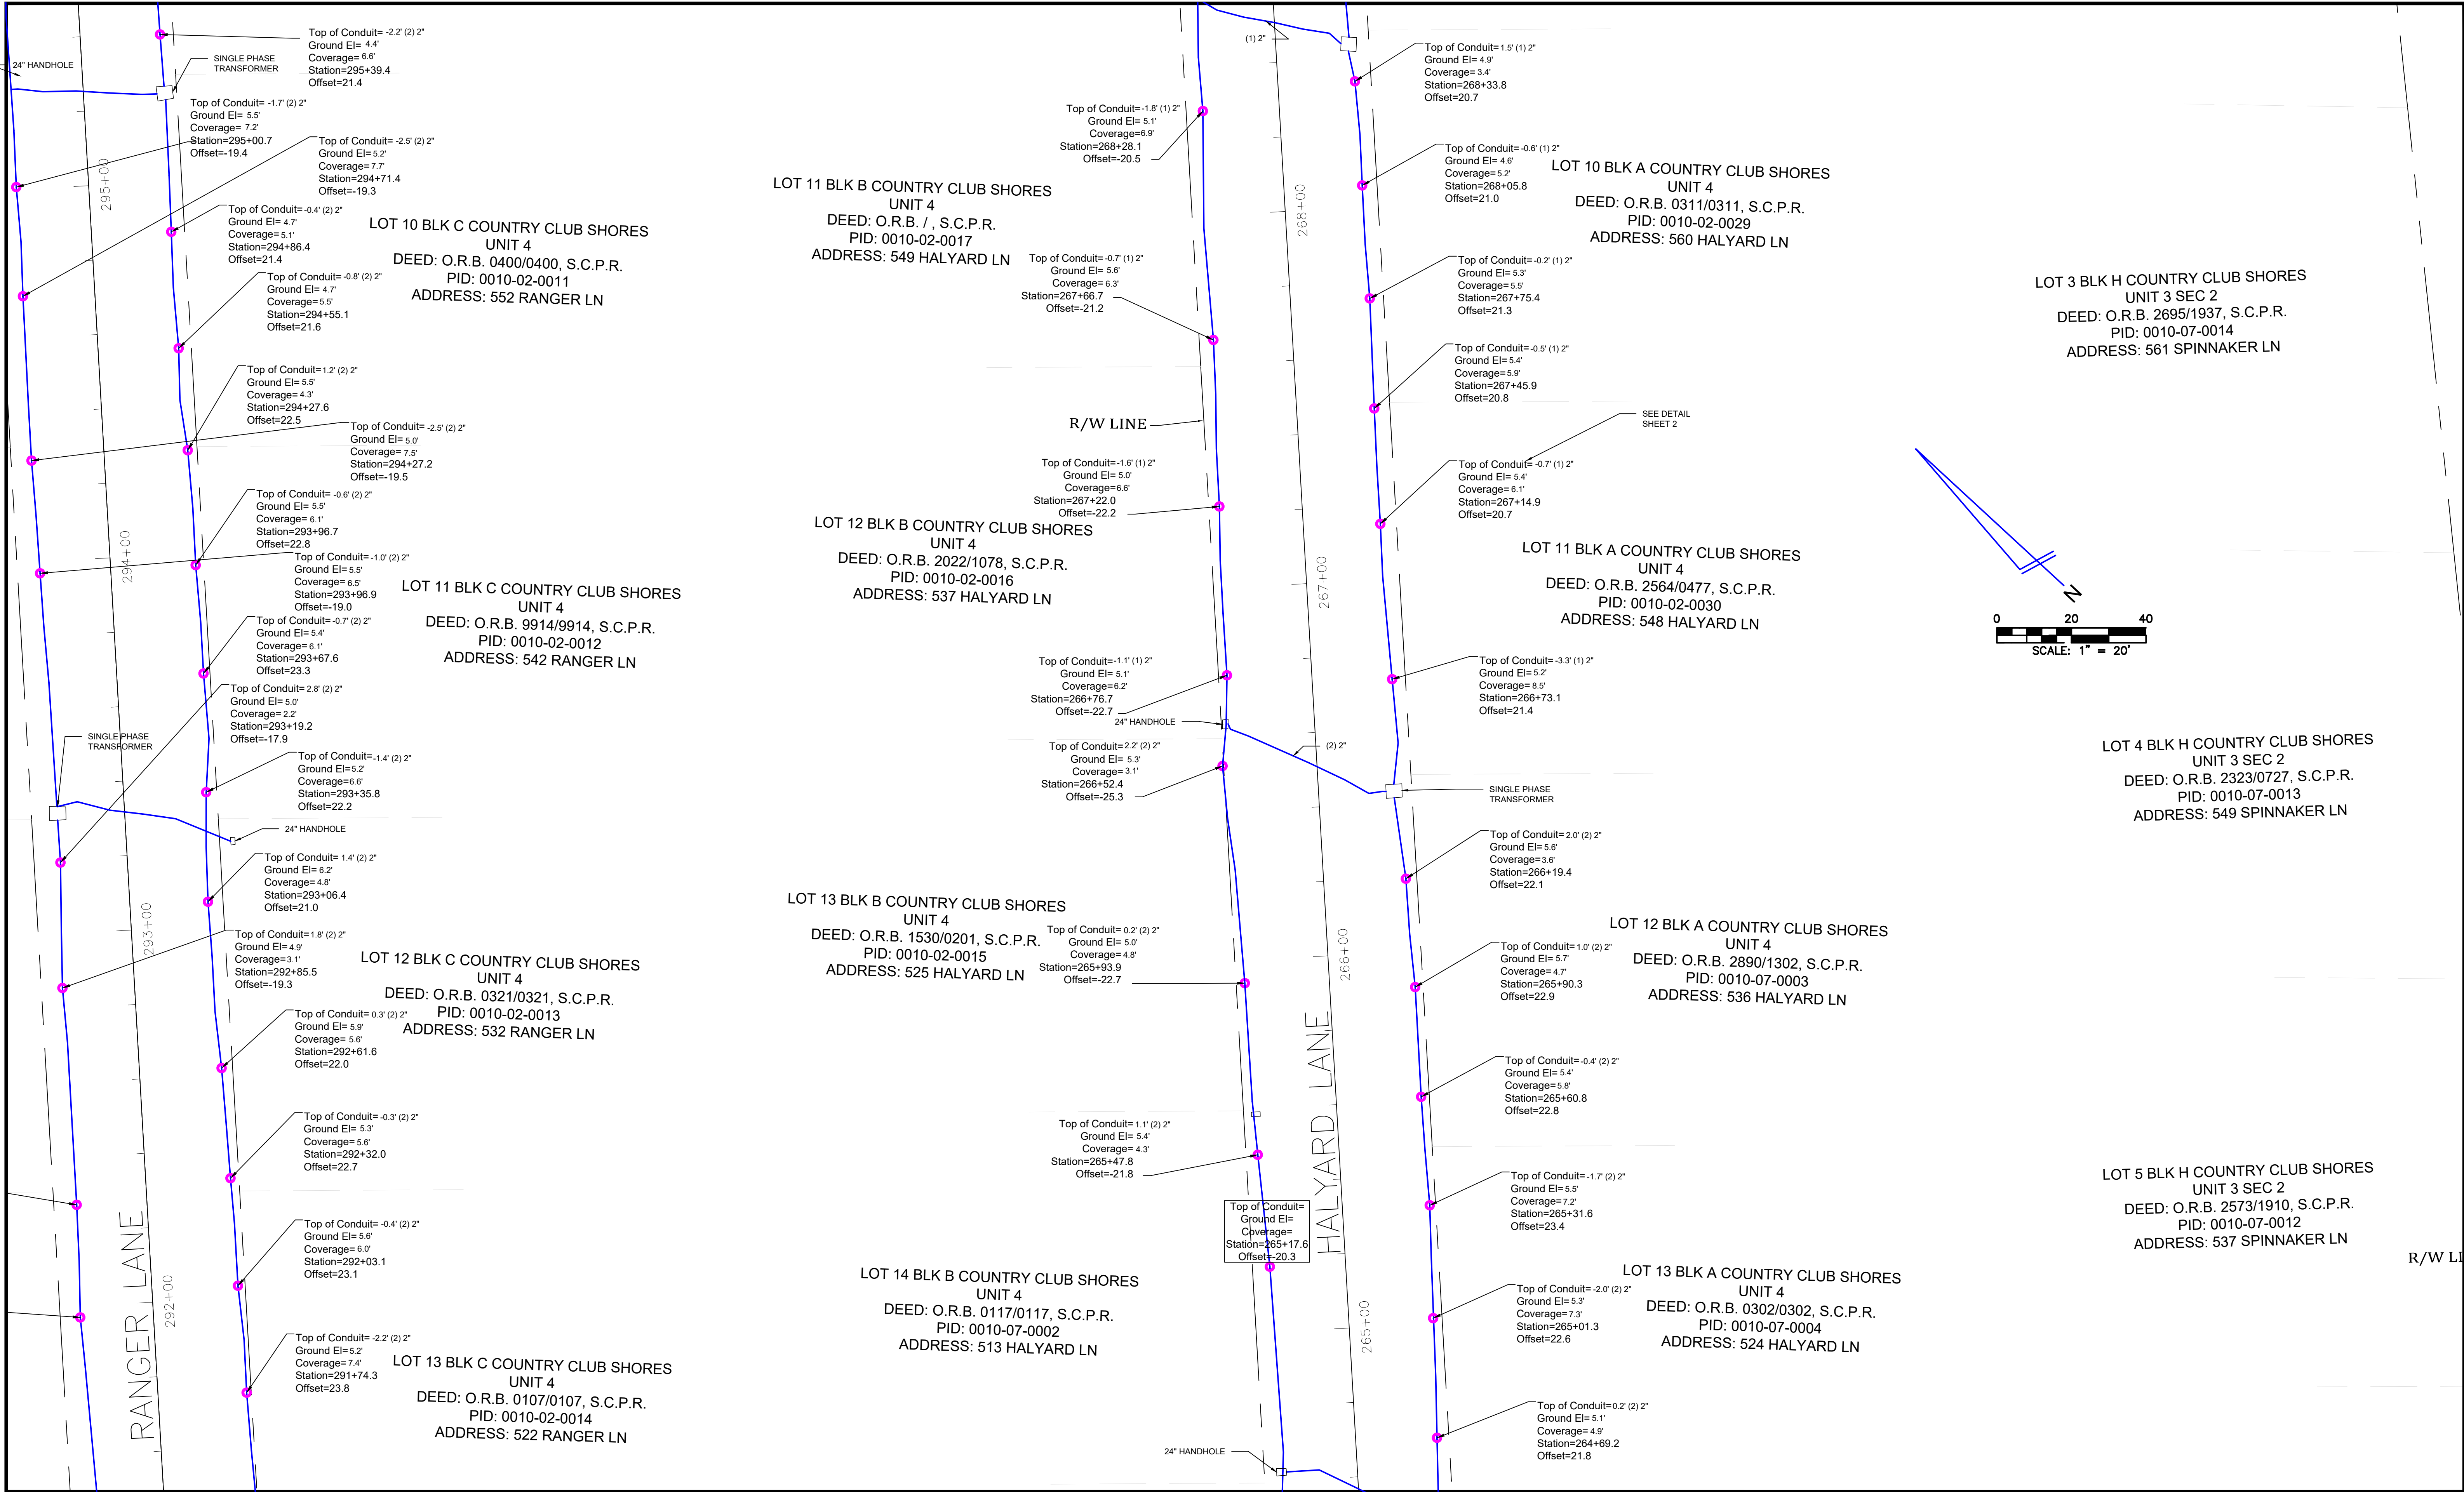

MATCH SHEET 21



TITLE: AS-BUILT SURVEY "LONGBOAT KEY UNDERGROUND" (PHASE 1 SOUTH)

LOCATION: SECTIONS 16, 21 & 22, TOWNSHIP 36 SOUTH, RANGE 17 EAST, SARASOTA COUNTY, FLORIDA

BULLSEYE SURVEYING, INC.
LB 7818
2198 NE COACHMAN ROAD, UNIT F, CLEARWATER, FL 33765
Phone: (727) 475-8088

FILE: 19-040-AS-BUILTS	Drawn By: GRM/AMW
PROJECT NUMBER: 19-040	Date: 10/26/2020
	Scale: 1" = 20'

SHEET
24
OF 45

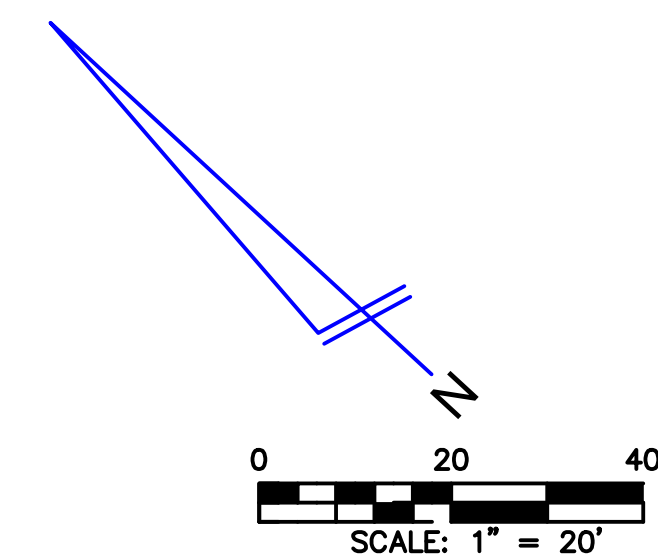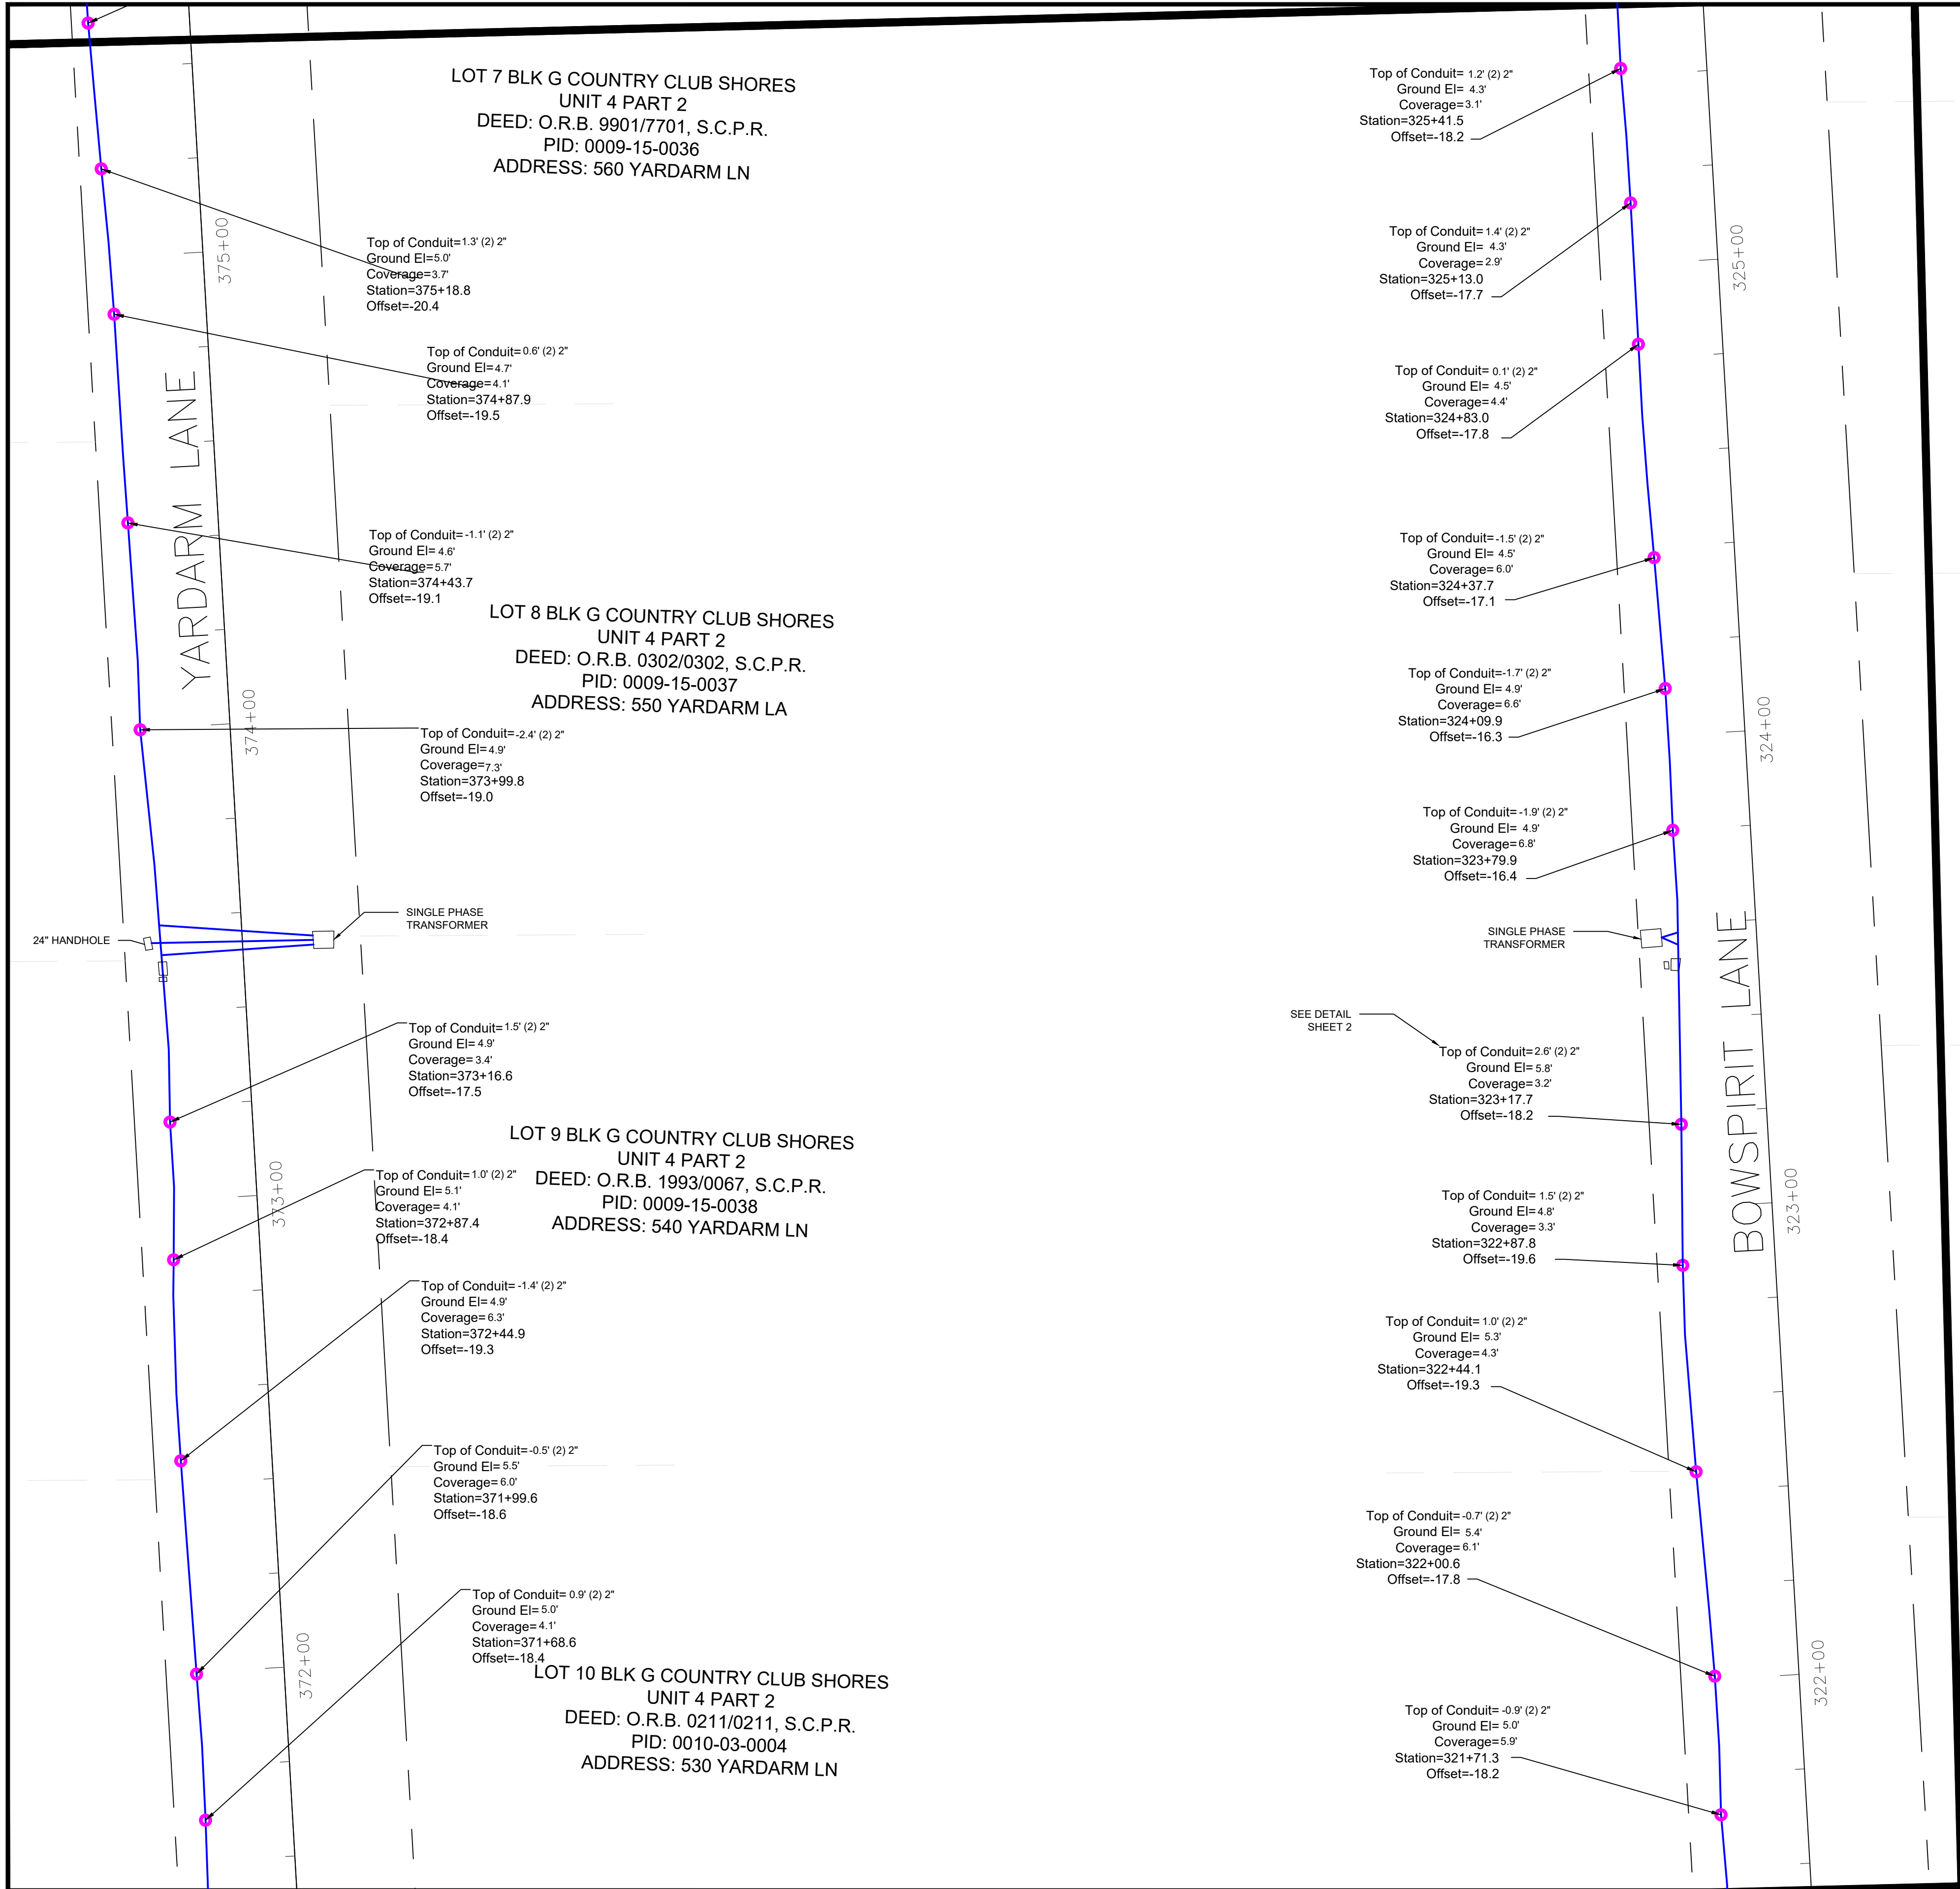

LOT 9 BLK E COUNTRY CLUB SHORES
UNIT 4 PART 2 ORI 2000142281
DEED: O.R.B. 0014/0014, S.C.P.R.
PID: 0010-02-0001
ADDRESS: 540 BOWSPRIT LA

LOT 10 BLK D COUNTRY CLUB SHORES
UNIT 4
DEED: O.R.B. 2896/0509, S.C.P.R.
PID: 0010-02-0005
ADDRESS: 551 RANGER LN

LOT 10 BLK E COUNTRY CLUB SHORES
UNIT 4 PART 2
DEED: O.R.B. 0304/0304, S.C.P.R.
PID: 0010-02-0002
ADDRESS: 530 BOWSPRIT LN

LOT 11 BLK D COUNTRY CLUB SHORES
UNIT 4
DEED: O.R.B. 9902/9890, S.C.P.R.
PID: 0010-02-0004
ADDRESS: 541 RANGER LN

LOT 11 BLK E COUNTRY CLUB SHORES
UNIT 4 PART 2
DEED: O.R.B. 2959/2697, S.C.P.R.
PID: 0010-03-0010
ADDRESS: 520 BOWSPRIT LA


LOT 12 BLK D COUNTRY CLUB SHORES
UNIT 4
DEED: O.R.B. 0400/0400, S.C.P.R.
PID: 0010-02-0003
ADDRESS: 531 RANGER LN

LOT 12 BLK E COUNTRY CLUB SHORES
UNIT 4 PART 2
DEED: O.R.B. 0205/0205, S.C.P.R.
PID: 0010-03-0011
ADDRESS: 510 BOWSPRIT LN

LOT 13 BLK D COUNTRY CLUB SHORES
UNIT 4
DEED: O.R.B. 1472/1599, S.C.P.R.
PID: 0010-03-0014
ADDRESS: 521 RANGER LN

Top of Conduit=-0.3' (2) 2"
Ground El=5.2'
Coverage=5.5'
Station=292+27.3
Offset=-18.9


Top of Conduit=0.4' (2) 2"
Ground El=5.6'
Coverage=5.2'
Station=291+97.0
Offset=-19.6

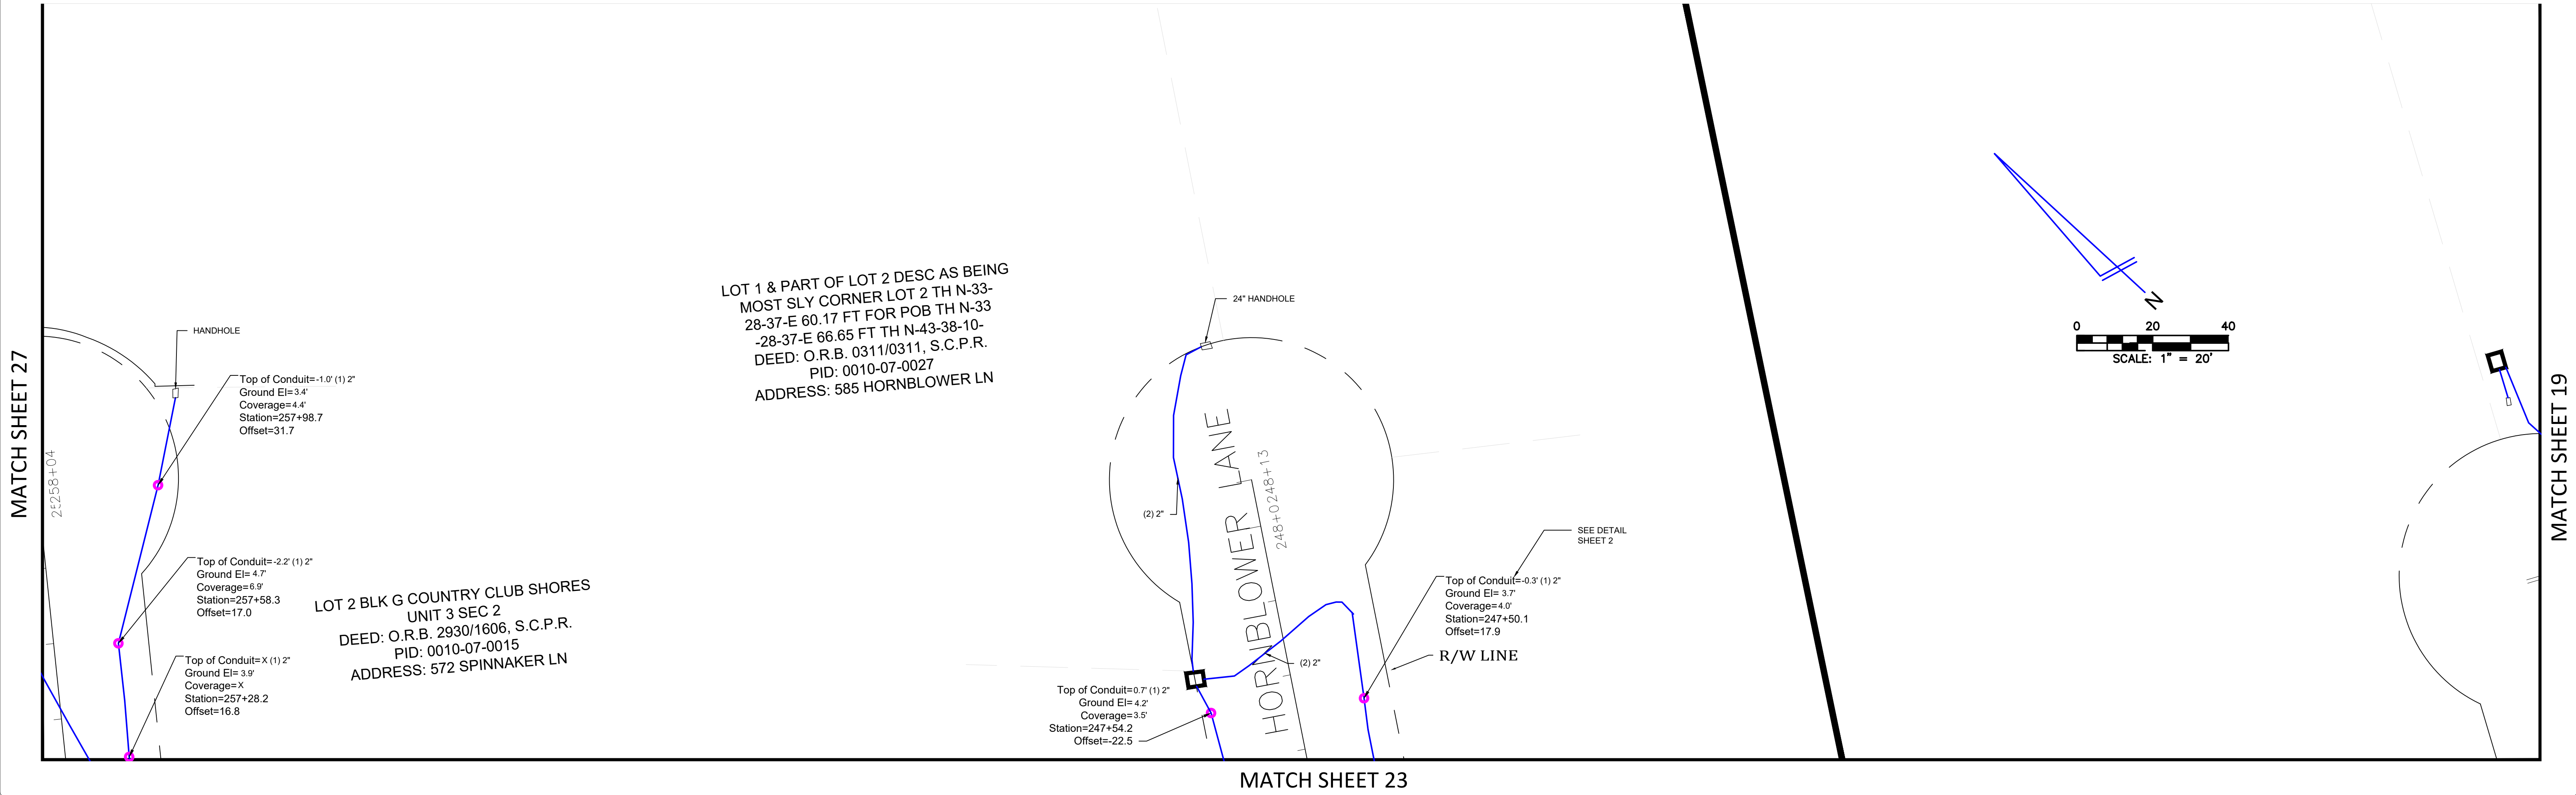

TITLE: AS-BUILT SURVEY "LONGBOAT KEY UNDERGROUND" (PHASE 1 SOUTH)


LOCATION: SECTIONS 16, 21 & 22, TOWNSHIP 36 SOUTH, RANGE 17 EAST, SARASOTA COUNTY, FLORIDA



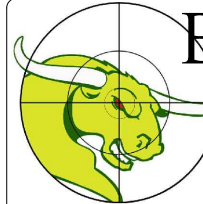

BULLSEYE SURVEYING, INC.
LB 7818
2198 NE COACHMAN ROAD, UNIT F, CLEARWATER, FL 33765
Phone: (727) 475-8088

FILE: 19-040-AS-BUILTS	Drawn By: GRM/AMW
PROJECT NUMBER: 19-040	Date: 10/26/2020
	Scale: 1" = 20'

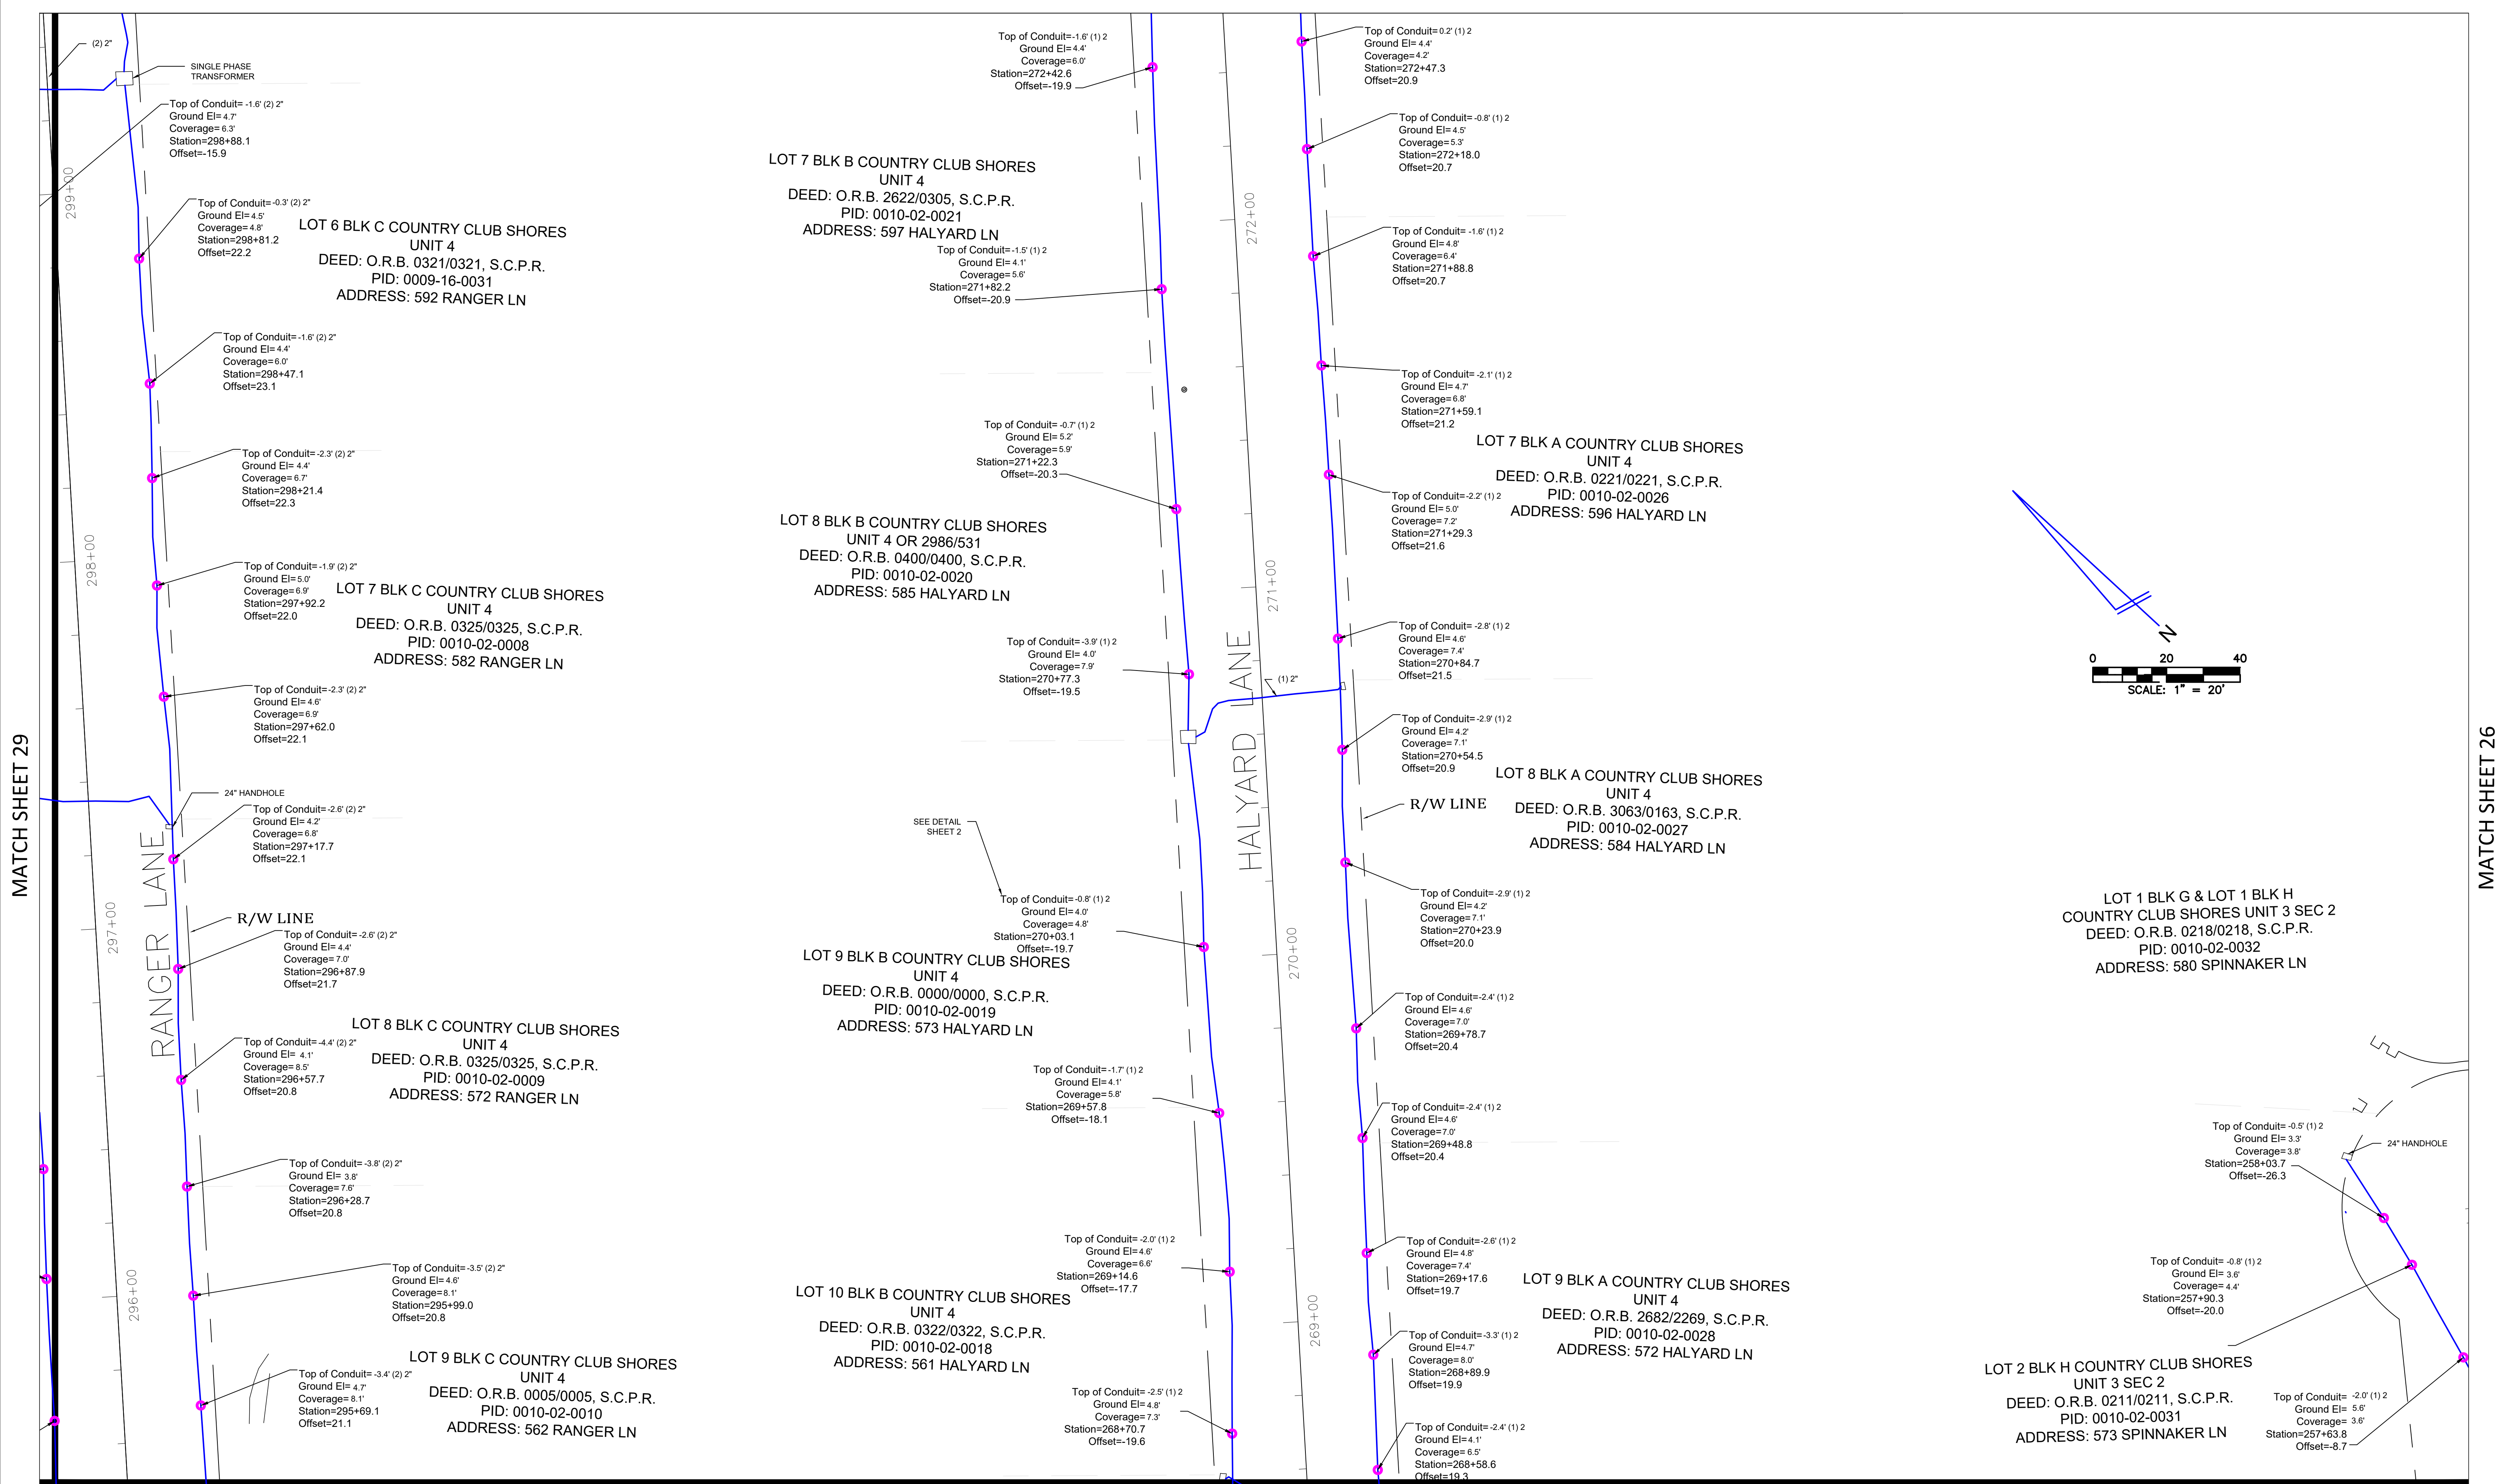


TITLE: AS-BUILT SURVEY "LONGBOAT KEY UNDERGROUND" (PHASE 1 SOUTH)

LOCATION: SECTIONS 16, 21 & 22, TOWNSHIP 36 SOUTH, RANGE 17 EAST, SARASOTA COUNTY, FLORIDA


BULLSEYE SURVEYING, INC.
LB 7818
2198 NE COACHMAN ROAD, UNIT F, CLEARWATER, FL 33765
Phone: (727) 475-8088

FILE: 19-040-AS-BUILTS	Drawn By: GRM/AMW
PROJECT NUMBER: 19-040	Date: 10/26/2020
	Scale: 1" = 20'

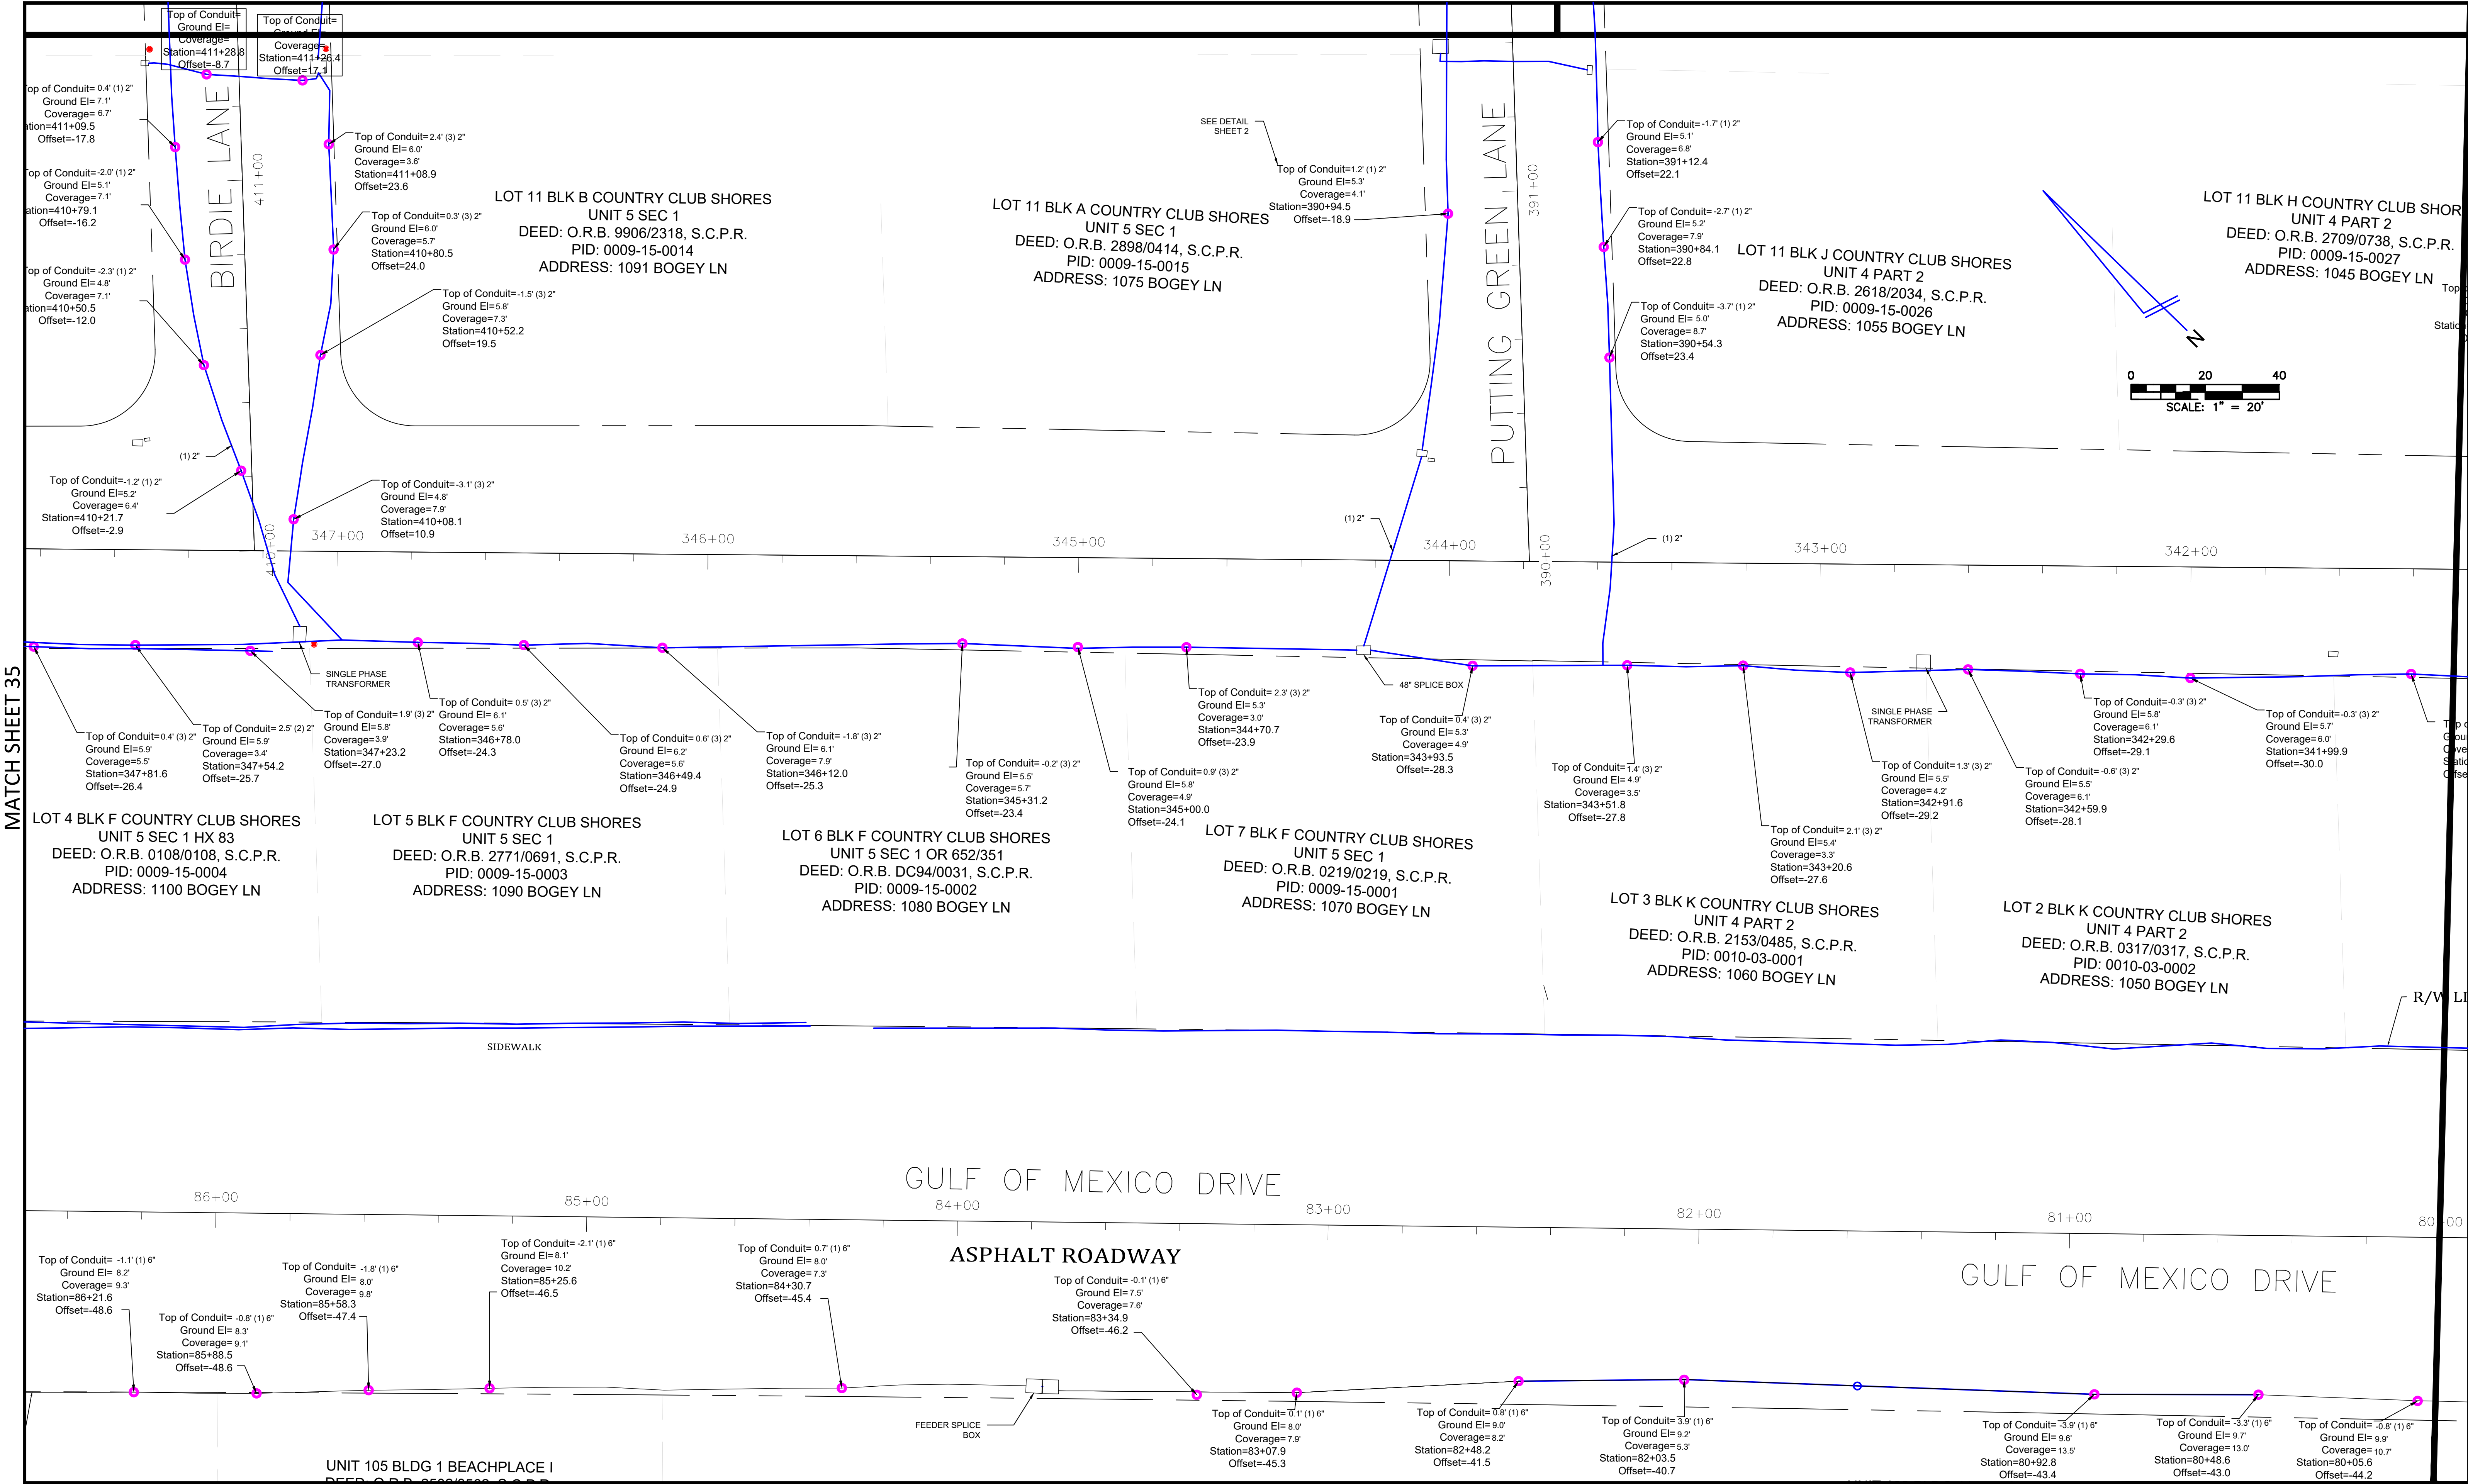

TITLE: AS-BUILT SURVEY "LONGBOAT KEY UNDERGROUND" (PHASE 1 SOUTH)

LOCATION: SECTIONS 16, 21 & 22, TOWNSHIP 36 SOUTH, RANGE 17 EAST, SARASOTA COUNTY, FLORIDA

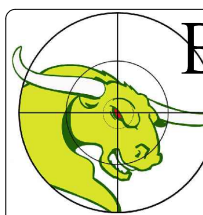

BULLSEYE SURVEYING, INC.
LB 7818
2198 NE COACHMAN ROAD, UNIT F, CLEARWATER, FL 33765
Phone: (727) 475-8088

FILE: 19-040-AS-BUILTS	Drawn By: GRM/AMW
PROJECT NUMBER: 19-040	Date: 10/26/2020
	Scale: 1" = 20'

MATCH SHEET 33

ADDRESS: 591 BOWSPRIT LN

SINGLE PHASE
TRANSFORMER
R/W LINE

LOT 5 BLK F COUNTRY CLUB SHORES
UNIT 4 PART 2
DEED: O.R.B. 1971/1629, S.C.P.R.
PID: 0009-16-0007
ADDRESS: 581 BOWSPRIT LN

LOT 5 BLK E COUNTRY CLUB SHORES
UNIT 4 PART 2
DEED: O.R.B. 0319/0319, S.C.P.R.
PID: 0009-16-0015
ADDRESS: 580 BOWSPRIT LN

LOT 6 BLK D COUNTRY CLUB SHORES
UNIT 4
DEED: O.R.B. 0009/0009, S.C.P.R.
PID: 0009-16-0020
ADDRESS: 591 RANGER LN

Top of Conduit=-2.7' (2) 2"
Ground El=4.4'
Coverage=7.1'
Station=298+58.1
Offset=-16.7

Top of Conduit=-1.7' (2) 2"
Ground El=4.0'
Coverage=5.7'
Station=298+28.6
Offset=-17.2

Top of Conduit=-1.5' (2) 2"
Ground El=3.7'
Coverage=5.2'
Station=297+98.5
Offset=-16.8

LOT 7 BLK D COUNTRY CLUB SHORES
UNIT 4 ORI 2003115312
DEED: O.R.B. 0311/0311, S.C.P.R.
PID: 0009-16-0019
ADDRESS: 581 RANGER LN

Top of Conduit= 0.4' (2) 2"
Ground El= 3.9'
Coverage=3.5'
Station=297+67.6
Offset=-16.1

Top of Conduit=-1.1' (2) 2"
Ground El= 4.0'
Coverage= 5.1'
Station=296+97.7
Offset=-18.3

Top of Conduit= -1.4' (2) 2"
Ground El= 4.0'
Coverage= 5.4'
Station=296+68.4
Offset=-18.3

LOT 8 BLK D COUNTRY CLUB SHORES
UNIT 4
DEED: O.R.B. 9909/1956, S.C.P.R.
PID: 0010-02-0007
ADDRESS: 571 RANGER LN

Top of Conduit=-1.4' (2) 2"
Ground El= 4.2'
Coverage= 5.6'
Station=296+35.7
Offset=-17.9

Top of Conduit=-1.3' (2) 2"
Ground El= 4.5'
Coverage= 5.8'
Station=296+05.8
Offset=-18.8

LOT 9 BLK D COUNTRY CLUB SHORES
UNIT 4
DEED: O.R.B. 2980/2951, S.C.P.R.
PID: 0010-02-0006
ADDRESS: 561 RANGER LN

Top of Conduit=-3.4' (2) 2"
Ground El= 4.2'
Coverage= 7.6'
Station=295+67.2
Offset=-18.8

Top of Conduit=-1.7' (2) 2"
Ground El=5.0'
Coverage=6.7'
Station=328+12.0
Offset=-16.3

Top of Conduit=-2.1' (2) 2"
Ground El=4.8'
Coverage=6.9'
Station=327+69.2
Offset=-17.3

Top of Conduit=-0.9' (2) 2"
Ground El=4.9'
Coverage=5.8'
Station=327+37.8
Offset=-16.4

Top of Conduit= 0.4' (2) 2"
Ground El=4.7'
Coverage=4.3'
Station=327+06.8
Offset=-15.8

Top of Conduit=1.8' (2) 2"
Ground El=4.8'
Coverage=3.0'
Station=326+76.3
Offset=-14.5

Top of Conduit=1.6' (2) 2"
Ground El=4.6'
Coverage=3.0'
Station=326+46.7
Offset=-14.6

Top of Conduit=1.3' (2) 2"
Ground El=4.7'
Coverage=3.4'
Station=326+17.7
Offset=-15.4

LOT 7 BLK E COUNTRY CLUB SHORES
UNIT 4 PART 2 OR 497/657
DEED: O.R.B. 1258/0537, S.C.P.R.
PID: 0009-16-0017
ADDRESS: 560 BOWSPRIT LN

Top of Conduit=1.0' (2) 2"
Ground El=4.5'
Coverage=3.5'
Station=325+88.7
Offset=-17.2

LOT 8 BLK E COUNTRY CLUB SHORES
UNIT 4 PART 2
DEED: O.R.B. 3042/2091, S.C.P.R.
PID: 0009-16-0018
ADDRESS: 550 BOWSPRIT LA

BOWSPRIT LANE

(2) 2"

326+00

327+00

328+00

329+00

MATCH SHEET 25

MATCH SHEET 30

SINGLE PHASE
TRANSFORMER

Top of Conduit=-0.3' (2) 2"
Ground El= 4.9'
Coverage=5.2'
Station=379+10.4
Offset=-15.7

Top of Conduit=-1.7' (2) 2"
Ground El=4.8'
Coverage=6.5'
Station=378+81.7
Offset=-16.0

Top of Conduit=-2.1' (2) 2"
Ground El= 4.9'
Coverage=7.0'
Station=378+51.9
Offset=-16.1

Top of Conduit=-1.9' (2) 2"
Ground El=4.6'
Coverage=6.5'
Station=378+22.9
Offset=-16.0

Top of Conduit=1.7' (2) 2"
Ground El=5.0'
Coverage=3.3'
Station=377+74.6
Offset=-18.2

Top of Conduit= 0.8' (2) 2"
Ground El= 5.0'
Coverage=4.2'
Station=377+42.1
Offset=-19.7

Top of Conduit=-0.2' (2) 2"
Ground El=5.0'
Coverage=5.2'
Station=377+12.8
Offset=-20.2

Top of Conduit=-1.1' (2) 2"
Ground El= 4.9'
Coverage=6.0'
Station=376+83.4
Offset=-20.6

Top of Conduit=-1.6' (2) 2"
Ground El= 4.8'
Coverage=6.4'
Station=376+53.9
Offset=-20.3

Top of Conduit=-1.4' (2) 2"
Ground El= 3.7'
Coverage= 5.1'
Station=376+10.5
Offset=-22.8

Top of Conduit=1.5' (2) 2"
Ground El= 5.0'
Coverage=3.3'
Station=375+79.3
Offset=-21.9

Top of Conduit=-0.1' (2) 2"
Ground El= 4.6'
Coverage=4.7'
Station=375+49.8
Offset=-21.5

LOT 4 BLK G COUNTRY CLUB SHORES
UNIT 4 PART 2
DEED: O.R.B. 0114/0114, S.C.P.R.
PID: 0009-16-0002
ADDRESS: 590 YARDARM LN

LOT 5 BLK G COUNTRY CLUB SHORES
UNIT 4 PART 2
DEED: O.R.B. 0110/0110, S.C.P.R.
PID: 0009-16-0003
ADDRESS: 580 YARDARM LN

LOT 6 BLK G COUNTRY CLUB SHORES
UNIT 4 PART 2
DEED: O.R.B. 2833/1050, S.C.P.R.
PID: 0009-15-0035
ADDRESS: 570 YARDARM LN

SEE DETAIL
SHEET 2

YARDARM LANE

378+00


379+00

377+00

376+00

24" HANDHOLE

(1) 2"

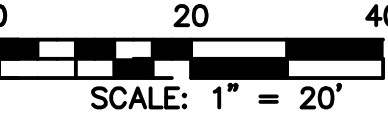


MATCH SHEET 27

TITLE: AS-BUILT SURVEY "LONGBOAT KEY UNDERGROUND" (PHASE 1 SOUTH)

LOCATION: SECTIONS 16, 21 & 22, TOWNSHIP 36 SOUTH, RANGE 17 EAST, SARASOTA COUNTY, FLORIDA

BULLSEYE SURVEYING, INC.
LB 7818
2198 NE COACHMAN ROAD, UNIT F, CLEARWATER, FL 33765
Phone: (727) 475-8088

FILE: 19-040-AS-BUILTS	Drawn By: GRM/AMW
PROJECT NUMBER: 19-040	Date: 10/26/2020
	Scale: 1" = 20'

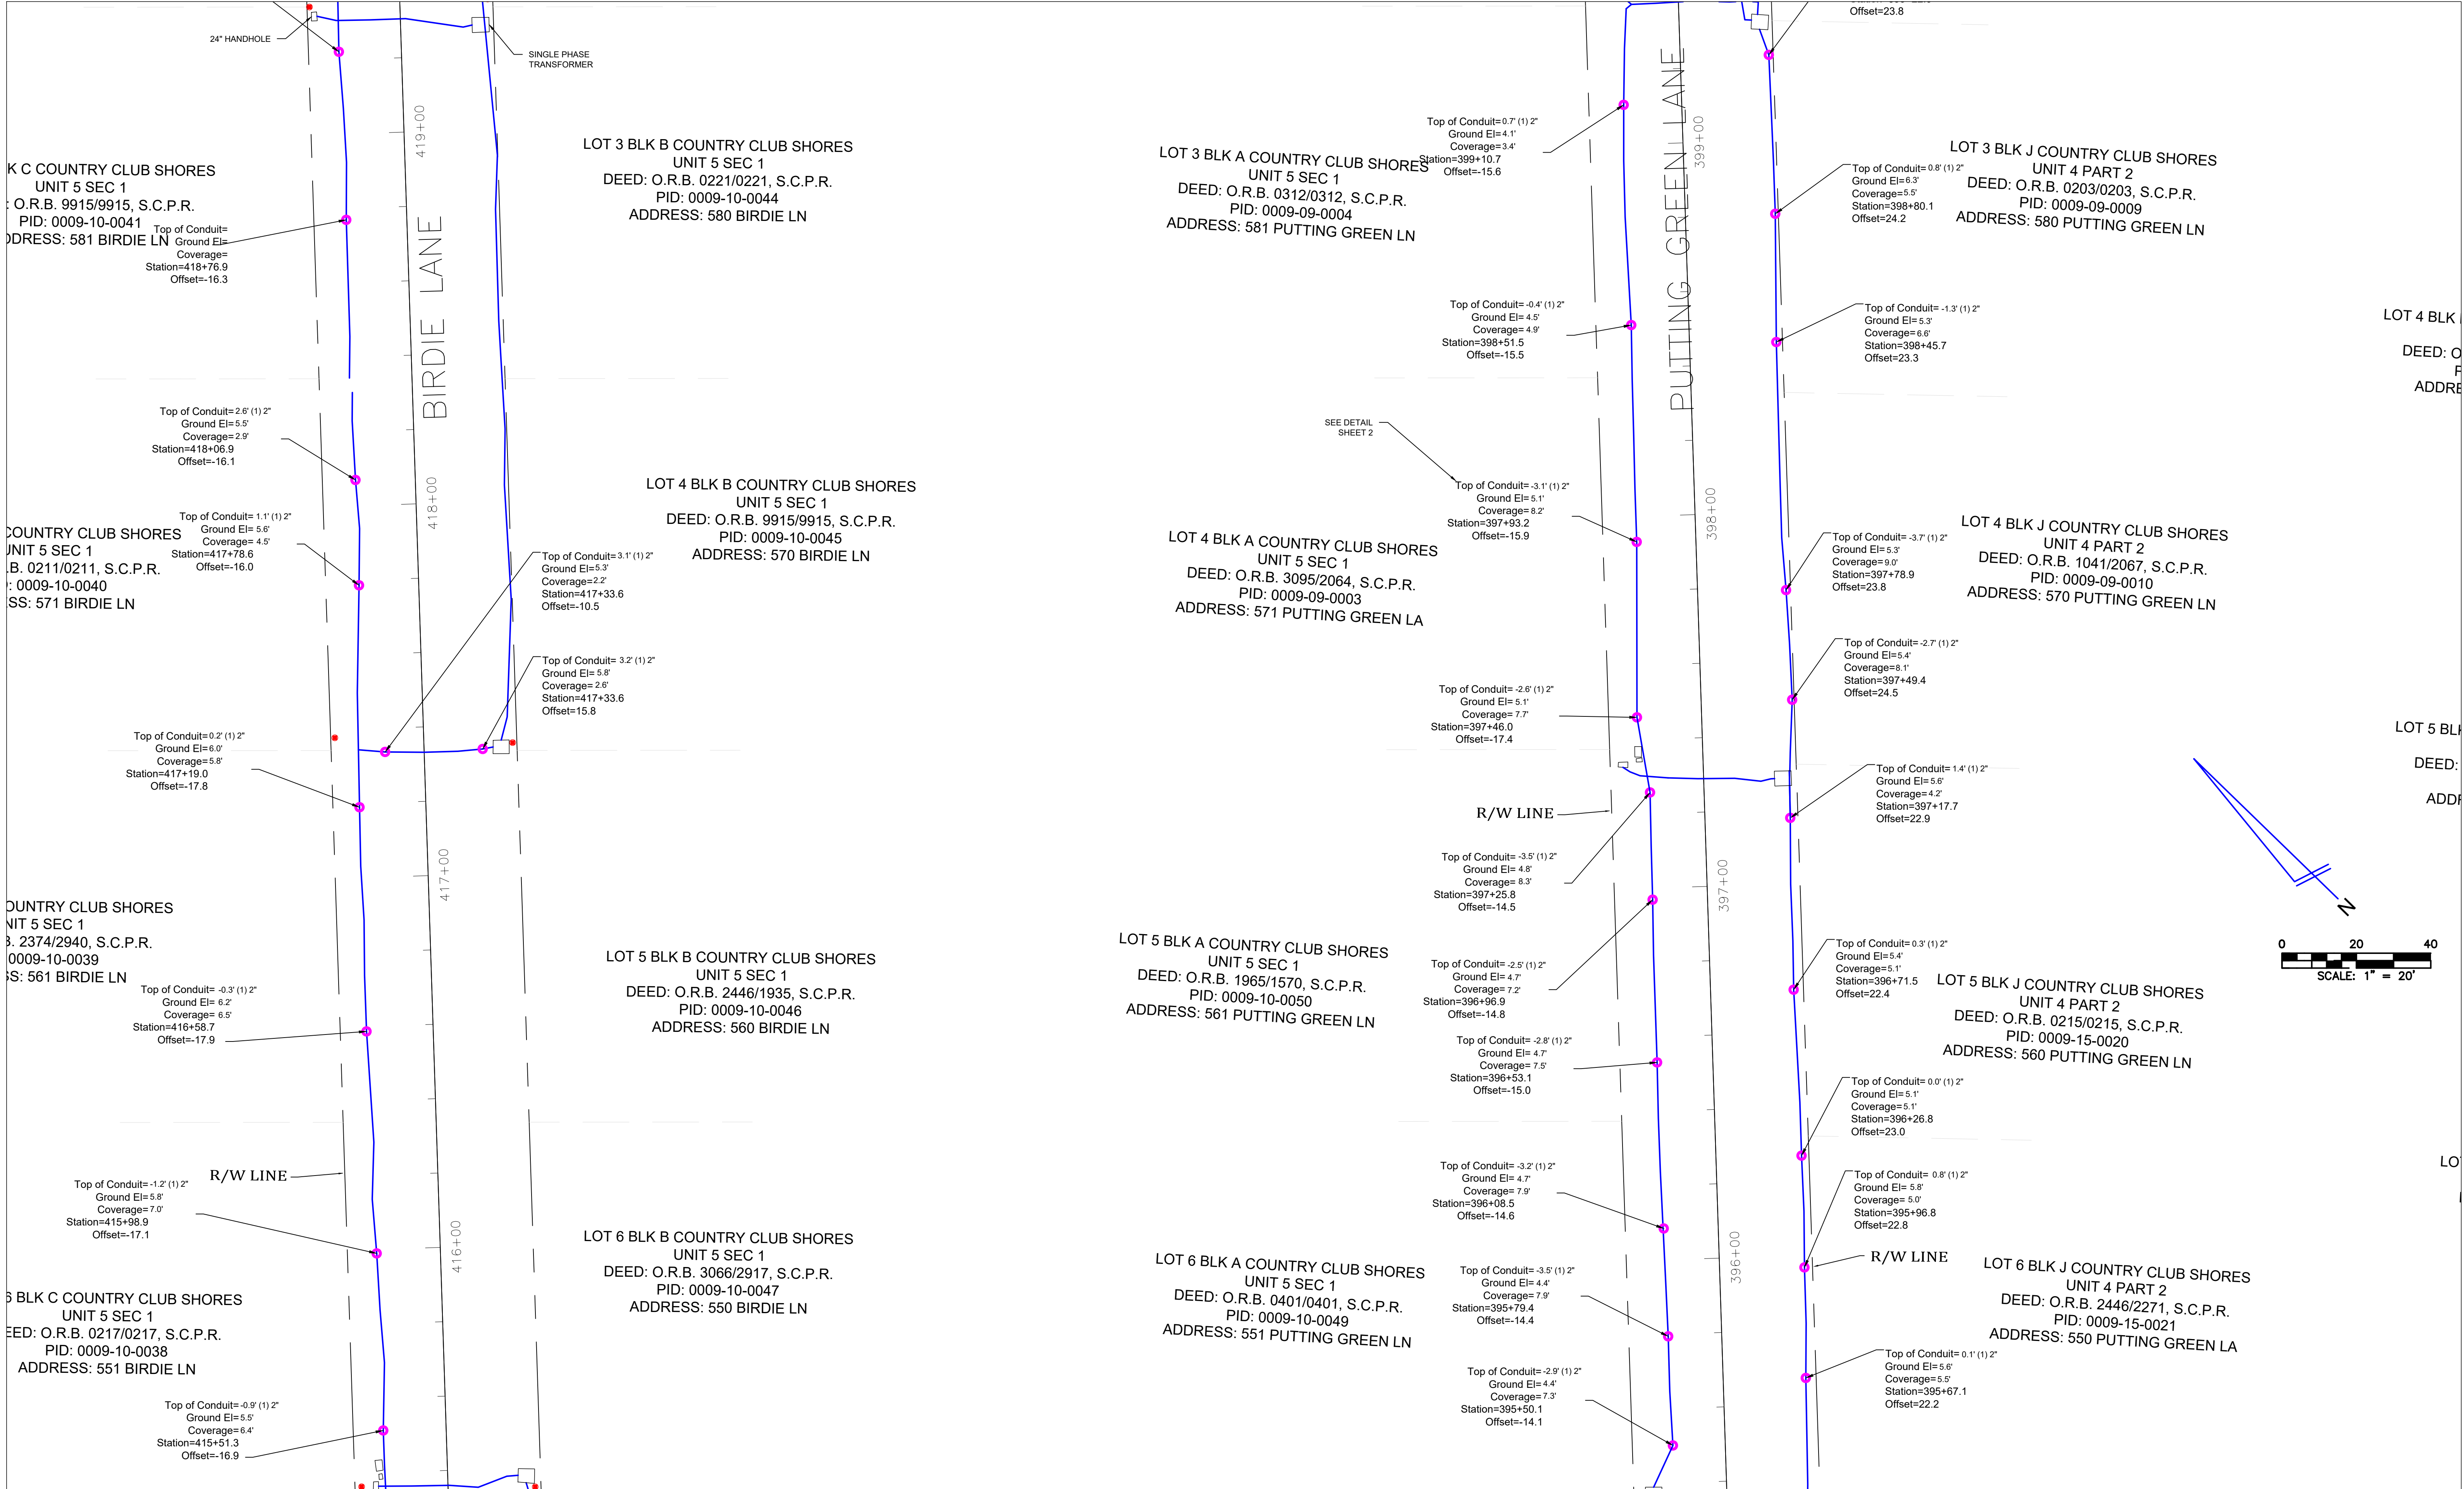


TITLE: AS-BUILT SURVEY "LONGBOAT KEY UNDERGROUND" (PHASE 1 SOUTH)

LOCATION: SECTIONS 16, 21 & 22, TOWNSHIP 36 SOUTH, RANGE 17 EAST, SARASOTA COUNTY, FLORIDA

BULLSEYE SURVEYING, INC.
LB 7818
2198 NE COACHMAN ROAD, UNIT F, CLEARWATER, FL 33765
Phone: (727) 475-8088


FILE: 19-040-AS-BUILTS	Drawn By: GRM/AMW
PROJECT NUMBER: 19-040	Date: 10/26/2020
	Scale: 1" = 20'

MATCH SHEET 33

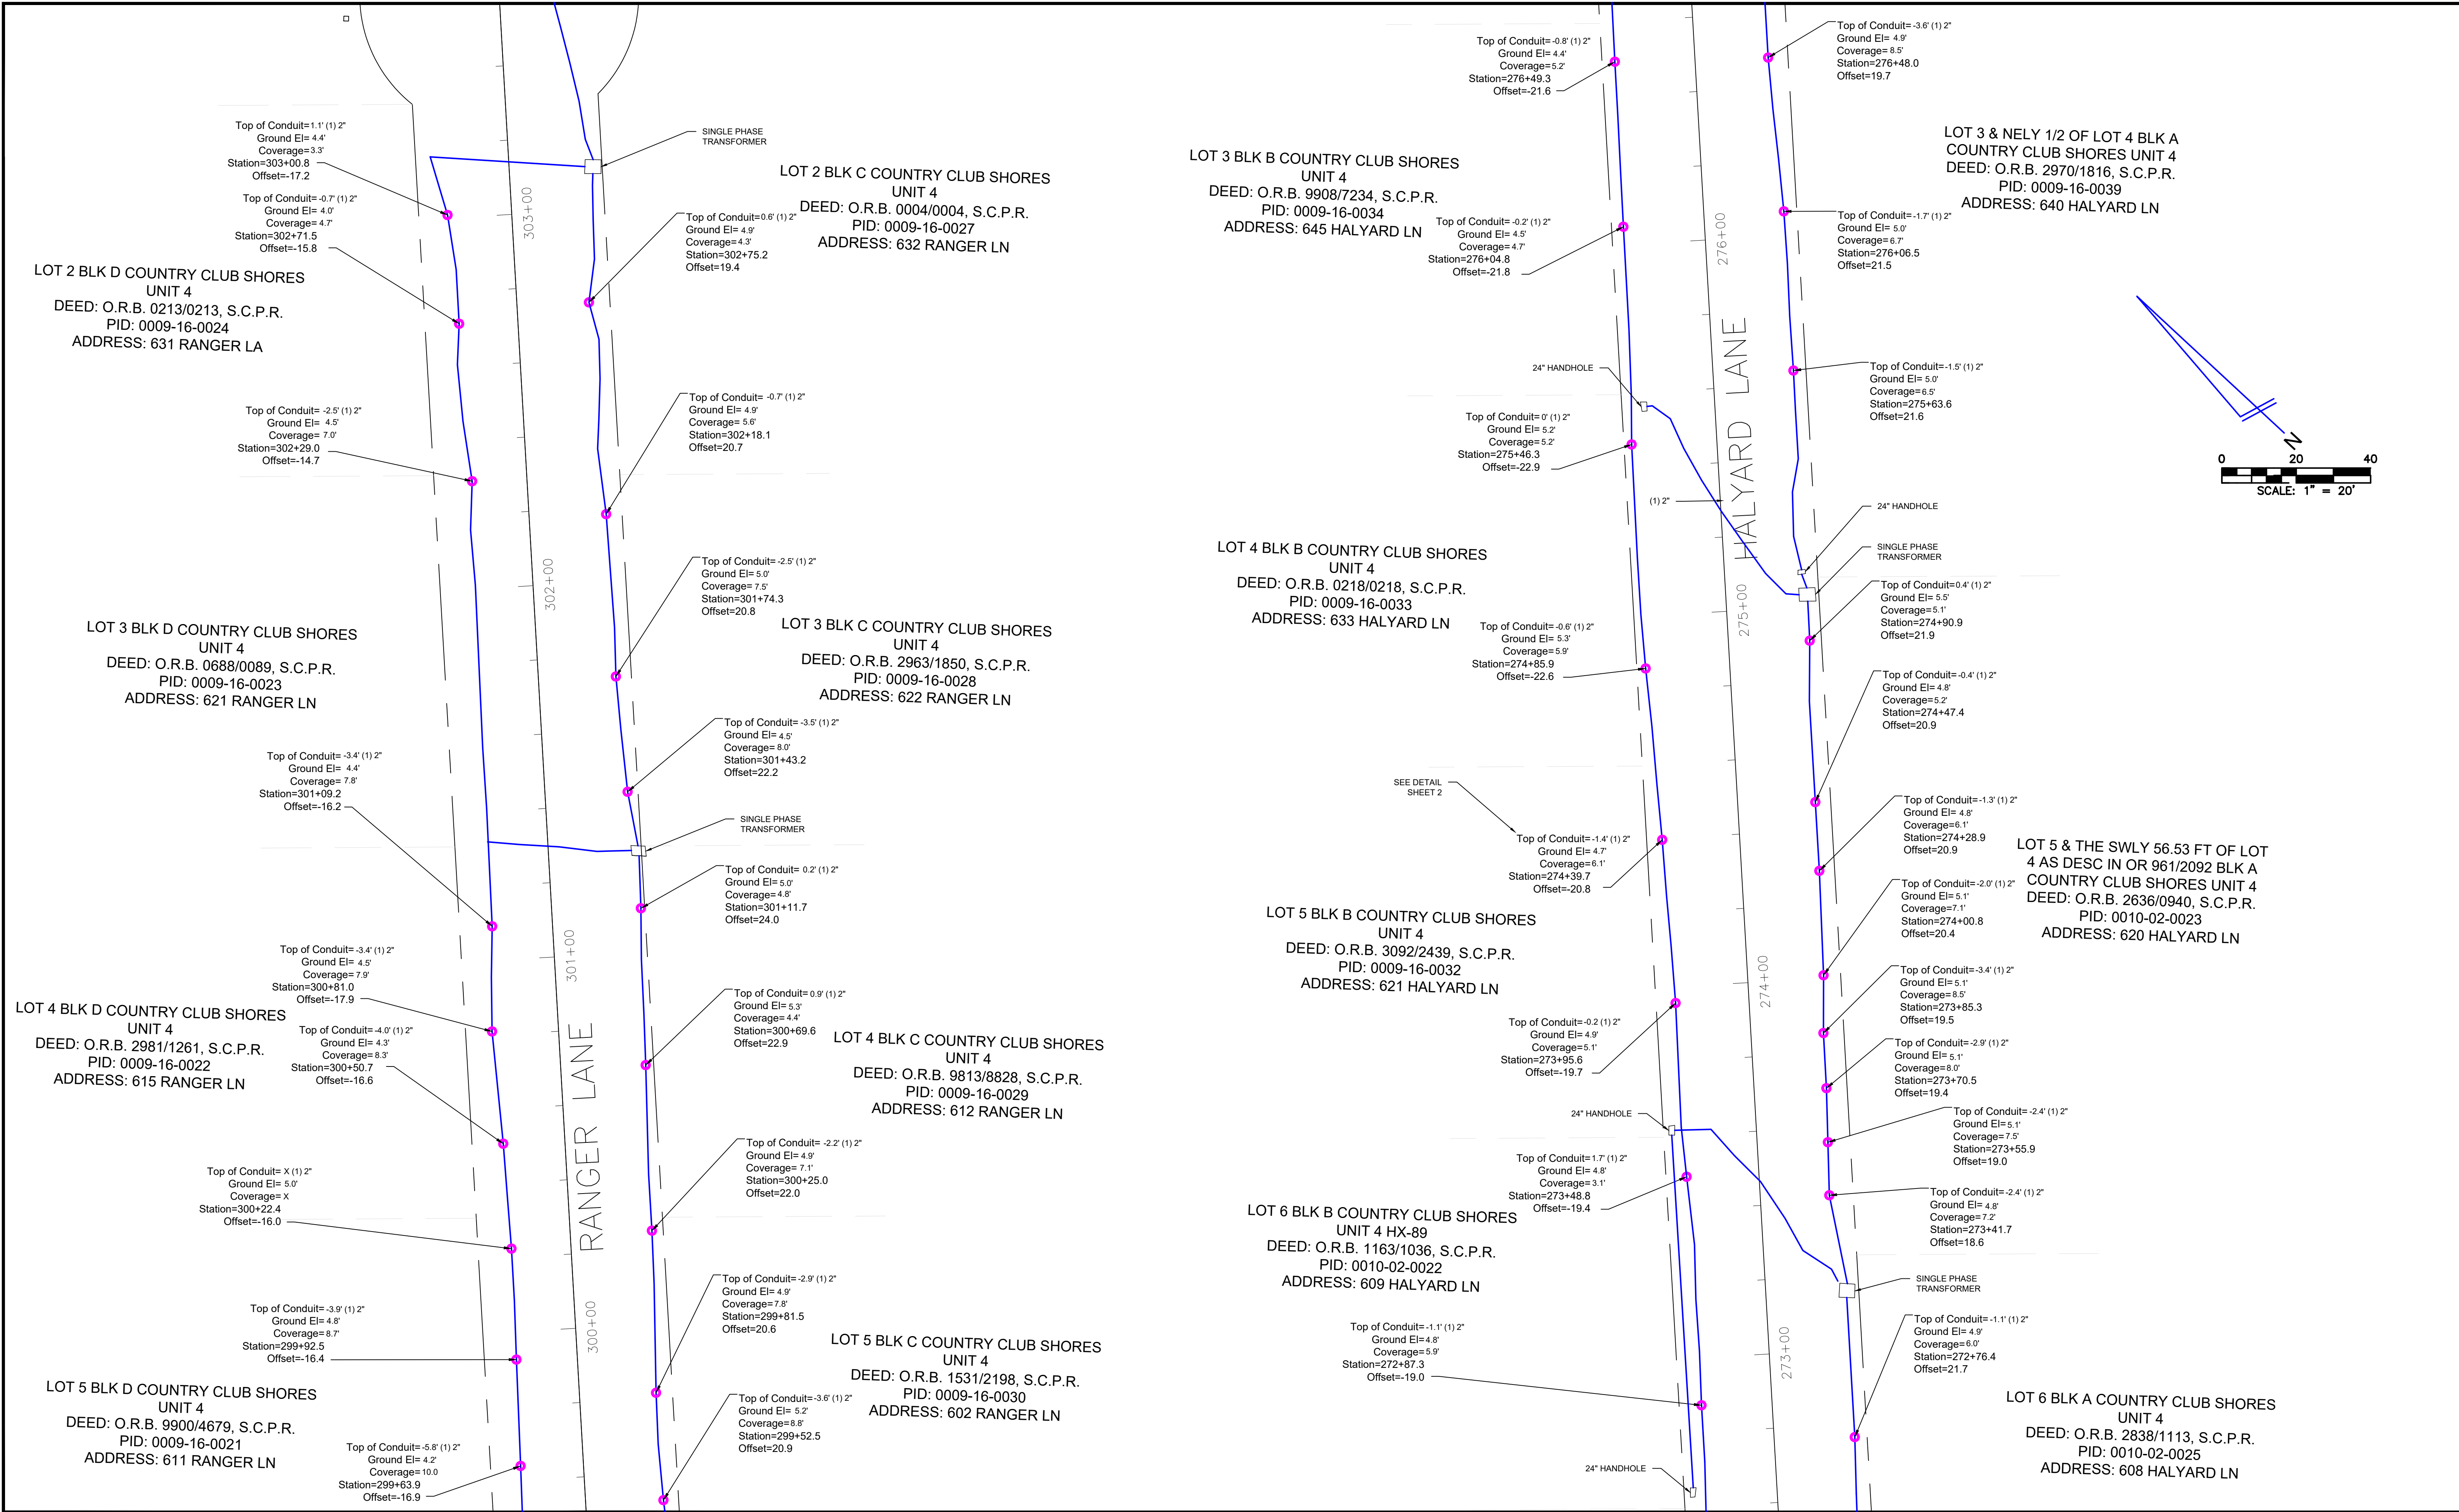


TITLE: AS-BUILT SURVEY "LONGBOAT KEY UNDERGROUND" (PHASE 1 SOUTH)

LOCATION: SECTIONS 16, 21 & 22, TOWNSHIP 36 SOUTH, RANGE 17 EAST, SARASOTA COUNTY, FLORIDA

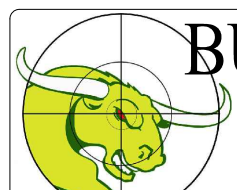


BULLSEYE SURVEYING, INC.
LB 7818
2198 NE COACHMAN ROAD, UNIT F, CLEARWATER, FL 33765
Phone: (727) 475-8088

FILE: 19-040-AS-BUILTS	Drawn By: GRM/AMW
PROJECT NUMBER: 19-040	Date: 10/26/2020
	Scale: 1" = 20'

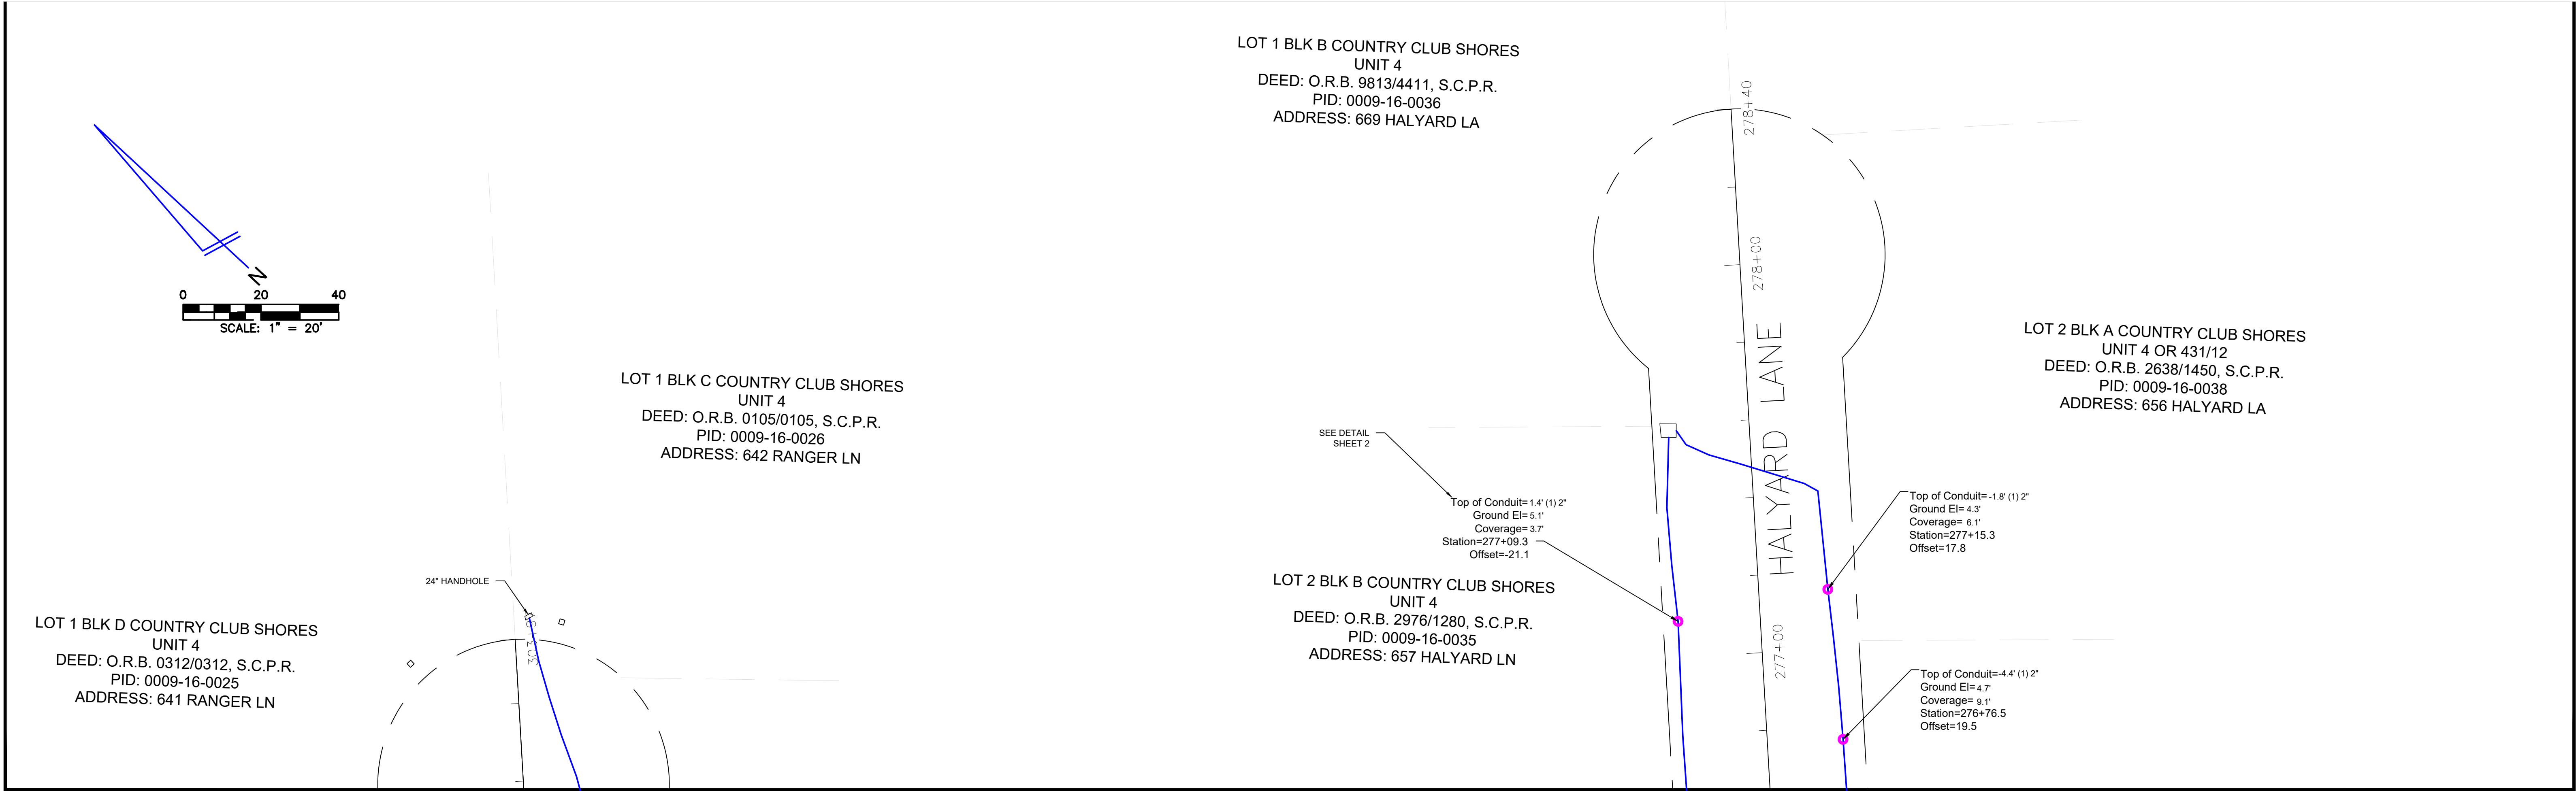

TITLE: AS-BUILT SURVEY "LONGBOAT KEY UNDERGROUND" (PHASE 1 SOUTH)


LOCATION: SECTIONS 16, 21 & 22, TOWNSHIP 36 SOUTH, RANGE 17 EAST, SARASOTA COUNTY, FLORIDA

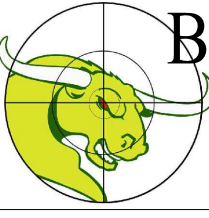

BULLSEYE SURVEYING, INC.
LB 7818
2198 NE COACHMAN ROAD, UNIT F, CLEARWATER, FL 33765
Phone: (727) 475-8088

FILE: 19-040-AS-BUILTS	Drawn By: GRM/AMW
PROJECT NUMBER: 19-040	Date: 10/26/2020 Scale: 1" = 20'

MATCH SHEET 34

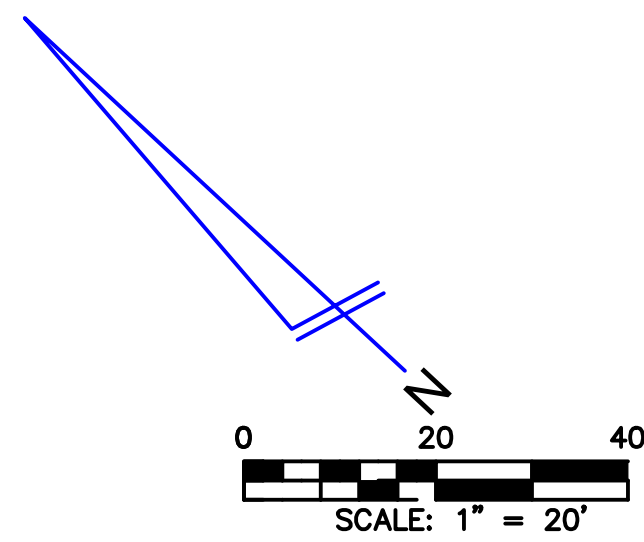

LOT 1 BLK H COUNTRY CLUB SHORES
UNIT 4 PART 2
DEED: O.R.B. 0111/0111, S.C.P.R.
PID: 0009-09-0013
ADDRESS: 621 YARDARM LN

LOT 2 BLK H COUNTRY CLUB SHORES
UNIT 4 PART 2 OR 2498/1057
DEED: O.R.B. 2498/1056, S.C.P.R.
PID: 0009-09-0012
ADDRESS: 611 YARDARM LN

LOT 3 BLK H COUNTRY CLUB SHORES
UNIT 4 PART 2
DEED: O.R.B. 0115/0115, S.C.P.R.
PID: 0009-09-0011
ADDRESS: 601 YARDARM LN

LOT 1 BLK G COUNTRY CLUB SHORES
UNIT 4 PART 2
DEED: O.R.B. 0322/0322, S.C.P.R.
PID: 0009-09-0014
ADDRESS: 620 YARDARM LN

LOT 2 BLK G COUNTRY CLUB SHORES
UNIT 4 PART 2
DEED: O.R.B. 0307/0307, S.C.P.R.
PID: 0009-09-0015
ADDRESS: 610 YARDARM LN

LOT 3 BLK G COUNTRY CLUB SHORES
UNIT 4 PART 2 OR 2653/627
DEED: O.R.B. 2653/0625, S.C.P.R.
PID: 0009-16-0001
ADDRESS: 600 YARDARM LN

LOT 1 BLK F COUNTRY CLUB SHORES
UNIT 4 PART 2
DEED: O.R.B. 2651/2262, S.C.P.R.
PID: 0009-09-0017
ADDRESS: 611 BOWSPRIT LN

LOT 2 BLK F COUNTRY CLUB SHORES
UNIT 4 PART 2
DEED: O.R.B. 9816/0548, S.C.P.R.
PID: 0009-16-0010
ADDRESS: 603 BOWSPRIT LA

LOT 3 BLK F COUNTRY CLUB SHORES
UNIT 4 PART 2 OR 2877/0524
DEED: O.R.B. 0318/0318, S.C.P.R.
PID: 0009-16-0009
ADDRESS: 595 BOWSPRIT LN

LOT 4 BLK F COUNTRY CLUB SHORES
UNIT 4 PART 2
DEED: O.R.B. 2715/2048, S.C.P.R.
PID: 0009-16-0008
ADDRESS: 591 BOWSPRIT LN

LOT 1 BLK E COUNTRY CLUB SHORES
UNIT 4 PART 2
DEED: O.R.B. 3089/1530, S.C.P.R.
PID: 0009-16-0011
ADDRESS: 620 BOWSPRIT LN

LOT 2 BLK E COUNTRY CLUB SHORES
UNIT 4 PART 2
DEED: O.R.B. 0400/0400, S.C.P.R.
PID: 0009-16-0012
ADDRESS: 610 BOWSPRIT LN


LOT 3 BLK E COUNTRY CLUB SHORES
UNIT 4 PART 2
DEED: O.R.B. 0221/0221, S.C.P.R.
PID: 0009-16-0013
ADDRESS: 600 BOWSPRIT LN

LOT 4 BLK E COUNTRY CLUB SHORES
UNIT 4 PART 2
DEED: O.R.B. 2721/2796, S.C.P.R.
PID: 0009-16-0014
ADDRESS: 590 BOWSPRIT LN

MATCH SHEET 29

TITLE: AS-BUILT SURVEY "LONGBOAT KEY UNDERGROUND" (PHASE 1 SOUTH)

LOCATION: SECTIONS 16, 21 & 22, TOWNSHIP 36 SOUTH, RANGE 17 EAST, SARASOTA COUNTY, FLORIDA

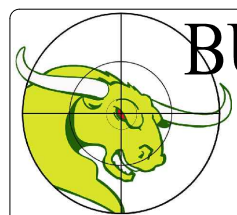

BULLSEYE SURVEYING, INC.

LB 7818
2198 NE COACHMAN ROAD, UNIT F, CLEARWATER, FL 33765
Phone: (727) 475-8088

FILE: 19-040-AS-BUILTS

Drawn By: GRM/AMW

PROJECT NUMBER: 19-040

Date: 10/26/2020

Scale: 1" = 20'

SHEET


33

OF 45

MATCH SHEET 31

MATCH SHEET 44


MATCH SHEET 33

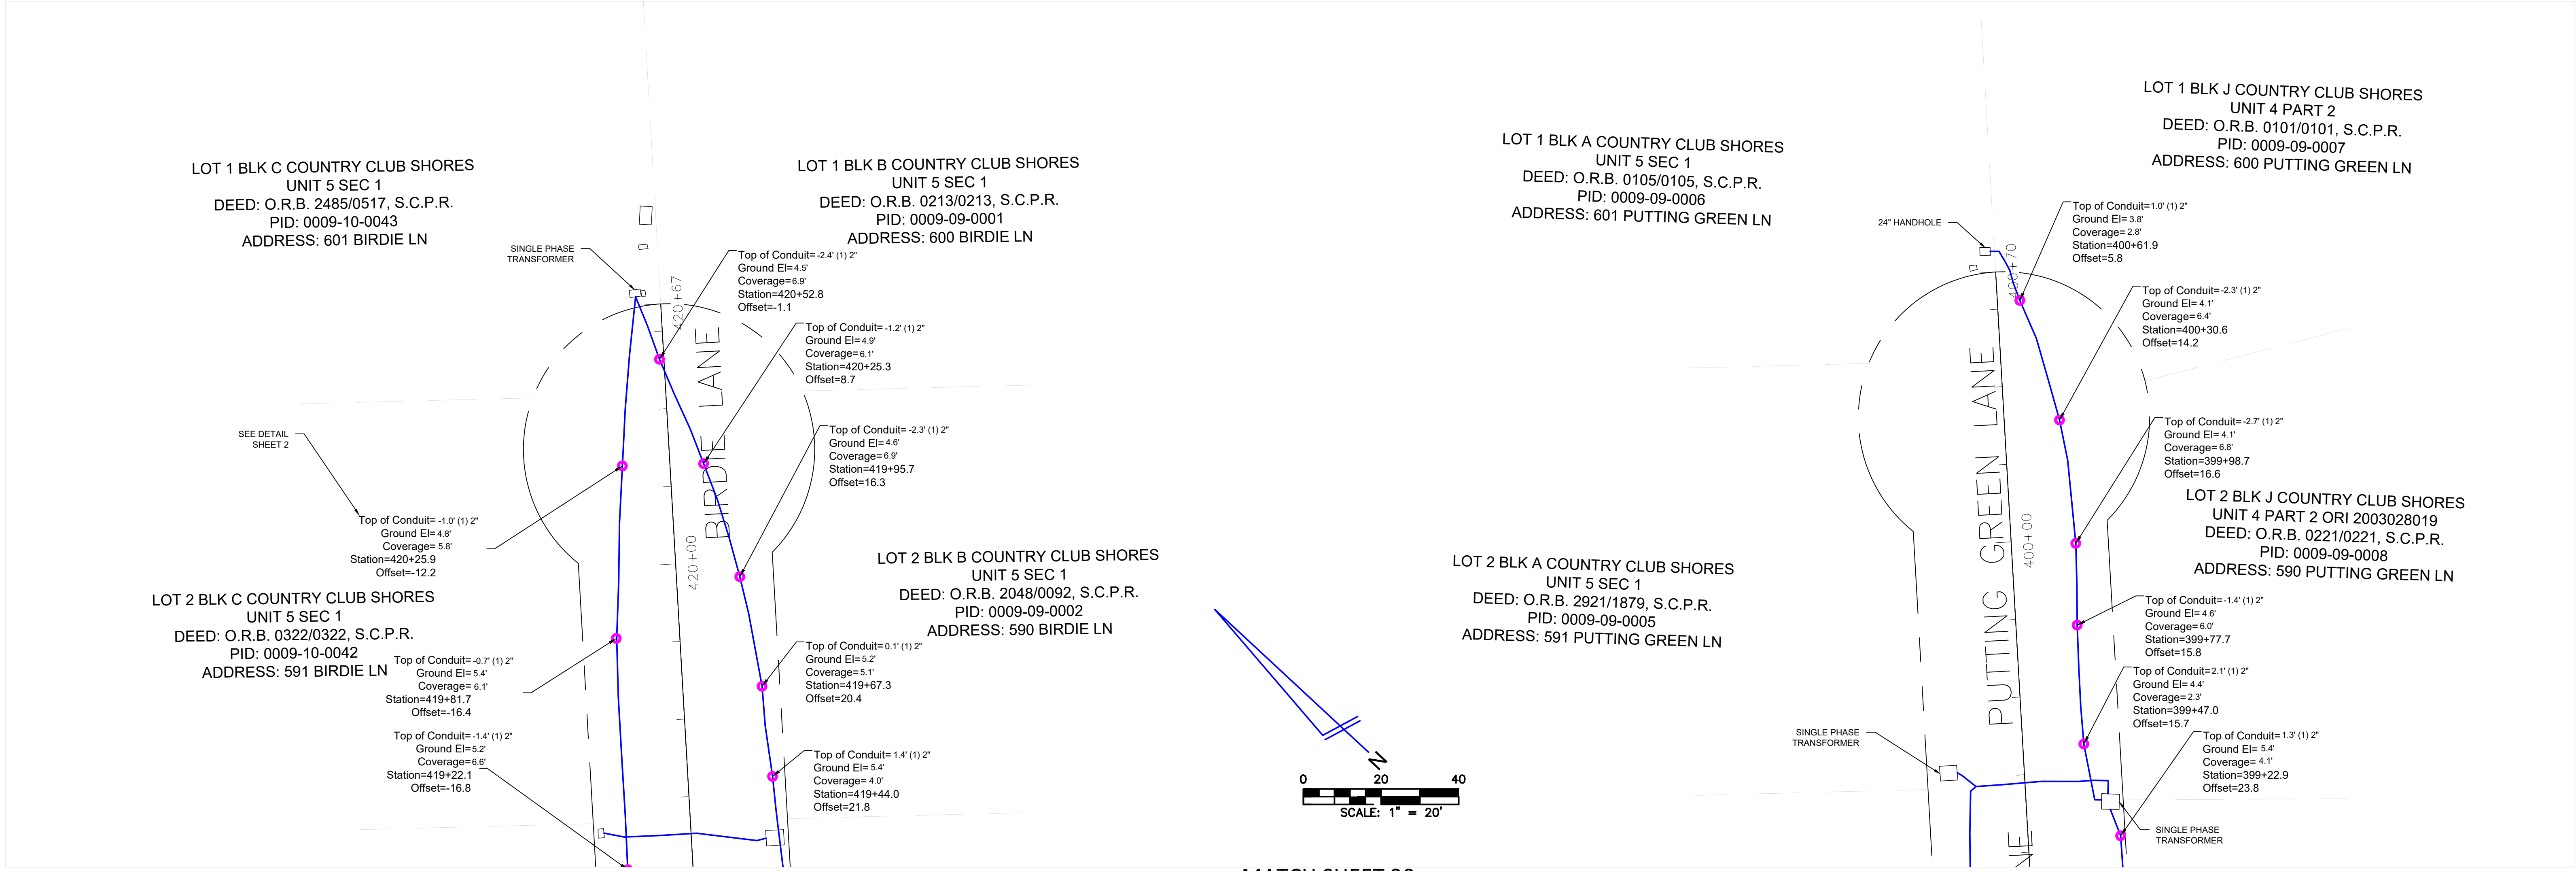

MATCH SHEET 30

TITLE: AS-BUILT SURVEY "LONGBOAT KEY UNDERGROUND" (PHASE 1 SOUTH)

LOCATION: SECTIONS 16, 21 & 22, TOWNSHIP 36 SOUTH, RANGE 17 EAST, SARASOTA COUNTY, FLORIDA

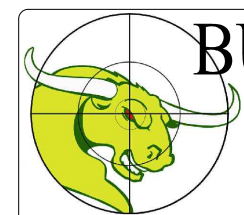

BULLSEYE SURVEYING, INC.


LB 7818
2198 NE COACHMAN ROAD, UNIT F, CLEARWATER, FL 33765
Phone: (727) 475-8088

FILE: 19-040-AS-BUILTS
PROJECT NUMBER: 19-040

Drawn By: GRM/AMW
Date: 10/26/2020

Scale: 1" = 20'

SHEET
34
OF 45

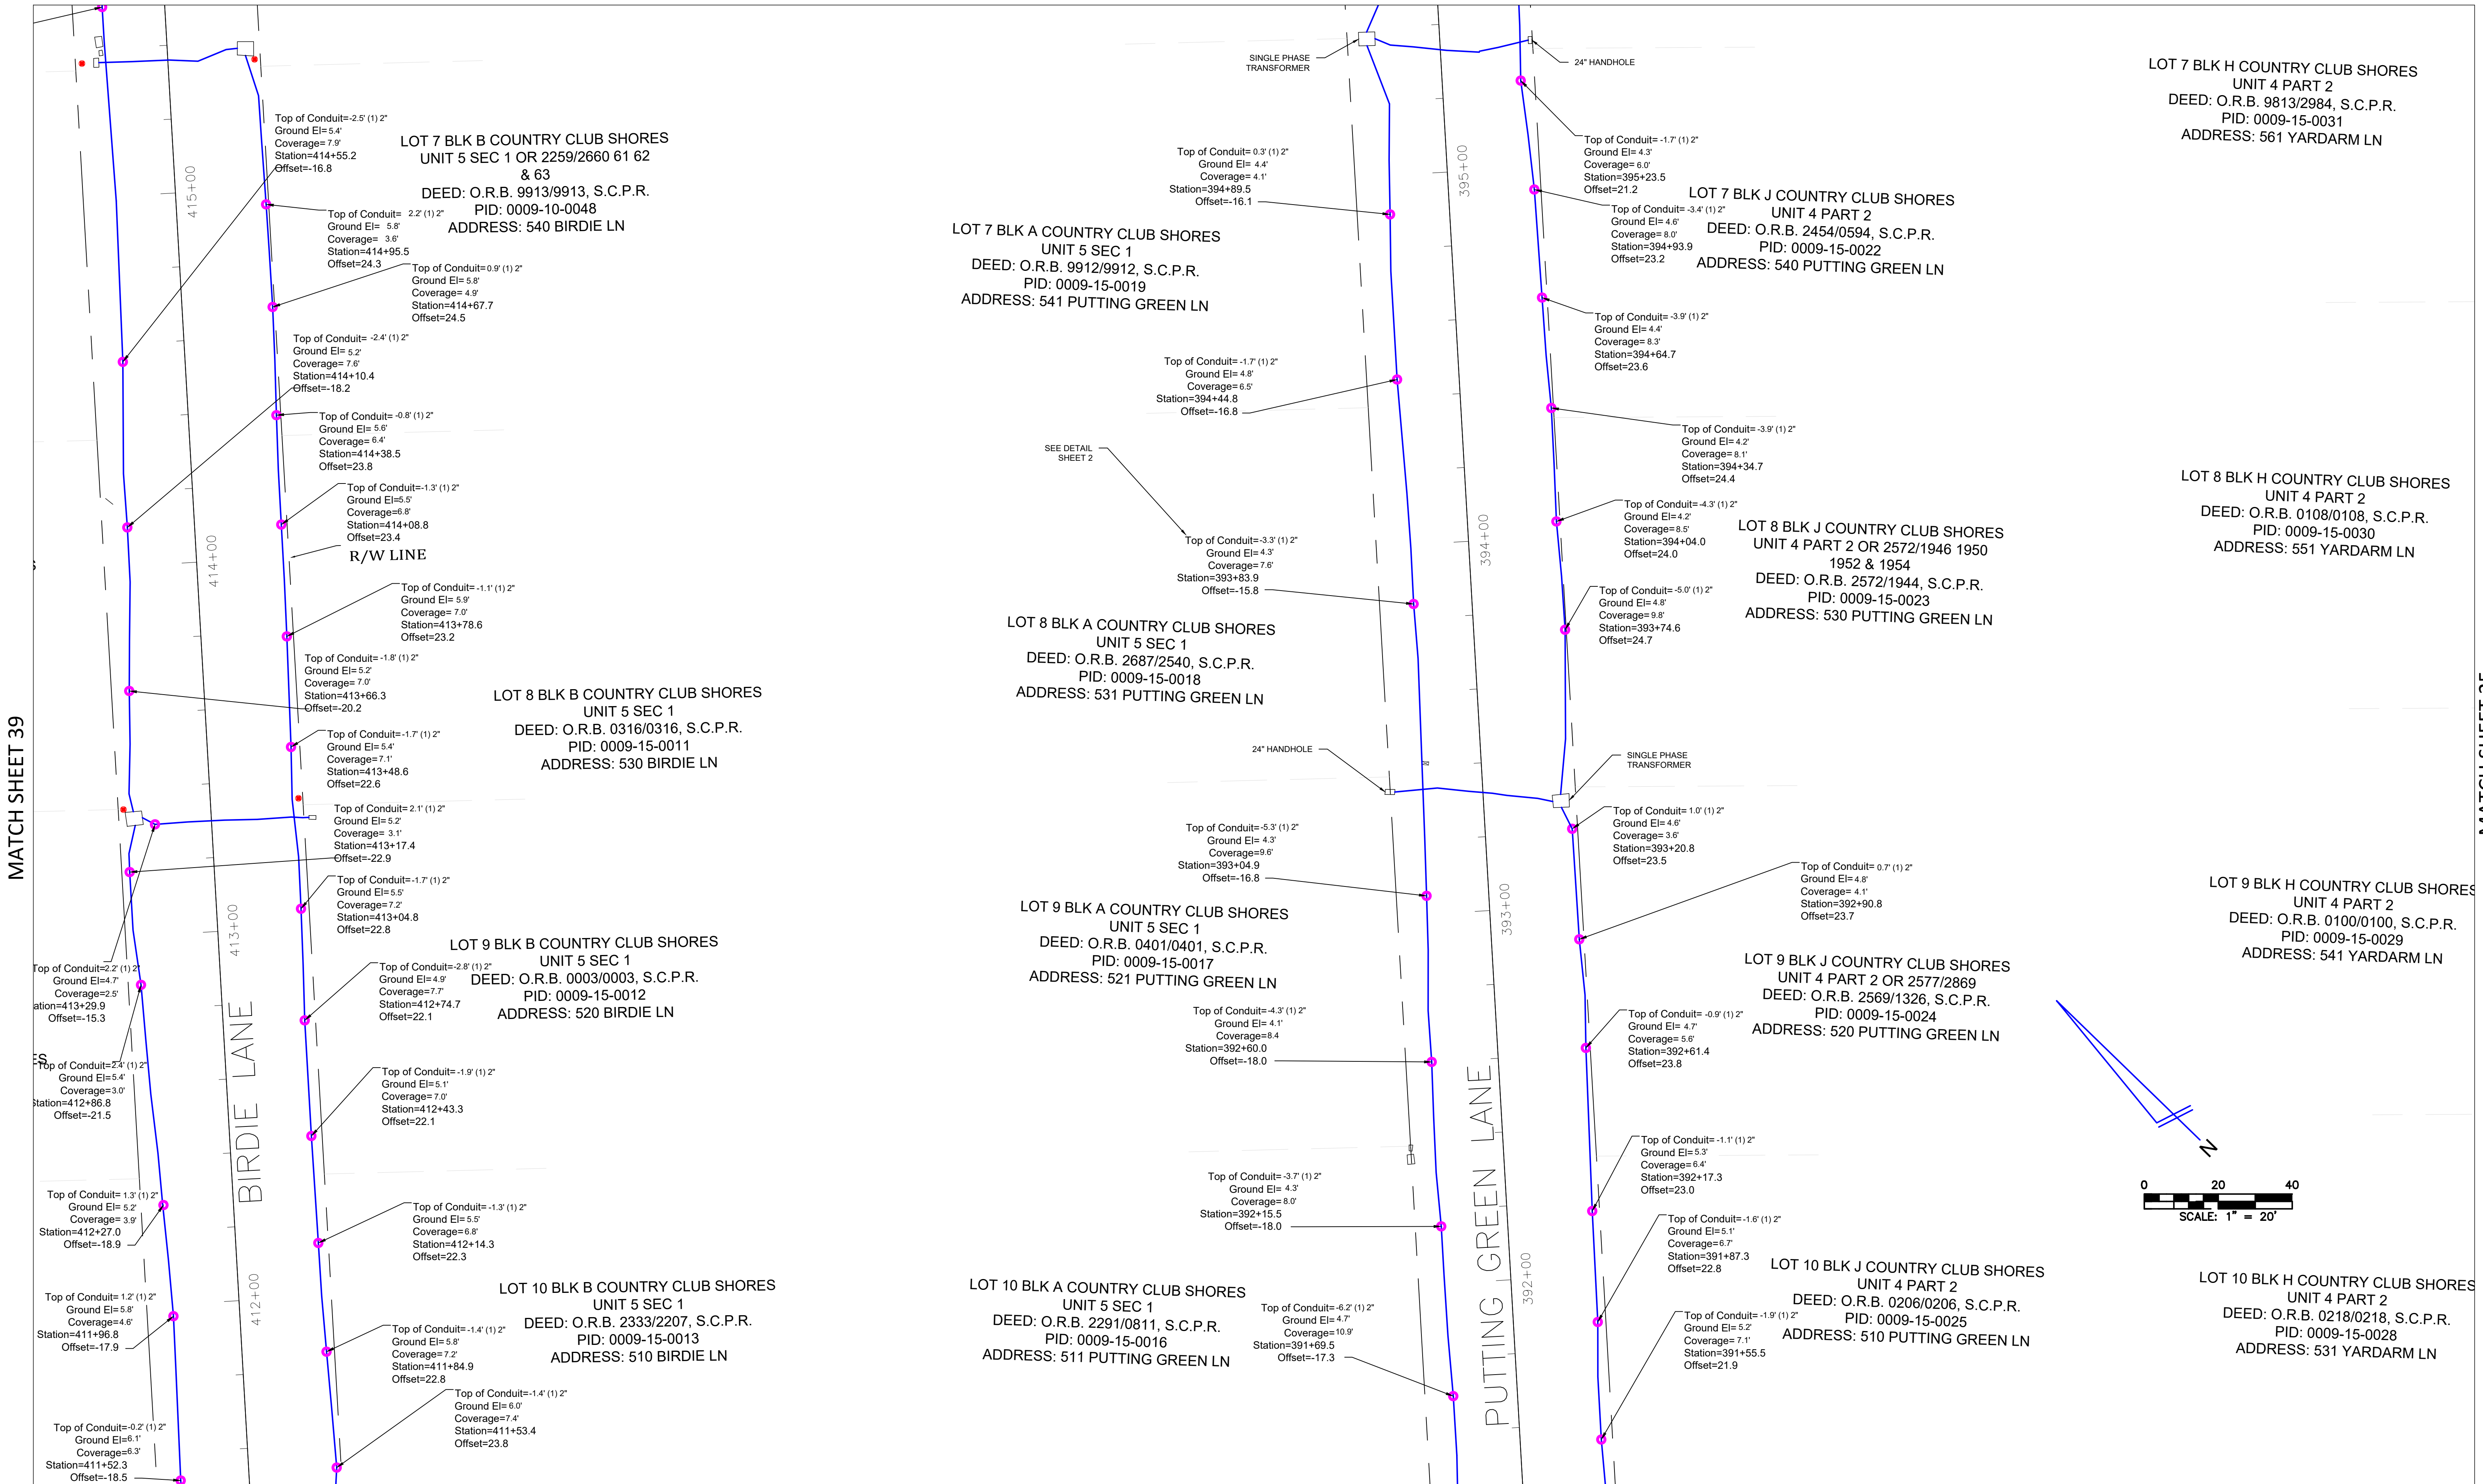



TITLE: AS-BUILT SURVEY "LONGBOAT KEY UNDERGROUND" (PHASE 1 SOUTH)

LOCATION: SECTIONS 16, 21 & 22, TOWNSHIP 36 SOUTH, RANGE 17 EAST, SARASOTA COUNTY, FLORIDA

BULLSEYE SURVEYING, INC.
LB 7818
2198 NE COACHMAN ROAD, UNIT F, CLEARWATER, FL 33765
Phone: (727) 475-8088


FILE: 19-040-AS-BUILTS	Drawn By: GRM/AMW
PROJECT NUMBER: 19-040	Date: 10/26/2020
	Scale: 1" = 20'

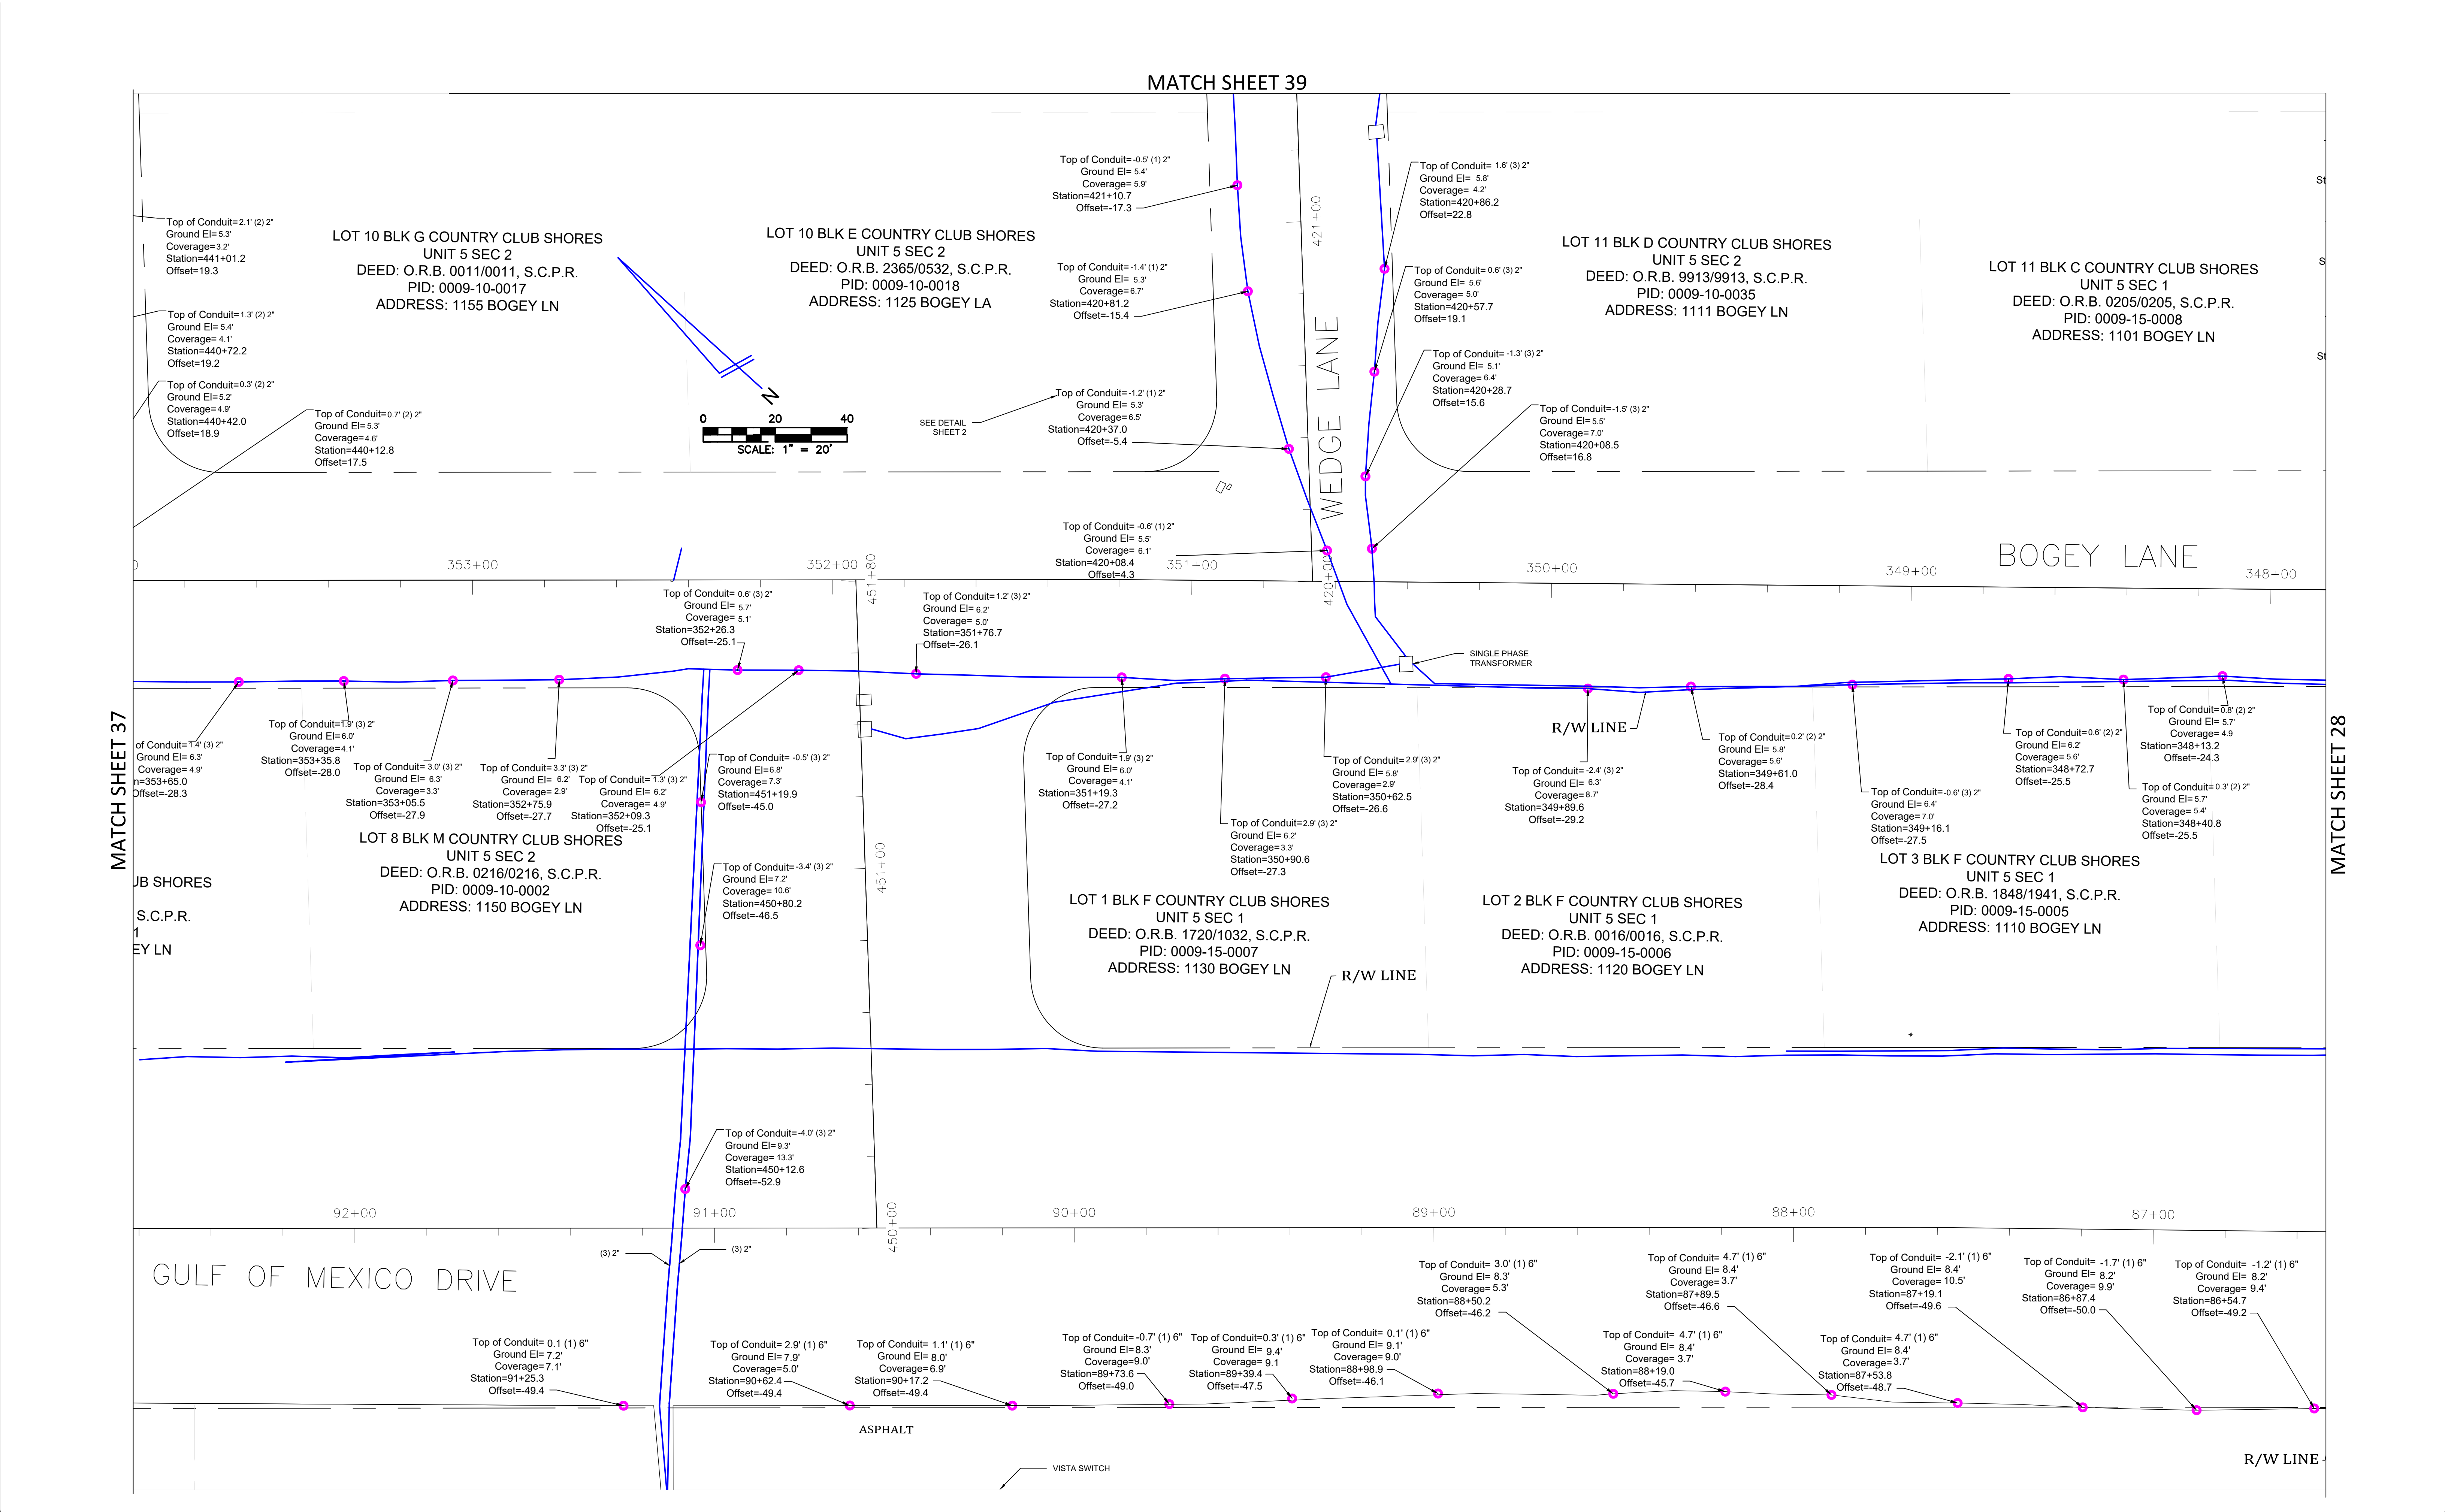

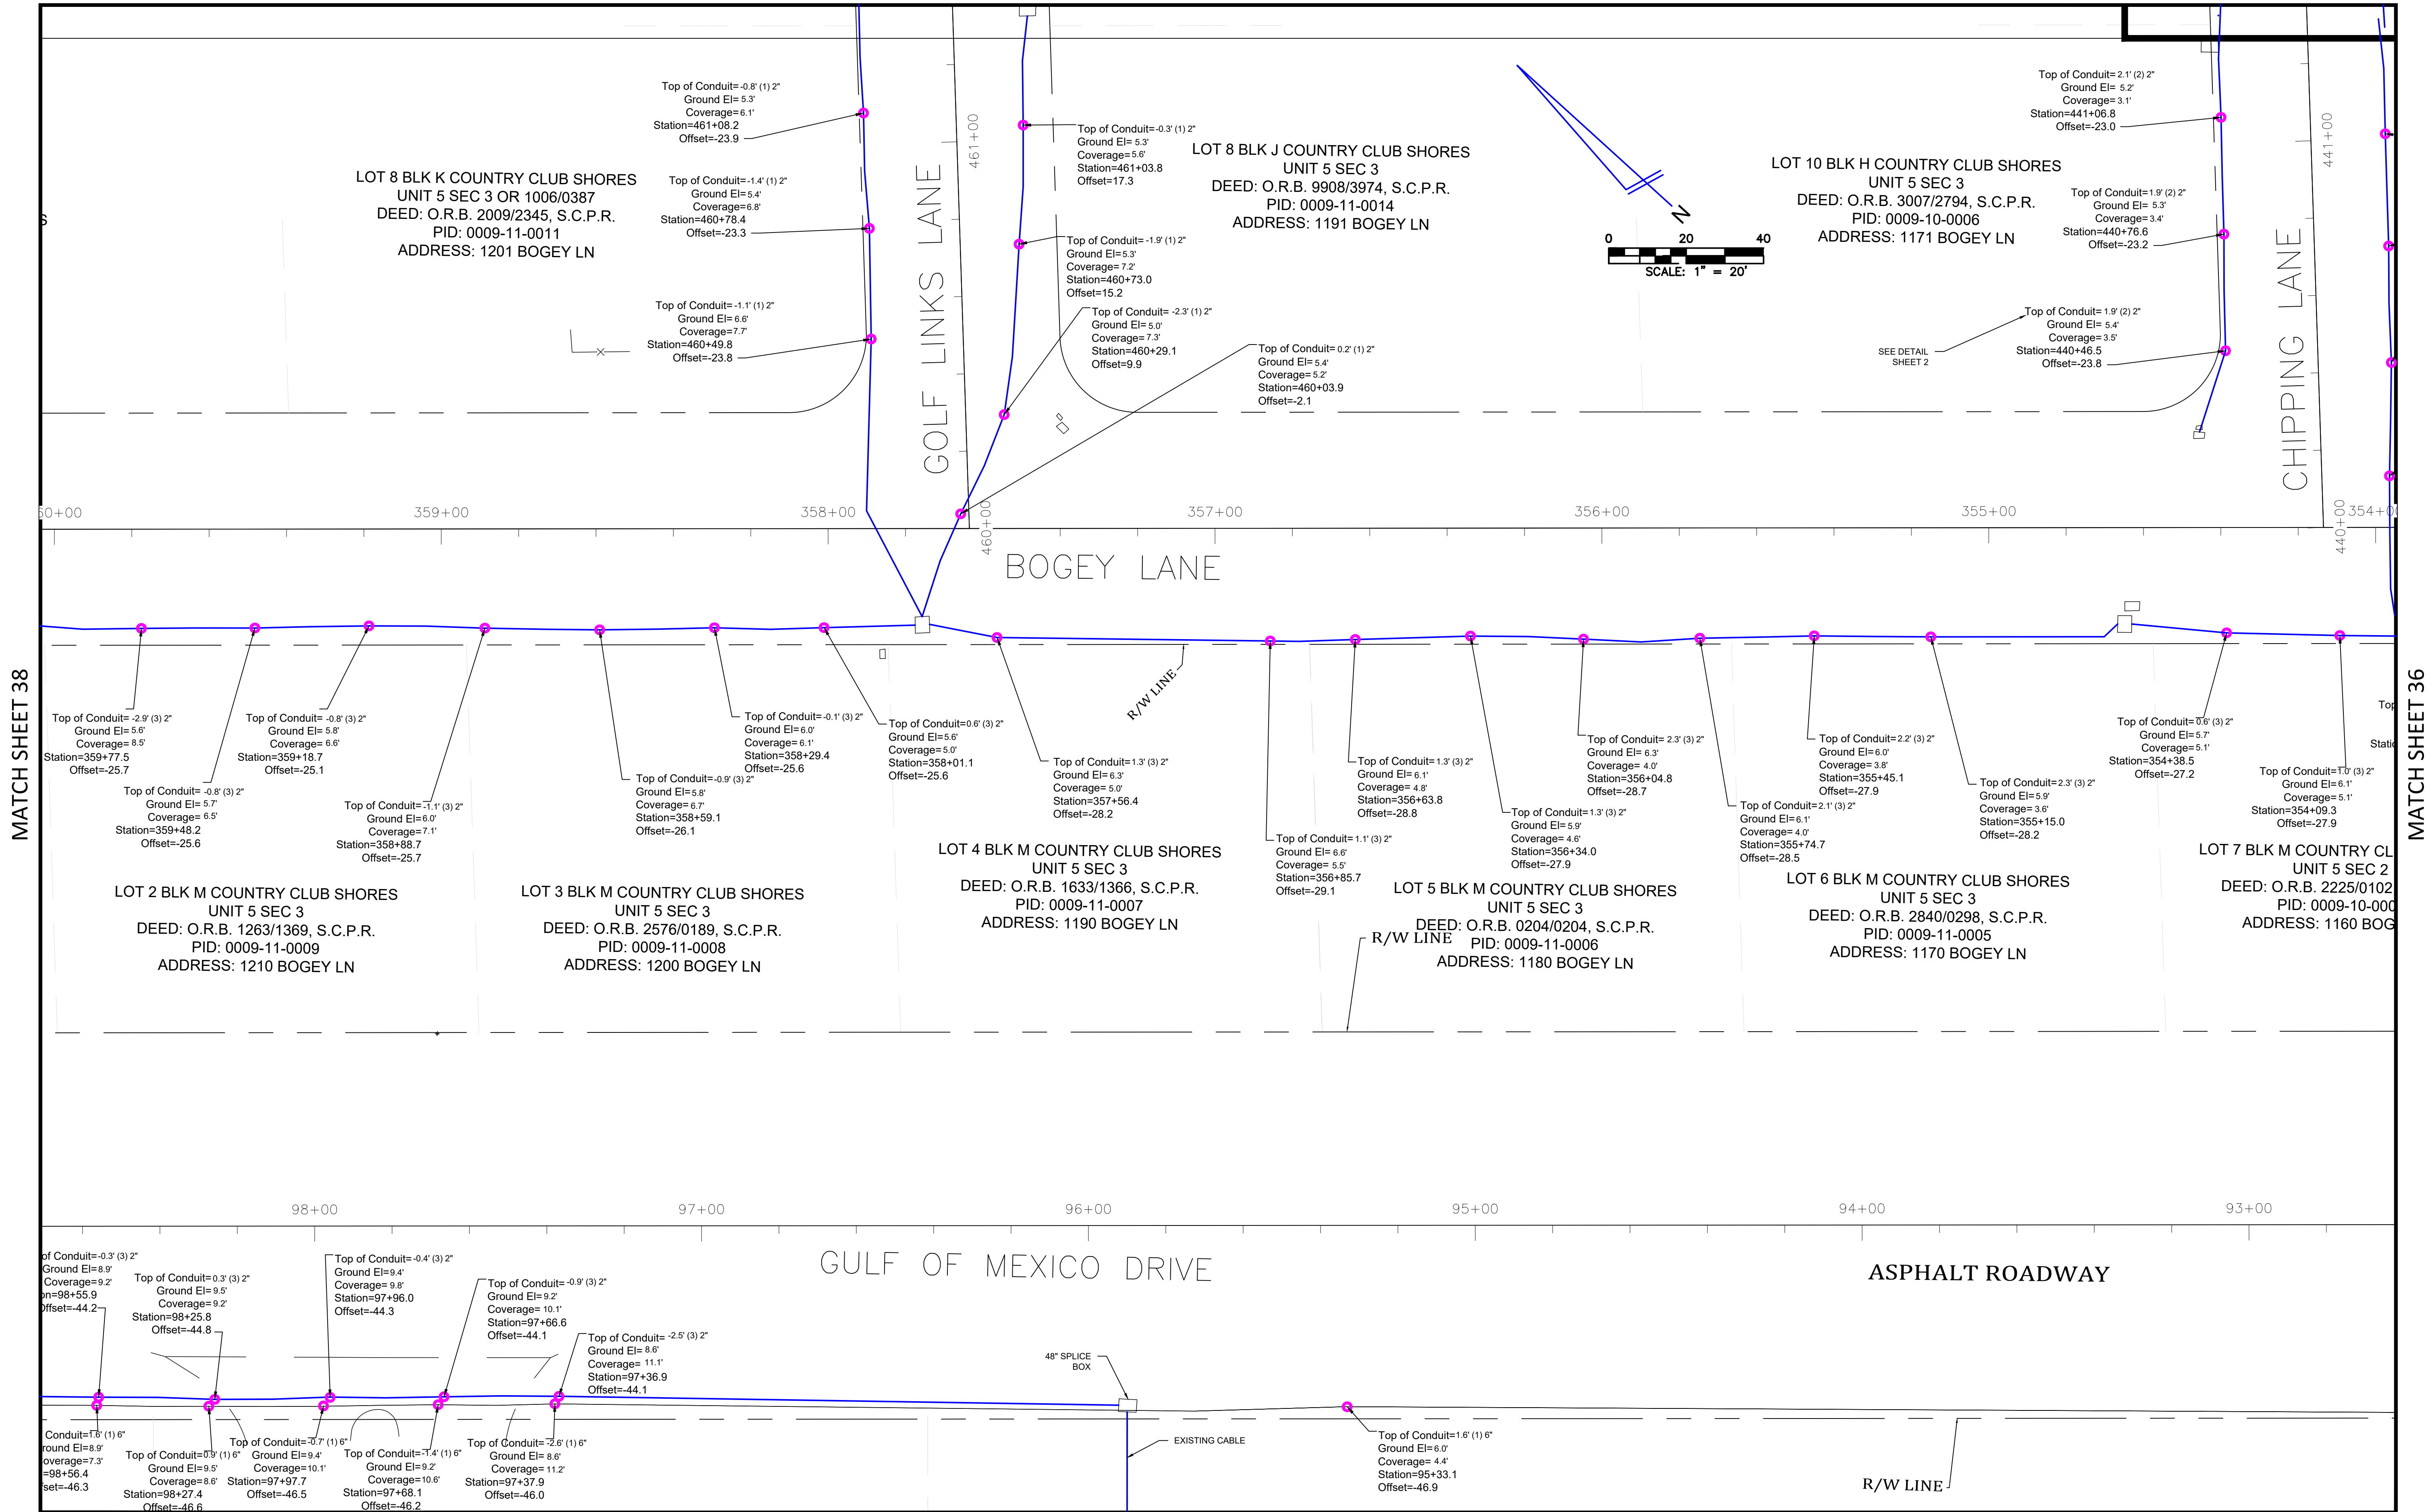

TITLE: AS-BUILT SURVEY "LONGBOAT KEY UNDERGROUND" (PHASE 1 SOUTH)


LOCATION: SECTIONS 16, 21 & 22, TOWNSHIP 36 SOUTH, RANGE 17 EAST, SARASOTA COUNTY, FLORIDA

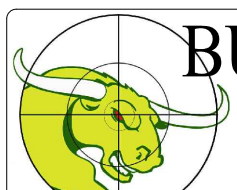

BULLSEYE SURVEYING, INC.
LB 7818
2198 NE COACHMAN ROAD, UNIT F, CLEARWATER, FL 33765
Phone: (727) 475-8088


FILE: 19-040-AS-BUILTS	Drawn By: GRM/AMW
PROJECT NUMBER: 19-040	Date: 10/26/2020
	Scale: 1" = 20'

MATCH SHEET 41

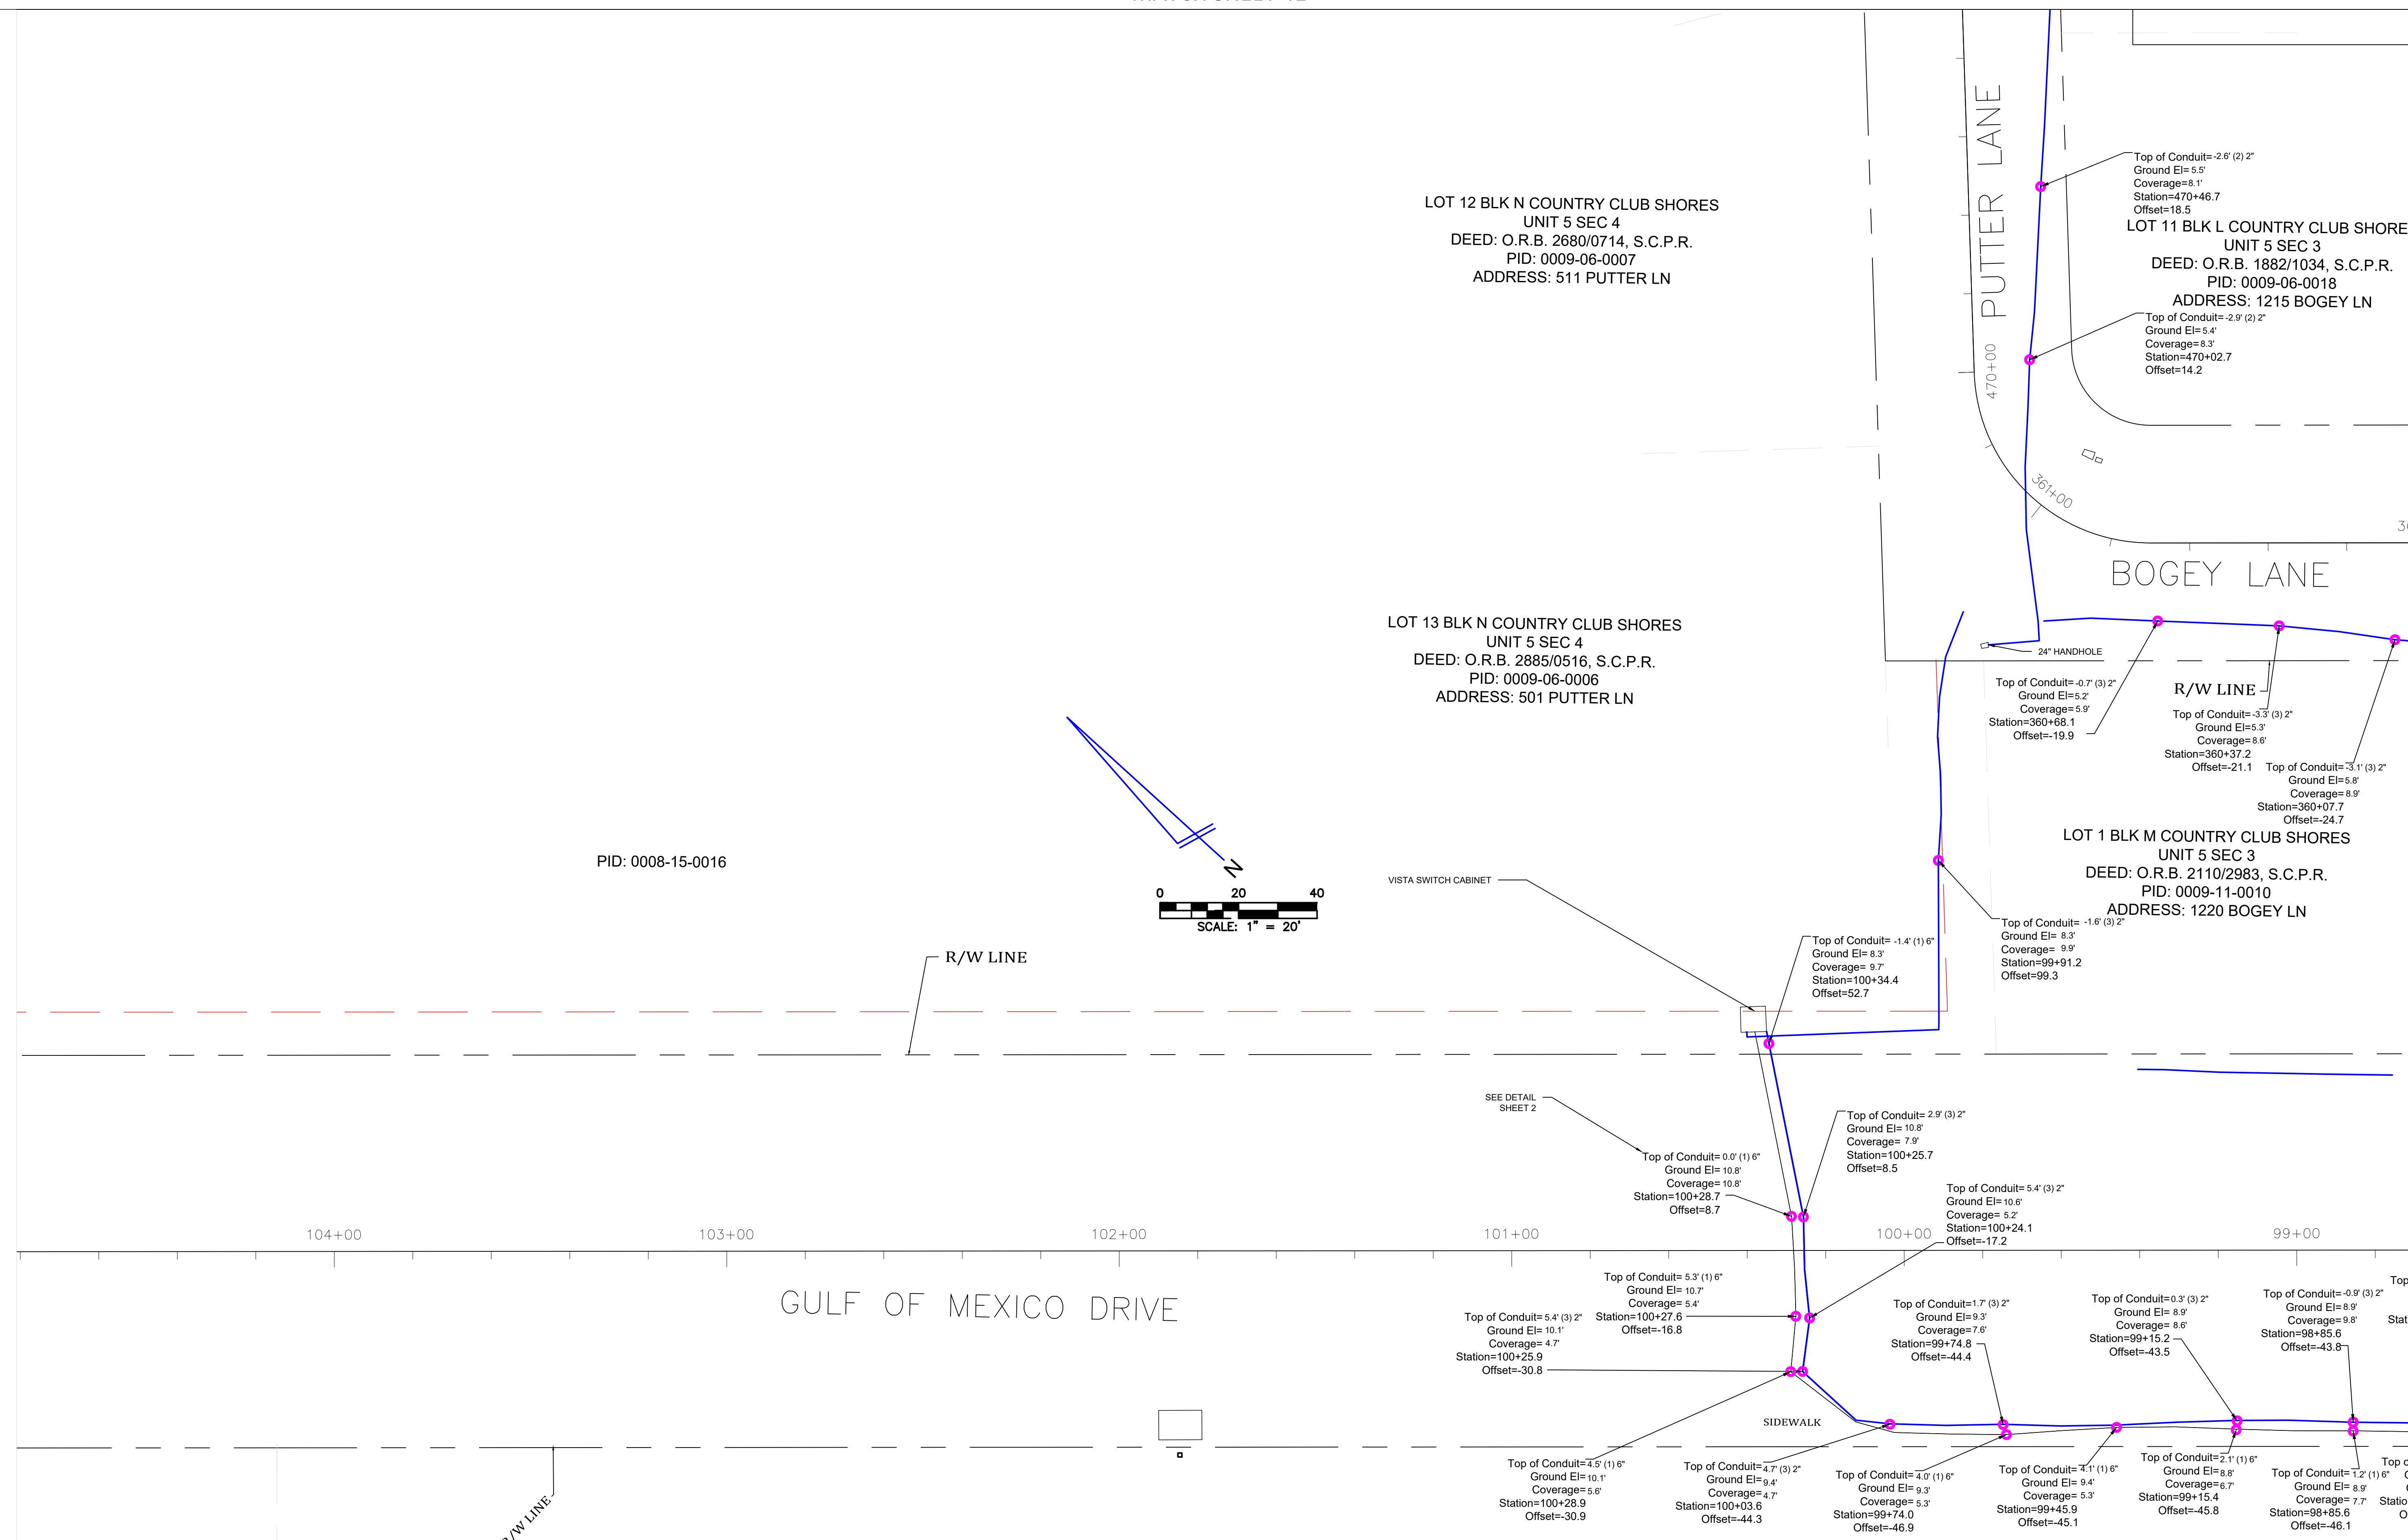


TITLE: AS-BUILT SURVEY "LONGBOAT KEY UNDERGROUND" (PHASE 1 SOUTH)

LOCATION: SECTIONS 16, 21 & 22, TOWNSHIP 36 SOUTH, RANGE 17 EAST, SARASOTA COUNTY, FLORIDA

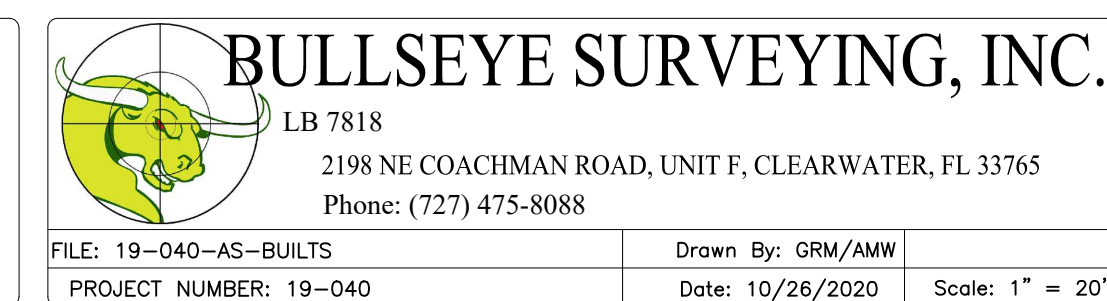

SHEET
38
OF 45

MATCH SHEET 42

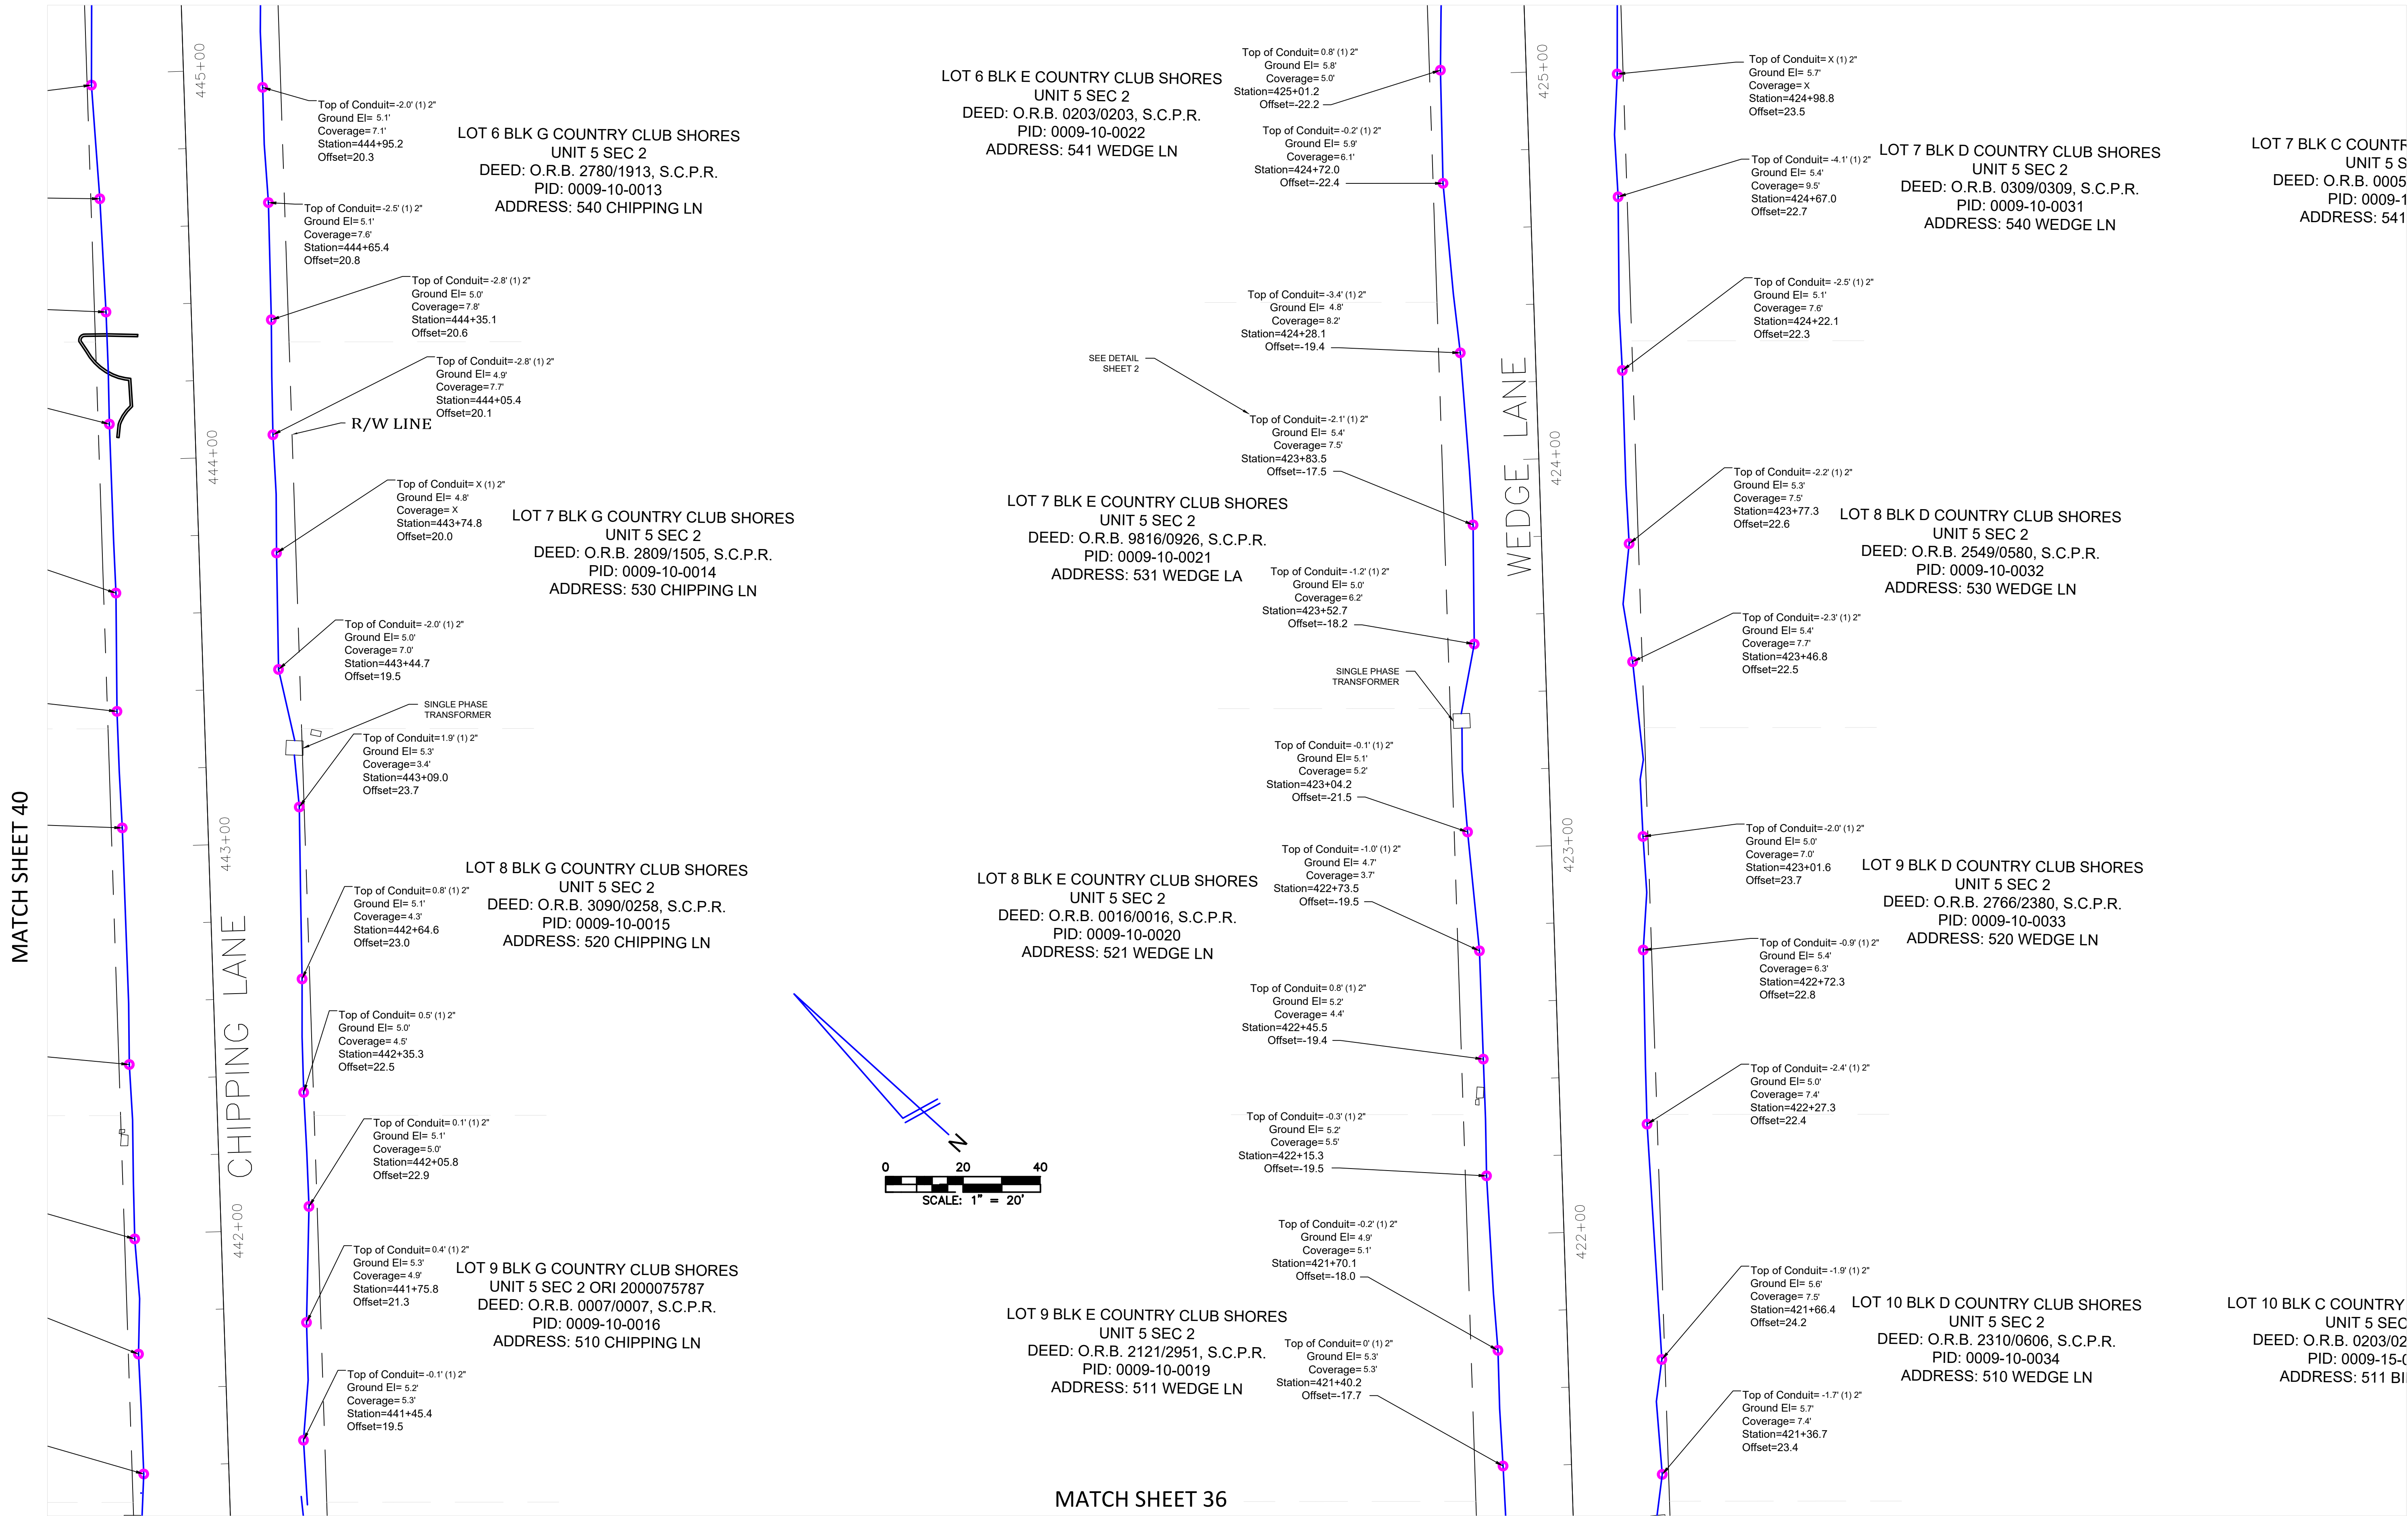

TITLE: AS-BUILT SURVEY "LONGBOAT KEY UNDERGROUND" (PHASE 1 SOUTH)

LOCATION: SECTIONS 16, 21 & 22, TOWNSHIP 36 SOUTH, RANGE 17 EAST, SARASOTA COUNTY, FLORIDA

BULLSEYE SURVEYING, INC.
LB 7818
2198 NE COACHMAN ROAD, UNIT F, CLEARWATER, FL 33765
Phone: (727) 475-8088

FILE: 19-040-AS-BUILTS	Drawn By: GRM/MMW
PROJECT NUMBER: 19-040	Date: 10/26/2020

Scale: 1" = 20'

SHEET
39
OF 45

MATCH SHEET 43

MATCH SHEET 41

LOT 4 BLK K COUNTRY CLUB SHORES
UNIT 5 SEC 3
DEED: O.R.B. 2272/0431, S.C.P.R.
PID: 0009-07-0005
ADDRESS: 541 GOLF LINKS LN

LOT 5 BLK K COUNTRY CLUB SHORES
UNIT 5 SEC 3
DEED: O.R.B. 2471/0550, S.C.P.R.
PID: 0009-07-0004
ADDRESS: 531 GOLF LINKS LN

LOT 6 BLK K COUNTRY CLUB SHORES
UNIT 5 SEC 3
DEED: O.R.B. 0314/0314, S.C.P.R.
PID: 0009-11-0013
ADDRESS: 521 GOLF LINKS LN

LOT 7 BLK K COUNTRY CLUB SHORES
UNIT 5 SEC 3 ORI 2001077780
DEED: O.R.B. 0104/0104, S.C.P.R.
PID: 0009-11-0012
ADDRESS: 511 GOLF LINKS LN

Top of Conduit= 0.5' (1) 2"
Ground El= 4.8'
Coverage= 4.3'
Station=464+77.7
Offset=-22.8

Top of Conduit= -1.3' (1) 2"
Ground El= 4.1'
Coverage= 5.4'
Station=464+34.9
Offset=-23.3

Top of Conduit= -1.7' (1) 2"
Ground El= 4.4'
Coverage= 6.1'
Station=464+04.1
Offset=-21.3

Top of Conduit= -2.4' (1) 2"
Ground El= 4.6'
Coverage= 7.0'
Station=463+78.8
Offset=-18.8

Top of Conduit= 1.5' (1) 2"
Ground El= 4.6'
Coverage= 3.1'
Station=463+01.4
Offset=-16.7

Top of Conduit= 0.8' (1) 2"
Ground El= 4.5'
Coverage= 3.7'
Station=462+71.1
Offset=-17.2

Top of Conduit= -0.3' (1) 2"
Ground El= 4.7'
Coverage= 5.0'
Station=462+41.8
Offset=-19.4

Top of Conduit= -1.5' (1) 2"
Ground El= 4.8'
Coverage= 6.3'
Station=461+97.8
Offset=-22.7

Top of Conduit= -1.7' (1) 2"
Ground El= 5.1'
Coverage= 6.8'
Station=461+52.8
Offset=-24.1

0 20 40
SCALE: 1" = 20'

465+00

GOLF LINKS LANE

462+00

Top of Conduit=-0.7' (1) 2"
Ground El= 4.7'
Coverage=5.4'
Station=464+89.6
Offset=19.7

Top of Conduit=-1.6' (1) 2"
Ground El= 4.7'
Coverage=6.3'
Station=464+59.5
Offset=19.5

Top of Conduit=-3.0' (1) 2"
Ground El= 4.5'
Coverage=7.5'
Station=464+14.4
Offset=19.8

Top of Conduit=-2.6' (1) 2"
Ground El= 5.0'
Coverage=7.8'
Station=463+69.7
Offset=19.1

SINGLE PHASE
TRANSFORMER

Top of Conduit=-2.3' (1) 2"
Ground El= 5.0'
Coverage=7.3'
Station=463+24.5
Offset=18.8

Top of Conduit= -2.6' (1) 2"
Ground El= 4.9'
Coverage= 7.5'
Station=462+93.2
Offset=18.5

Top of Conduit= -1.2' (1) 2"
Ground El= 5.5'
Coverage= 6.7'
Station=462+64.8
Offset=18.5

Top of Conduit= -2.3' (1) 2"
Ground El= 4.7'
Coverage= 7.0'
Station=462+34.0
Offset=18.1

Top of Conduit= -2.6' (1) 2"
Ground El= 4.4'
Coverage= 7.0'
Station=461+88.9
Offset=18.7

Top of Conduit= -2.6' (1) 2"
Ground El= 4.7'
Coverage= 7.3'
Station=461+60.0
Offset=19.3

LOT 4 BLK J COUNTRY CLUB SHORES
UNIT 5 SEC 3
DEED: O.R.B. 0324/0324, S.C.P.R.
PID: 0009-07-0018
ADDRESS: 540 GOLF LINKS LN

LOT 5 BLK J COUNTRY CLUB SHORES
UNIT 5 SEC 3
DEED: O.R.B. 0305/0305, S.C.P.R.
PID: 0009-10-0003
ADDRESS: 530 GOLF LINKS LN

LOT 6 BLK J COUNTRY CLUB SHORES
UNIT 5 SEC 3
DEED: O.R.B. 2887/1920, S.C.P.R.
PID: 0009-10-0004
ADDRESS: 520 GOLF LINKS LN

LOT 7 BLK J COUNTRY CLUB SHORES
UNIT 5 SEC 3
DEED: O.R.B. 2864/2755, S.C.P.R.
PID: 0009-10-0005
ADDRESS: 510 GOLF LINKS LA

LOT 6 BLK H COUNTRY CLUB SHORES
UNIT 5 SEC 3
DEED: O.R.B. 0005/0005, S.C.P.R.
PID: 0009-10-0010
ADDRESS: 541 CHIPPING LN

LOT 7 BLK H COUNTRY CLUB SHORES
UNIT 5 SEC 3
DEED: O.R.B. 2780/1061, S.C.P.R.
PID: 0009-10-0009
ADDRESS: 531 CHIPPING LN

LOT 8 BLK H COUNTRY CLUB SHORES
UNIT 5 SEC 3
DEED: O.R.B. 9905/3876, S.C.P.R.
PID: 0009-10-0008
ADDRESS: 521 CHIPPING LN

LOT 9 BLK H COUNTRY CLUB SHORES
UNIT 5 SEC 3
DEED: O.R.B. 2753/1080, S.C.P.R.
PID: 0009-10-0007
ADDRESS: 511 CHIPPING LA

Top of Conduit=2.4' (2) 2"
Ground El= 6.2'
Coverage=3.8'
Station=444+97.2
Offset=-23.9

Top of Conduit=-0.2' (2) 2"
Ground El= 4.8'
Coverage= 5.0'
Station=444+67.8
Offset=-22.7

Top of Conduit=-1.3' (2) 2"
Ground El= 4.7'
Coverage= 6.0'
Station=444+38.5
Offset=-22.0

Top of Conduit=-1.9' (2) 2"
Ground El= 4.9'
Coverage= 6.8'
Station=444+09.5
Offset=-22.1

Top of Conduit= -2.9' (2) 2"
Ground El= 5.0'
Coverage= 7.9'
Station=443+65.8
Offset=-21.8

Top of Conduit= -3.5' (2) 2"
Ground El= 4.6'
Coverage= 8.1'
Station=443+35.2
Offset=-22.5

Top of Conduit= -2.7' (2) 2"
Ground El= 5.1'
Coverage= 7.8'
Station=443+05.1
Offset=-22.1

Top of Conduit= -2.3' (2) 2"
Ground El= 4.8'
Coverage= 7.1'
Station=442+43.9
Offset=-22.3

Top of Conduit= -1.2' (2) 2"
Ground El= 4.9'
Coverage= 6.1'
Station=441+98.8
Offset=-22.4

Top of Conduit= -1.3' (2) 2"
Ground El= 5.1'
Coverage= 6.4'
Station=441+69.1
Offset=-22.4

Top of Conduit= -1.4' (2) 2"
Ground El= 5.3'
Coverage= 6.7'
Station=441+38.1
Offset=-22.0

445+00


444+00

MATCH SHEET 39

MATCH SHEET 37

TITLE: AS-BUILT SURVEY "LONGBOAT KEY UNDERGROUND" (PHASE 1 SOUTH)

LOCATION: SECTIONS 16, 21 & 22, TOWNSHIP 36 SOUTH, RANGE 17 EAST, SARASOTA COUNTY, FLORIDA

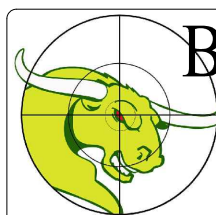

BULLSEYE SURVEYING, INC.

LB 7818
2198 NE COACHMAN ROAD, UNIT F, CLEARWATER, FL 33765
Phone: (727) 475-8088

FILE: 19-040-AS-BUILTS
PROJECT NUMBER: 19-040



Drawn By: GRM/AMW
Date: 10/26/2020

Scale: 1" = 20'

SHEET

40

OF 45

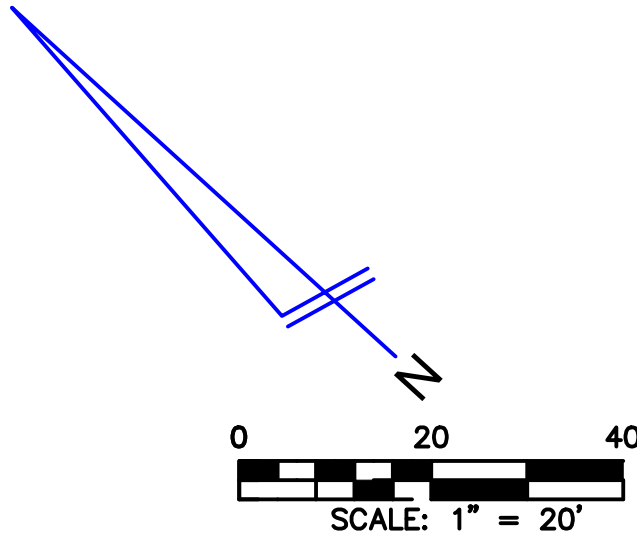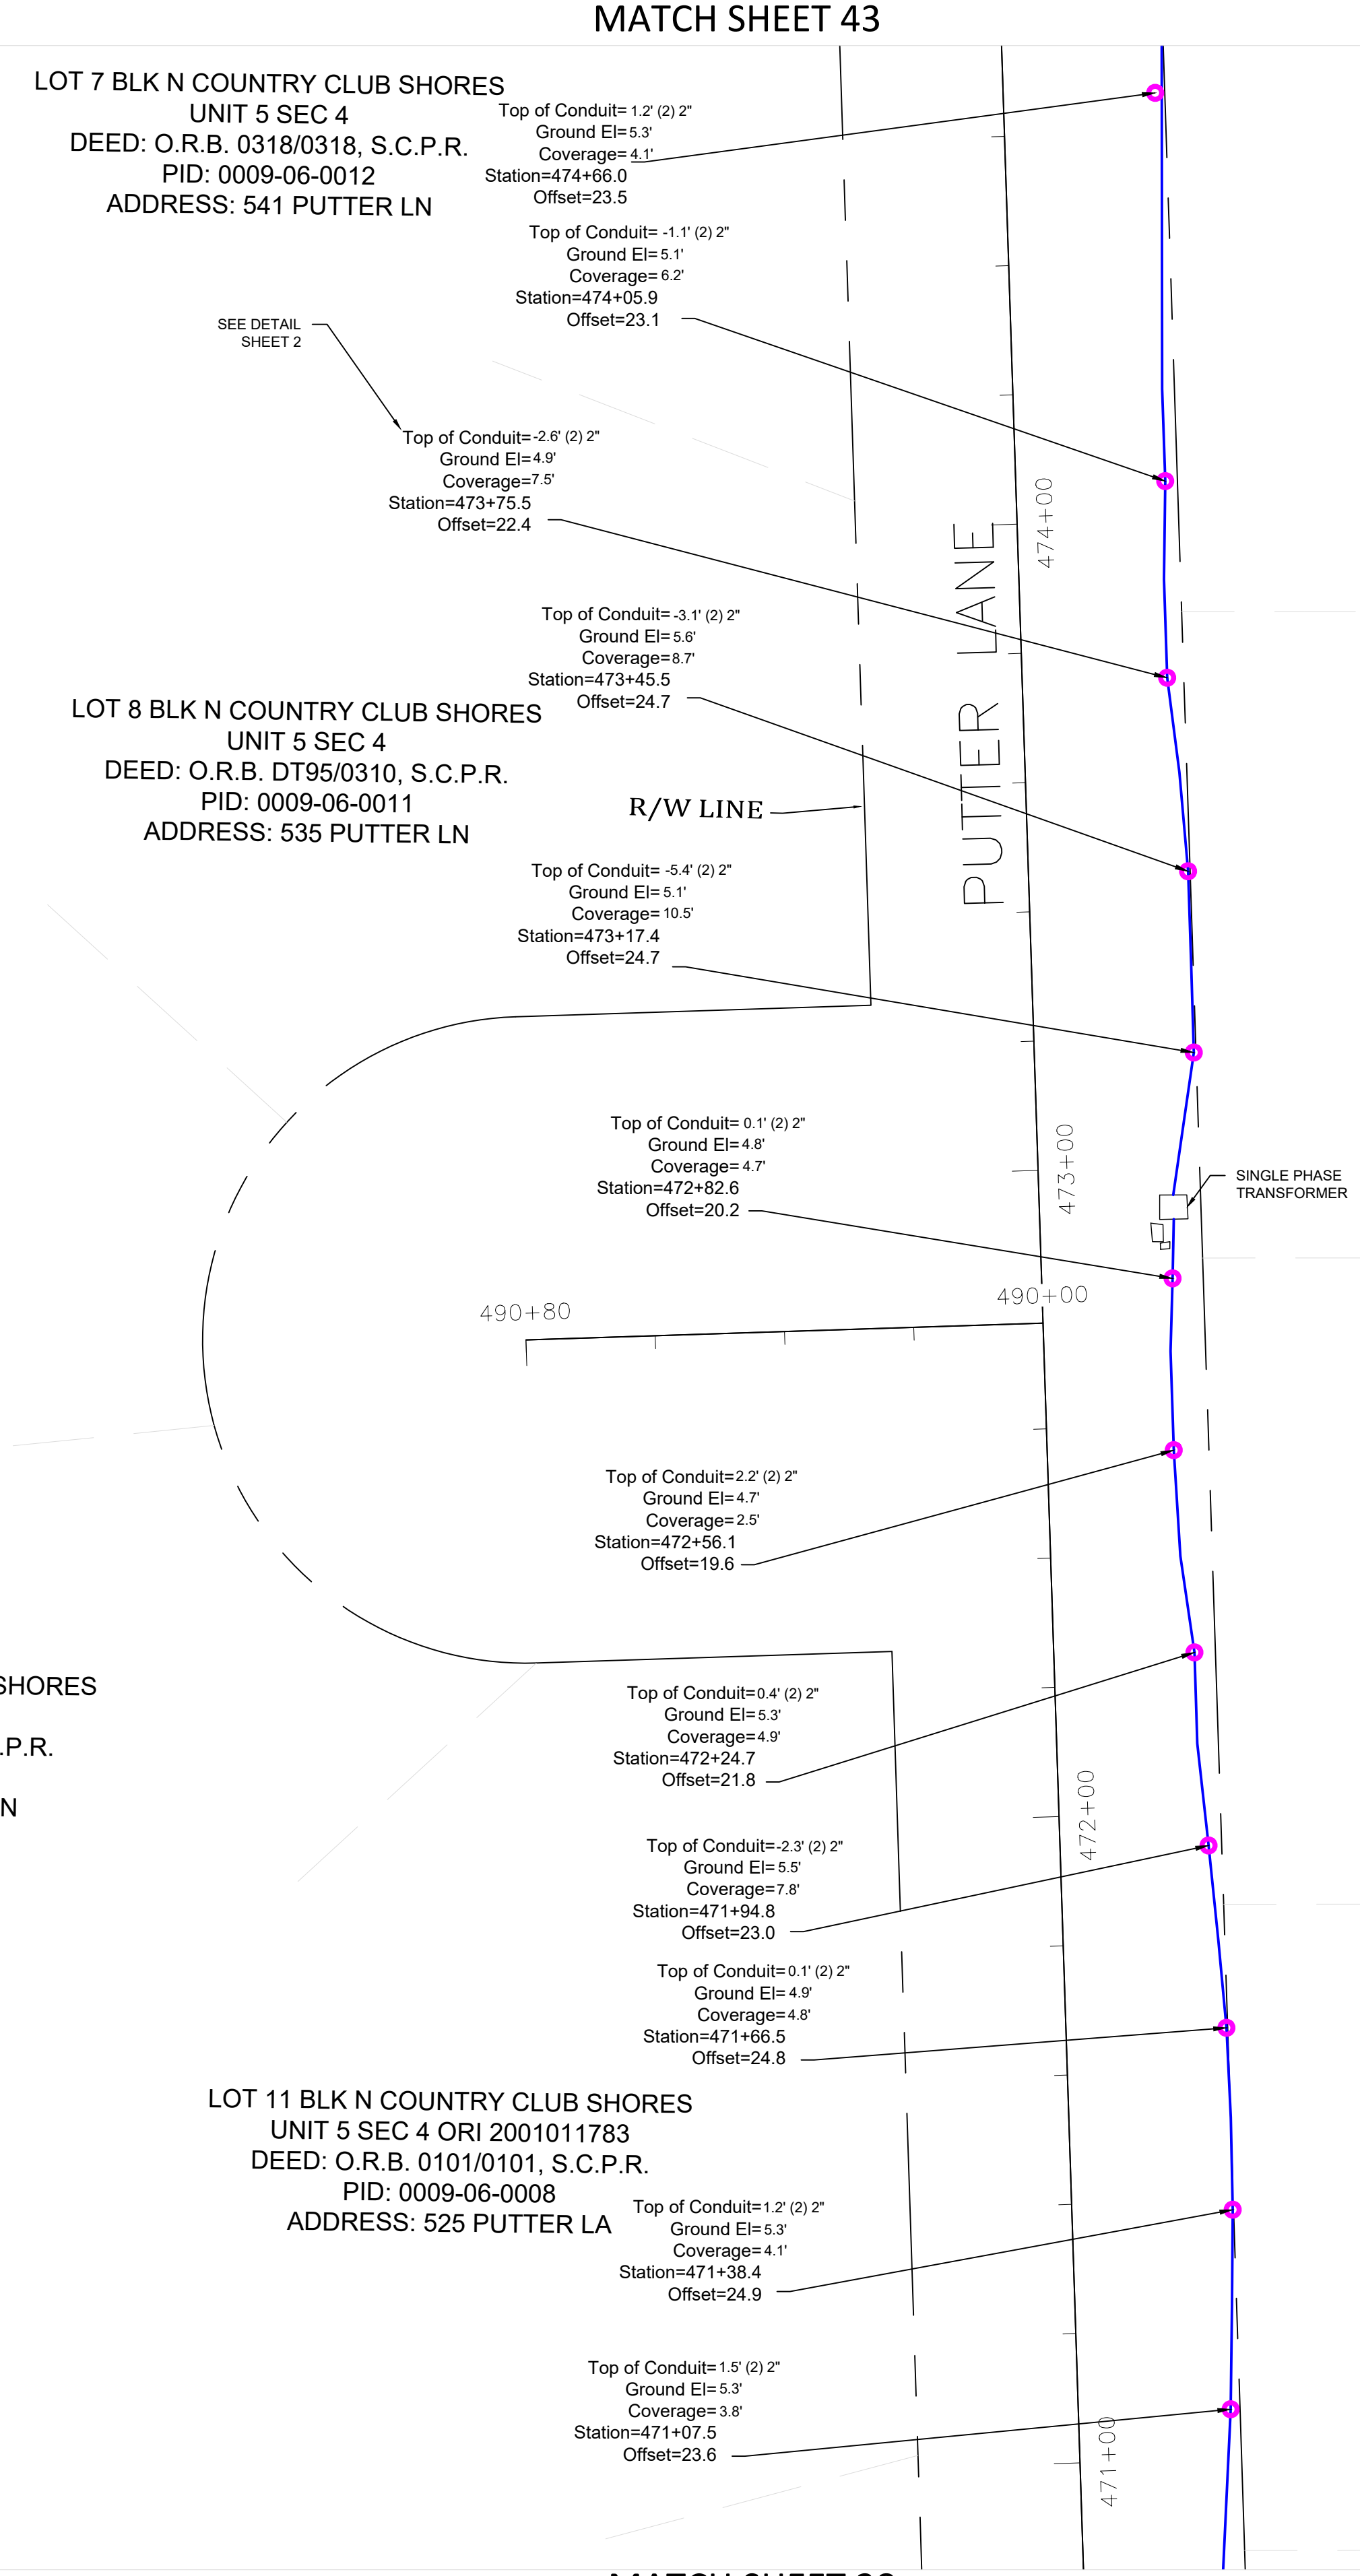

TITLE: AS-BUILT SURVEY "LONGBOAT KEY UNDERGROUND" (PHASE 1 SOUTH)

LOCATION: SECTIONS 16, 21 & 22, TOWNSHIP 36 SOUTH, RANGE 17 EAST, SARASOTA COUNTY, FLORIDA

MATCH SHEET 38




BULLSEYE SURVEYING, INC.

LB 7818
2198 NE COACHMAN ROAD, UNIT F, CLEARWATER, FL 33765
Phone: (727) 475-8088



FILE: 19-040-AS-BUILTS	Drawn By: GRM/MMW	
PROJECT NUMBER: 19-040	Date: 10/26/2020	Scale: 1" = 20'

SHEET
41
OF 41

MATCH SHEET 43

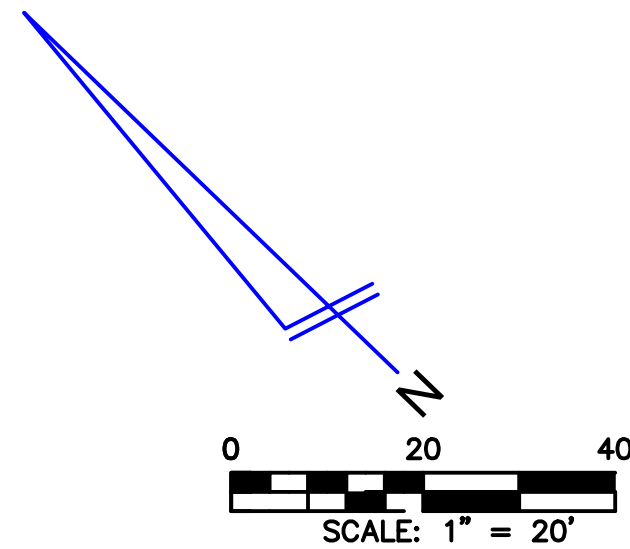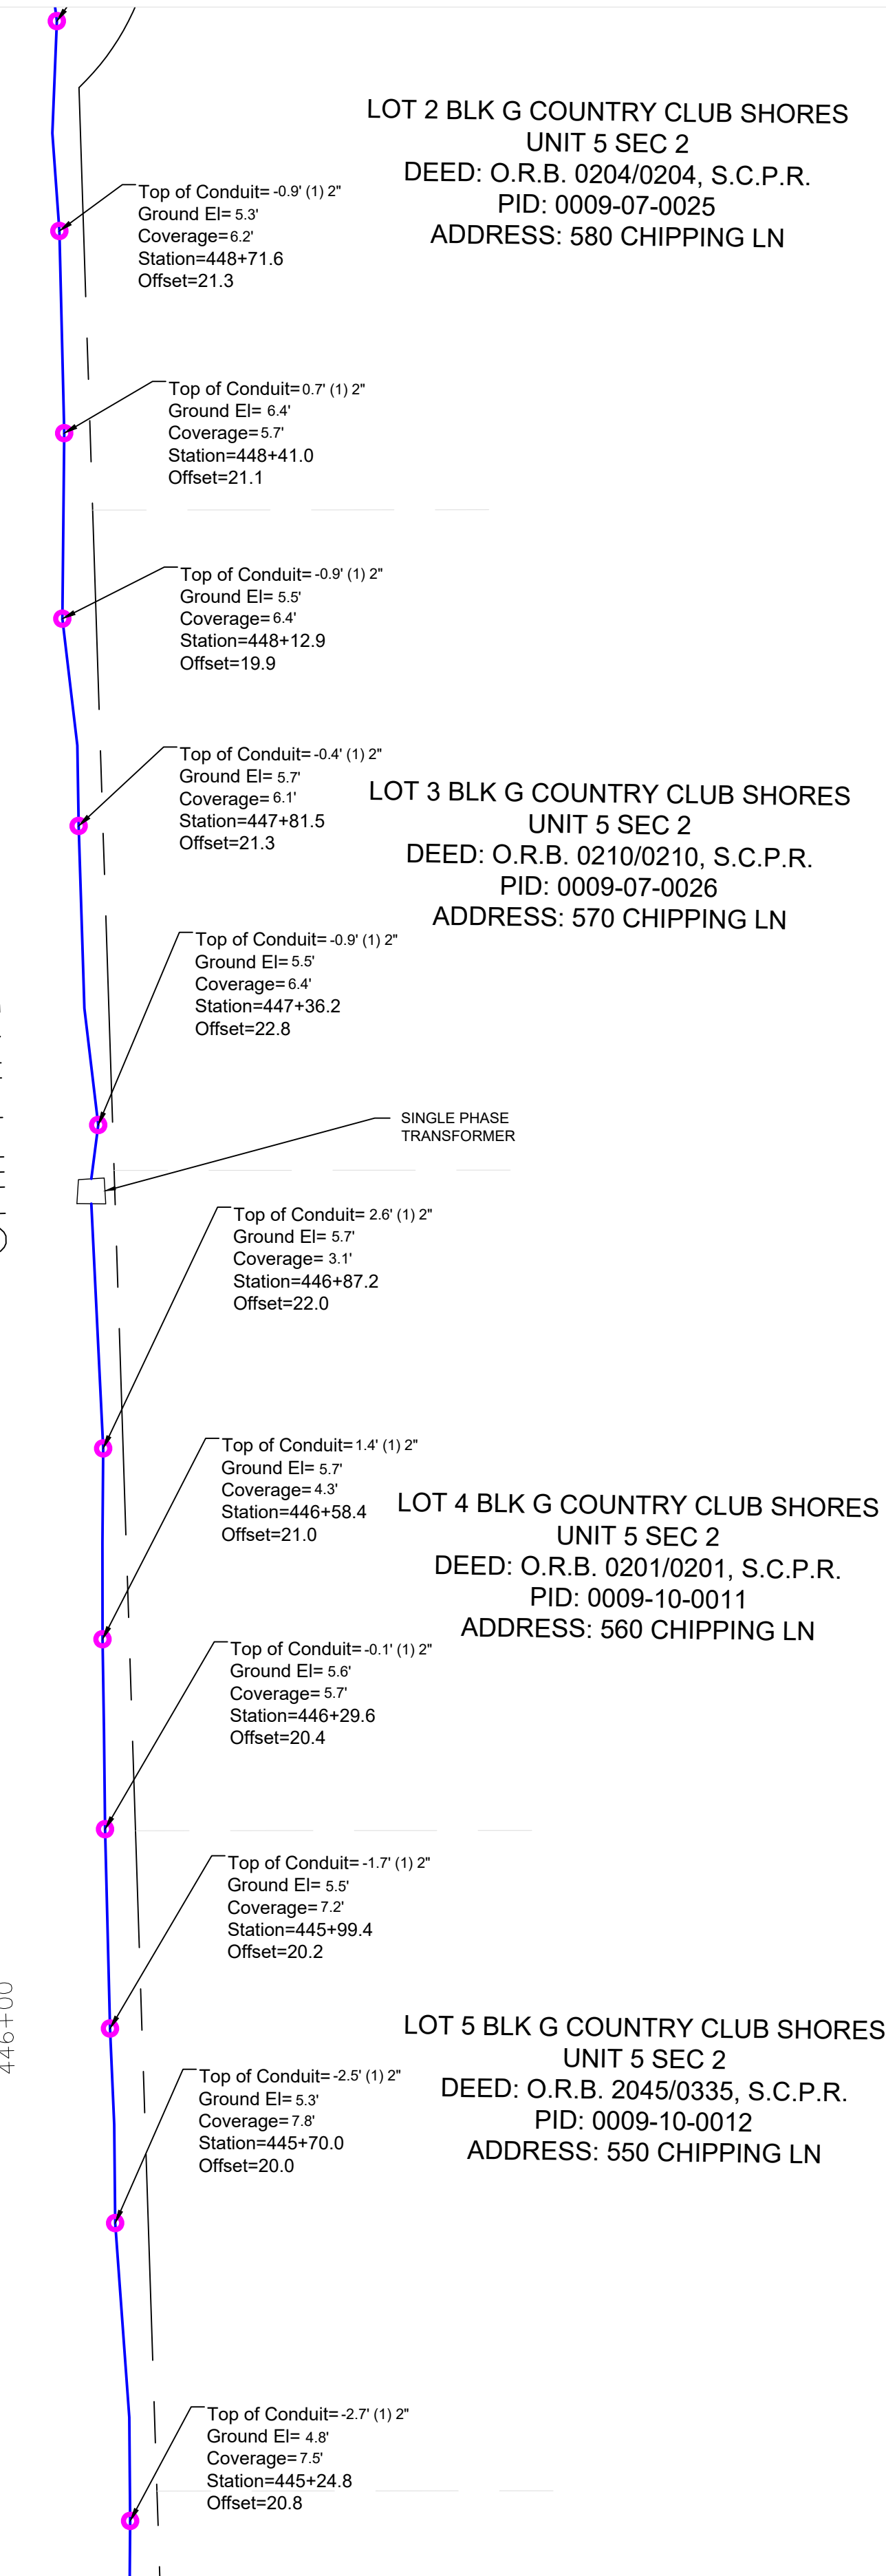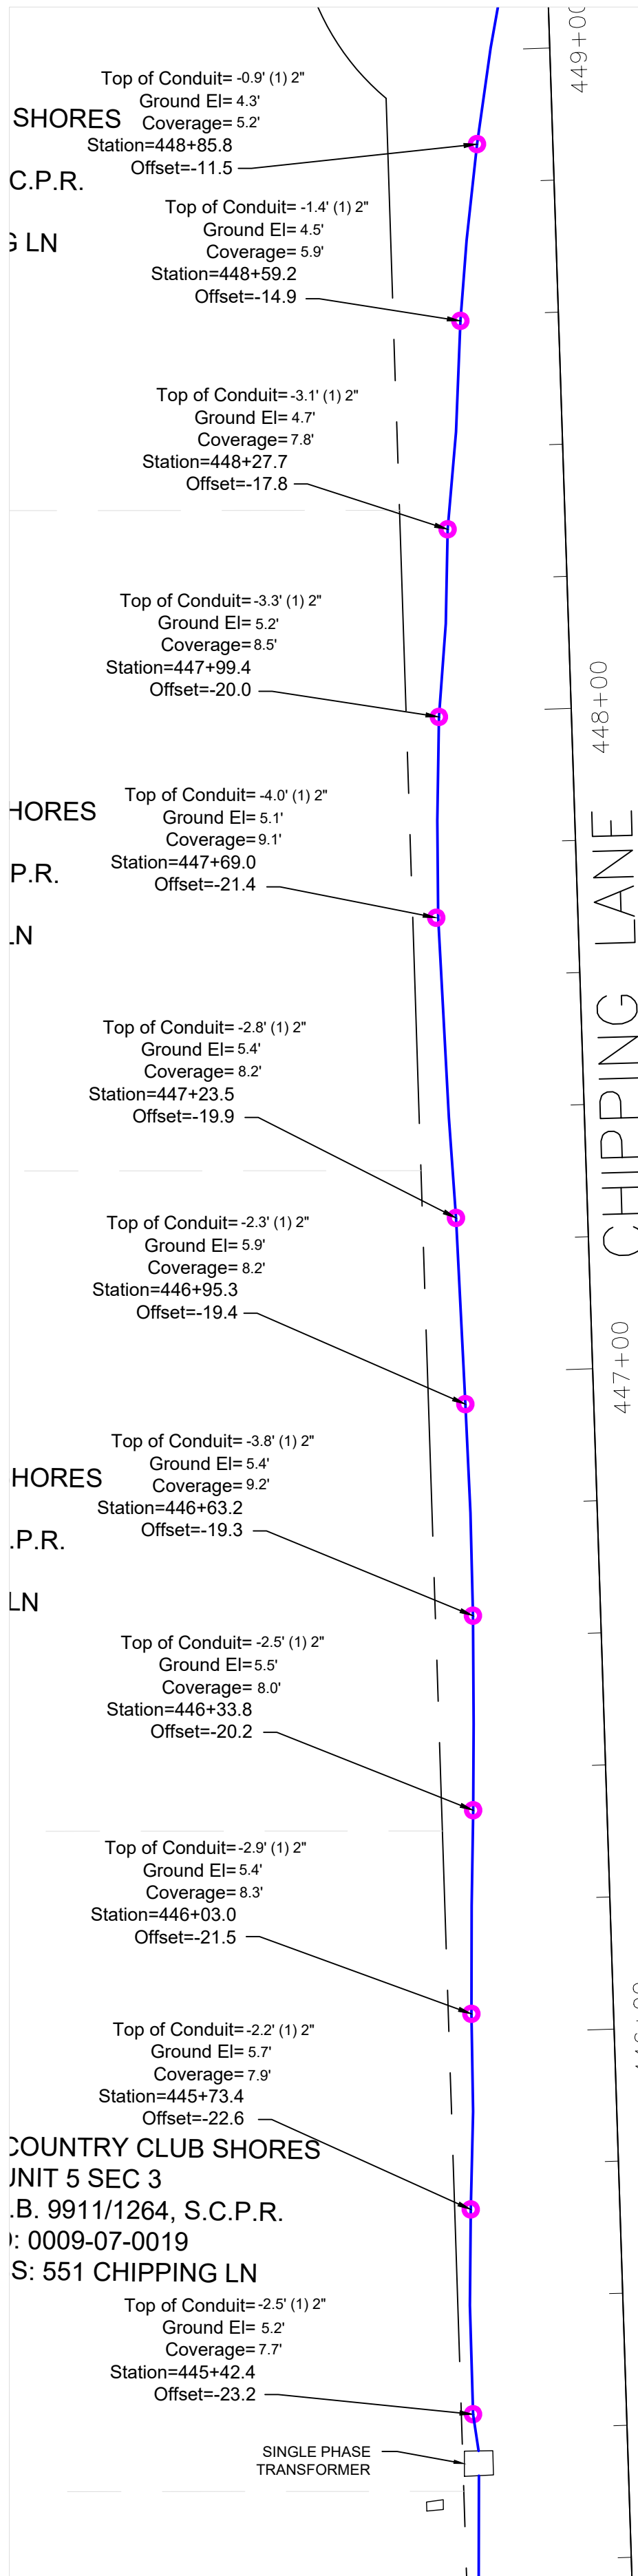

MATCH SHEET 44

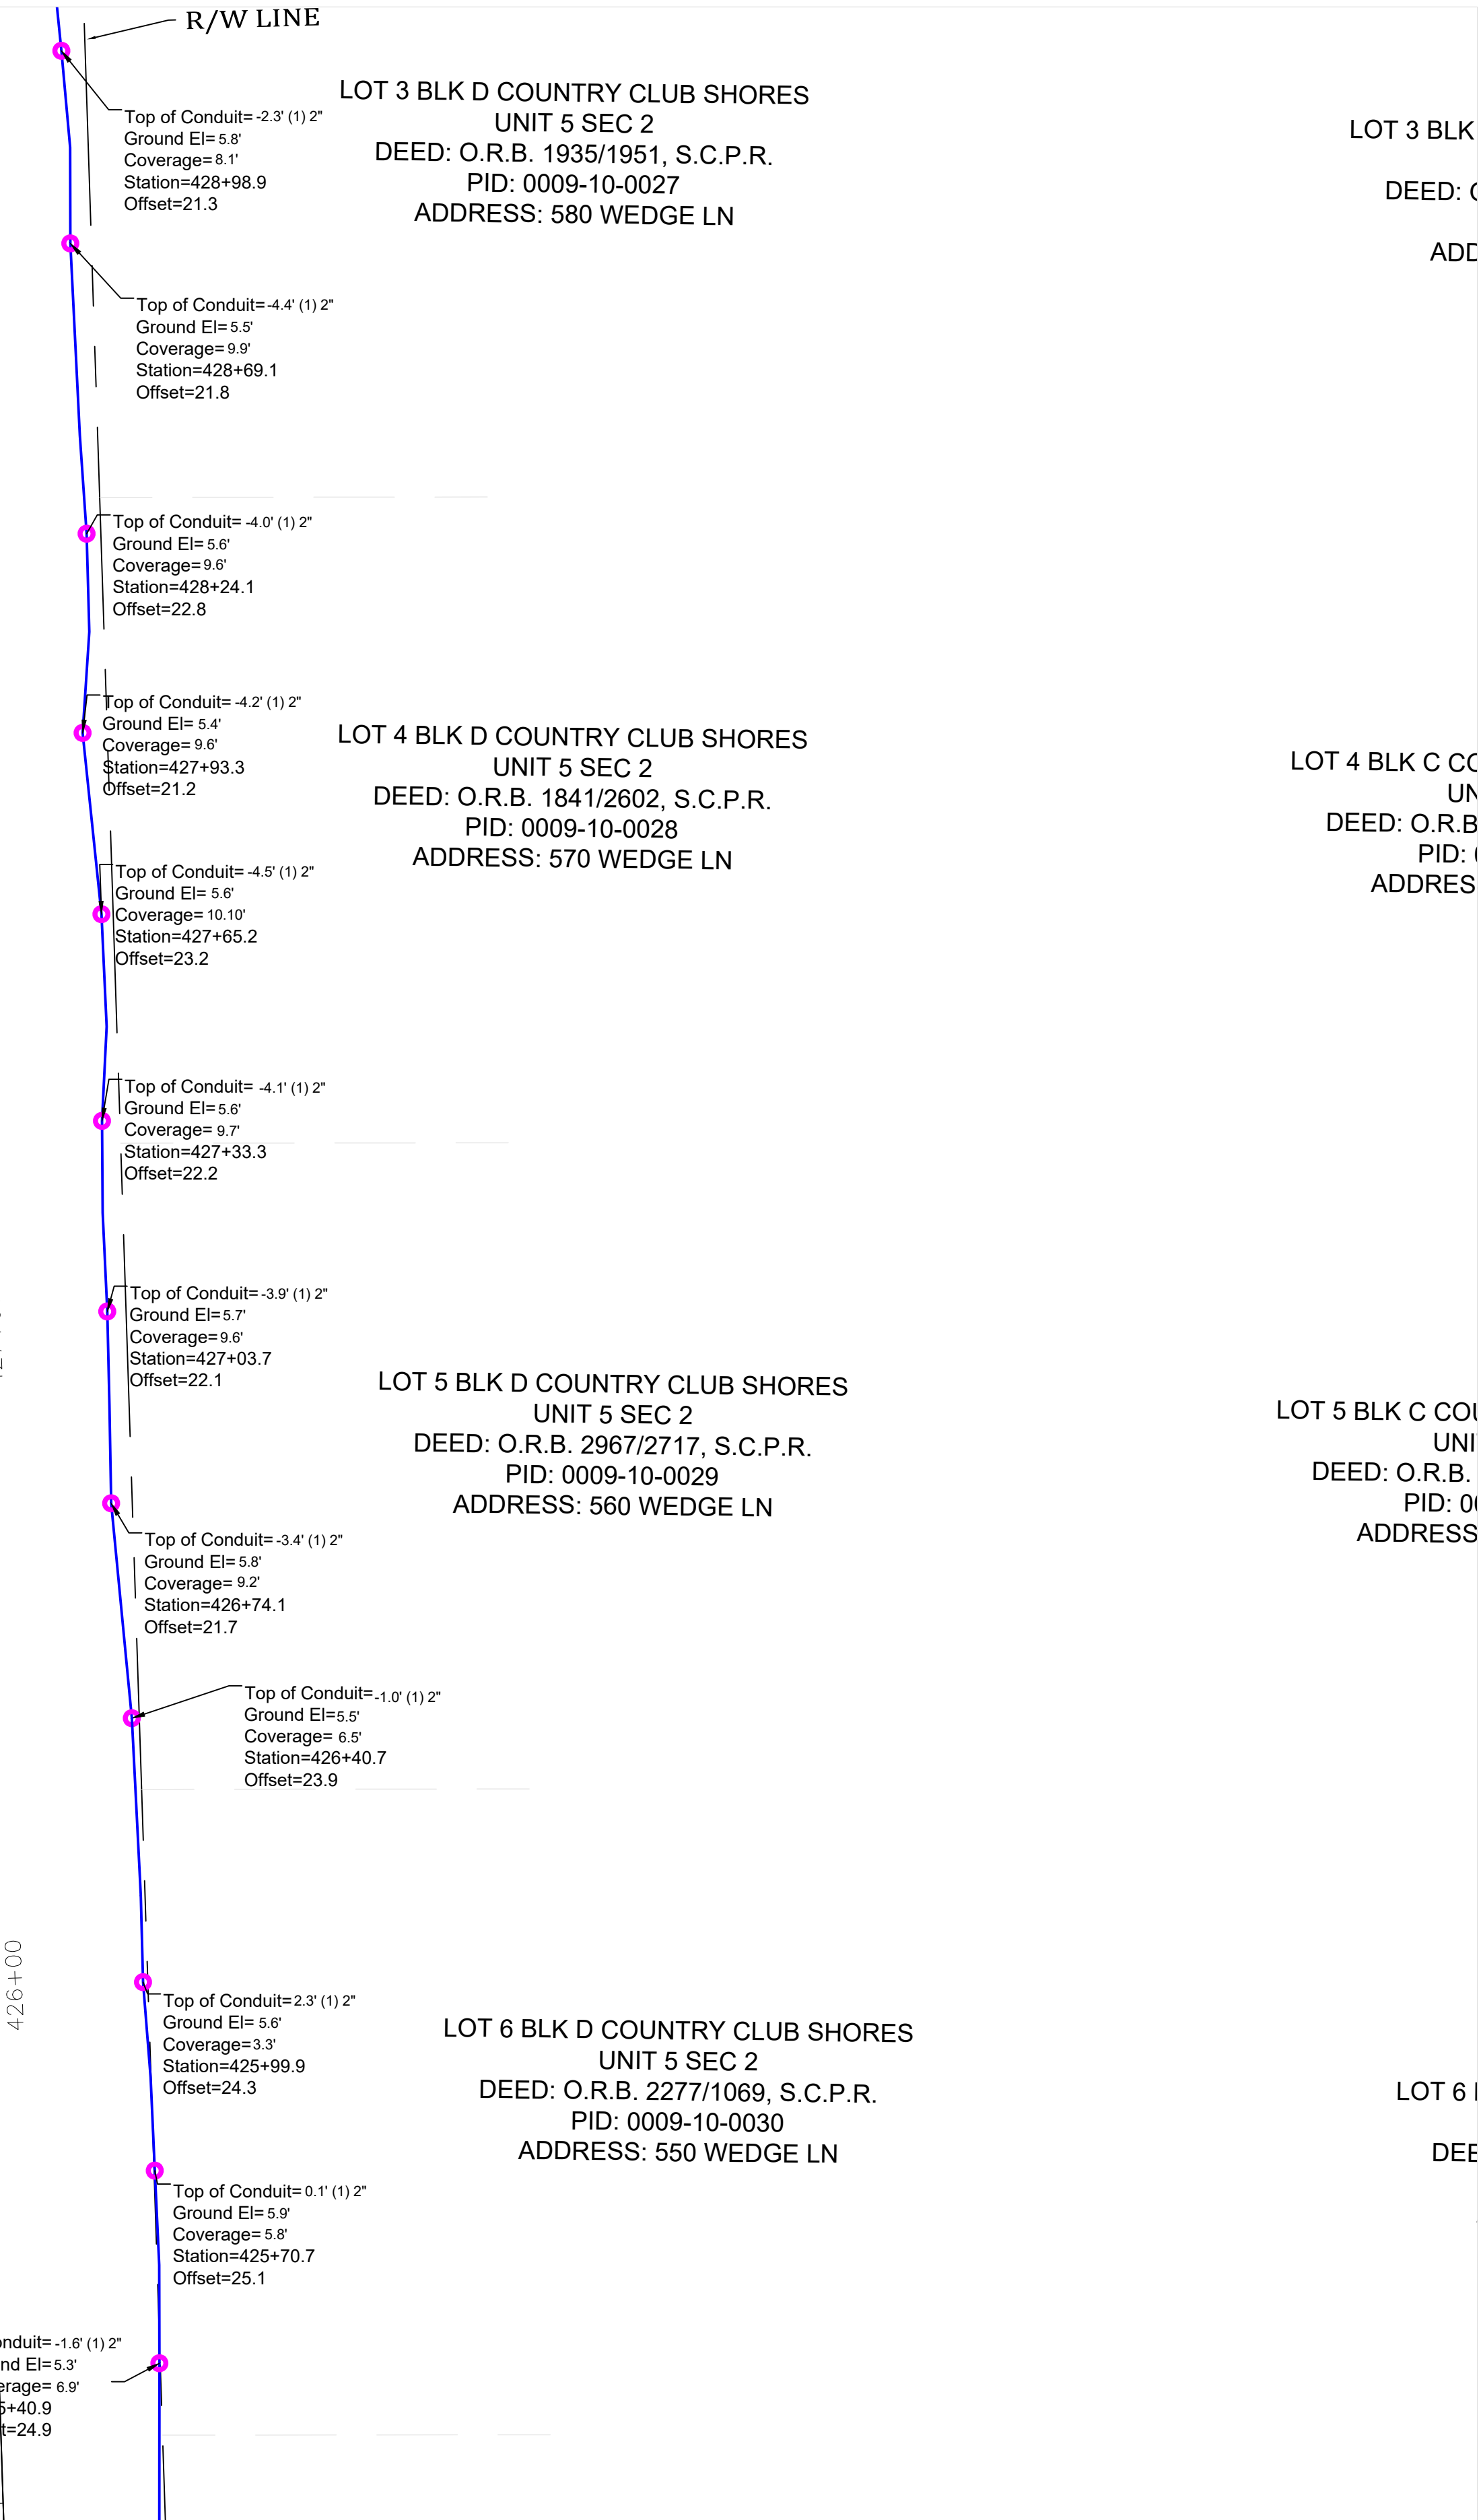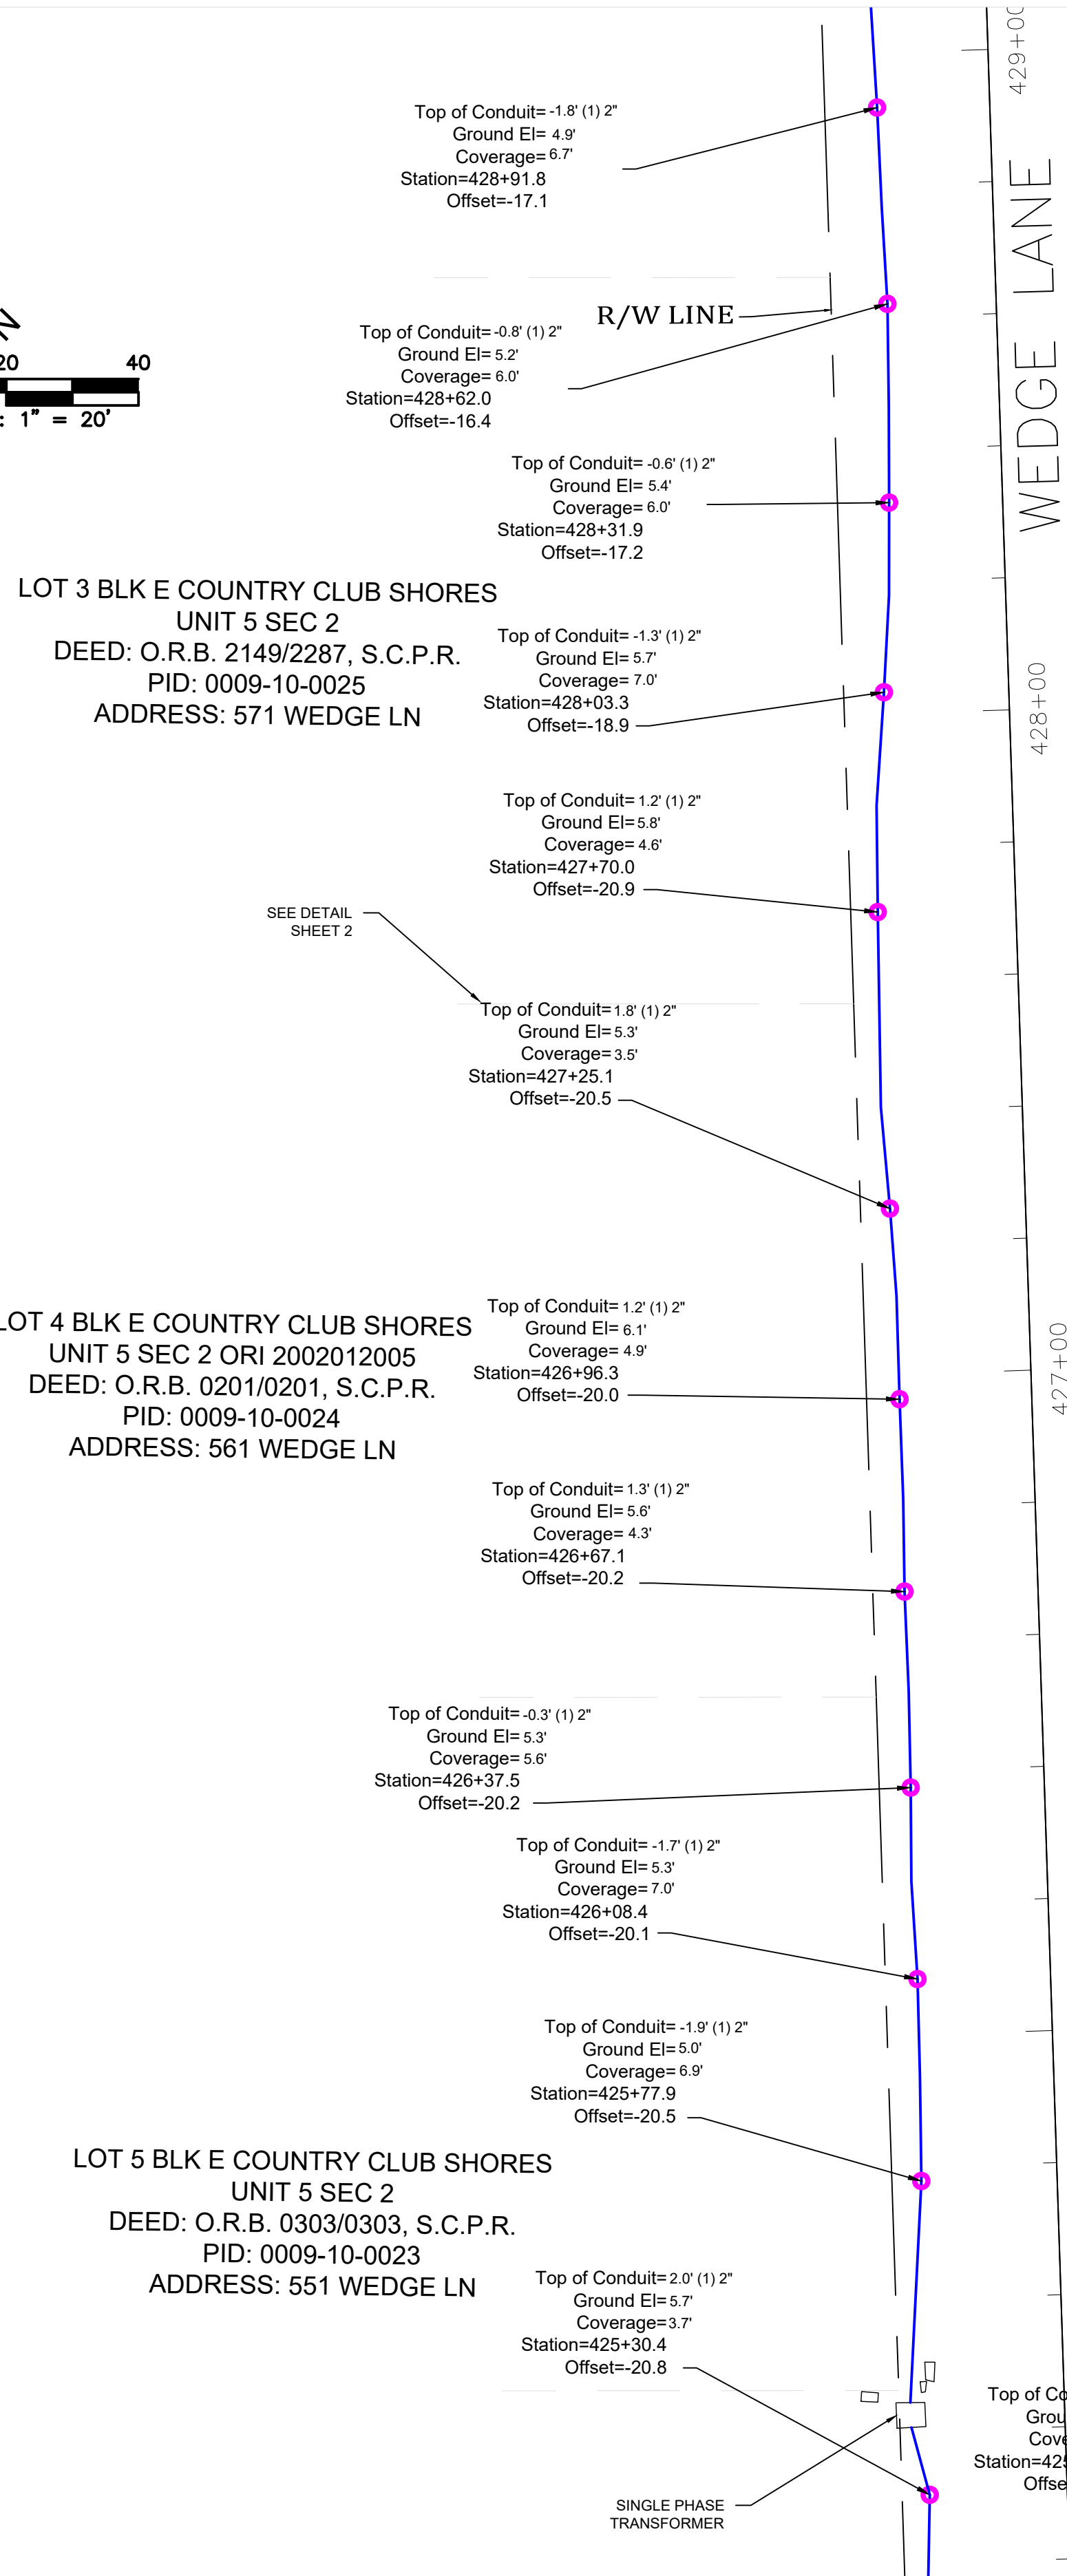

MATCH SHEET 30

MATCH SHEET 39

TITLE: AS-BUILT SURVEY "LONGBOAT KEY UNDERGROUND" (PHASE 1 SOUTH)


LOCATION: SECTIONS 16, 21 & 22, TOWNSHIP 36 SOUTH, RANGE 17 EAST, SARASOTA COUNTY, FLORIDA

BULLSEYE SURVEYING, INC.
LB 7818
2198 NE COACHMAN ROAD, UNIT F, CLEARWATER, FL 33765
Phone: (727) 475-8088

FILE: 19-040-AS-BUILTS	Drawn By: GRM/AMW	
PROJECT NUMBER: 19-040	Date: 10/26/2020	Scale: 1" = 20'

SHEET
42
OF 45

MATCH SHEET 45

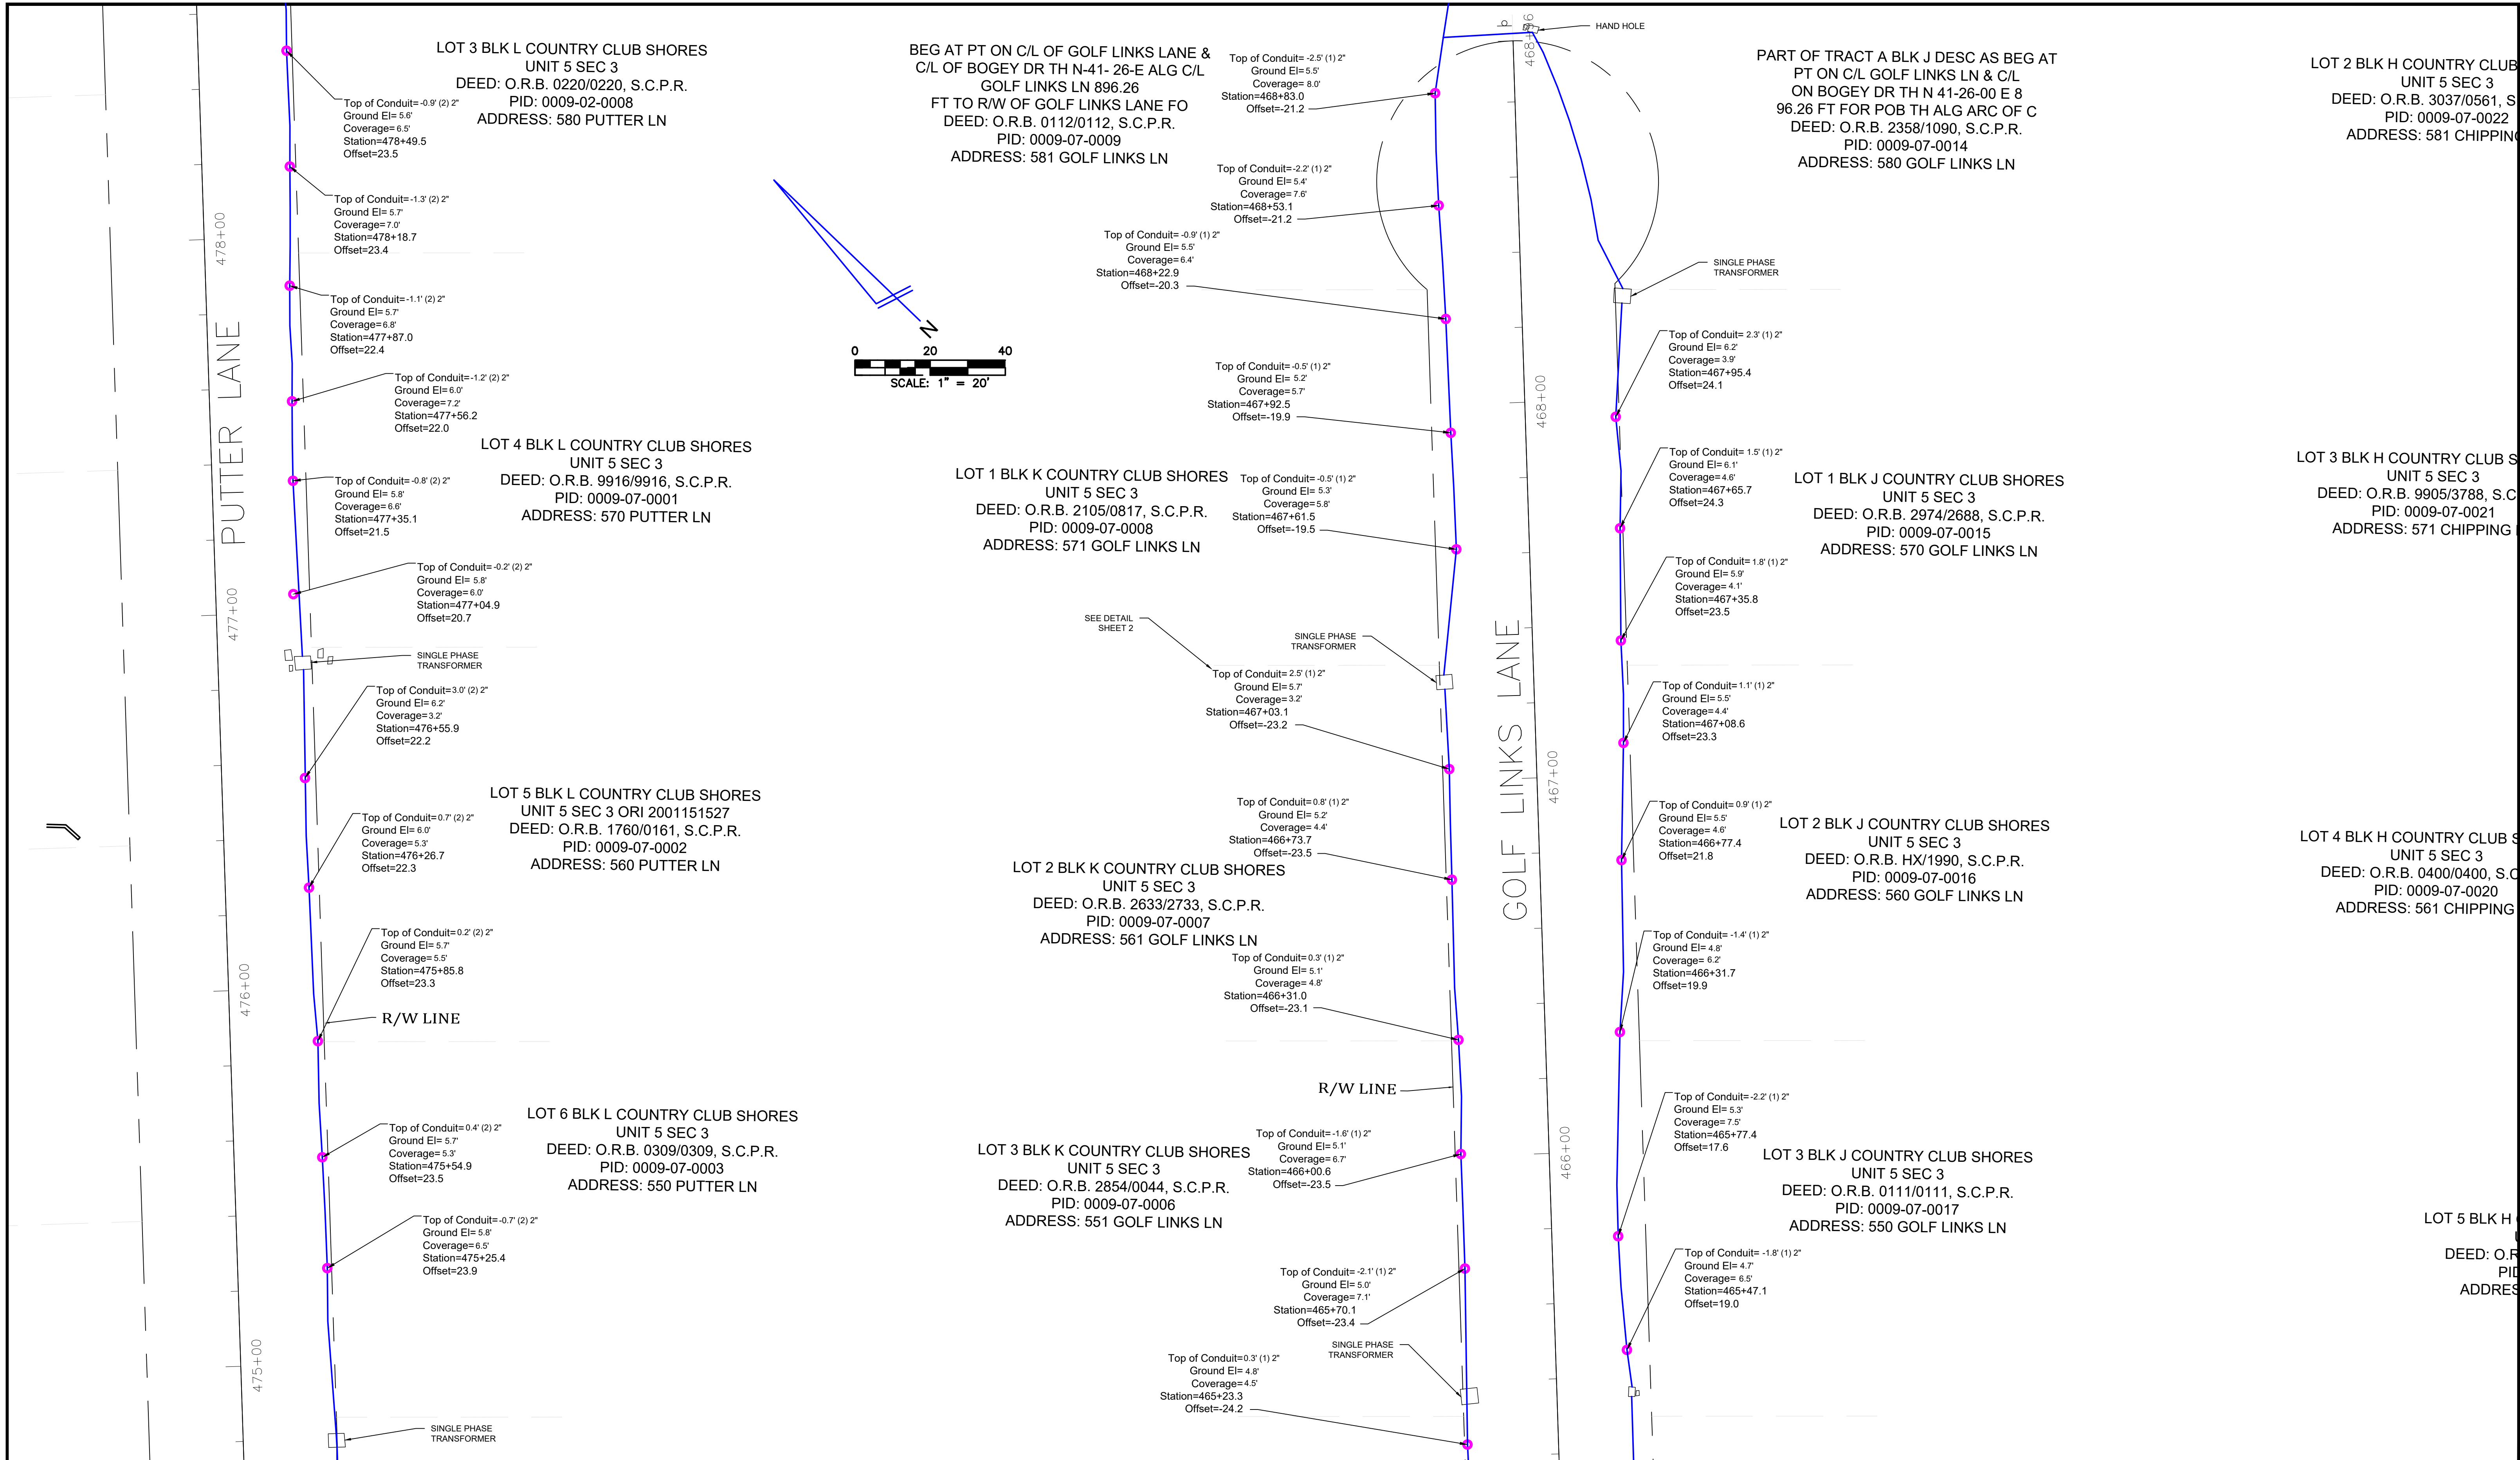

MATCH SHEET 40

TITLE: AS-BUILT SURVEY "LONGBOAT KEY UNDERGROUND" (PHASE 1 SOUTH)

LOCATION: SECTIONS 16, 21 & 22, TOWNSHIP 36 SOUTH, RANGE 17 EAST, SARASOTA COUNTY, FLORIDA

BULLSEYE SURVEYING, INC.
LB 7818
2198 NE COACHMAN ROAD, UNIT F, CLEARWATER, FL 33765
Phone: (727) 475-8088

FILE: 19-040-AS-BUILTS
PROJECT NUMBER: 19-040

Drawn By: GRM/MMW
Date: 10/26/2020


Scale: 1" = 20'

SHEET
43
OF 45


MATCH SHEET 45

LOT 1 BLK H COUNTRY CLUB SHORES
UNIT 5 SEC 3
DEED: O.R.B. 2393/2158, S.C.P.R.
PID: 0009-07-0023
ADDRESS: 591 CHIPPING LN

LOT 1 BLK G COUNTRY CLUB SHORES
UNIT 5 SEC 2
DEED: O.R.B. 0309/0309, S.C.P.R.
PID: 0009-07-0024
ADDRESS: 590 CHIPPING LN

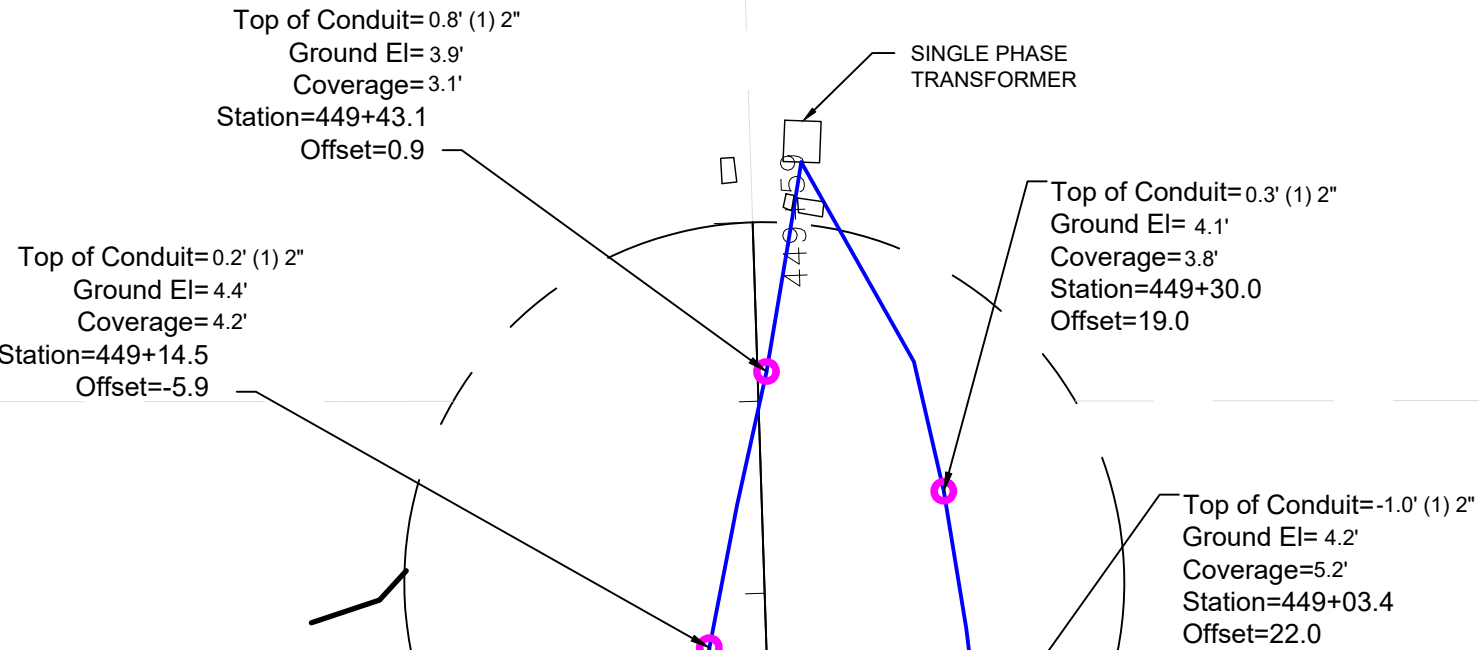


LOT 1 BLK E COUNTRY CLUB SHORES
UNIT 5 SEC 2
DEED: O.R.B. 2647/2875, S.C.P.R.
PID: 0009-07-0028
ADDRESS: 591 WEDGE LN

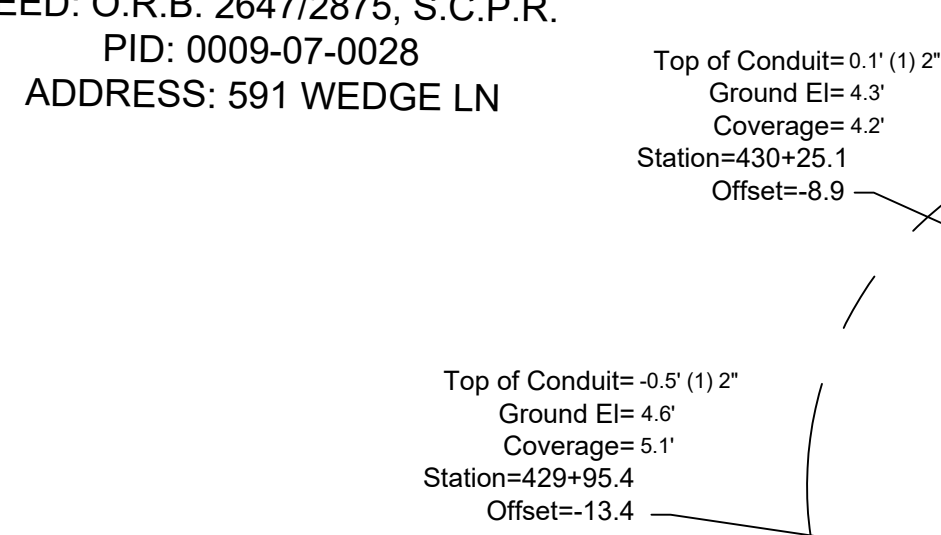


LOT 2 BLK E COUNTRY CLUB SHORES
UNIT 5 SEC 2
DEED: O.R.B. 0220/0220, S.C.P.R.
PID: 0009-07-0027
ADDRESS: 581 WEDGE LN

LOT 1 BLK D COUNTRY CLUB SHORES
UNIT 5 SEC 2
DEED: O.R.B. 2655/2239, S.C.P.R.
PID: 0009-07-0029
ADDRESS: 600 WEDGE LN

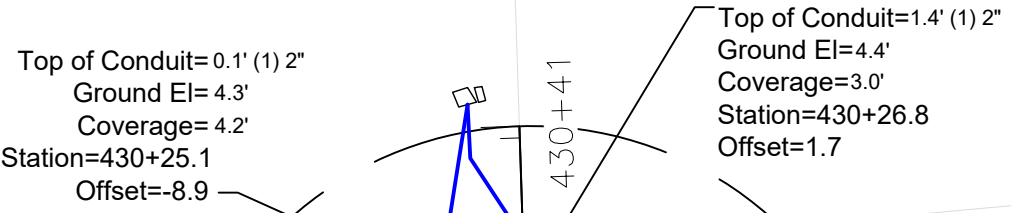

LOT 2 BLK D COUNTRY CLUB SHORES
UNIT 5 SEC 2
DEED: O.R.B. 0215/0215, S.C.P.R.
PID: 0009-10-0026
ADDRESS: 590 WEDGE LN

LOT 2 BLK C COUN
UNIT
DEED: O.R.B. 00
PID: 000
ADDRESS: 5

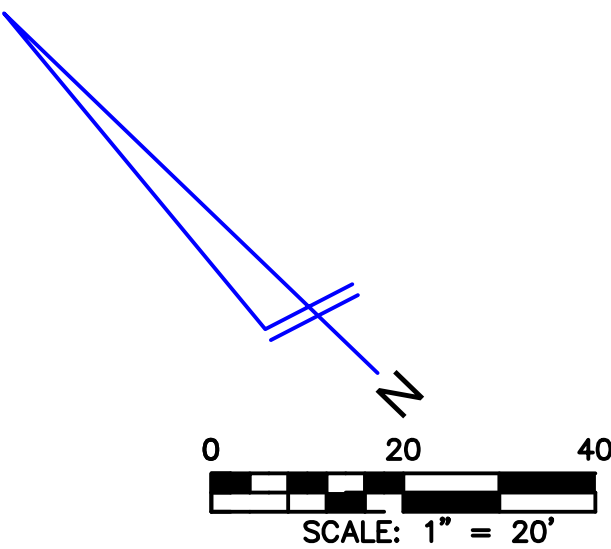


MATCH SHEET 34

MATCH SHEET 42

TITLE: AS-BUILT SURVEY "LONGBOAT KEY UNDERGROUND" (PHASE 1 SOUTH)


LOCATION: SECTIONS 16, 21 & 22, TOWNSHIP 36 SOUTH, RANGE 17 EAST, SARASOTA COUNTY, FLORIDA

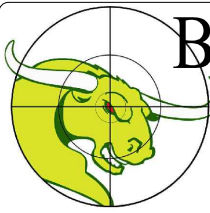

BULLSEYE SURVEYING, INC.
LB 7818
2198 NE COACHMAN ROAD, UNIT F, CLEARWATER, FL 33765
Phone: (727) 475-8088

FILE: 19-040-AS-BUILTS	Drawn By: GRM/AMW	
PROJECT NUMBER: 19-040	Date: 10/26/2020	Scale: 1" = 20'


SHEET
44
OF 45

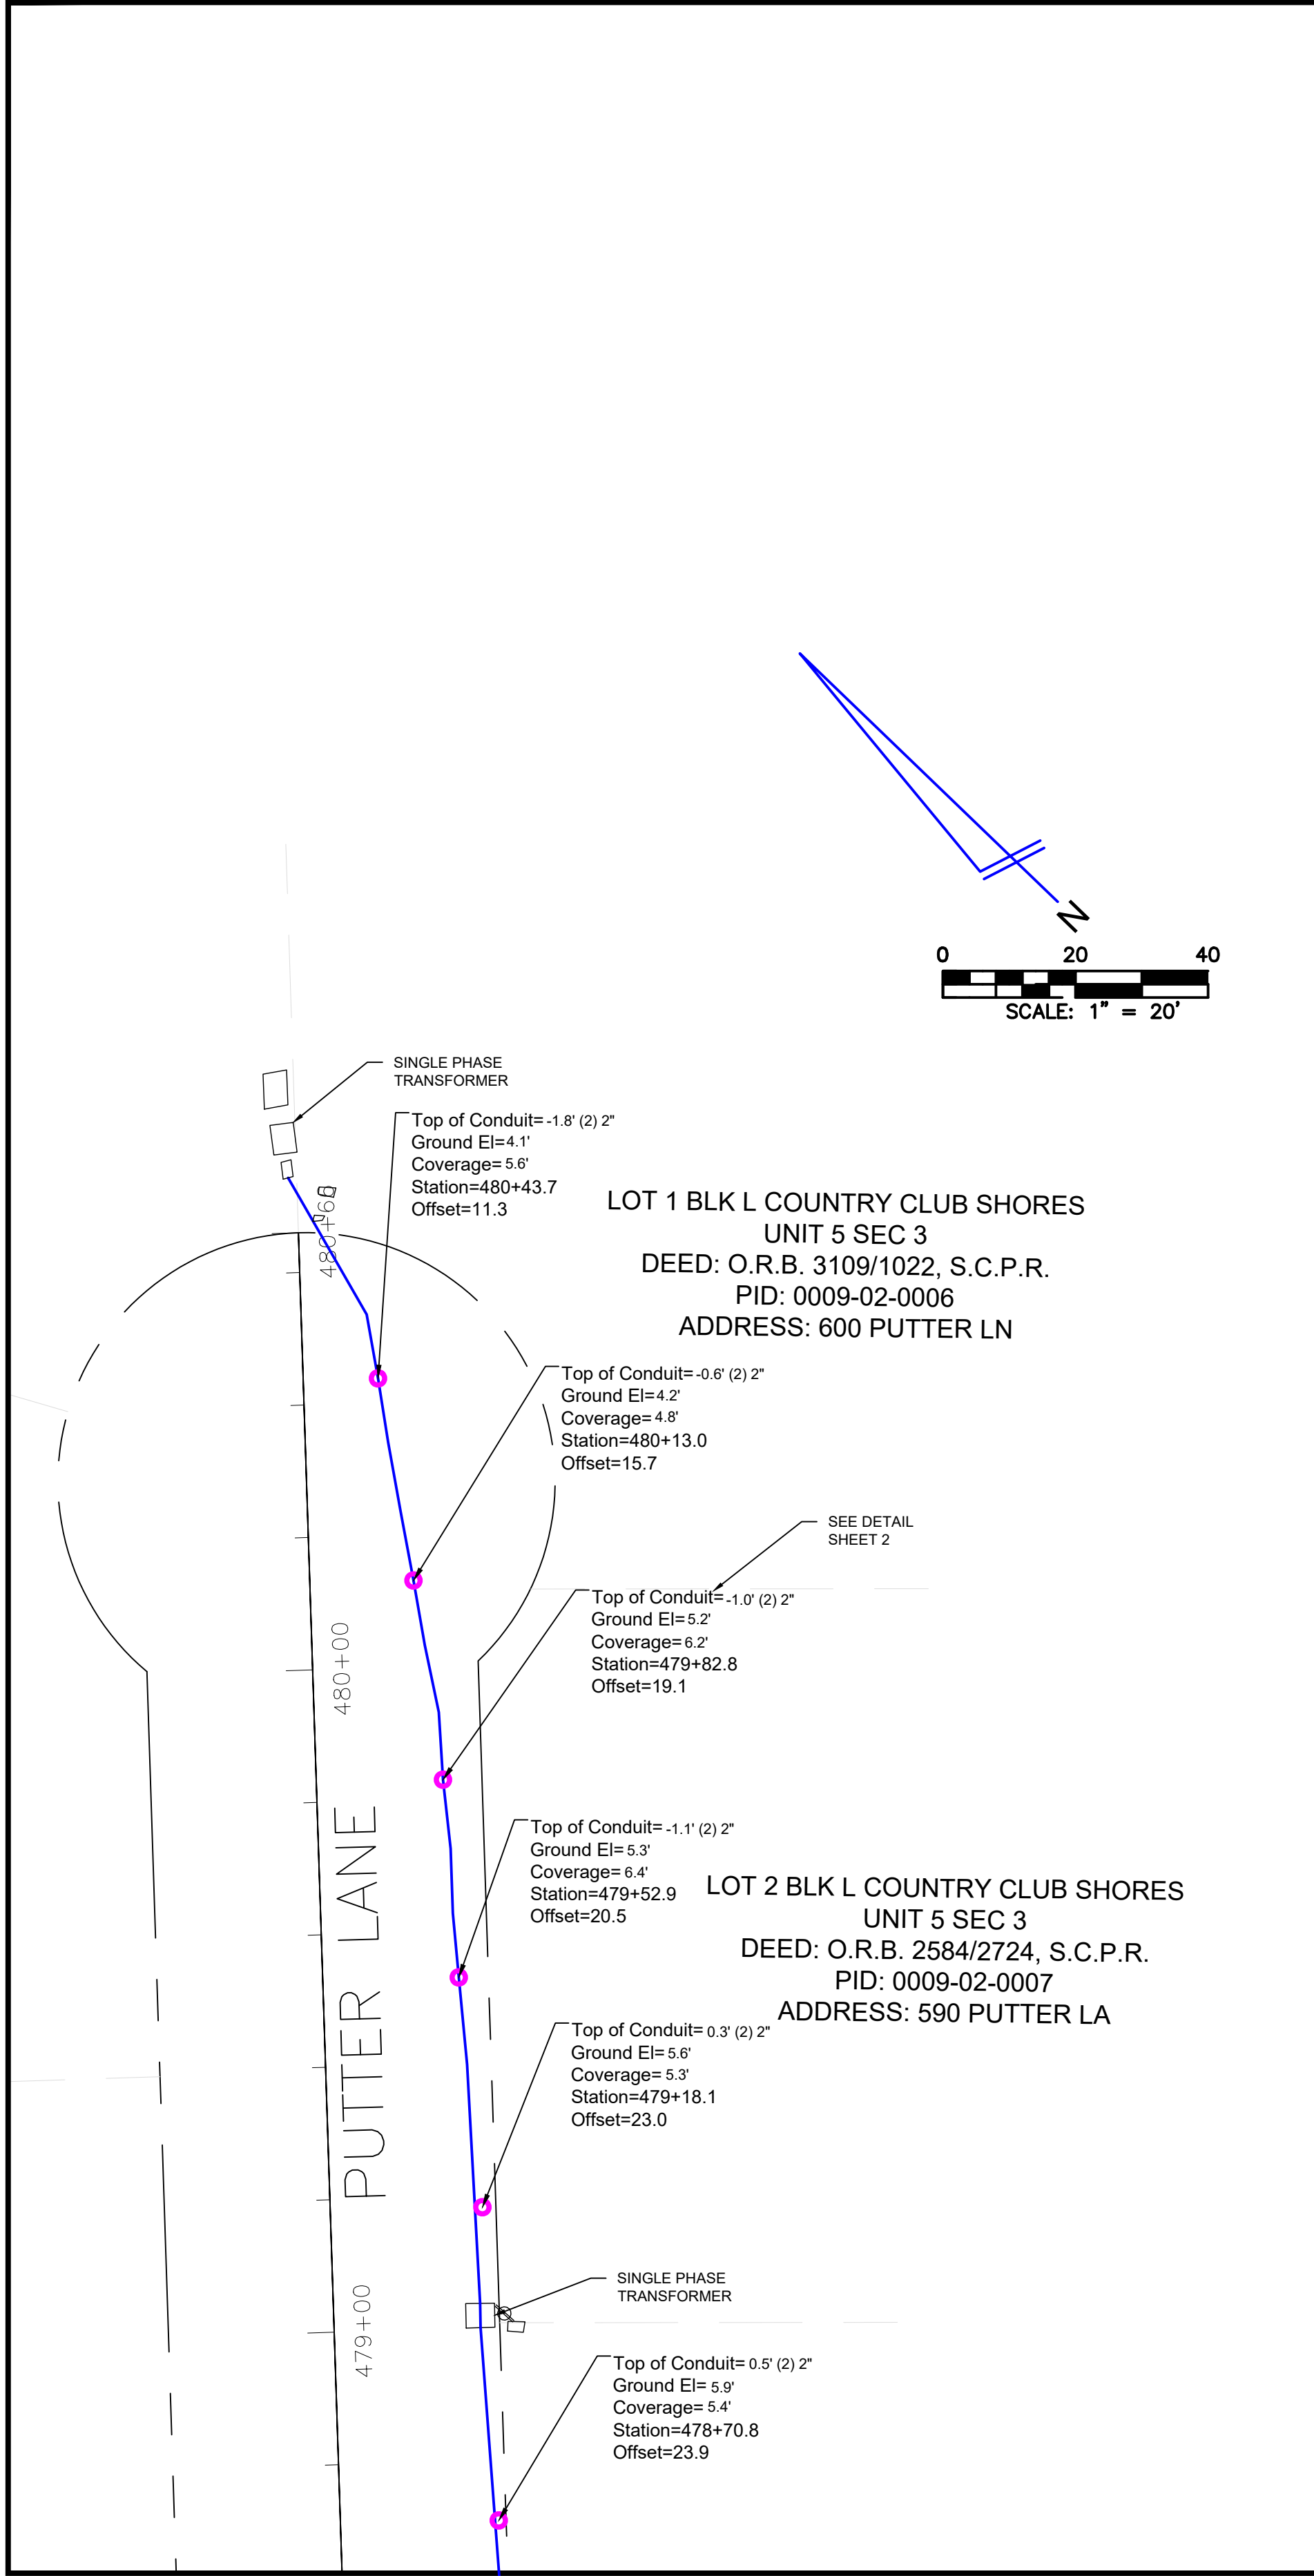

MATCH SHEET 43

TITLE: AS-BUILT SURVEY "LONGBOAT KEY UNDERGROUND" (PHASE 1 SOUTH)

LOCATION: SECTIONS 16, 21 & 22, TOWNSHIP 36 SOUTH, RANGE 17 EAST, SARASOTA COUNTY, FLORIDA

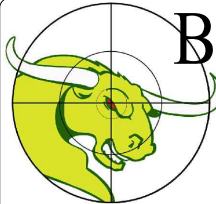

BULLSEYE SURVEYING, INC.
LB 7818
2198 NE COACHMAN ROAD, UNIT F, CLEARWATER, FL 33765
Phone: (727) 475-8088

FILE: 19-040-AS-BUILTS	Drawn By: GRM/AMW
PROJECT NUMBER: 19-040	Date: 10/26/2020 Scale: 1" = 20'