
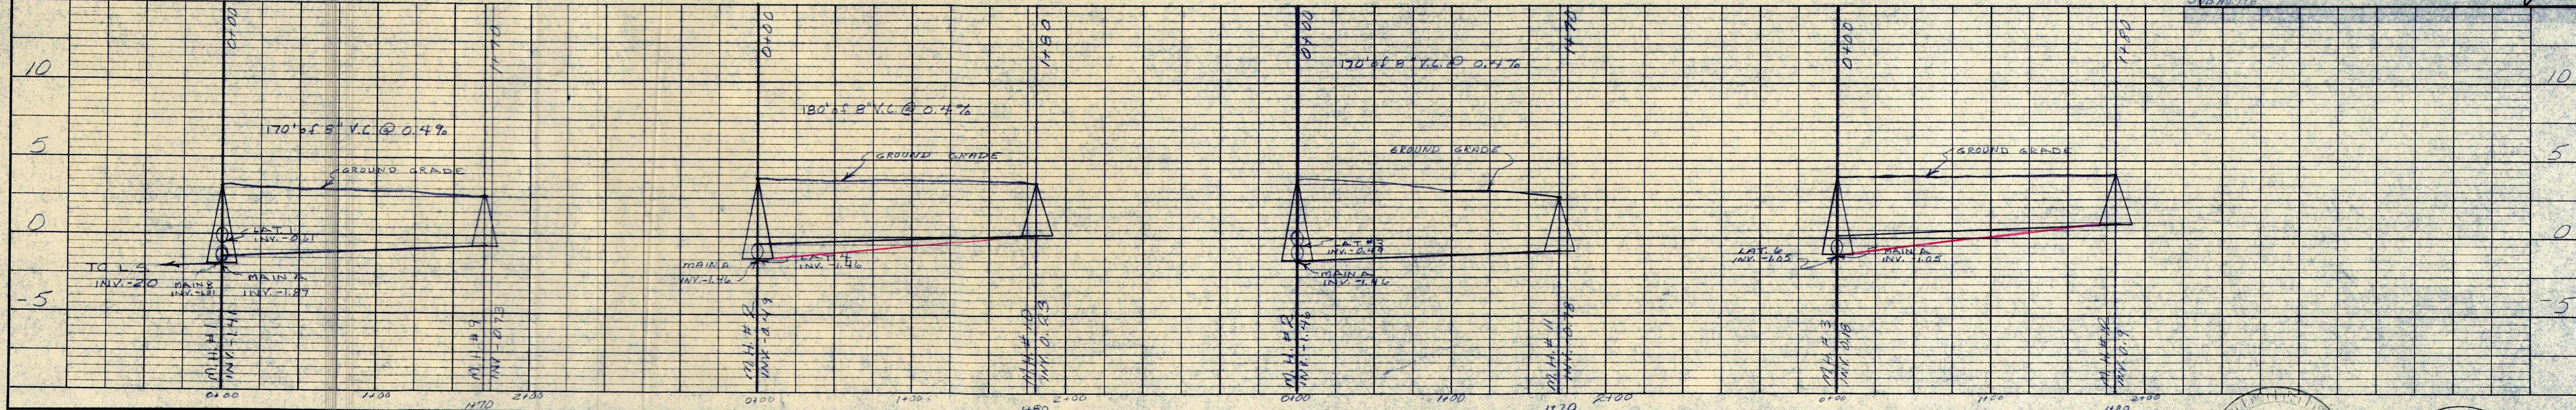
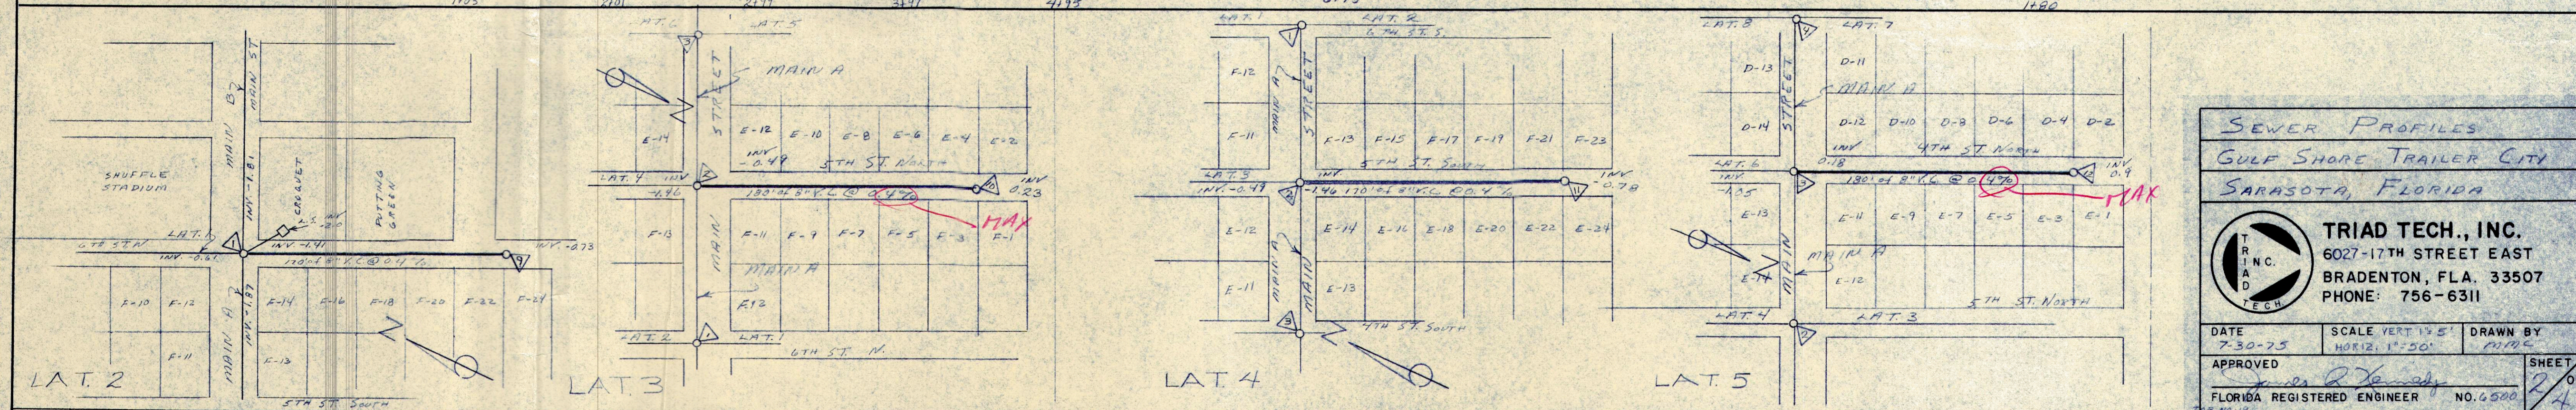
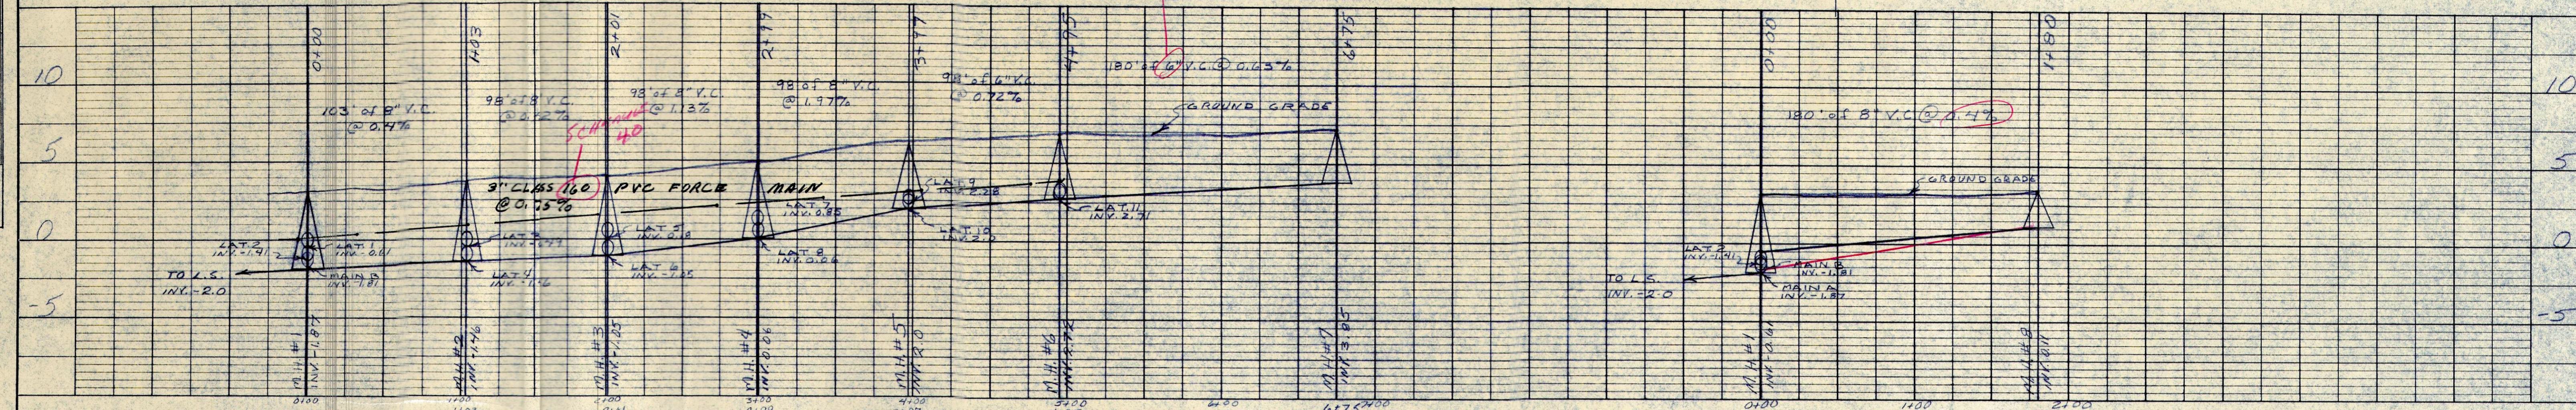


DATE: _____
 BY: _____
 SURVEYED: _____
 PLANNED: _____
 NOTE BOOK: _____
 NO. OF WAY CHECKED: _____

DATE: _____
 BY: _____
 SURVEYED: _____
 PROFILED: _____
 NOTE BOOK: _____
 NO. OF WAY CHECKED: _____

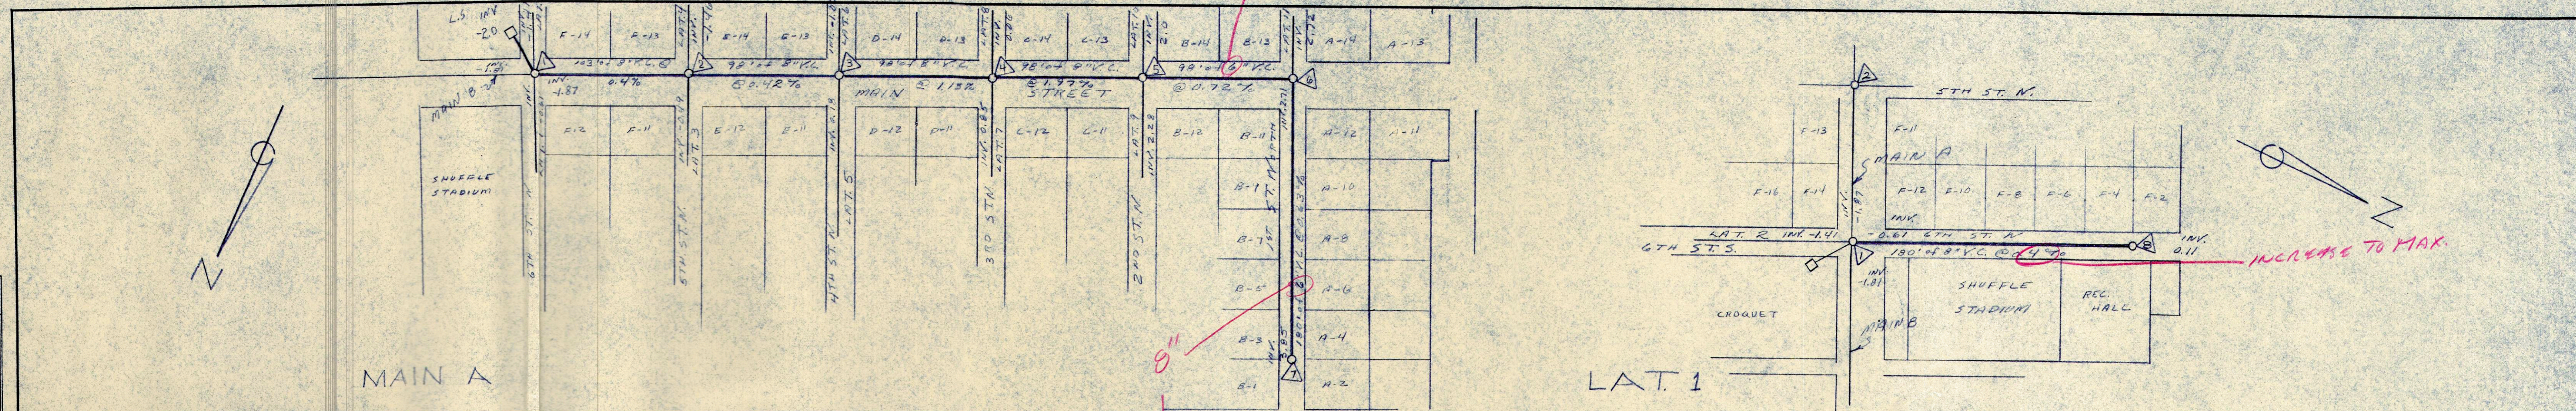

SEWER PROFILES
 GULF SHORE TRAILER CITY
 SARASOTA, FLORIDA

TRIAD TECH., INC.
 6027-17TH STREET EAST
 BRADENTON, FLA. 33507
 PHONE: 756-6311

DATE: 7-30-75 SCALE VERT. 1"=5' DRAWN BY: _____
 HORIZ. 1"=50' M.P.C.

APPROVED: _____ SHEET 24 OF _____
 FLORIDA REGISTERED ENGINEER NO. 6500

