
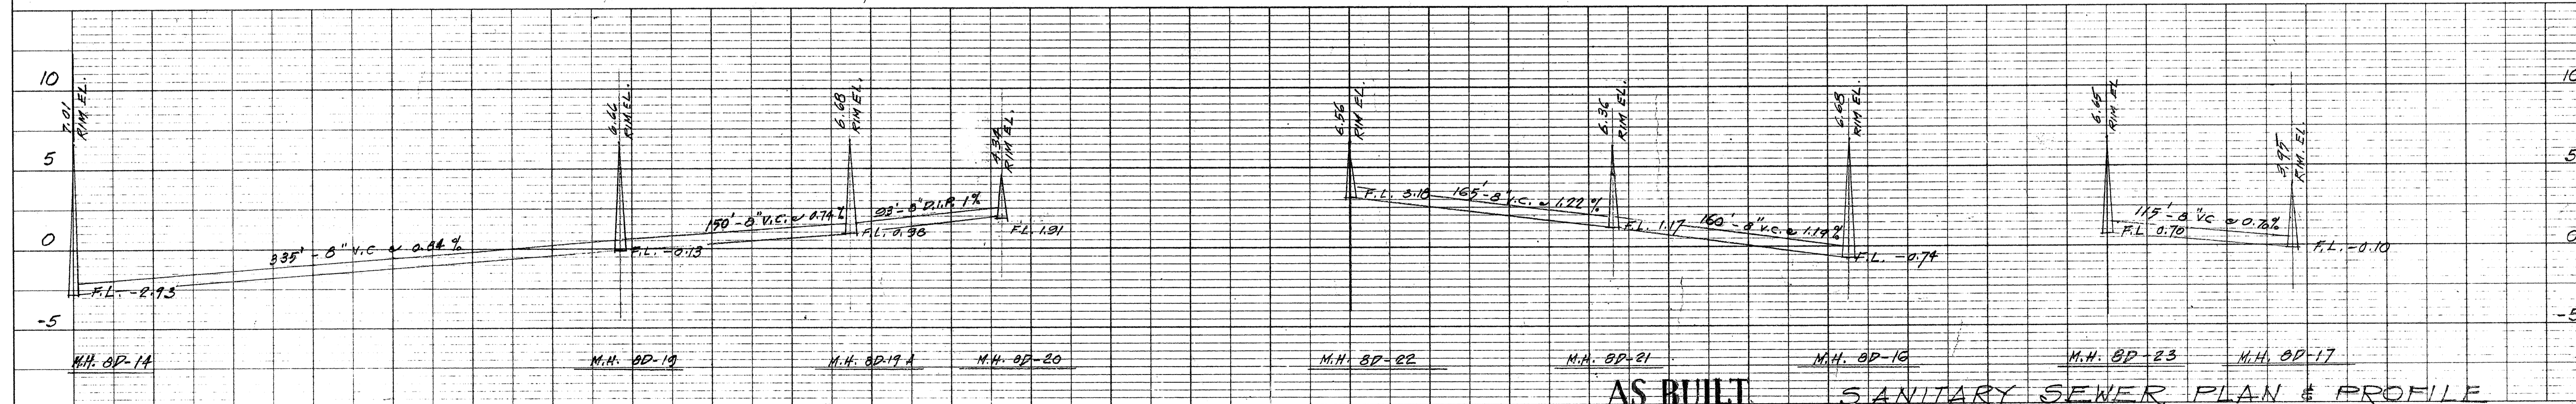
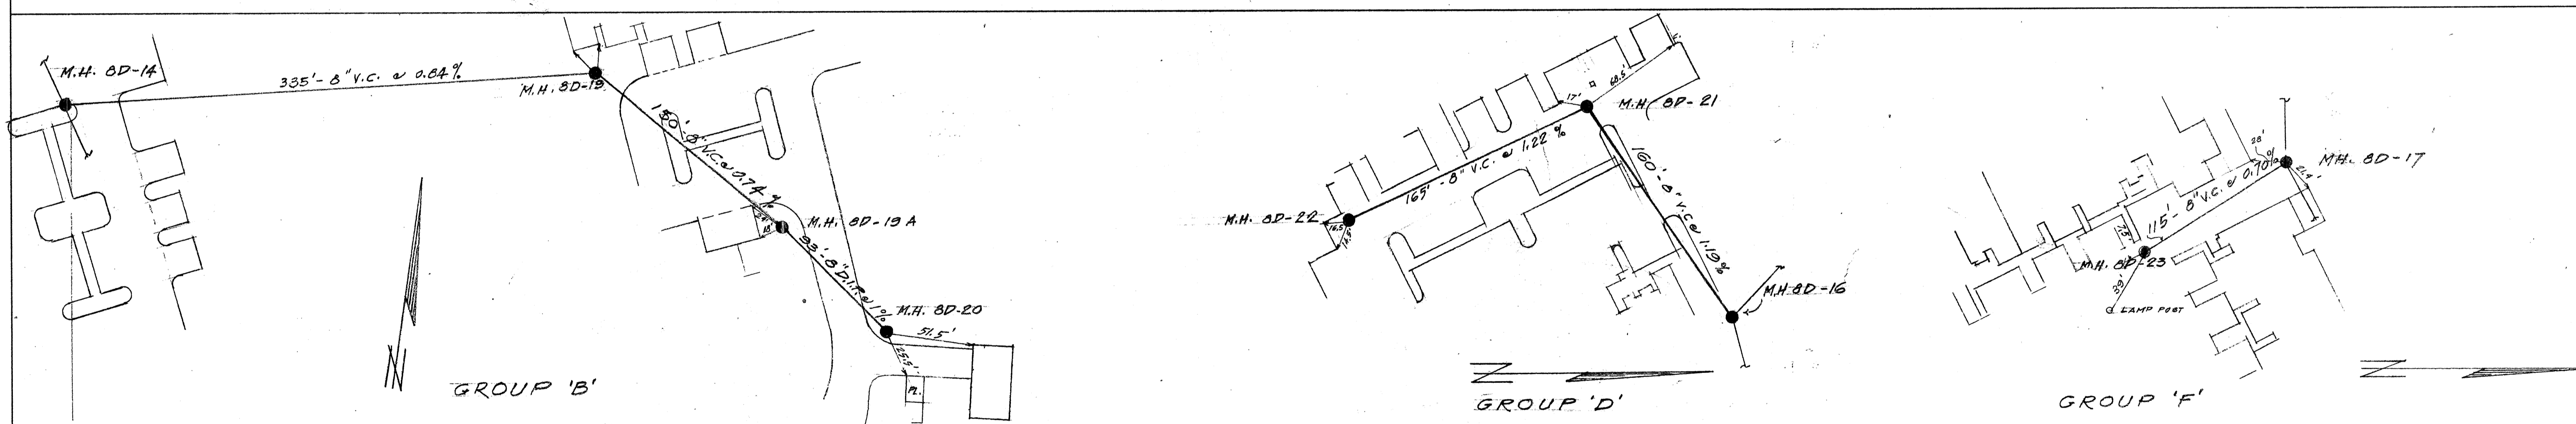
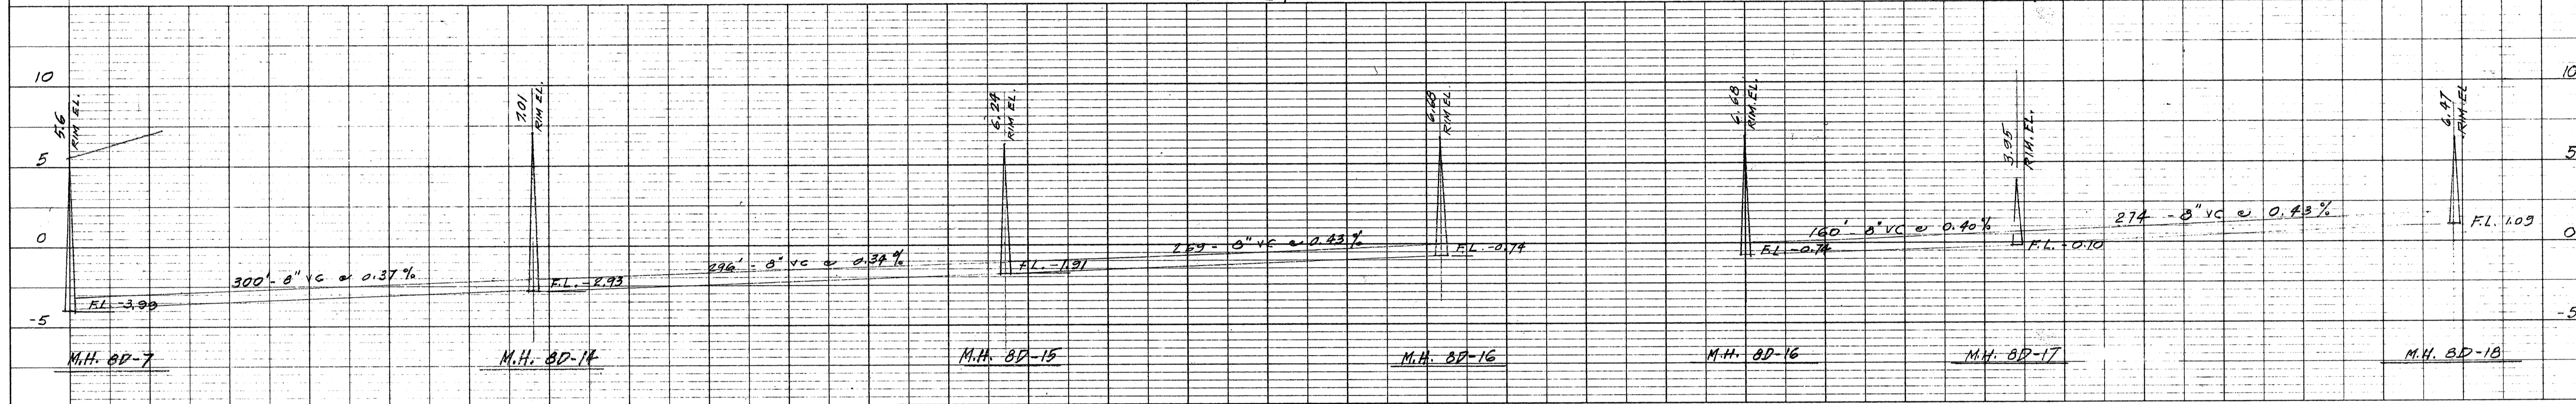


| | |
|----------|--|
| DATE | |
| BY | |
| APPROVED | |
| PLANNED | |
| NOTED | |
| NO. | |

| | |
|----------|--|
| DATE | |
| BY | |
| APPROVED | |
| PLANNED | |
| NOTED | |
| NO. | |

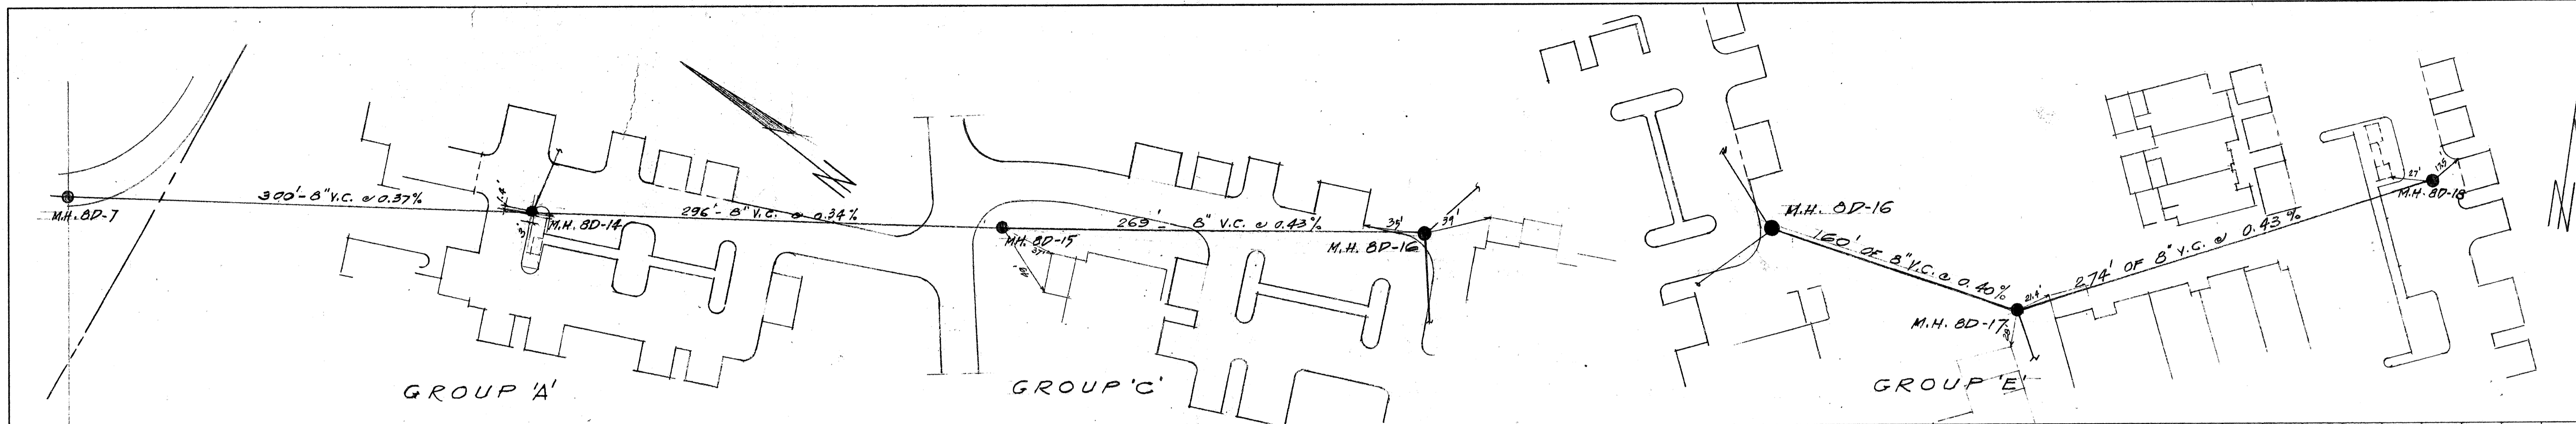

AS BUILT
MAY 20, 1985
SANITARY SEWER PLAN & PROFILE

PLATE 2 PLAN-PROFILE D. P. A. & R. E. STANDARD
100% RAC AGEPROOF VELLUM—MADE AND PRINTED IN U. S. A.
EUGENE DIEZGEN CO.

TOWN OF LONGBOAT KEY, FLORIDA
 BAYPORT BEACH AND TENNIS CLUB
 PLANNED BY: JENNIS CLIP
 CHECKED BY: JENNIS CLIP
 DATE: 12-20-85
 REVISION: 1
 DRAWN BY: JENNIS CLIP
 DATE: 12-20-85
 REV. 10/11

BAYPORT BEACH AND TENNIS CLUB
BAYPORT BEACH, FLORIDA