
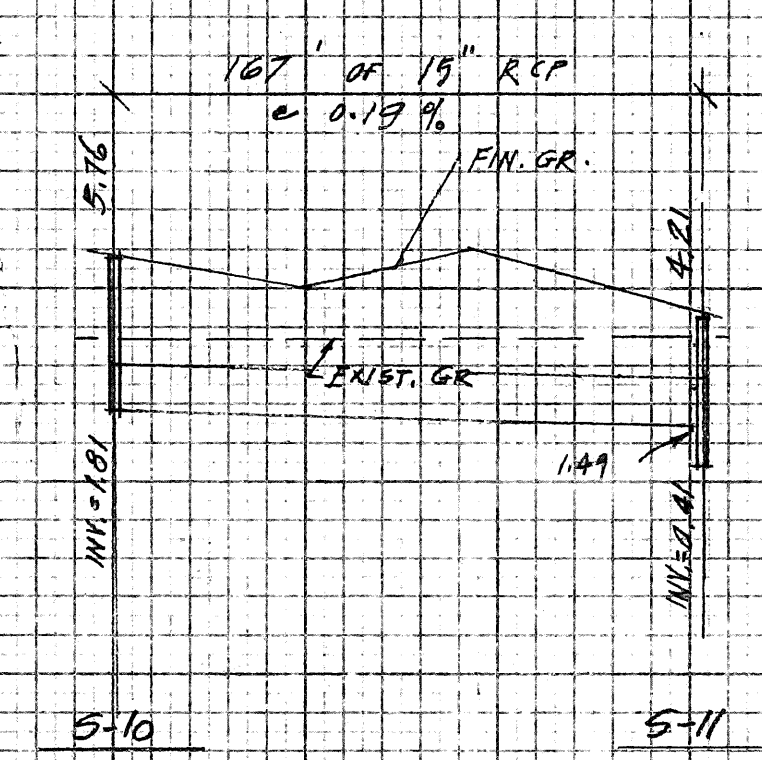
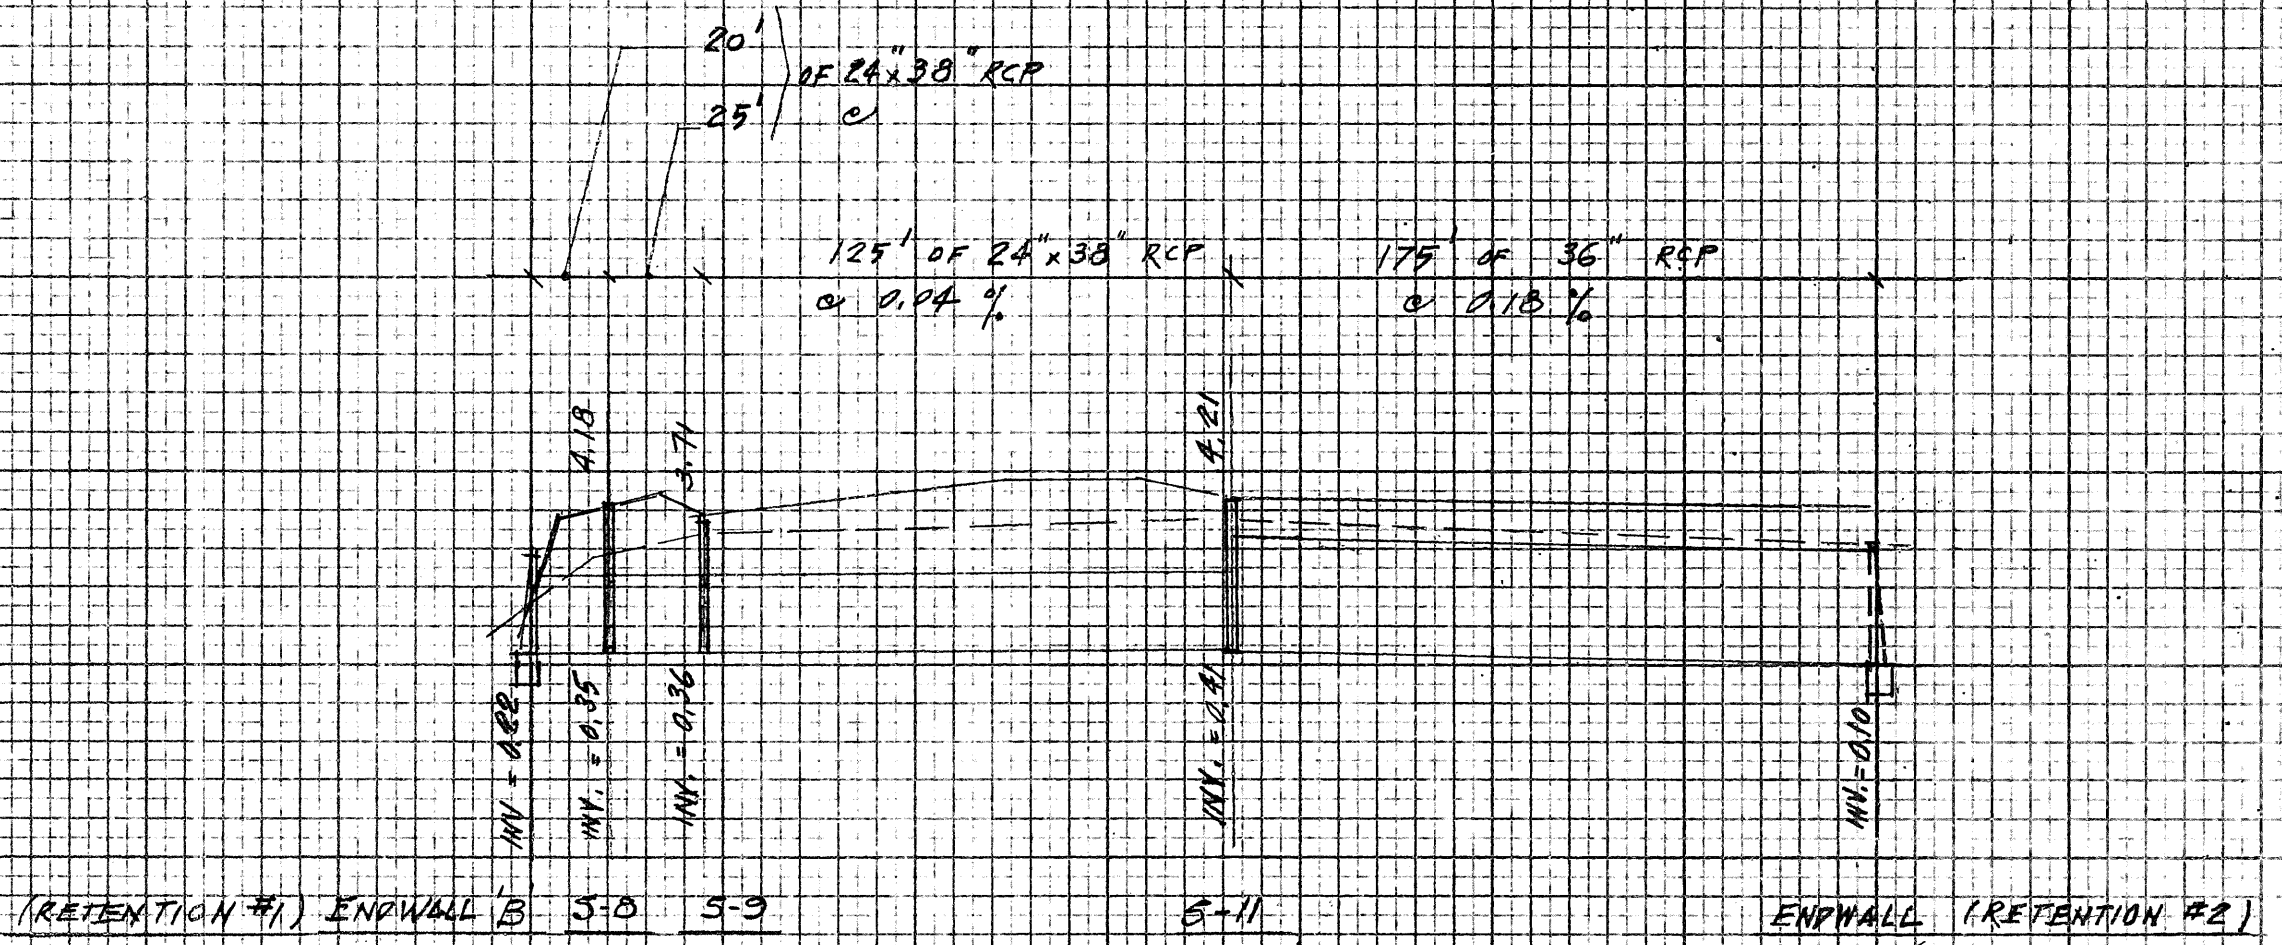
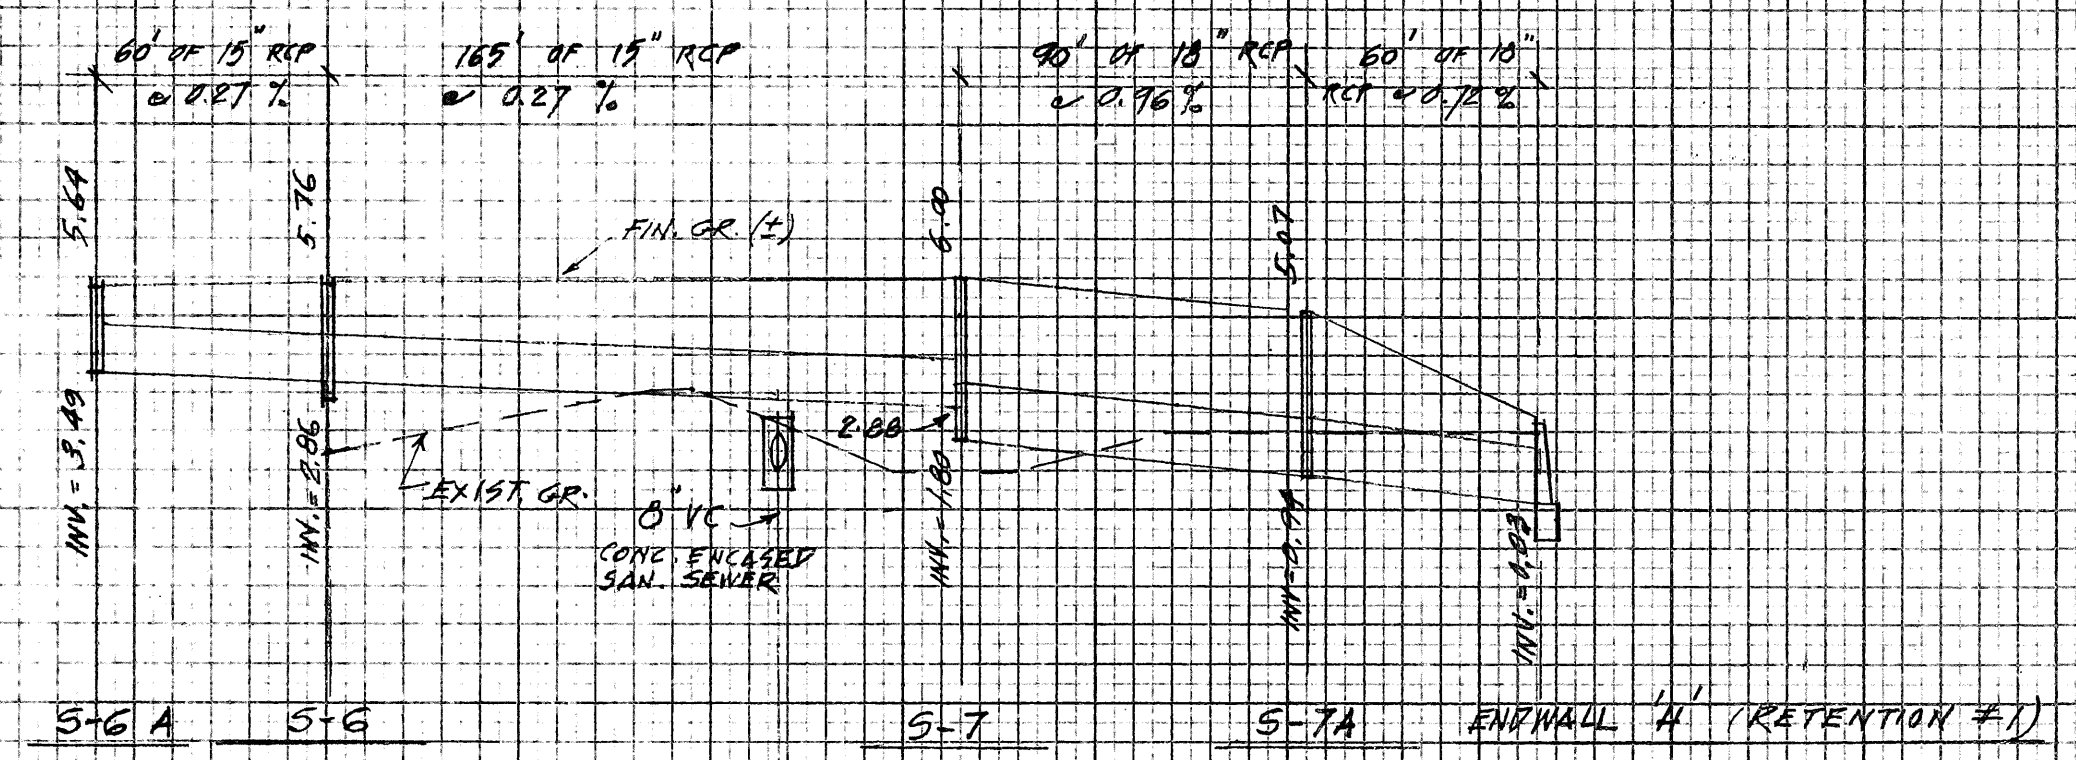
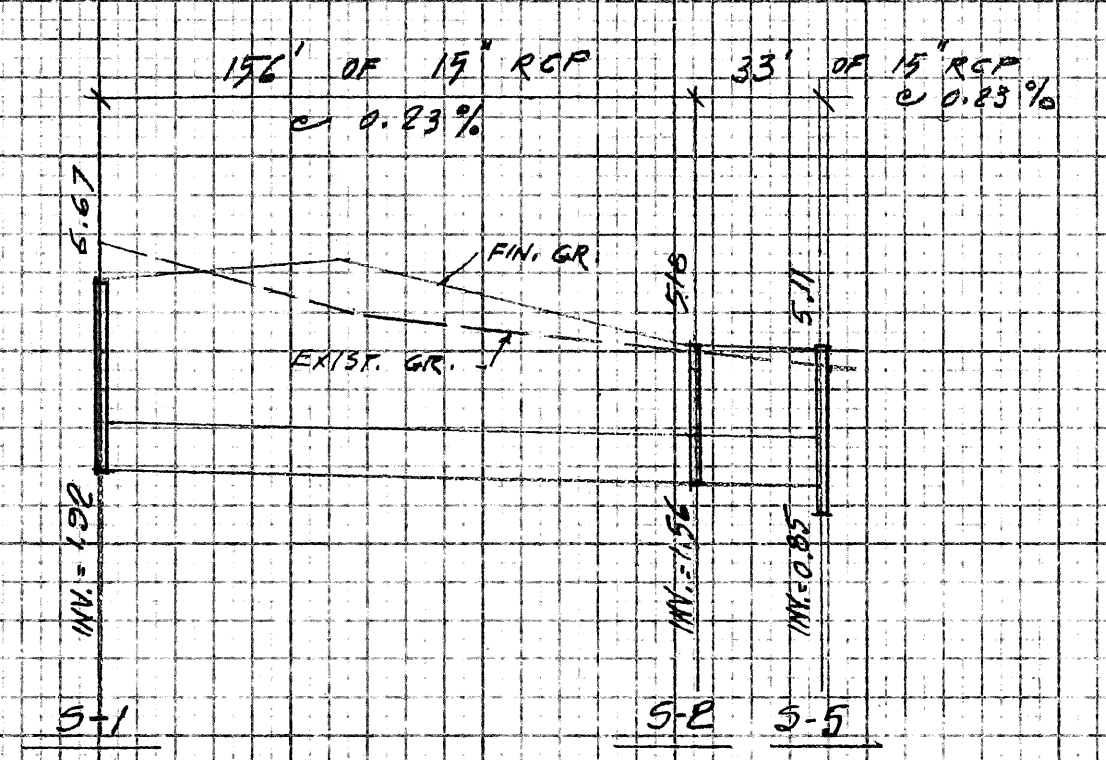


FINAL SURVEY PLOTTED AREAS CHECKED

ORIGINAL SURVEY PLOTTED AREAS CHECKED

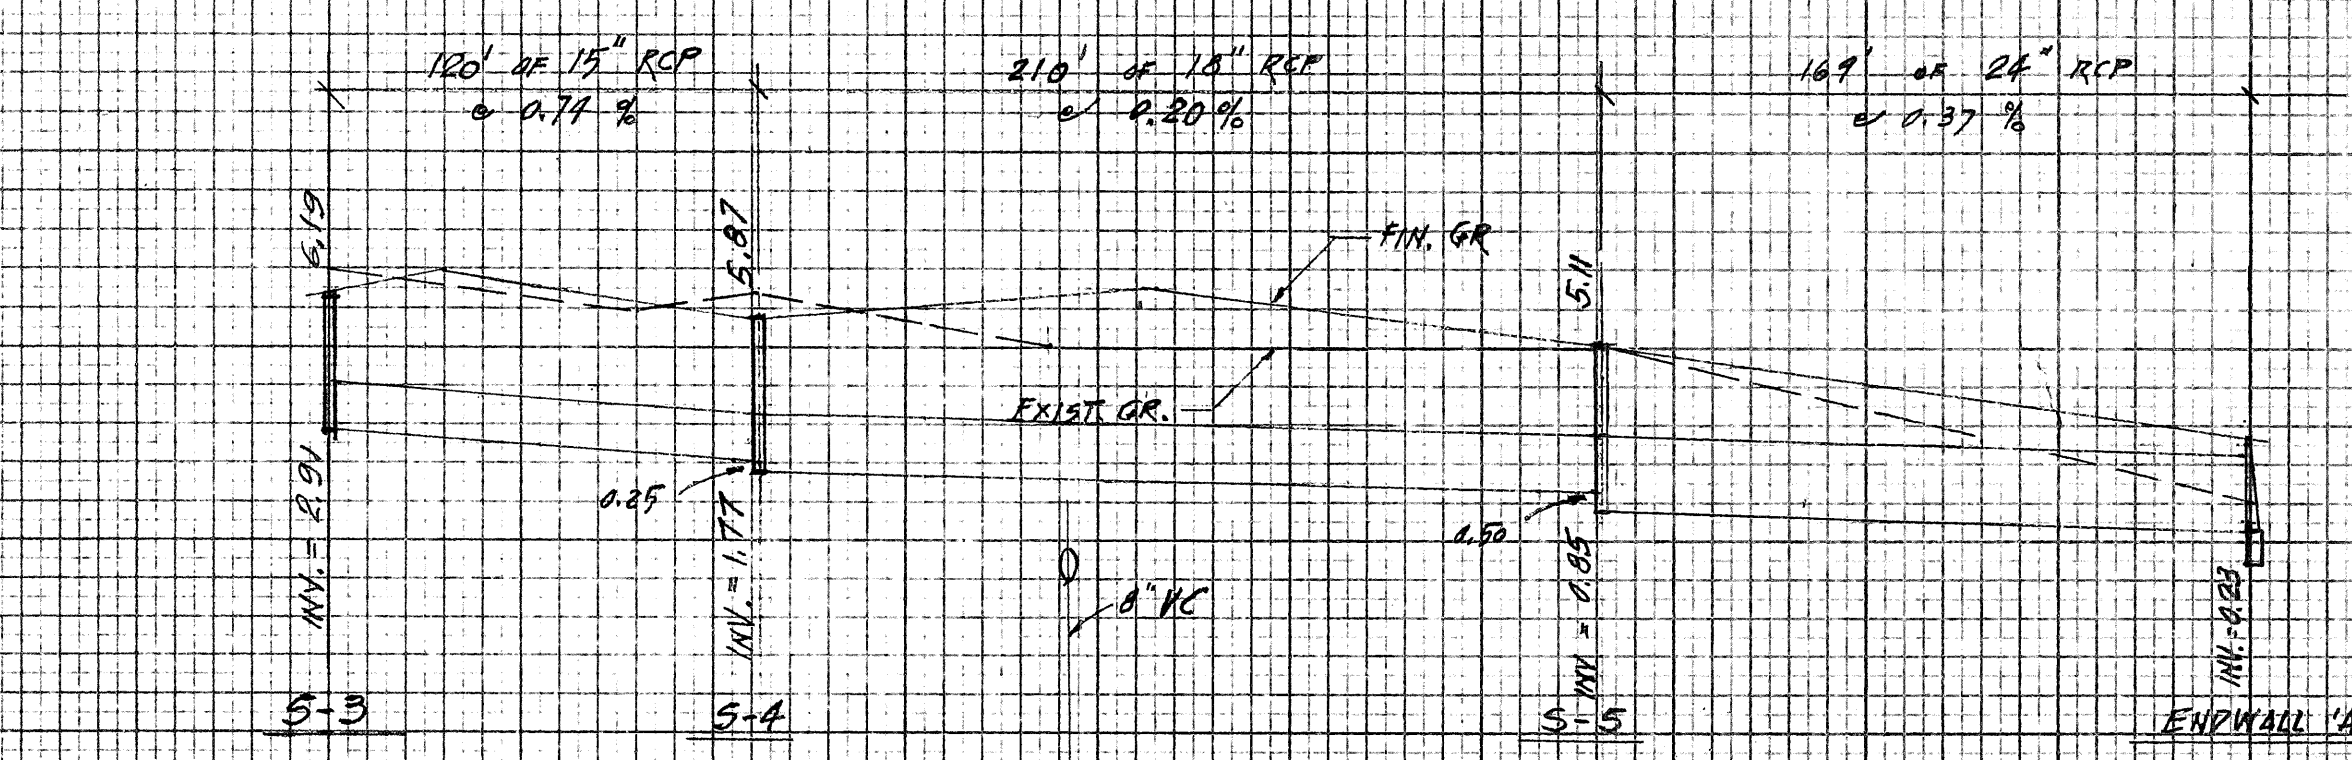

AS BUILT
MAY 20, 1985
STORM SEWER PROFILES

PLATE 3 CROSS SECTION O P R A R C STANDARD
DIETZEN CORPORATION

REVISION
DATE
BY
PROJECT ENGINEER
DRAWN BY
CHECKED BY
DATE
LOCATION