
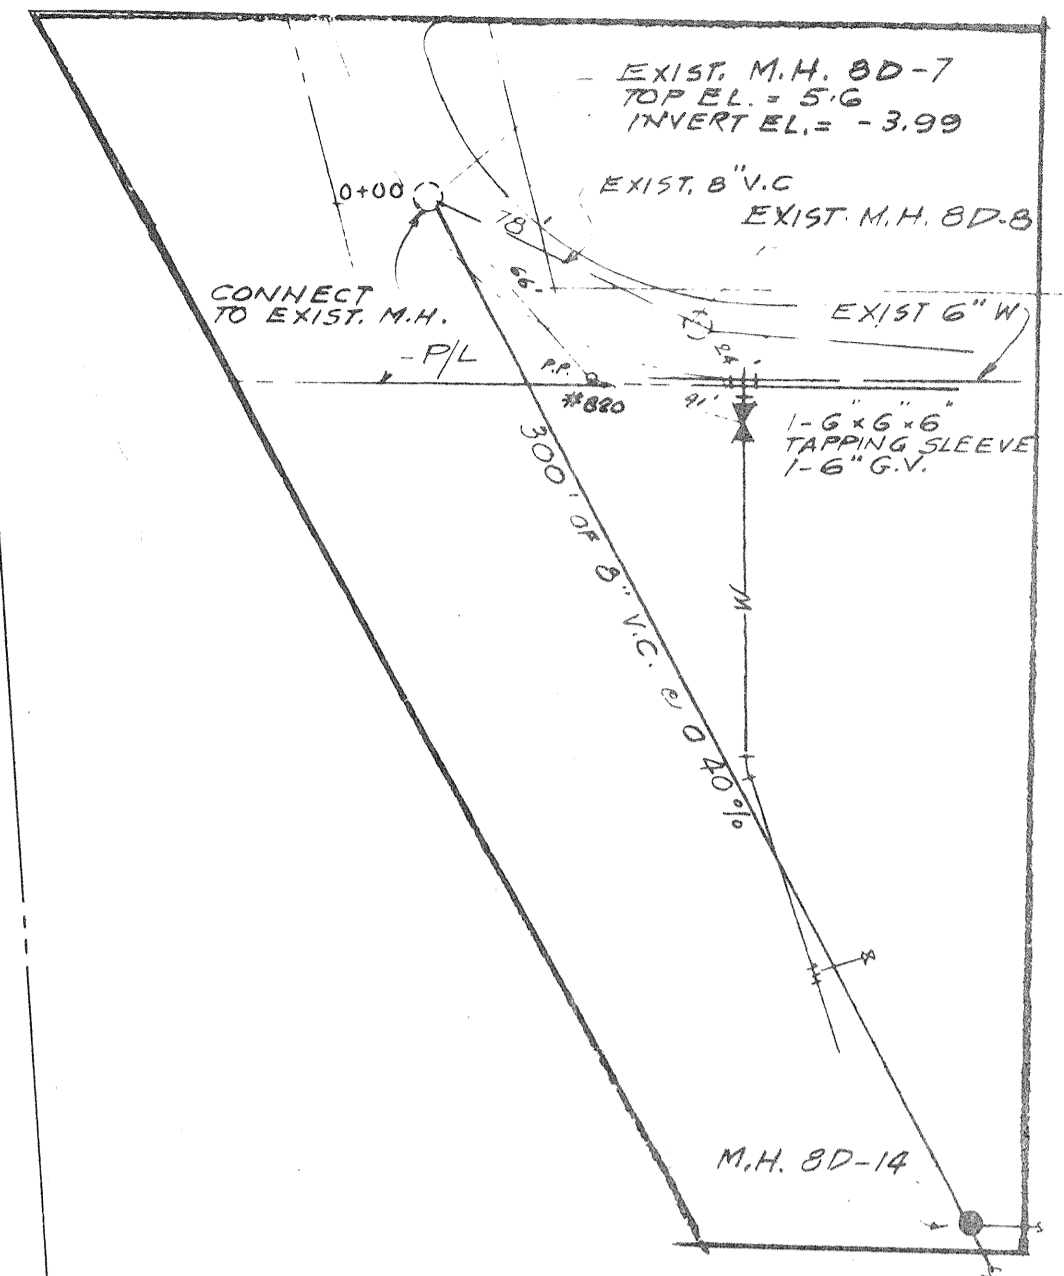


600

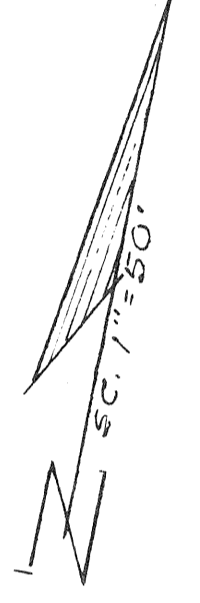

AS BUILT  
 MAY 20, 1985  
 UTILITY PLAN

BAYPORT BEACH AND TENNIS CLUB

NO.	DATE	BY	SCALE	REVISION
1	4.30.85	J.S.	1" = 50'	DESIGNED BY PROJECT
2				DATE: 6.22.85
3				DRAWN BY: ALBERT L. CONYERS
4				ARCHITECT & PLANNING

TOWN OF LONGBOAT KEY, FLORIDA  
 BAYPORT BEACH & TENNIS CLUB  
 EDWARD J. SEIBERT  
 ARCHITECT & PLANNING