


GROUND FLOOR PLAN
SCALE: 1/8" = 1'-0"

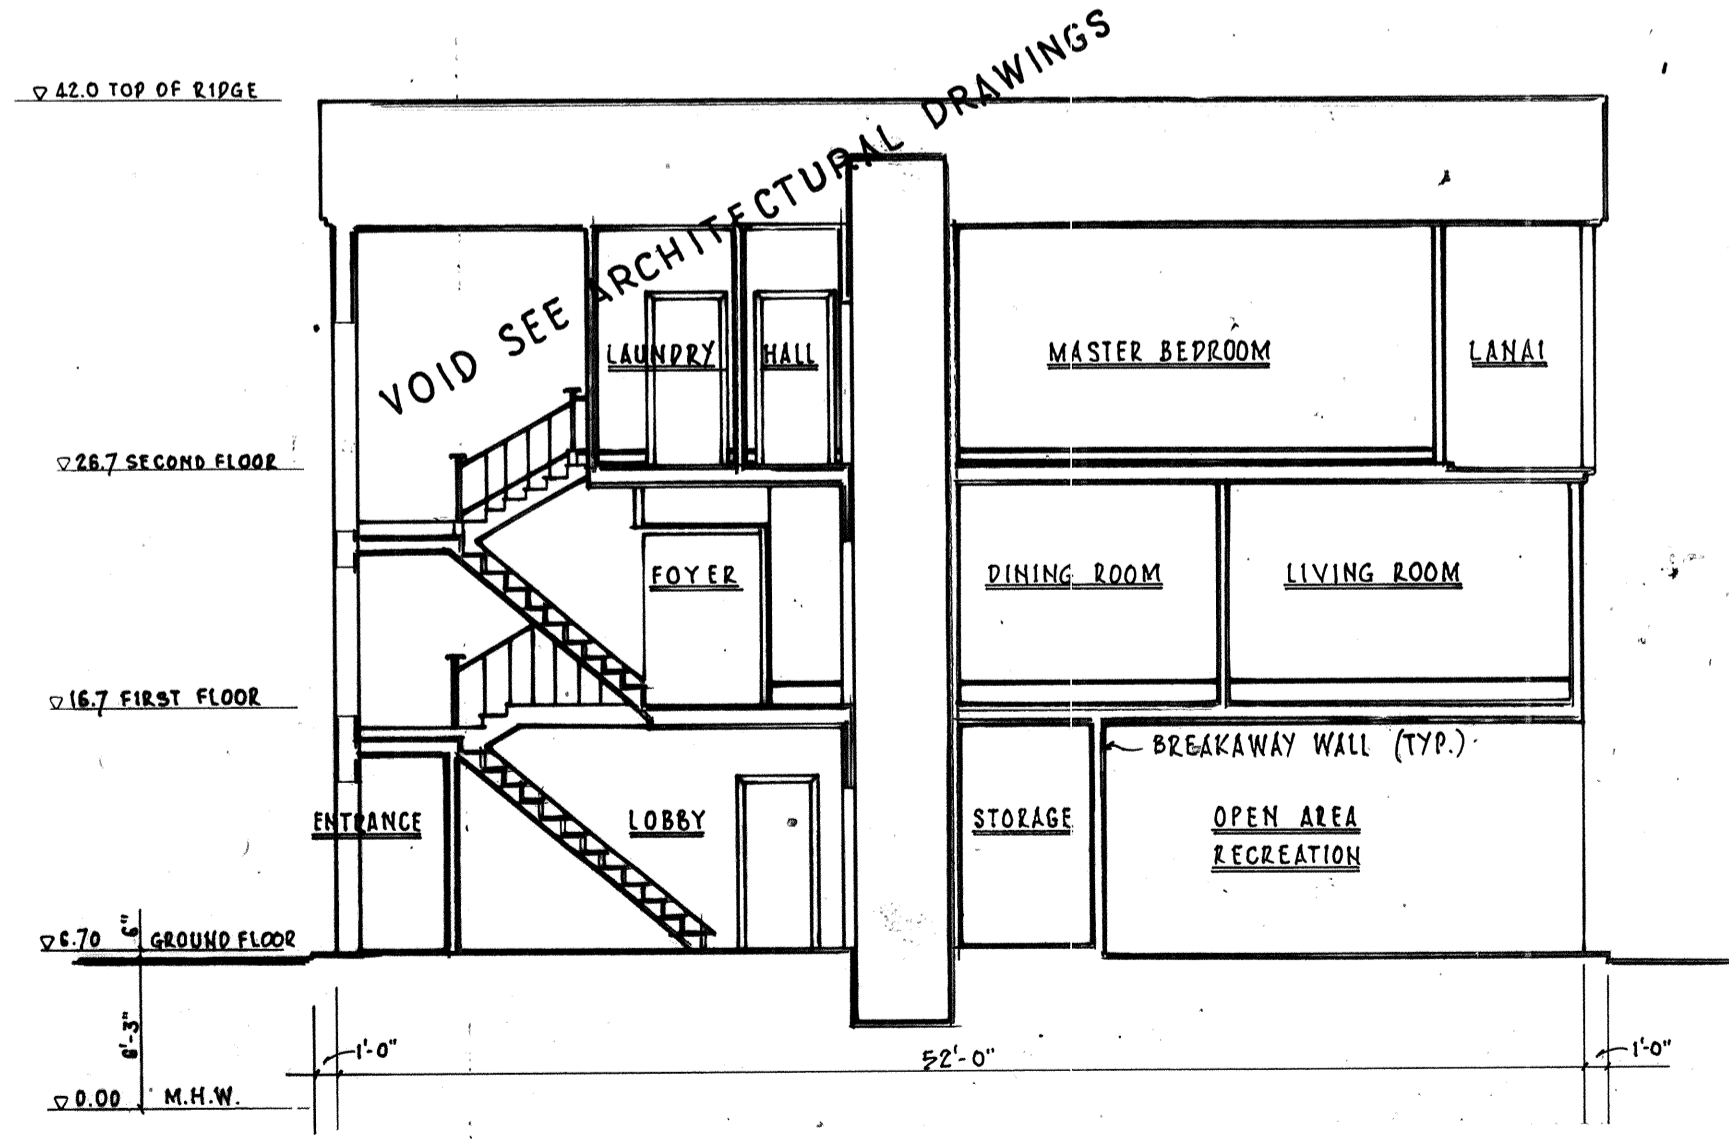

SECTION
SCALE: 1/8" = 1'-0"

RECORD DRAWING

by: *[Signature]* 6/12/91

4-8-91 W.E.M.

6/12/91

DESIGNED BY	M.J.J./CL.
DATE:	AUG., 1988
CHECKED BY	PROJECT NO. 2499
BY	DATE
REVISION	DATE
AREA VENDOR ORIGINALS NOT APPLICABLE	DATE
APPLICABLE REVISIONS TO BE APPLIED TO ALL DRAWINGS	DATE

DESIGNED BY: MILLARD J. YODER, P.E., FL. CERT. NO. 35765

DRAWN BY: E.P.

CONSULTING ENGINEERS & SURVEYORS

133 SOUTH MCINTOSH RD. SARASOTA, FLA. 33582

SMALLY, WELLFORD & NALVEN, Inc.

BEACH WALK CONDOMINIUM RECREATION AREA PLAN

INDEX NO. 9-2499-012

REVISION 5