


PLAN STA. 2+27 TO 6+67
SCALE: 1" = 20'

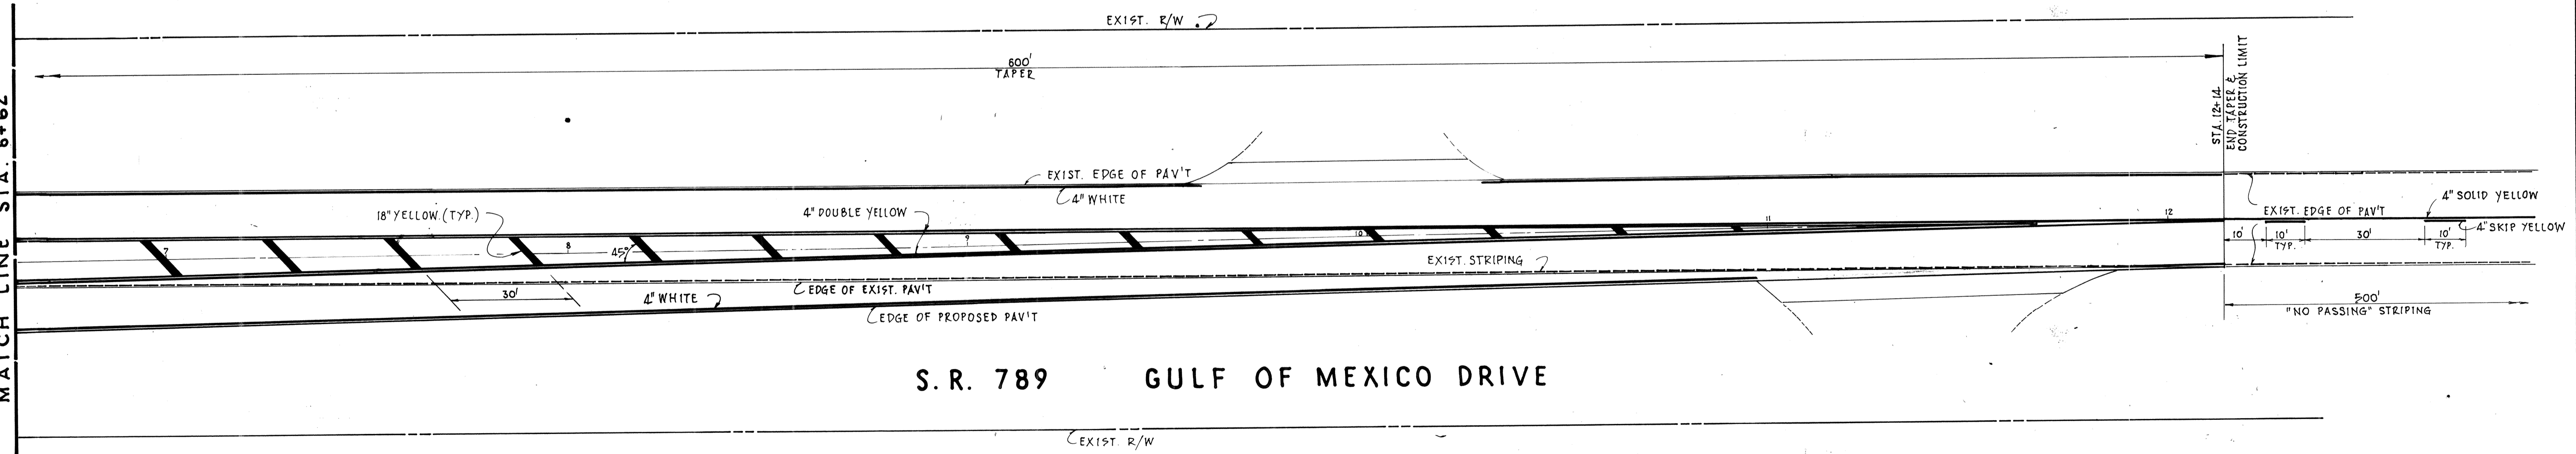

PLAN STA. 6+67 TO 12+17
SCALE: 1" = 20'

RECORD DRAWING

By: *[Signature]* 6/12/91

- NOTES:**
- REPLACE "NO PASSING ZONE" SIGN SOUTH END OF PROJECT.
 - ALL STRIPING SHALL BE THERMOPLASTIC IN ACCORDANCE WITH THE FLORIDA DEPARTMENT OF TRANSPORTATION STANDARD SPECIFICATIONS FOR ROAD AND BRIDGE CONSTRUCTION LATEST MODEL.
 - RELOCATE ALL SIGNS ALONG WIDENING TO MAINTAIN THEIR EXISTING OFFSET FROM THE PROPOSED EDGE OF PAVEMENT.
 - THE CONTRACTOR SHALL PROVIDE TEMPORARY STRIPING UPON COMPLETION OF EACH PHASE OF ASPHALT SURFACING IN ACCORDANCE WITH FDOT REQUIREMENTS.

6/12/91
[Signature]
MILLARD J. JOBER, P.E.,
FL. CERT. NO. 52765

DATE:	DEC., 1988	SCALE:	1" = 20'	BY:	[Signature]	
DESIGNED BY:	M.J.J. / C.L.	CHECKED BY:	PROJECT NO.	7499	DRAWN BY:	E.P.
REVISION			GENERAL REVISION			
REVISION			JOB: SIDEWALK			
DATE:			5/8/89			
L.T.R.:			A. S.			
DATE:			6/7/89			
L.T.R.:			A. S.			

FOR: RIVIERA CORPORATION

BEACH WALK CONDOMINIUM STRIPING PLAN

SMALLY, WELLFORD & NALVEN, Inc. CONSULTING ENGINEERS & SURVEYORS

133 SOUTH MCINTOSH RD. SARASOTA, FLA. 33592

INDEX NO. 6-2499-017