


TOWN OF LONGBOAT KEY, FLORIDA
 ARVIDA CORPORATION
 BEACHPLACE AS-BUILT
 ENGINEER BENNETT & BISHOP, INC. ENGINEERS & SURVEYORS 4509 BEE RIDGE ROAD SARASOTA, FLORIDA
 SHEET NUMBER 250-023 AB
 REVISION
 LTR. DATE
 BY
 SCALE: 1" = 40'
 DATE: 8-10-81
 DESIGNED BY M.W.
 DRAWN BY
 CHECKED BY PROJECT NO.
 F.V.
 SEE SHEET N° 250-022 AB
 MATCH LINE
 MATCH LINE
 115 APPROX. M.H.W. 4-5-78
 150'
 THE PRIVATEER NORTH C.B. 7, PG. 22A
 EXIST. SEAWALL
 DUNE WALKOVER STRUCTURE
 DUNE WALKOVER STRUCTURE
 COASTAL CONSTRUCTION CONTROL LINE - TOWN OF LONGBOAT KEY
 COASTAL CONSTRUCTION CONTROL LINE
 MATCH LINE
 MATCH LINE
 REVISION
 LTR. DATE
 BY
 SCALE: 1" = 40'
 DATE: 8-10-81
 DESIGNED BY M.W.
 DRAWN BY
 CHECKED BY PROJECT NO.
 F.V.
 SEE SHEET N° 250-022 AB
 MATCH LINE
 MATCH LINE
 115 APPROX. M.H.W. 4-5-78
 150'
 THE PRIVATEER NORTH C.B. 7, PG. 22A
 EXIST. SEAWALL
 DUNE WALKOVER STRUCTURE
 DUNE WALKOVER STRUCTURE
 COASTAL CONSTRUCTION CONTROL LINE - TOWN OF LONGBOAT KEY
 COASTAL CONSTRUCTION CONTROL LINE
 MATCH LINE
 MATCH LINE

GULF OF MEXICO

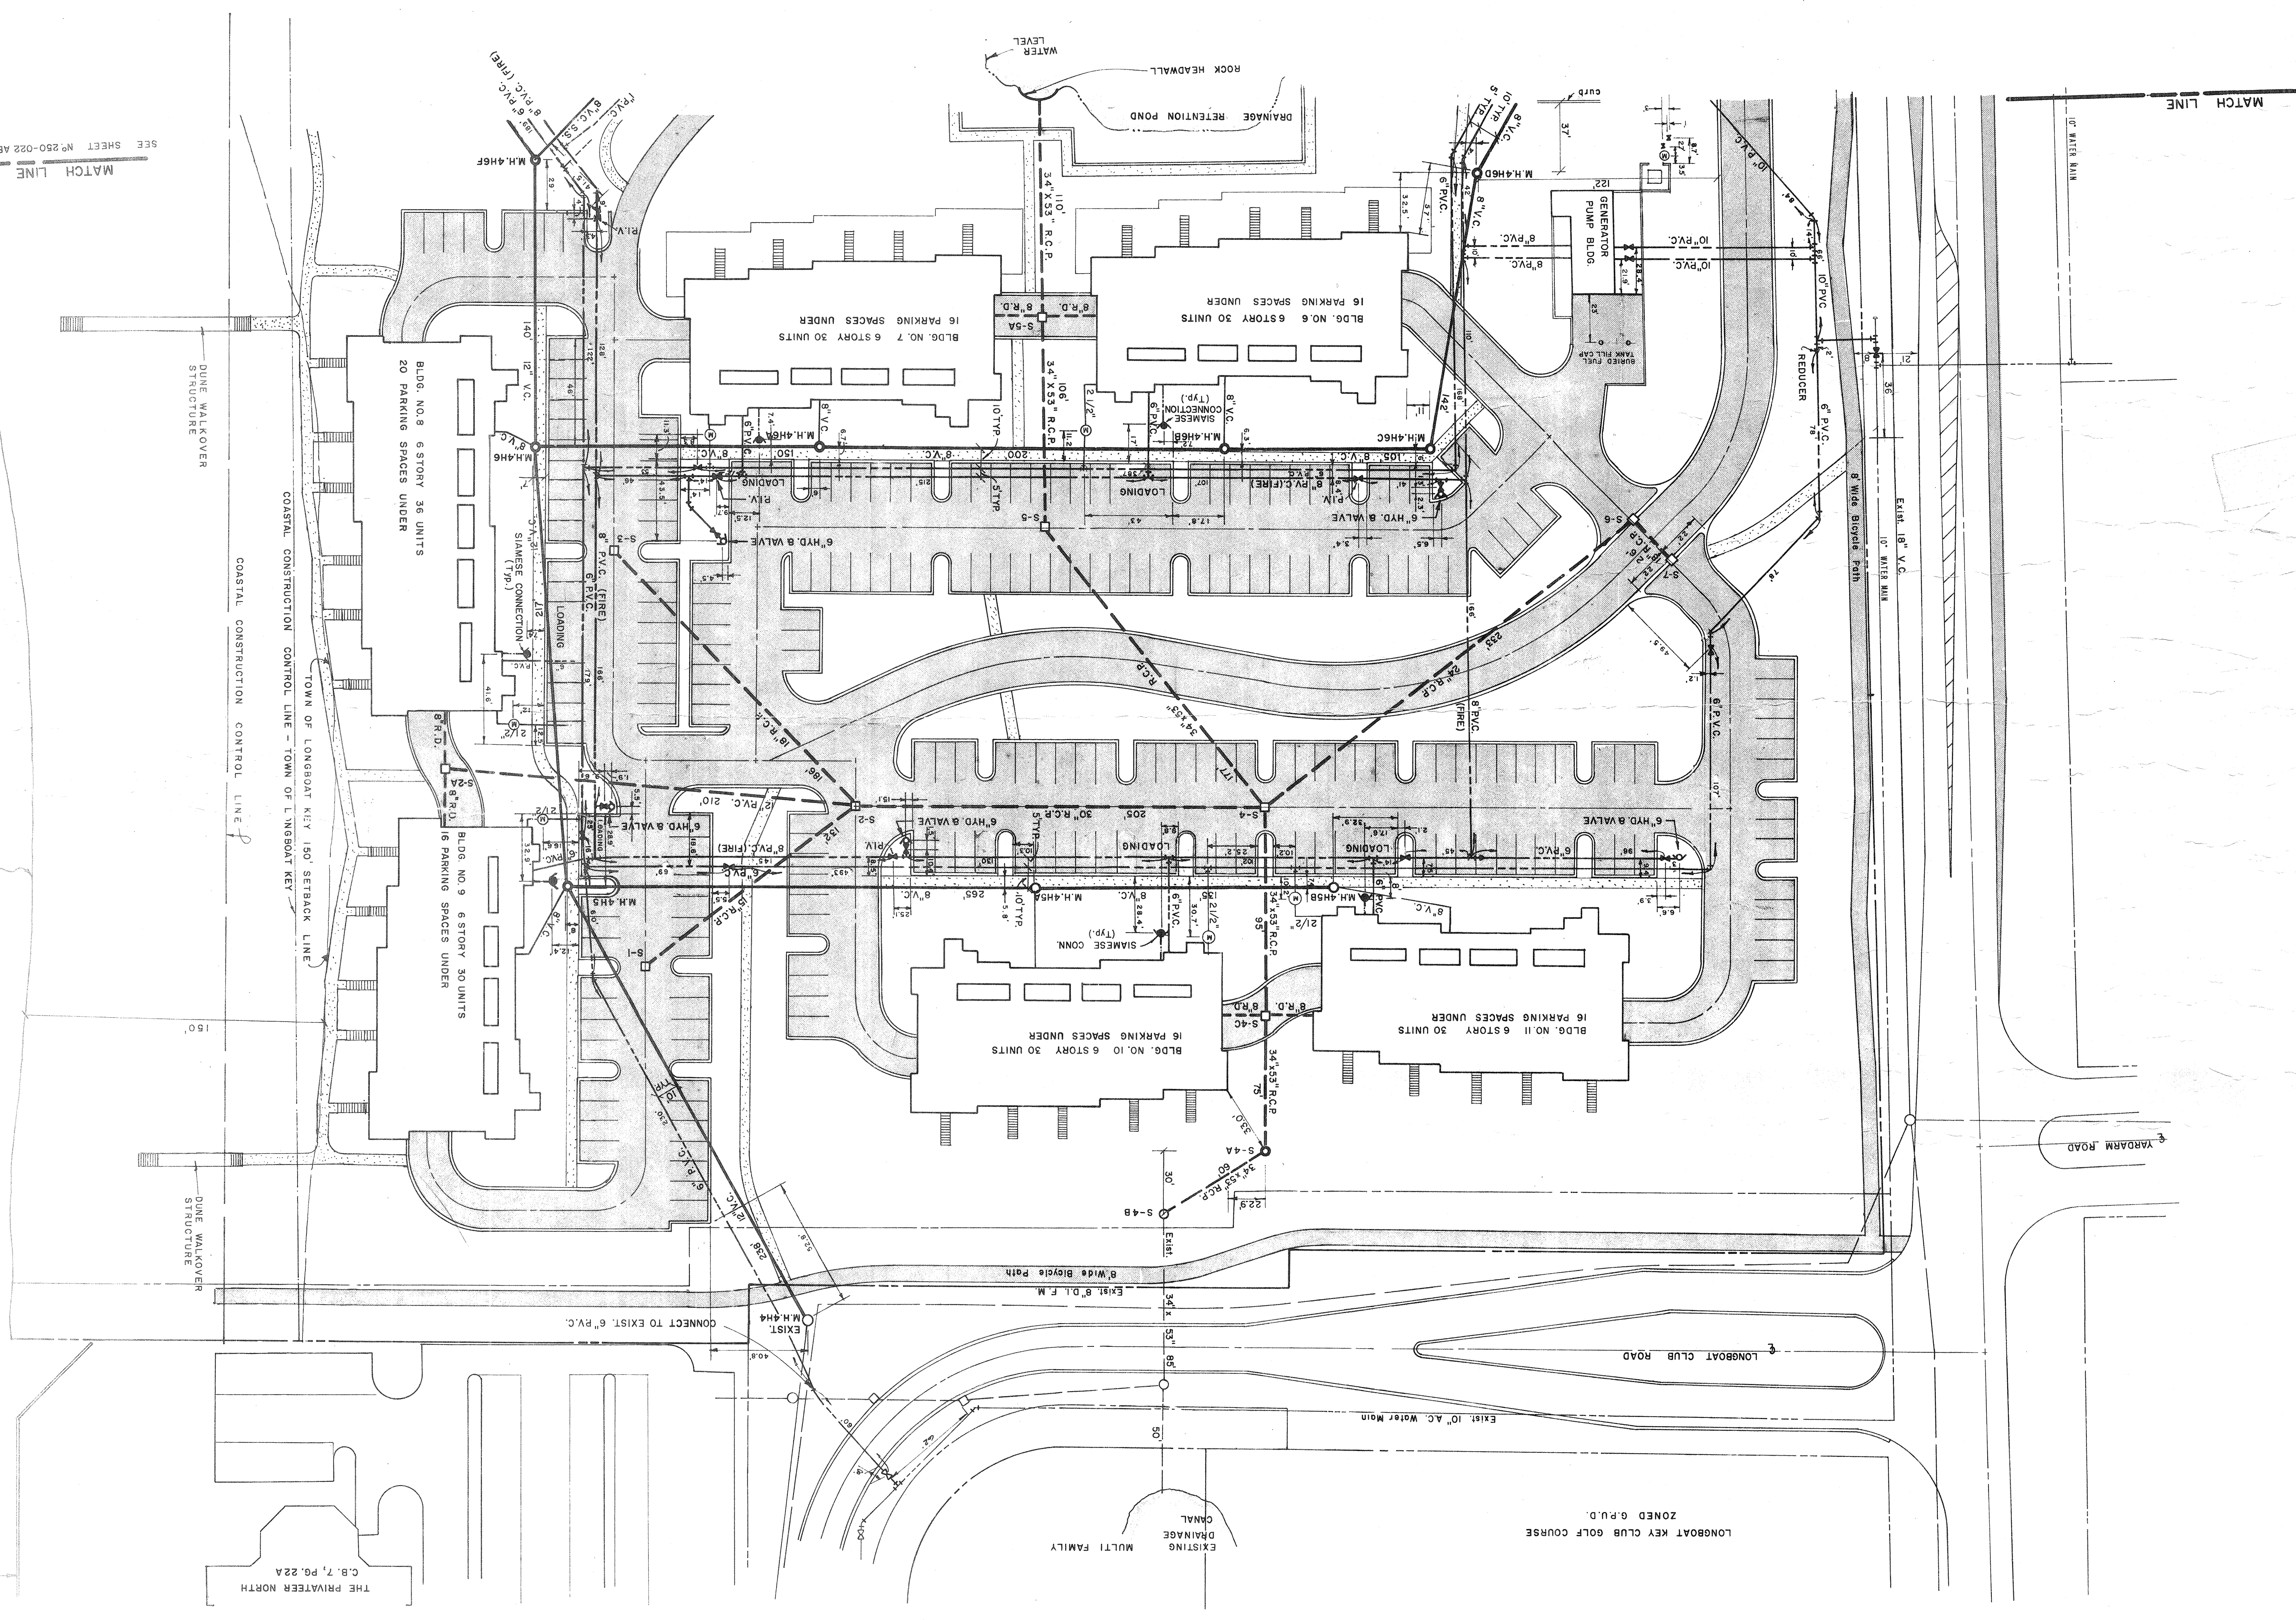

TOWN OF LONGBOAT KEY, FLORIDA
 ARVIDA CORPORATION
 BEACHPLACE AS-BUILT
 ENGINEER BENNETT & BISHOP, INC. ENGINEERS & SURVEYORS 4509 BEE RIDGE ROAD SARASOTA, FLORIDA
 SHEET NUMBER 250-023 AB
 REVISION
 LTR. DATE
 BY
 SCALE: 1" = 40'
 DATE: 8-10-81
 DESIGNED BY M.W.
 DRAWN BY
 CHECKED BY PROJECT NO.
 F.V.
 SEE SHEET N° 250-022 AB
 MATCH LINE
 MATCH LINE
 115 APPROX. M.H.W. 4-5-78
 150'
 THE PRIVATEER NORTH C.B. 7, PG. 22A
 EXIST. SEAWALL
 DUNE WALKOVER STRUCTURE
 DUNE WALKOVER STRUCTURE
 COASTAL CONSTRUCTION CONTROL LINE - TOWN OF LONGBOAT KEY
 COASTAL CONSTRUCTION CONTROL LINE
 MATCH LINE
 MATCH LINE