


GULF OF MEXICO

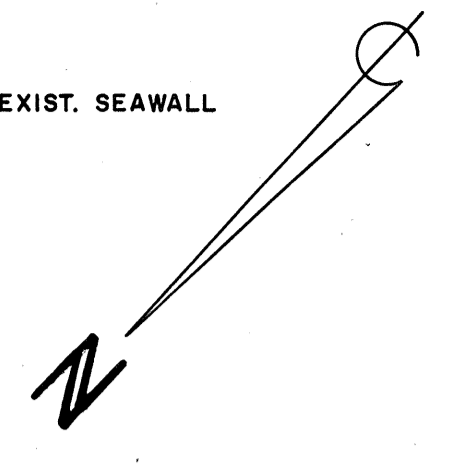

MATCH LINE
SEE SHEET NO. 250-022 AB

MATCH LINE

REVISION	BY	REVISION	DATE:	DESIGNED BY:
			8-10-81	M. W.
250-023 AB	PROJECT ENGINEER	TOWN OF LONGBOAT KEY, FLORIDA	SCALE:	DRAWN BY:
			1" = 40'	F.V.
SHEET NUMBER		L.T.R. DATE		PROJECT NO.
250-023 AB				
REVISION		TOWN OF LONGBOAT KEY, FLORIDA		ENGINEERS & SURVEYORS
		ARVIDA CORPORATION		4509 BEE RIDGE ROAD
		BEACHPLACE		SARASOTA, FLORIDA
		AS-BUILT		
		BENNETT & BISHOP, INC.		
		T.L.K. FILE NO.		