


NOTE:
 SALES OFFICE (TRAILER) IS CONNECTED TO "OLD" SANITARY SEWER MANHOLE. OUTFALL LINE AND SERVICE LINE TO BE PLUGGED AND MANHOLE FILLED IN WHEN TRAILER IS REMOVED.

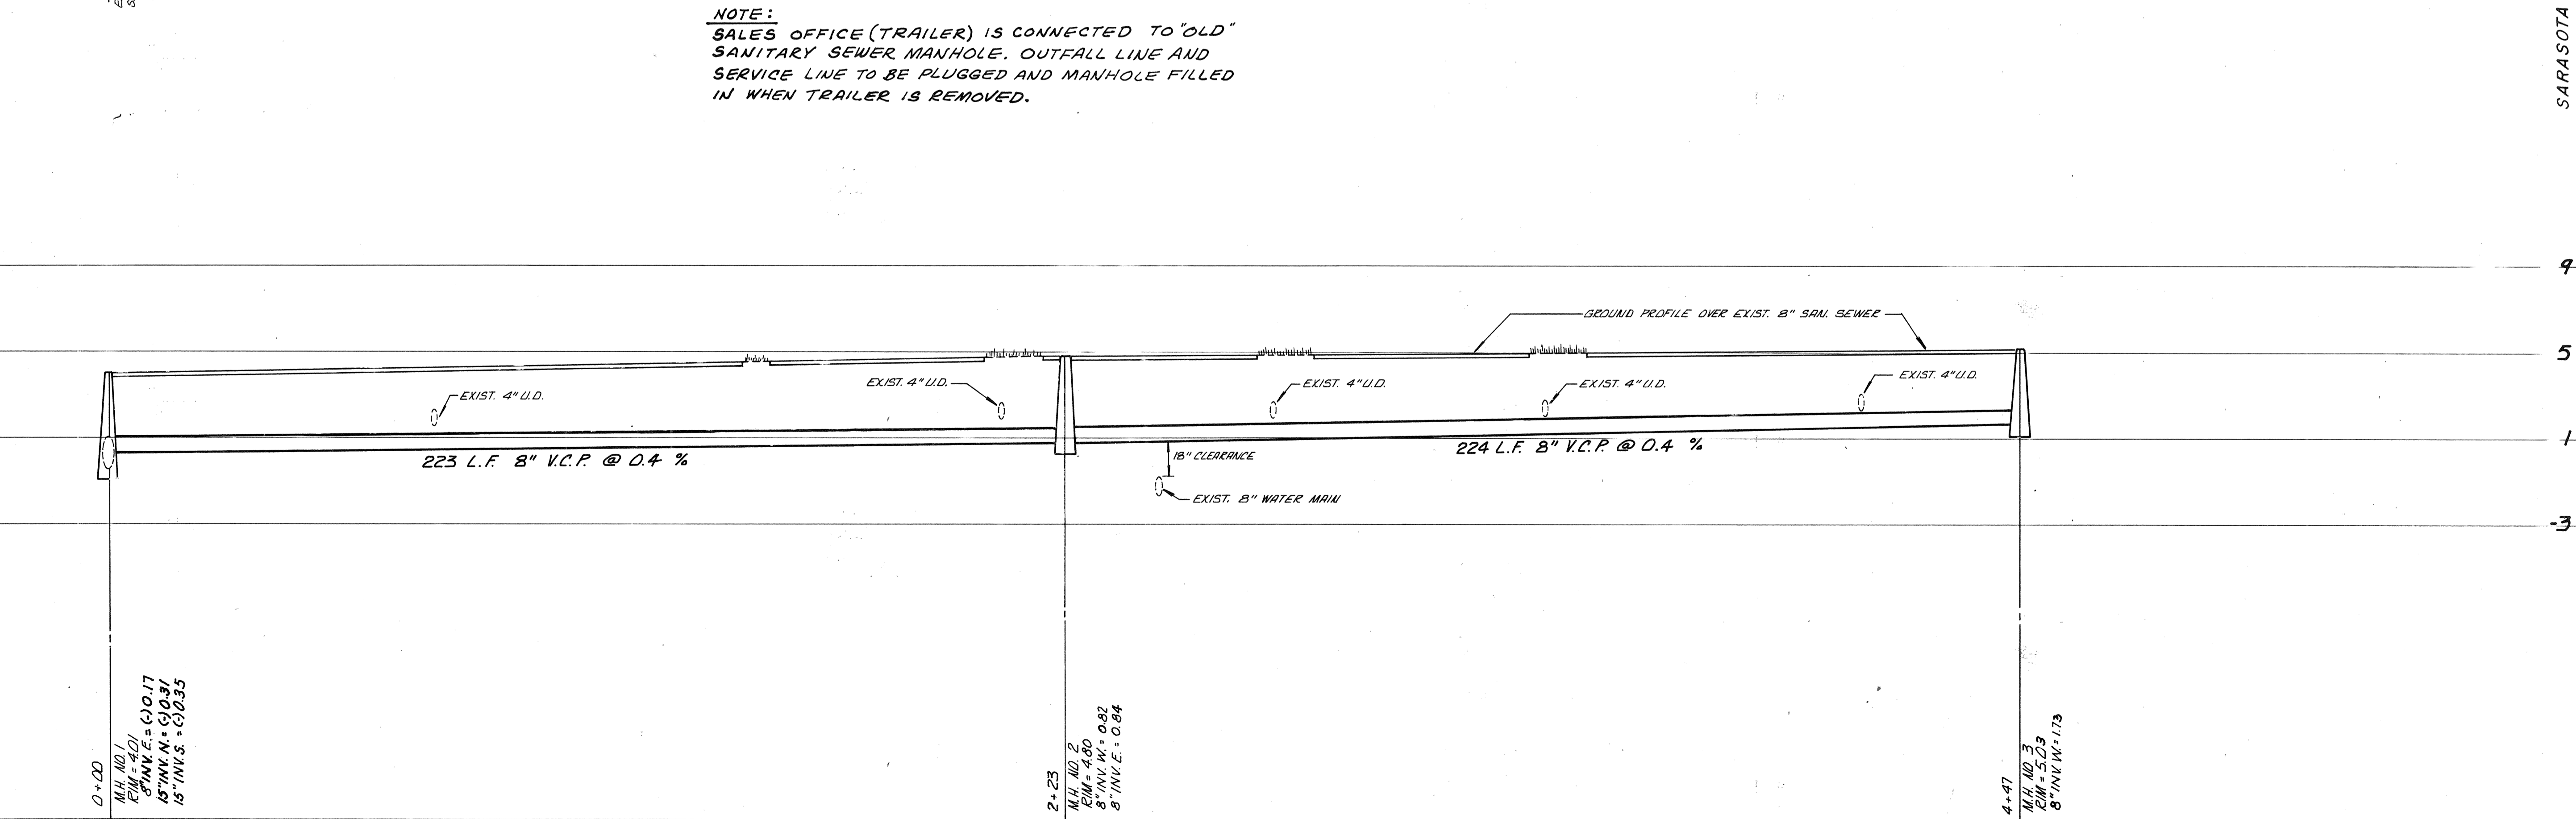

0+00
 M.H. NO. 1
 RIM = 4.01
 8" INV. E. = C10.17
 15" INV. N. = C10.31
 15" INV. S. = C10.35

2+23
 M.H. NO. 2
 RIM = 4.80
 8" INV. N. = 0.92
 8" INV. E. = 0.84

4+47
 M.H. NO. 3
 RIM = 5.03
 8" INV. N. = 1.73

DESIGNED BY		PROJECT ENGINEER	
DATE:		10-21-87	
SCALE:		1" = 20'	
DRAWN BY		RWC	
CHECKED BY		M.E.O.	
BY		RWC	
REV. PER CONST. RECORDS		REVISION	
REV. PER CORRECTIONS TO WATER LINES, RE-LAID SAN. SEW. MH & TO MH 3 AND OLD SAN. SEW. WITH 80' L.C.		REV. PER CONST. RECORDS	
L.T.R. DATE		10-21-87	
TOWN OF LONGBOAT KEY, FLORIDA		SARASOTA BAY	
BARRY LEWIS		RECORD DRAWING	
THE BOATHOUSE OF LONGBOAT KEY		78 SARASOTA CENTER BOULEVARD	
AS BUILT		SARASOTA, FLORIDA 32420	
ENGINEER		(813) 371-6362	
LOCATION		T.L.K. FILE NO.	
WILLIAM F. BISHOP & ASSOCIATES, INC.		SHEET NUMBER	
		BLWS-0001	
REVISION			