


CONSTRUCTION NOTES:

1. CONTRACTOR TO MAINTAIN CONSISTENT GRADE IN FORCE MAIN FROM LIPT STATION TO TIE TO EXISTING TO AVOID AIR ENTRAPMENT. AIR RELEASE VALVE MAY BE REQUIRED AT TOWN OF LONGBOAT KEY OPTION.
2. CONTRACTOR TO VERIFY LOCATION OF EXISTING WATER AND FORCE MAIN FOR TIE DISTANCE PRIOR TO PREPARING CONSTRUCTION PRICES FOR BIDDING.
3. STORMWATER FILTRATION APPROVALS WERE OBTAINED FROM S.W.F.W.M.D. BY WEST & CONYERS. THIS PERMIT DOES NOT HAVE AN EXPIRATION, AND THE APPROVED CONCEPT HAS BEEN UTILIZED IN THE PROPOSED PLANS.
4. EXISTING SITE TOPOGRAPHY HAS NOT BEEN UPDATED TO REFLECT THE LOCATION AND ELEVATION OF FILL PLACED (IN ACCORDANCE WITH APPROVED DREDGE AND FILL PERMITS OBTAINED FROM WEST & CONYERS) FOR COMPANION WAY ROAD BEYOND THE EXISTING PAVEMENT. GRADES AND FILL LOCATION WILL BE OBTAINED PRIOR TO CONSTRUCTION. IF NECESSARY, ROADWAY ALIGNMENT AND GRADES WILL BE ADJUSTED FOR COMPATIBILITY WITH THESE CONDITIONS.

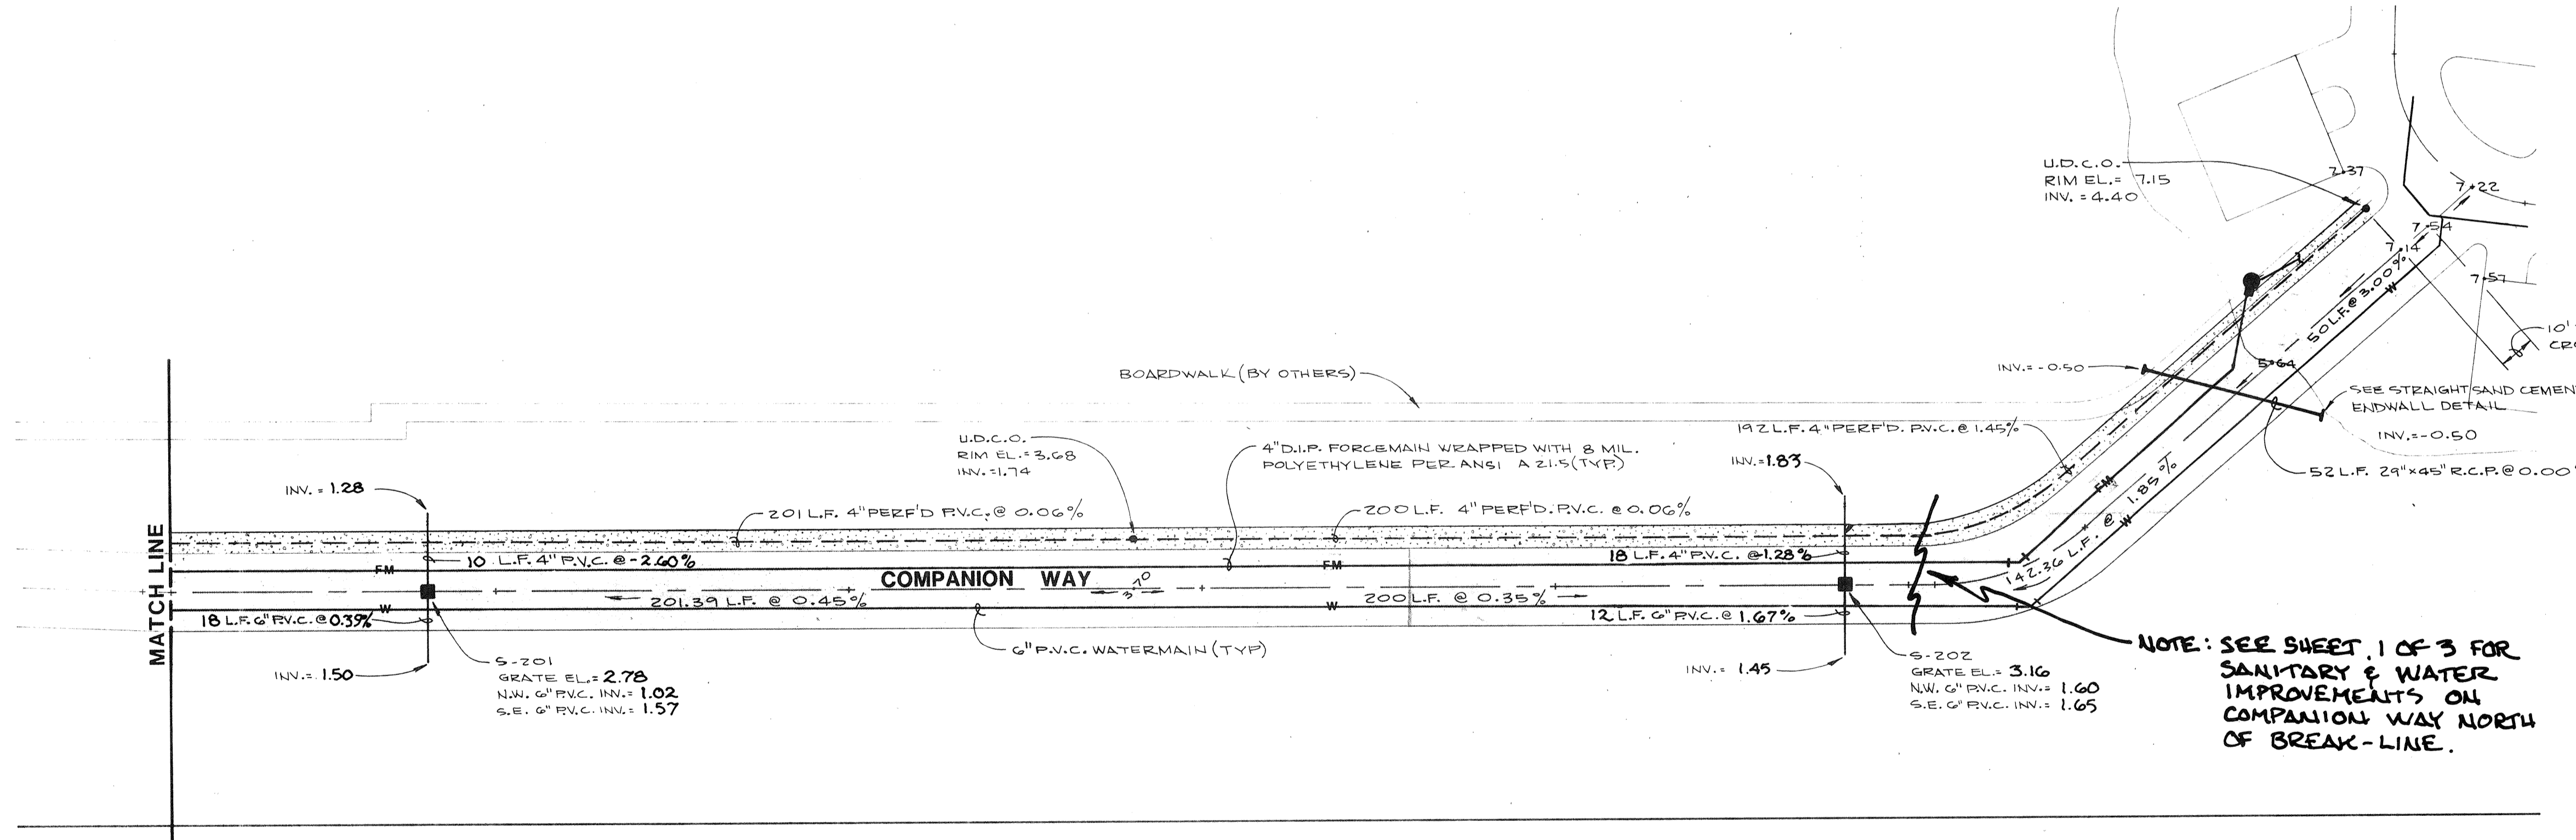

**RECORD DRAWING**  
 OF  
**COMPANION WAY EXTENSION,**  
**FORCEMAIN AND WATERMAIN PLAN**  
 FOR  
**CEDARS EAST - STAGE 7**  
 AT  
**LONGBOAT KEY**  
 ON  
**SARASOTA BAY**  
 LOCATED IN  
**SEC. 24 & 25, TWP. 35S., RGE. 16E.**  
**MANATEE COUNTY, FLORIDA**

NOV 19 1991

**LEGEND**

3.47	EXISTING GRADE
4.21	PROPOSED GRADE
■	INLET & P.V.C. PIPE
FM	FORCEMAIN
W	WATERMAIN
—	GRAVEL TRENCH W/ PERFD. P.V.C.

**ENGINEER'S CERTIFICATE**

I, THE UNDERSIGNED PROFESSIONAL ENGINEER, HEREBY CERTIFY THAT TO THE BEST OF MY KNOWLEDGE AND BELIEF THE IMPROVEMENTS DEPICTED HEREON HAVE BEEN CONSTRUCTED IN SUBSTANTIAL COMPLIANCE WITH THE APPROVED PLANS. I FURTHER STATE THAT THIS RECORD DRAWING WAS PREPARED UNDER THE DIRECT SUPERVISION OF A PROFESSIONAL LAND SURVEYOR REGISTERED IN THE STATE OF FLORIDA.

ZOLLER, NAJJAR & SHROYER, INC.  
 P. O. BOX 9448  
 BRADENTON, FLORIDA 34206

*Richard P. Clarke*  
 RICHARD P. CLARKE P.E. #16377

DATE OF CERTIFICATION: 11-19-91

I HEREBY CERTIFY THAT THE RECORD DRAWING OF THE UTILITIES SHOWN, SUPERIMPOSED UPON THE DESIGN CONSTRUCTION PLANS, IS TO THE BEST OF MY KNOWLEDGE, INFORMATION, AND BELIEF A TRUE AND CORRECT REPRESENTATION OF THE IMPROVEMENTS AS SHOWN.

ZOLLER, NAJJAR & SHROYER, INC.  
 P.O. BOX 9448  
 BRADENTON, FLORIDA 34206

*James A. Gatch, Jr.*  
 JAMES A. GATCH, JR. PLS #4295

DATE OF FIELD WORK: 12-12-89 DATE OF CERTIFICATION: 11-18-91

**REVISIONS**

1	RECORD DRAWING	TJP
2	FINAL SUBM. TO S.C.	11-18-91
3		
4		
5		
6		
7		

Zoller, Najjar & Shroyer, Inc.  
 Engineers, Planners, Surveyors & Landscape Architects

201 5th Avenue Drive East  
 Post Office Box 9448  
 Bradenton, Florida 33506  
 Telephone (813) 748-8880

DESIGNED M.H. CHECKED R.B.C. DATE 10/28/87 SCALE 1"=30'  
 DRAWN J.H. COMP. JOB NO. 668-8946 FILE NO. 09810 SHEET 3 OF 3