


SANITARY SEWER AS-BUILTS NEPTUNE AVENUE		
ITEM	STATION	OFFSET
5. SAN. SERVICE LT.	05+69.84	29.1' LT.

POTABLE WATER AS-BUILTS NEPTUNE AVENUE		
ITEM	STATION	OFFSET
6. METER BOX LT.	03+87.70	27.6' LT.

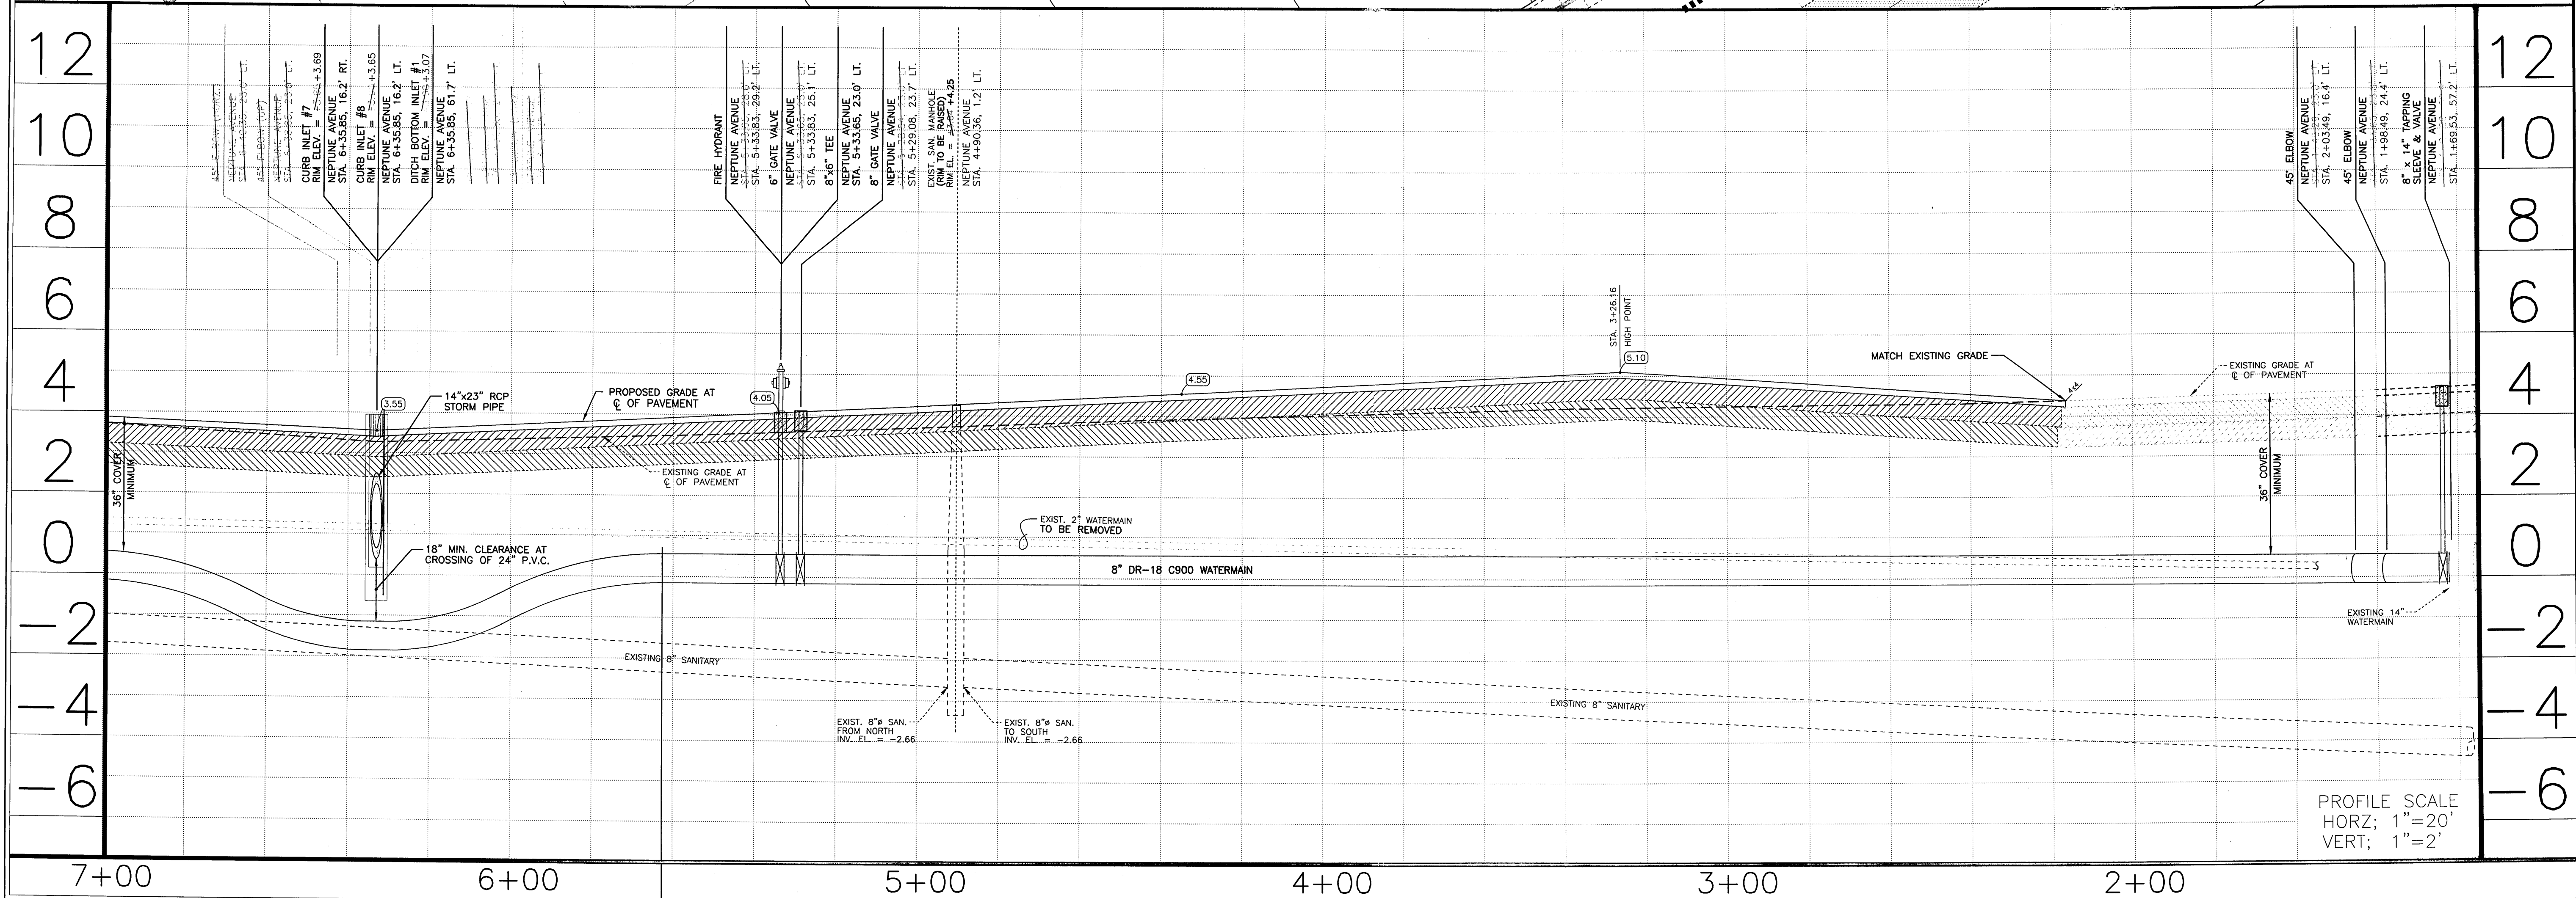

PROFILE SCALE
HORIZ; 1"=20'
VERT; 1"=2'

CYRIX ENGINEERING, INC.
Engineers & Surveyors
1144 Tallevast Rd., #1111
Sarasota, Fla 34243

(941) 358-8812 (ph) * (941) 358-8909 (fax)

PROJECT NO.	03-200	DRAWN BY	2006
CHECKED BY	2006	DATE	5-JUNE-2006
REVISIONS		DATE	BY
1. CHANGE PER PLAN & PROFILE LAYOUT		28-JUL-01	2006
2. CHANGE PER PLAN & PROFILE LAYOUT		01-MAY-03	2006

SEAL:

J. Mary Privette PE, Fl. Reg.# 43394
MAY 01 2008

**COQUINA BEACH
SUBDIVISION**

PLAN & PROFILE
NEPTUNE AVENUE
STA. 1+15.00
TO
STA. 7+00.00

SHEET
15
OF 16