




DITCH BOTTOM INLET #16 (MODIFIED TYPE "E" STRUCTURE)
SCALE: N.T.S.

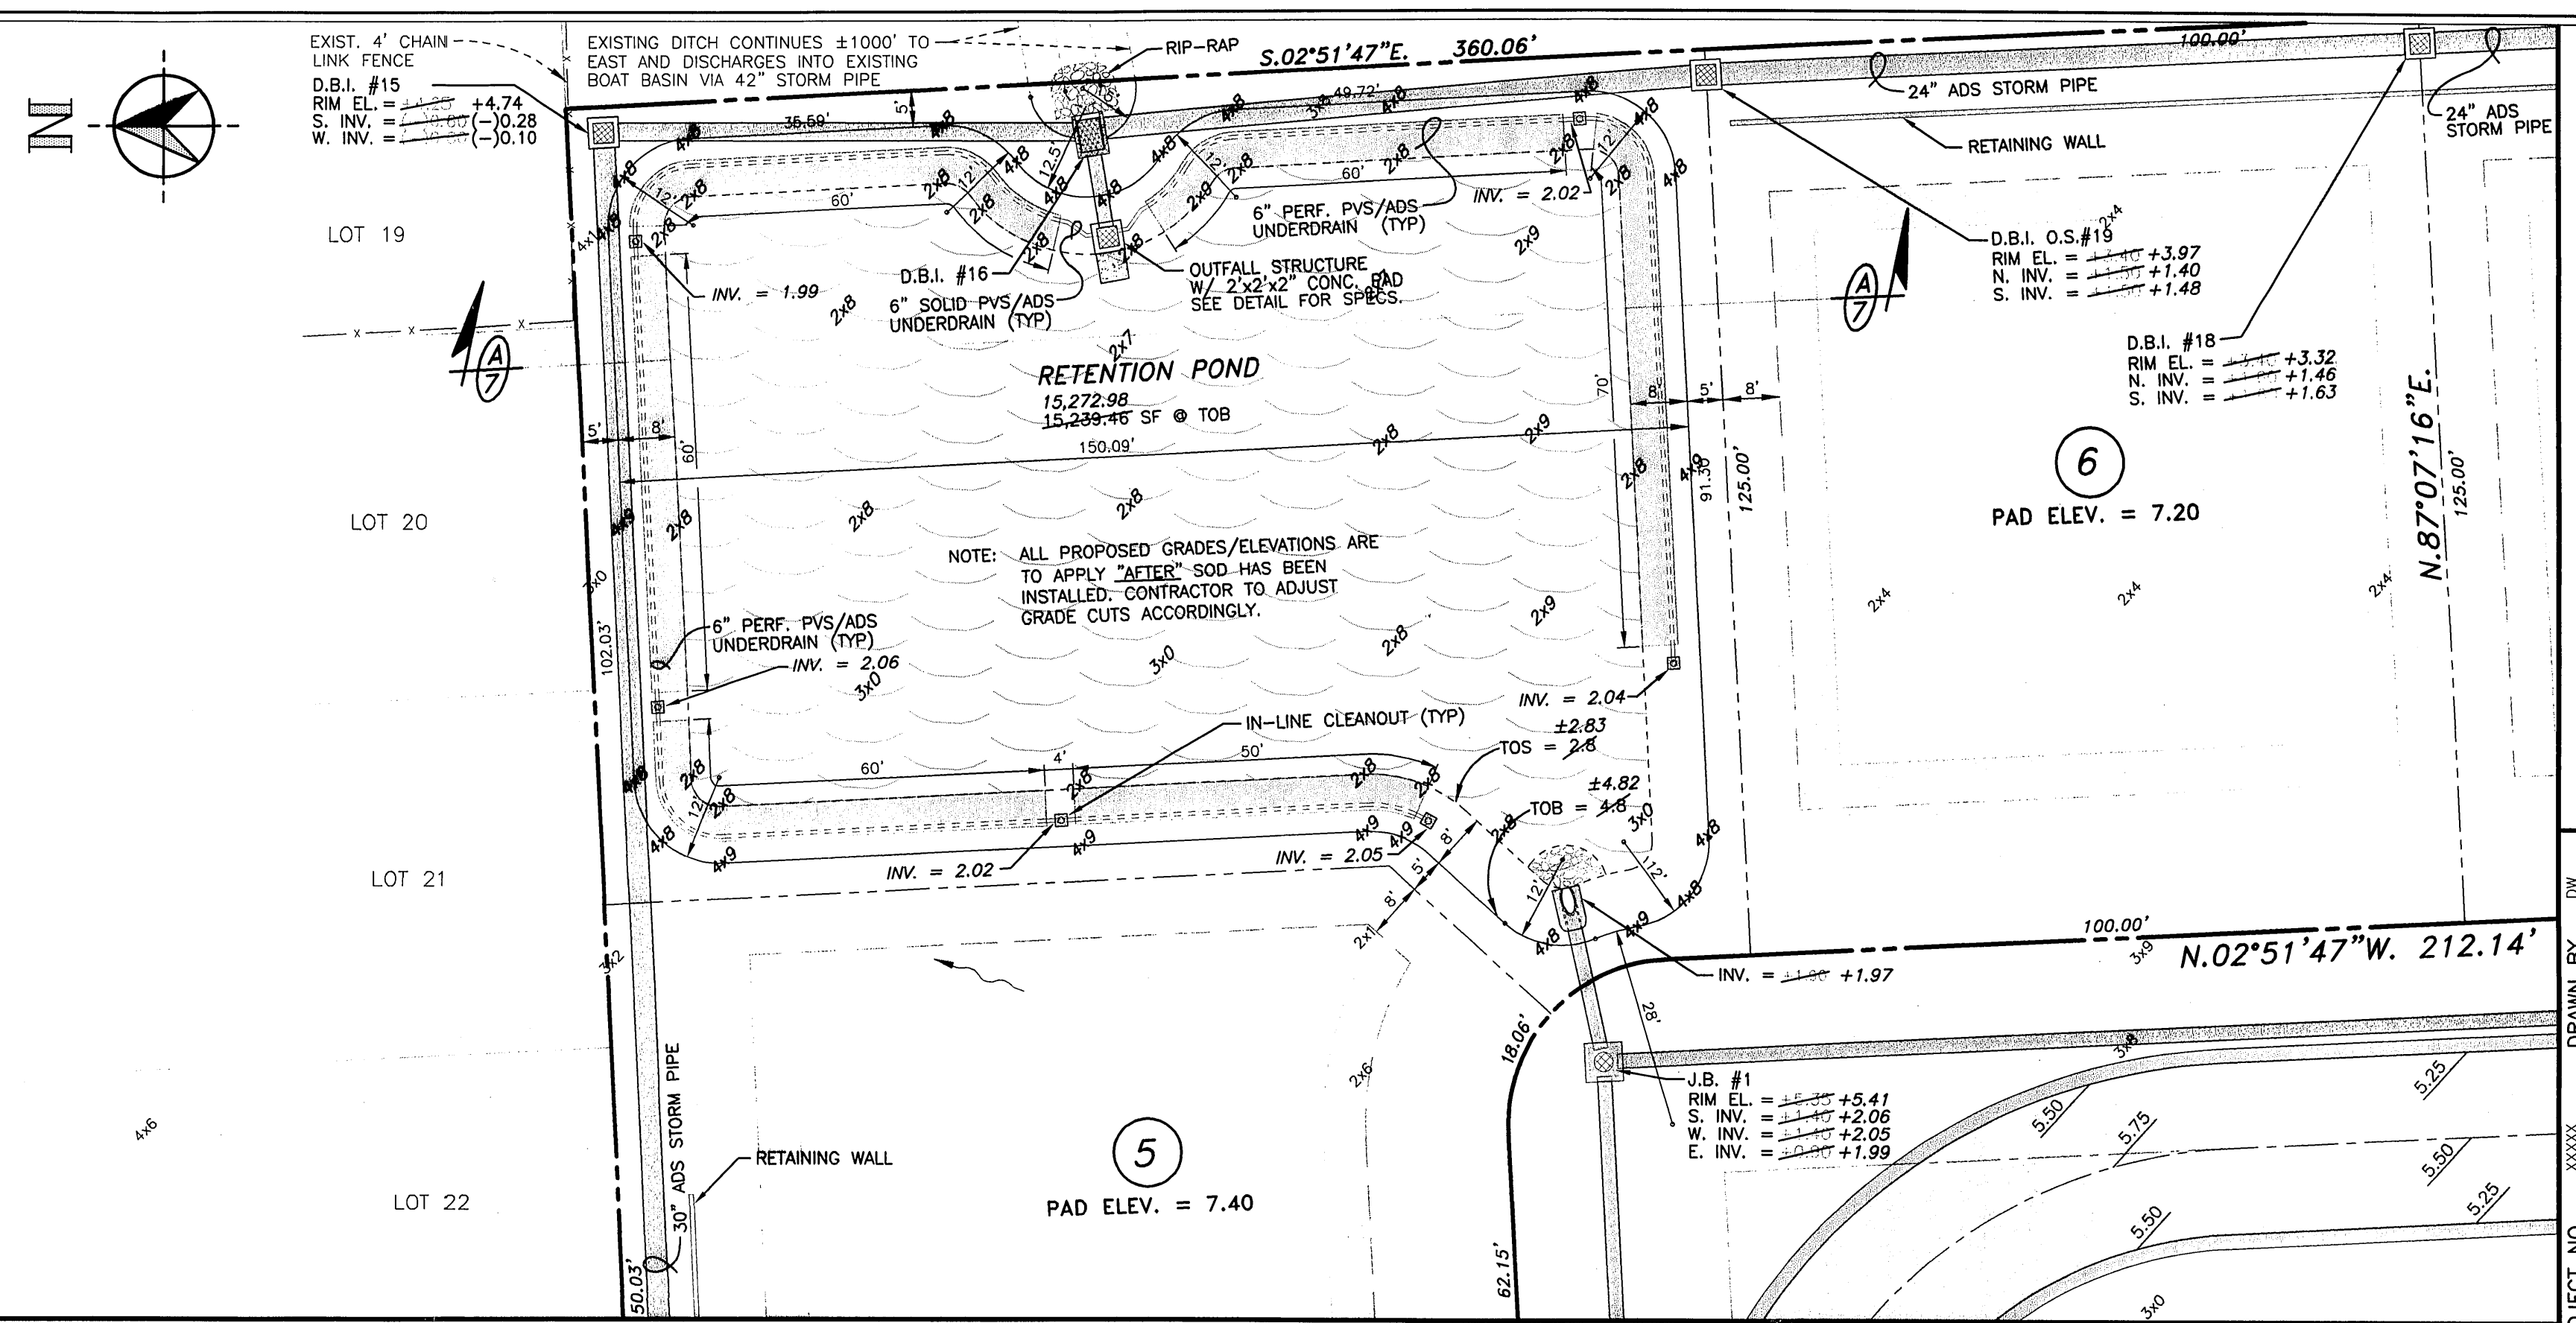


DRY RETENTION POND PLAN
SCALE: 2:1
SCALE: 1"=20'

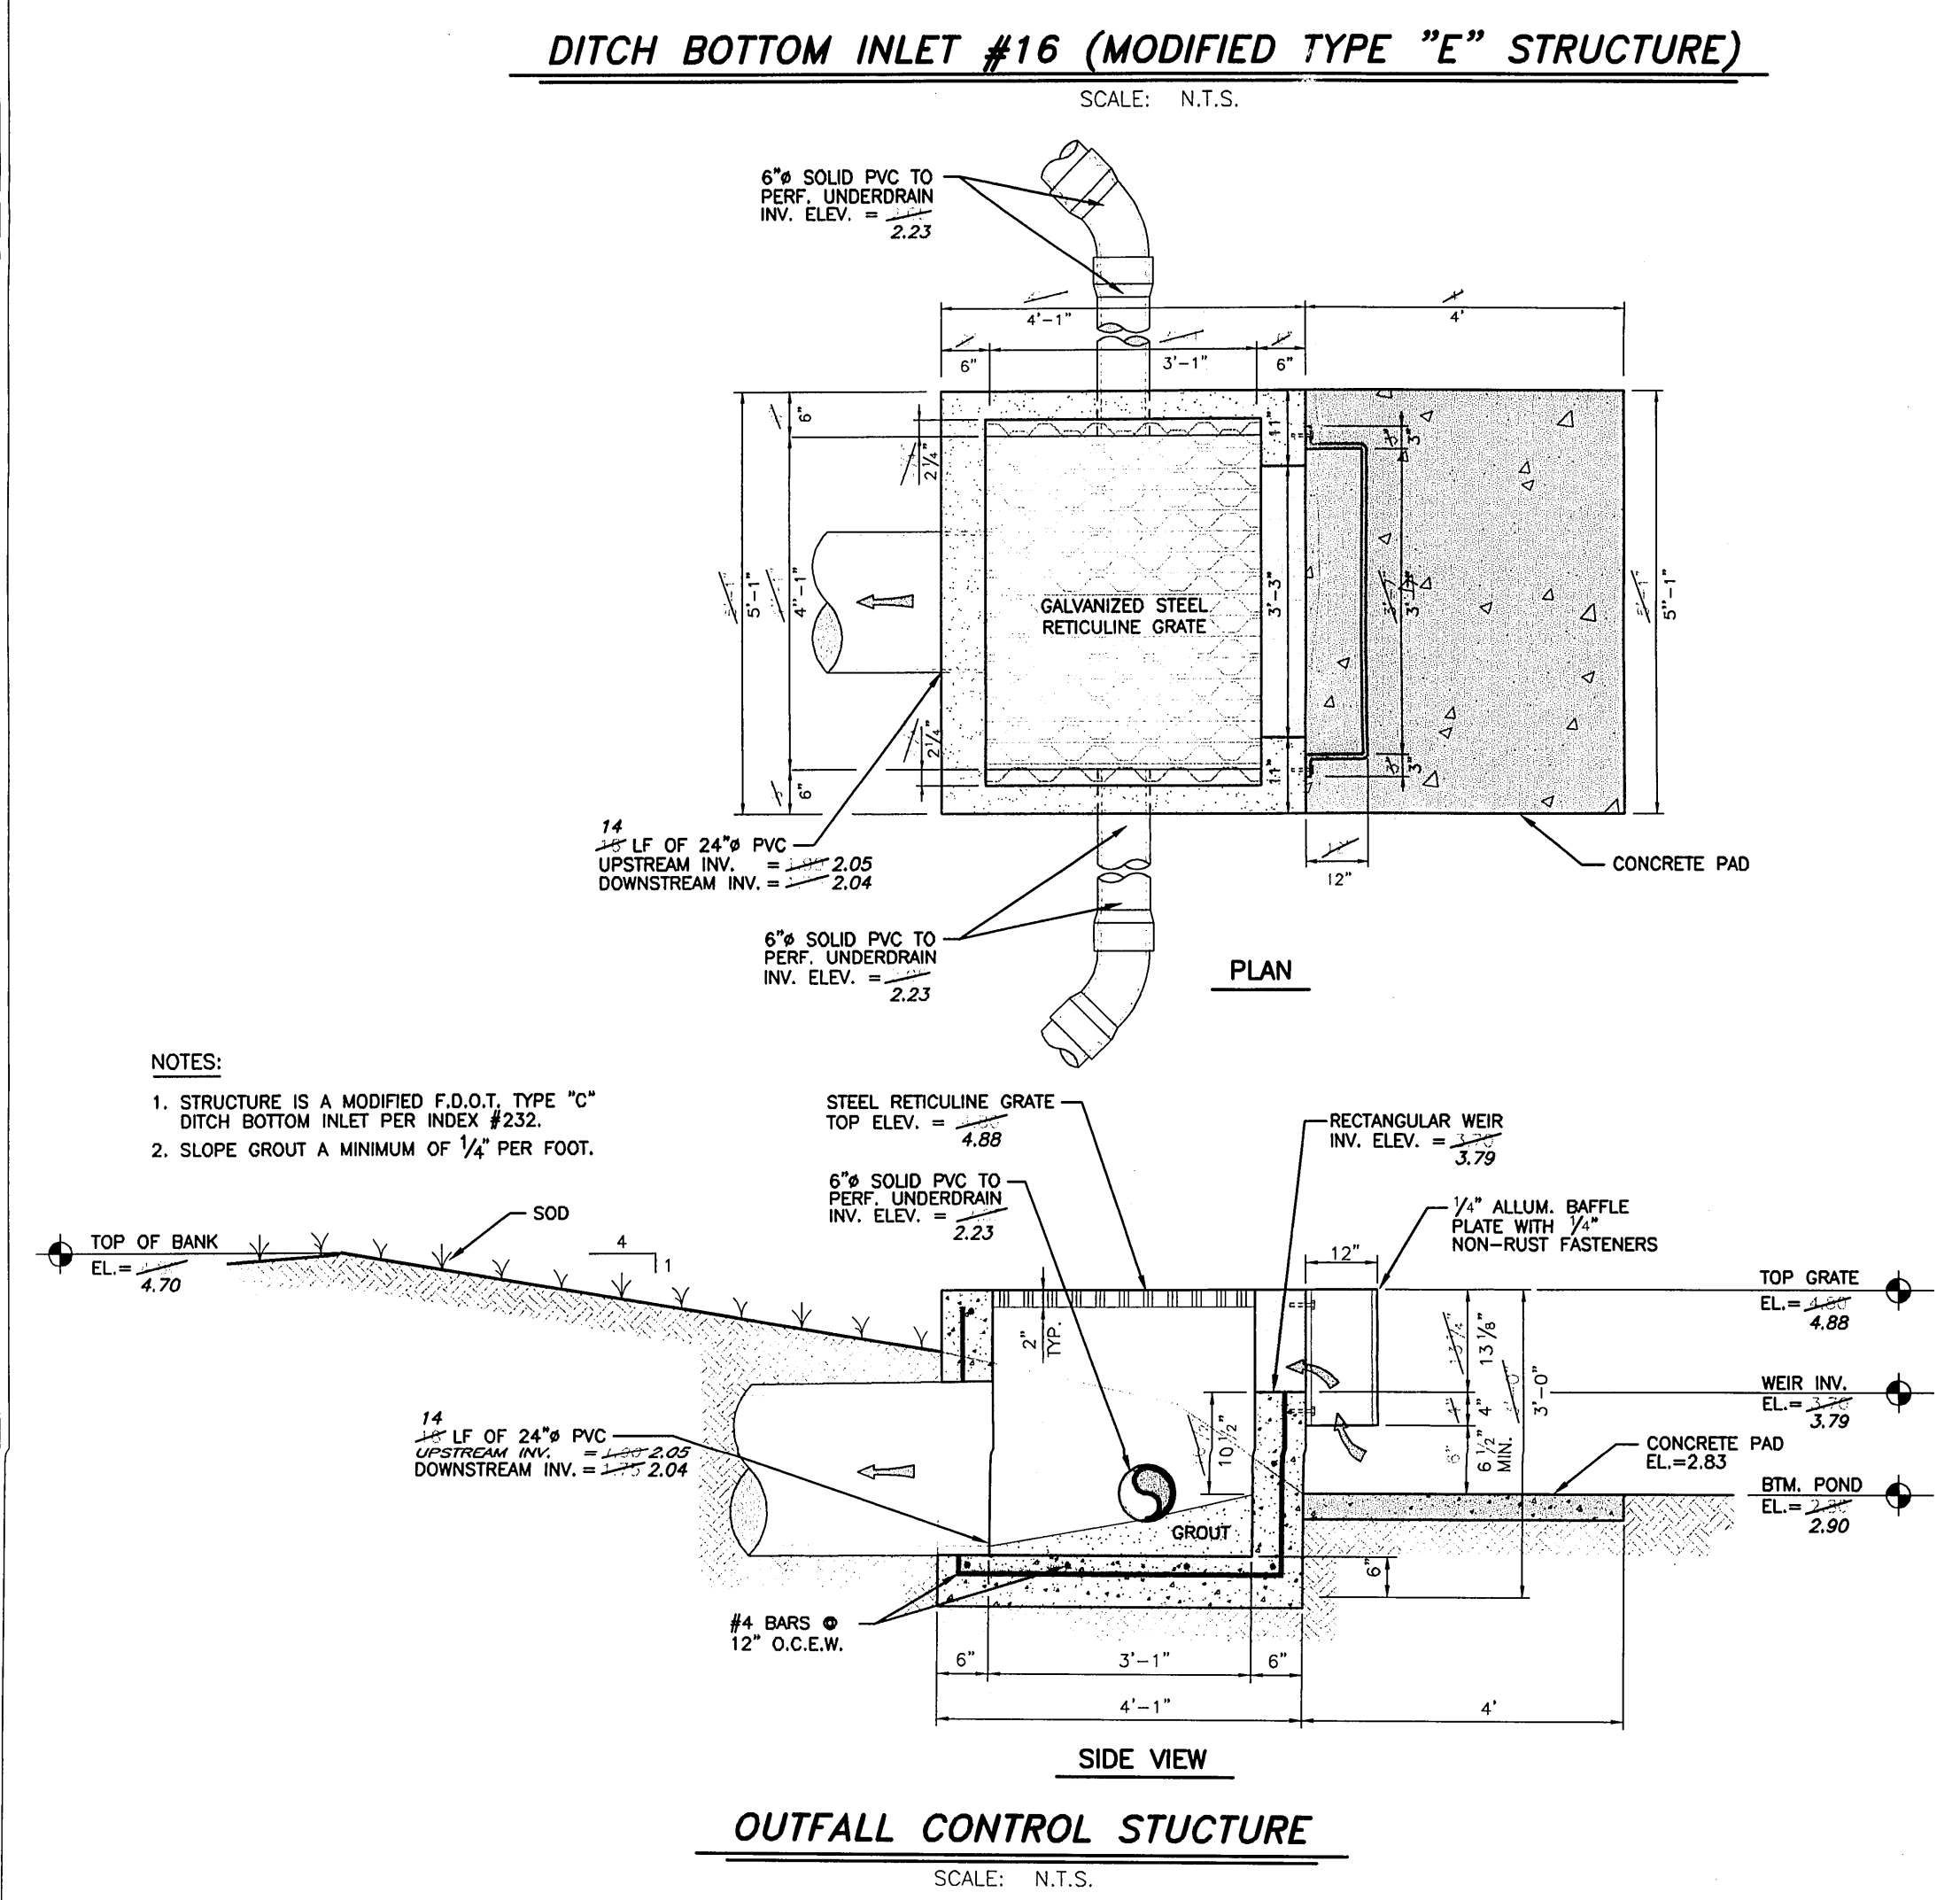


OUTFALL CONTROL STRUCTURE
SCALE: N.T.S.

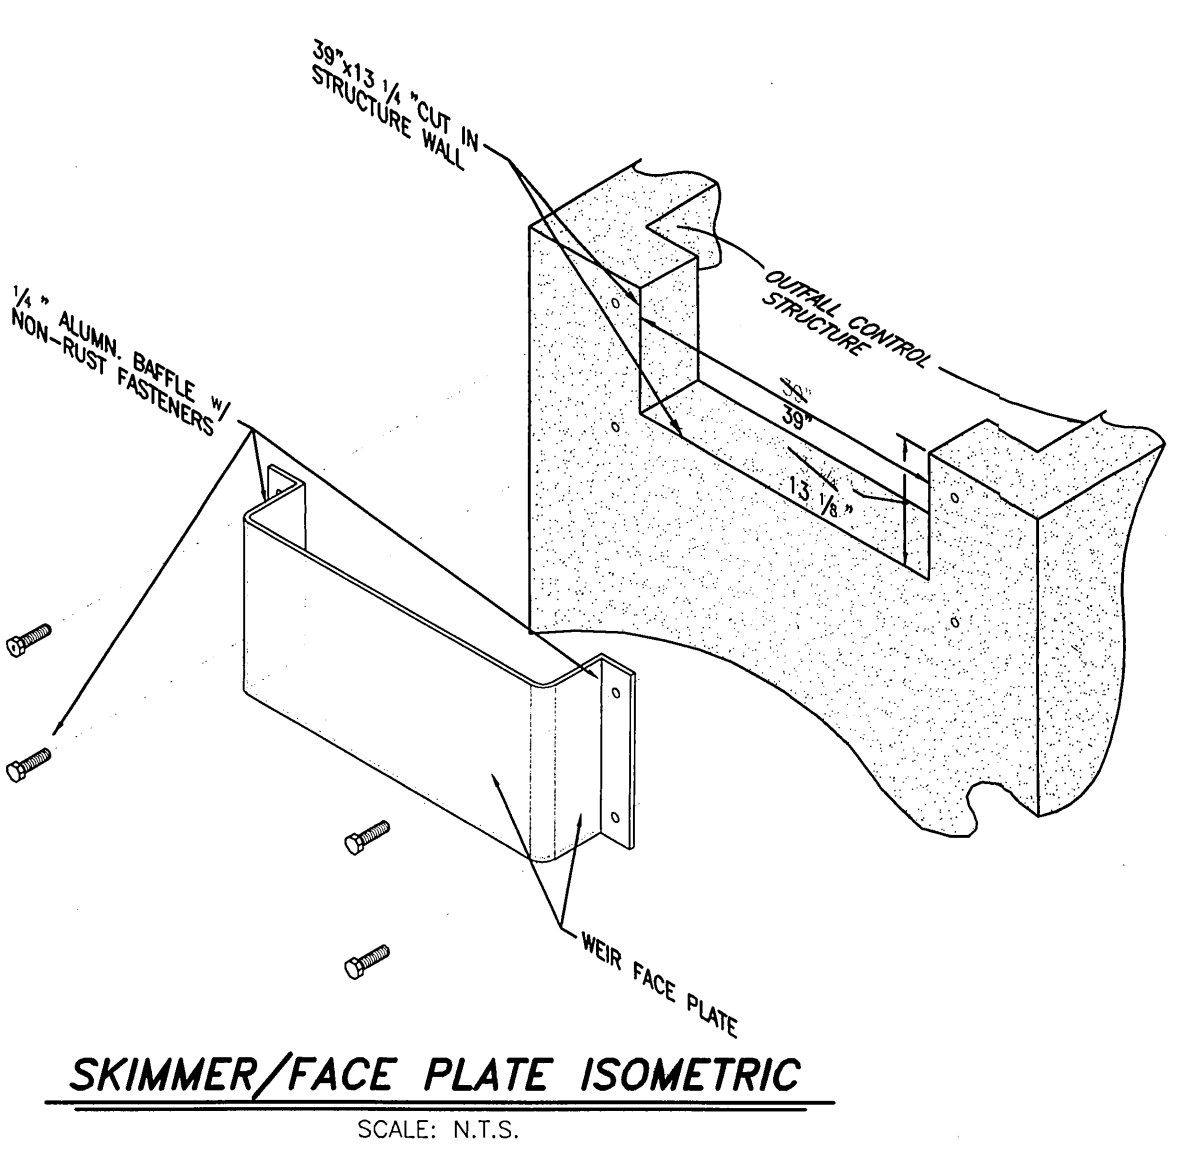


SKIMMER/FACE PLATE ISOMETRIC
SCALE: N.T.S.

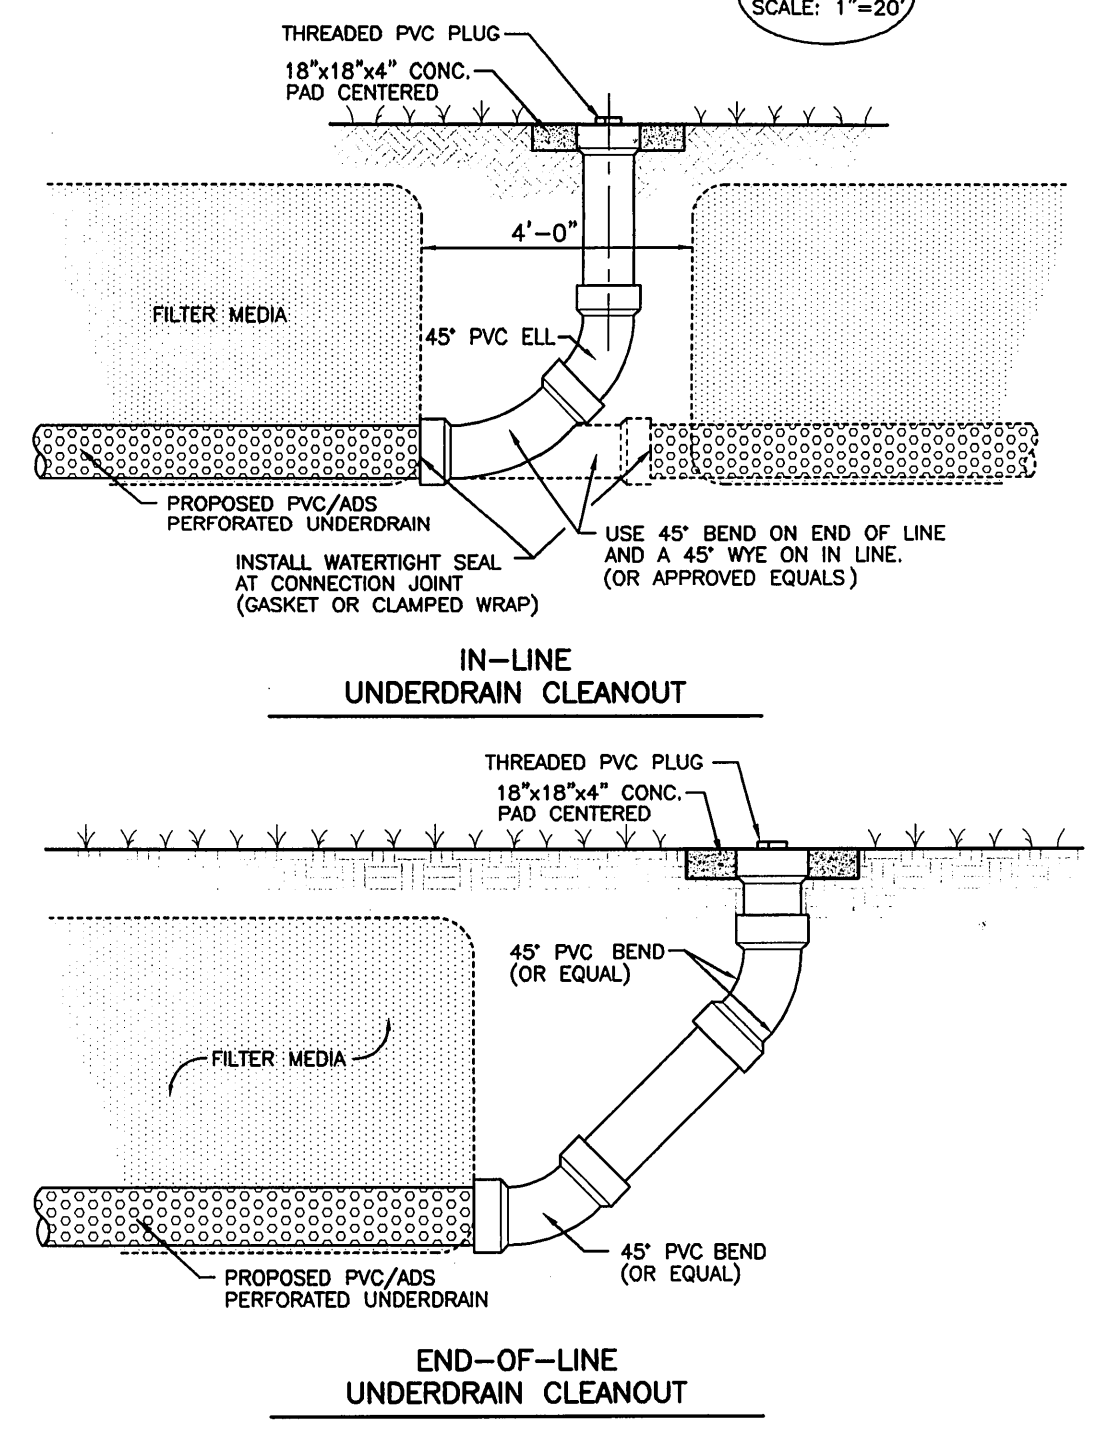

SIDEBANK FILTER DETAIL
SCALE: N.T.S.

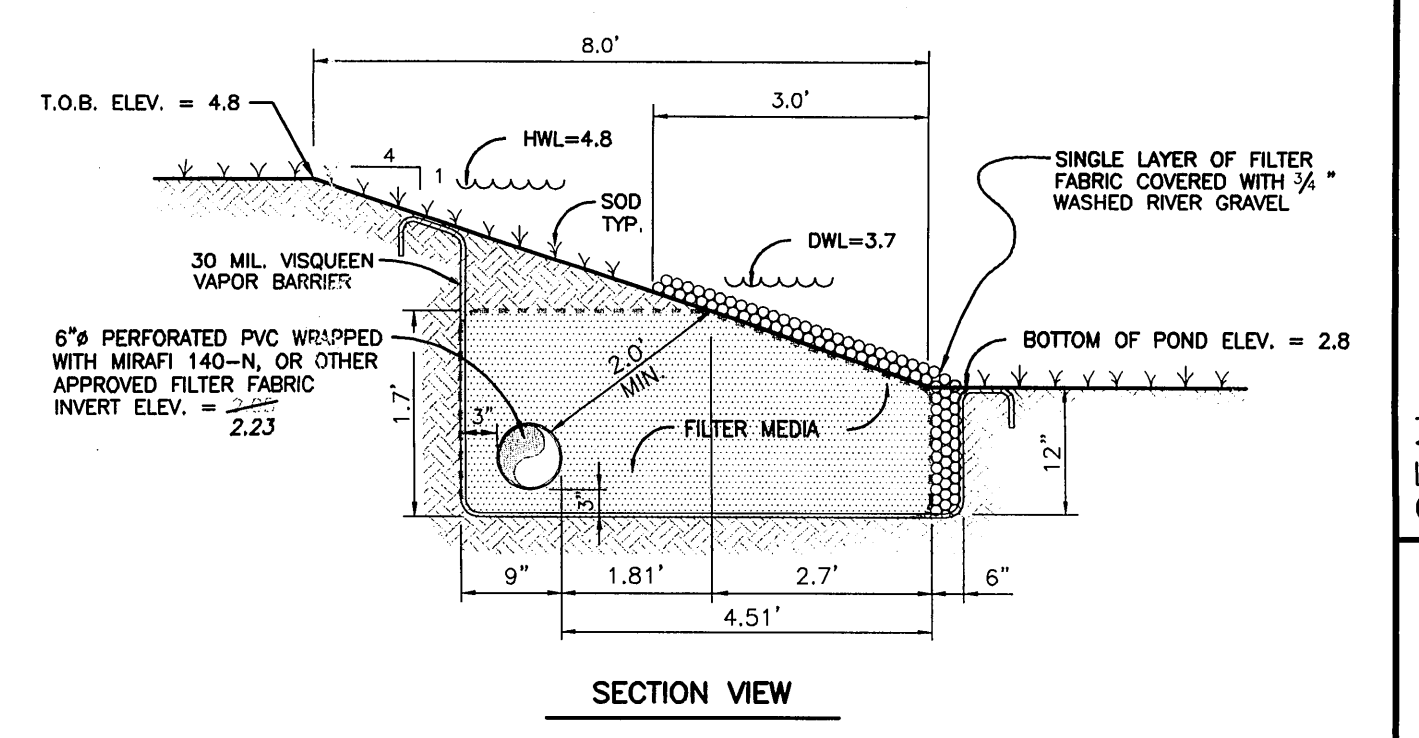

- NOTES:**
- CONTRACTOR TO ENSURE SEAMS OF VISQUEEN BARRIER ARE INSTALLED AS PER MANUFACTURERS SPECIFICATIONS, IN ORDER TO MAINTAIN WATER TIGHTNESS OF BARRIER.
 - CONTRACTOR SHALL SUPPLY THE ENGINEER OF RECORD WITH A CONDUCTIVITY ANALYSIS OF THE FILTER MATERIAL DELIVERED TO THE SITE PRIOR TO CONSTRUCTION OF THE UNDERDRAIN. THE ANALYSIS SHALL BE CERTIFIED BY A PROFESSIONAL SOILS ENGINEER.
 - FILTER MEDIA SHALL BE A FINE GRANULAR MATERIAL WITH A UNIFORMITY COEFFICIENT OF 1.5 OR GREATER, AND AN EFFECTIVE GRAIN SIZE OF 0.075 TO 0.55 MILLIMETERS. NO LUMEROCK OR SHELL MATERIAL SHALL BE USED AS FILTER MEDIA. FILTER MEDIA SHALL HAVE A MINIMUM HYDRAULIC CONDUCTIVITY OF 5.42 FT/HR.

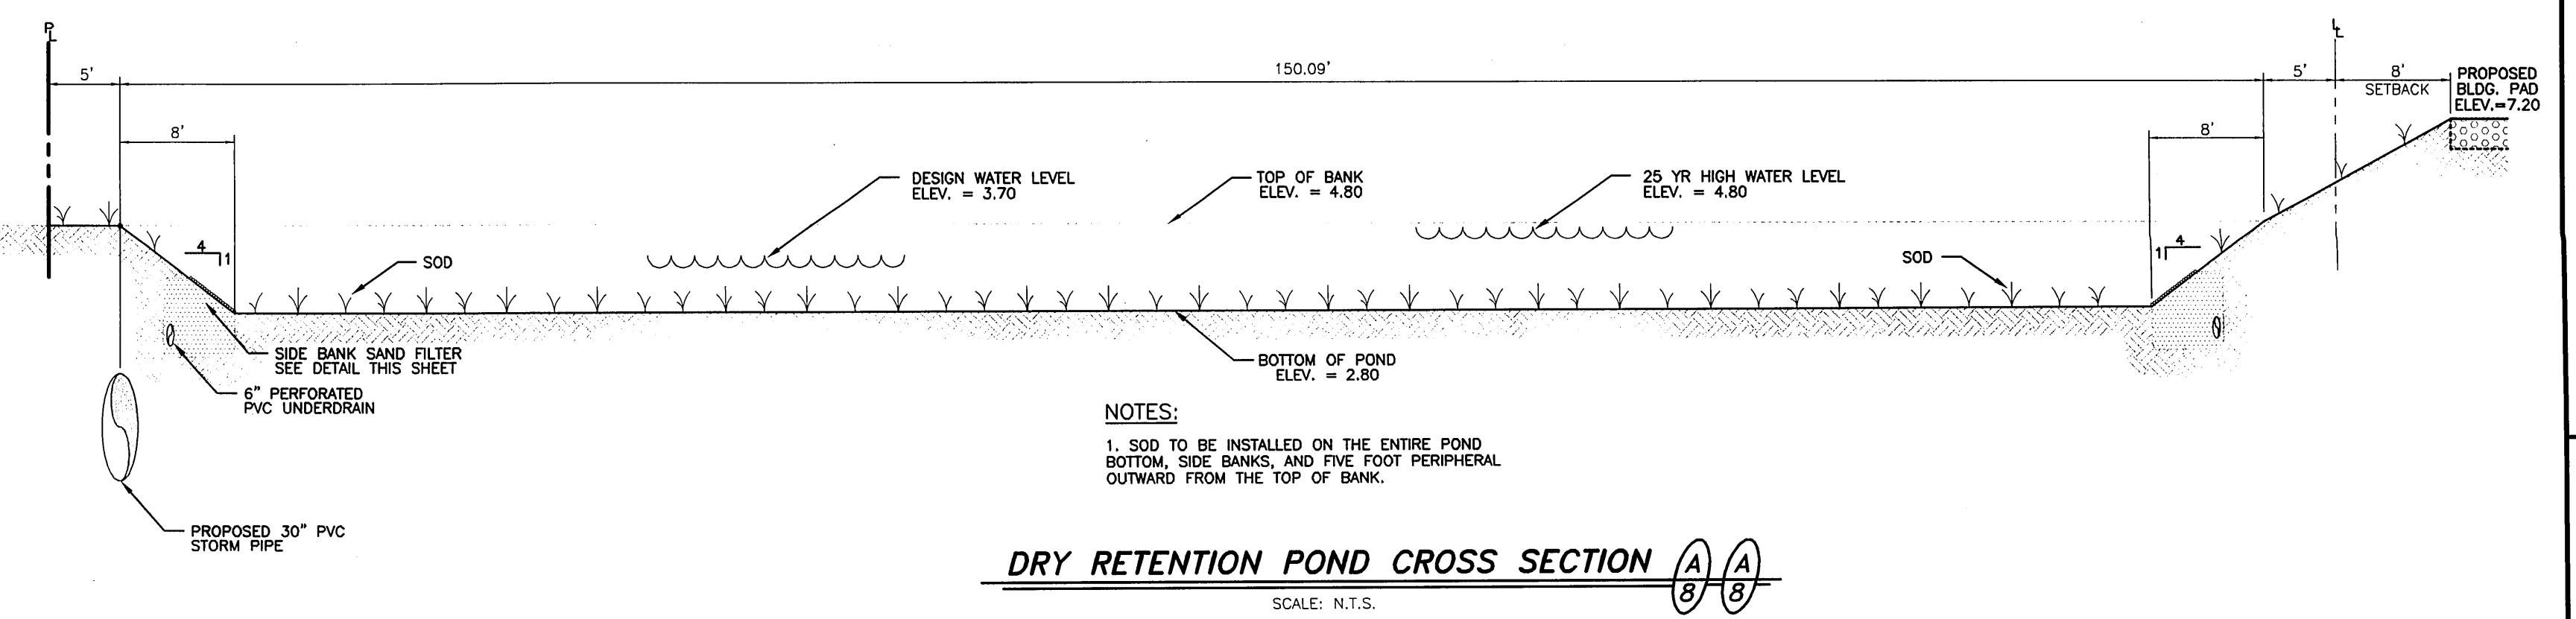

DRY RETENTION POND CROSS SECTION (A-A)
SCALE: N.T.S.

CYRIX ENGINEERING, INC.
Engineers & Surveyors
1144 Tallevast Rd., #1111
Sarasota, Fla 34243
(941) 358-8812 (ph) * (941) 358-8909 (fax)

PROJECT NO.	DATE	BY
XXXXX	12 APR 2004	
J.M.P.		
REVISIONS		

SEAL
J. Mark Privette PE, FL. Reg # 43394
MAY 19 2004

COQUINA BEACH SUBDIVISION

POND LAYOUT AND DETAILS

SHEET
8
OF 16