


GULF OF MEXICO


MEAN HIGH WATER LINE  
SEPT. 25, 1972  
1.46' ABOVE M.S.L.

CONC. PIER

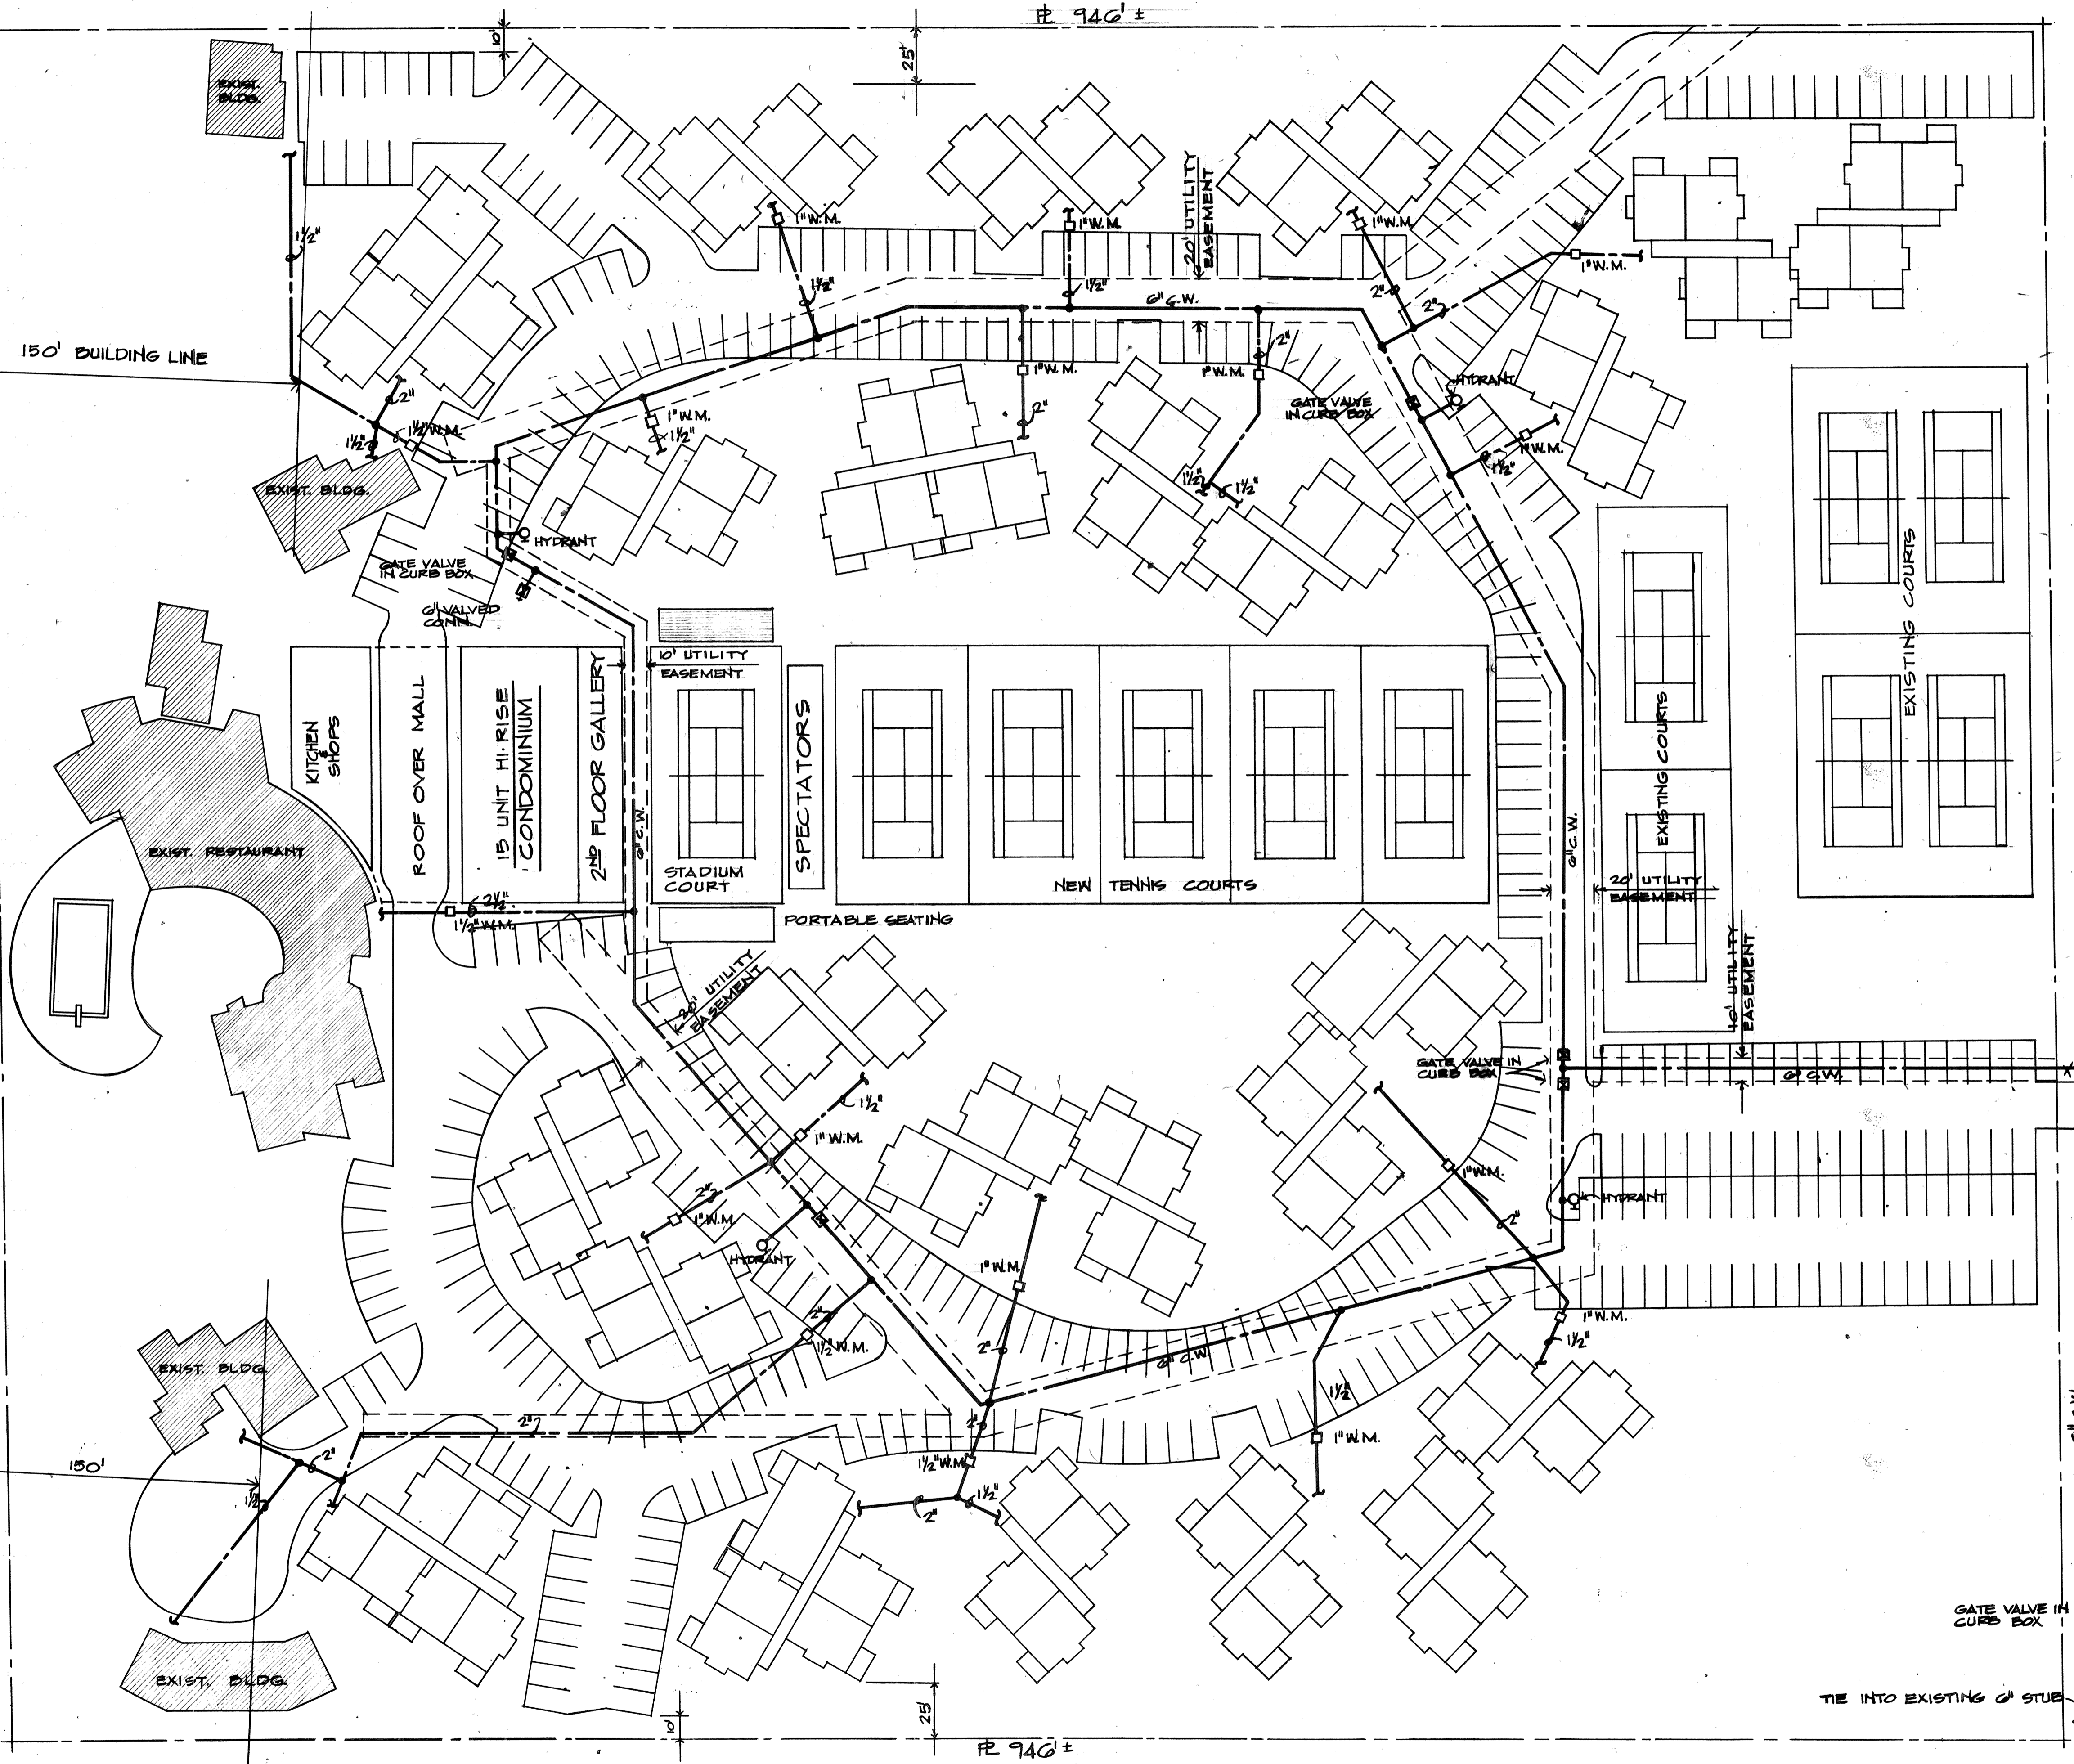

**SITE PLAN**  
SHOWING "AS BUILT" WATER DISTRIBUTION SYSTEM

JOHN RINGLING PARKWAY (STATE ROAD 70)

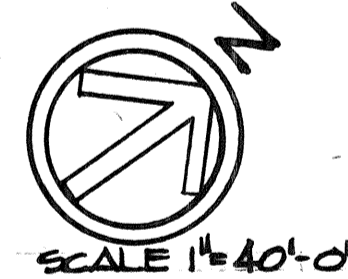

**LEGEND**

W.M. WATER METER  
C.W. CITY WATER

(DISCONTINUED)

DETAIL OF CONNECTION  
TO WATER SYSTEM

TIE INTO EXISTING 6" STUB

PROJECT ENGINEER D.E. BRITTS ASSOC. INC. 1632 N. FEDERAL HWY. FT. LAUDERDALE, FLA. FLA. REG. NO. 4795 FILE # 6217	DESIGNED BY	DATE:	SCALE:	REVISION	L.T.R.	DATE
	CHECKED BY					
	DRAWN BY					
<b>TOWN OF LONGBOAT KEY, FLORIDA</b> <b>COLONY BEACH &amp; TENNIS CLUB</b> <b>LONGBOAT KEY SARASOTA FLORIDA</b>						
ENGINEER & LOCATION	SHEET NUMBER		REVISION			
	62-A					

*D.E. Britts*