


GULF OF MEXICO


MEAN HIGH WATER LINE  
SEPT. 28, 1972  
1.40' ABOVE M.S.L.

CONC. PIER

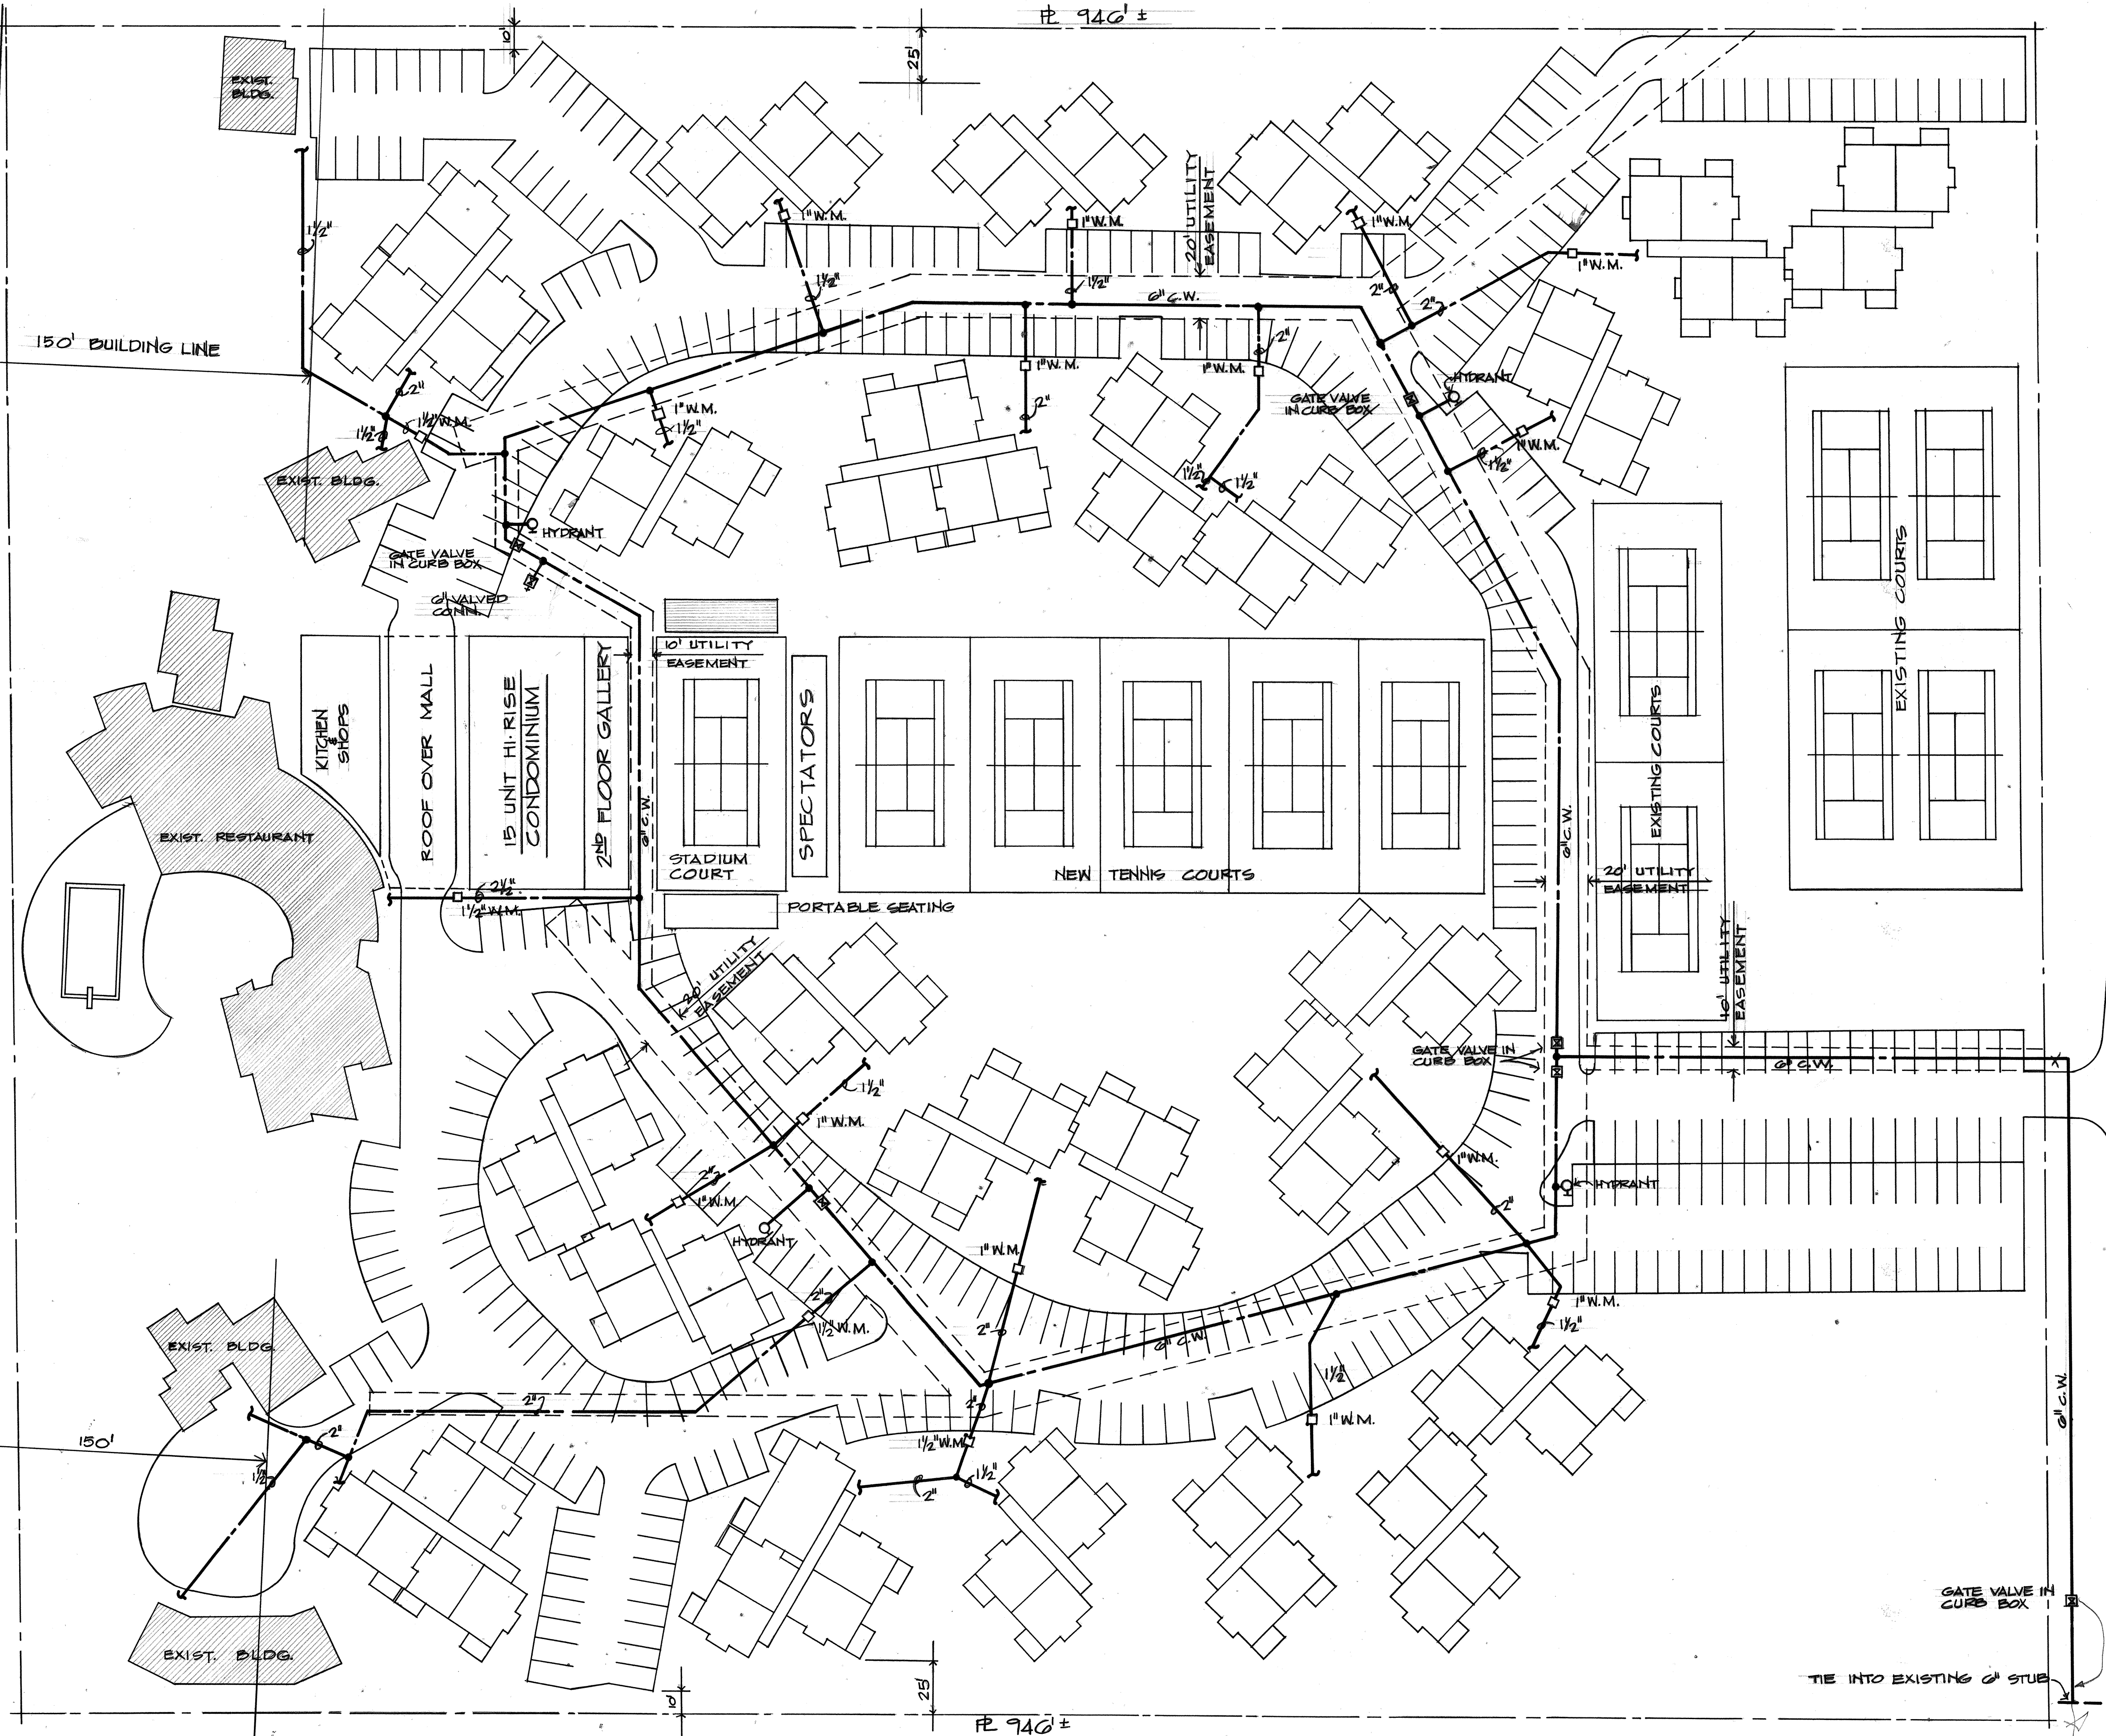


**SITE PLAN**  
SHOWING "AS BUILT" WATER DISTRIBUTION SYSTEM

JOHN RINGLING PARKWAY (STATE ROAD 78A)

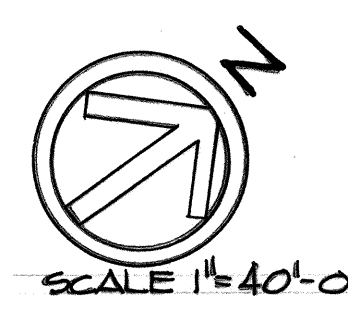

**LEGEND**  
 W.M. WATER METER  
 C.W. CITY WATER

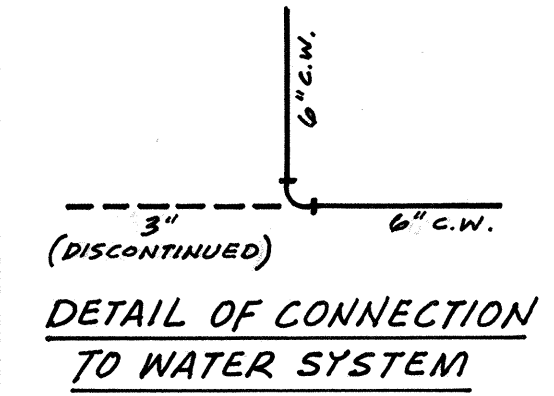

*DE/Brks*

DESIGNED BY		DATE:		SCALE:		BY		REVISION		L.T.R. DATE		PROJECT ENGINEER	
D.E. BRIT ASSOC. INC.												D.E. BRIT ASSOC. INC.	
1428 W. TARPON HWY.												1428 W. TARPON HWY.	
FT. LAUDERDALE, FLA.												FT. LAUDERDALE, FLA.	
												P.L.A. REG. NO. 4795	
												FILE # 6217	
TOWN OF LONGBOAT KEY, FLORIDA												SHEET NUMBER	
COLONY BEACH & TENNIS CLUB												W/S-3	
LONGBOAT KEY SARASOTA FLORIDA												REVISION	
ENGINEER												T.L.K. FILE NO.	
L.S. LOCATION													