
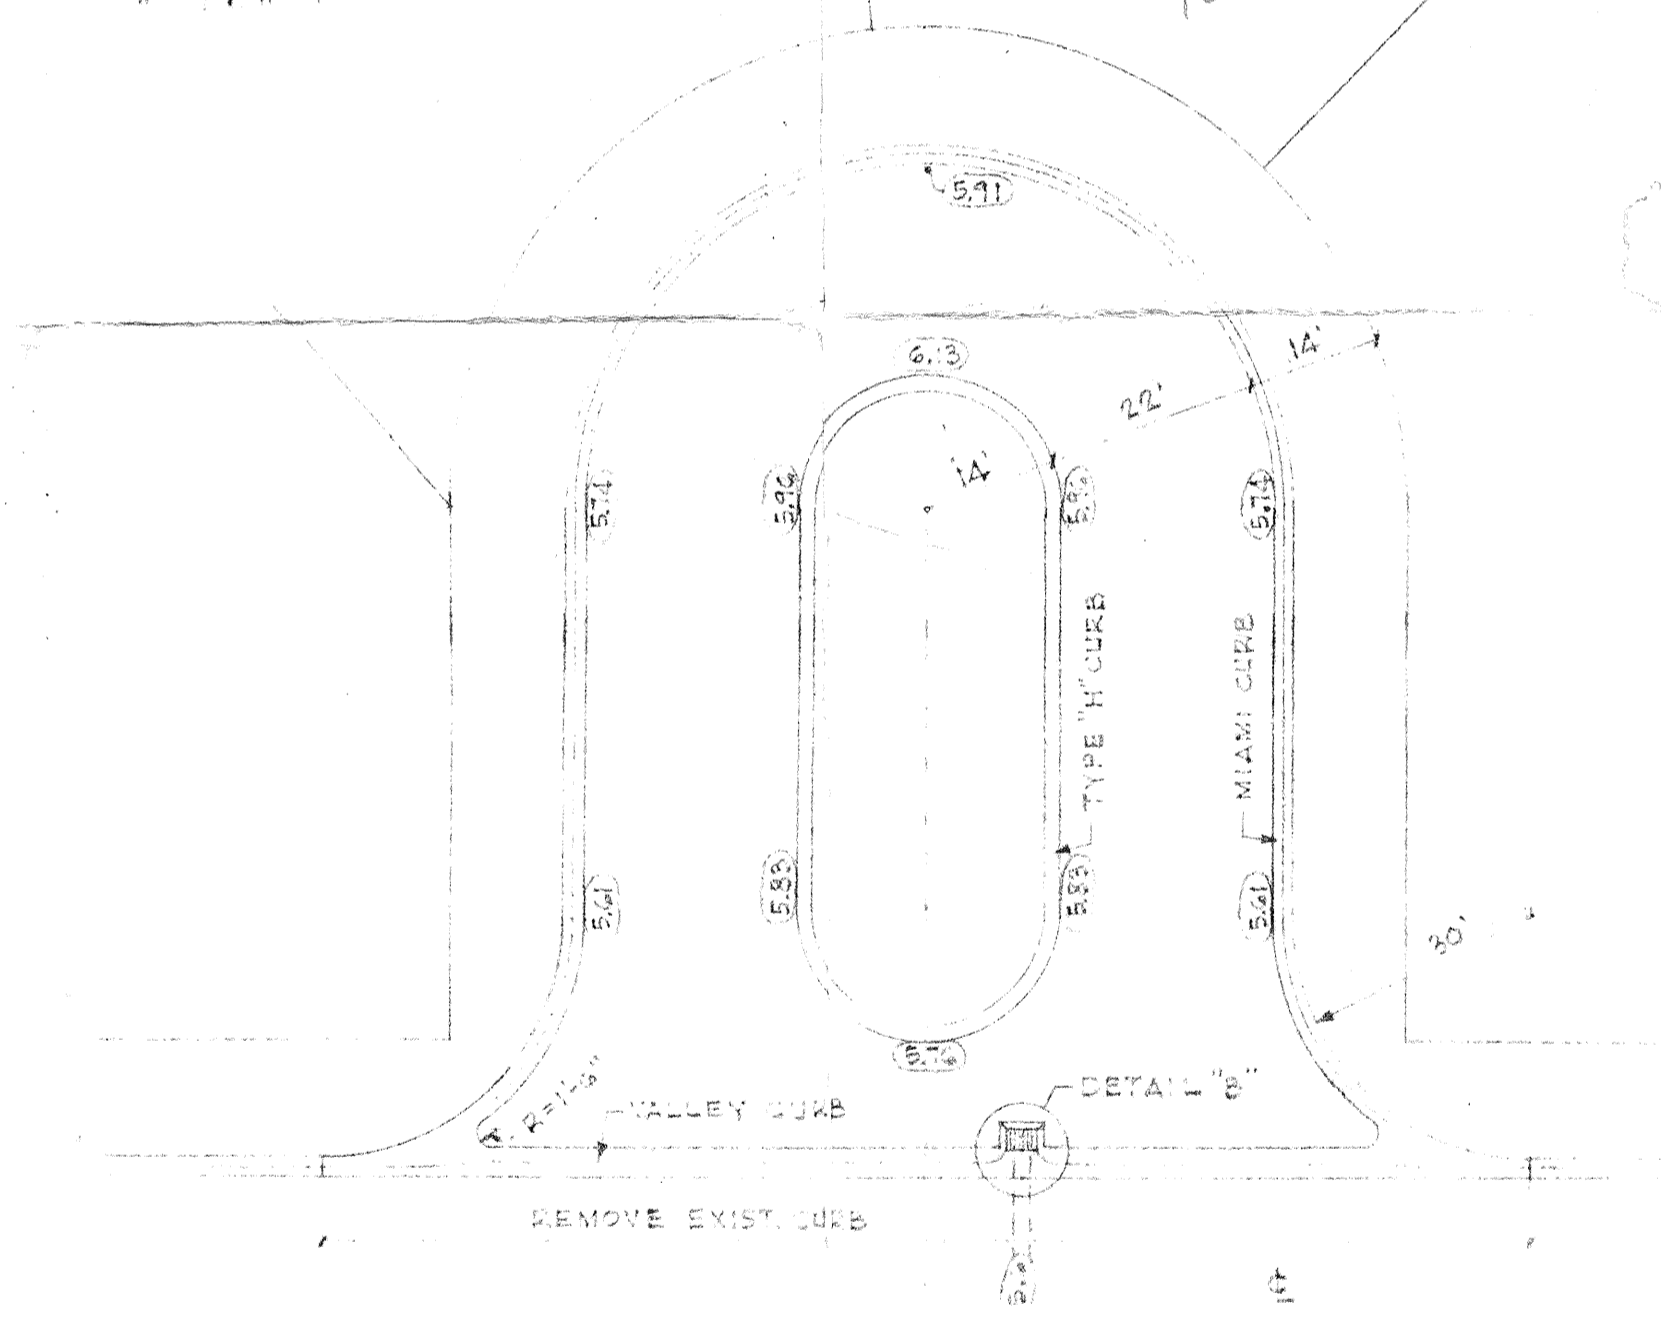
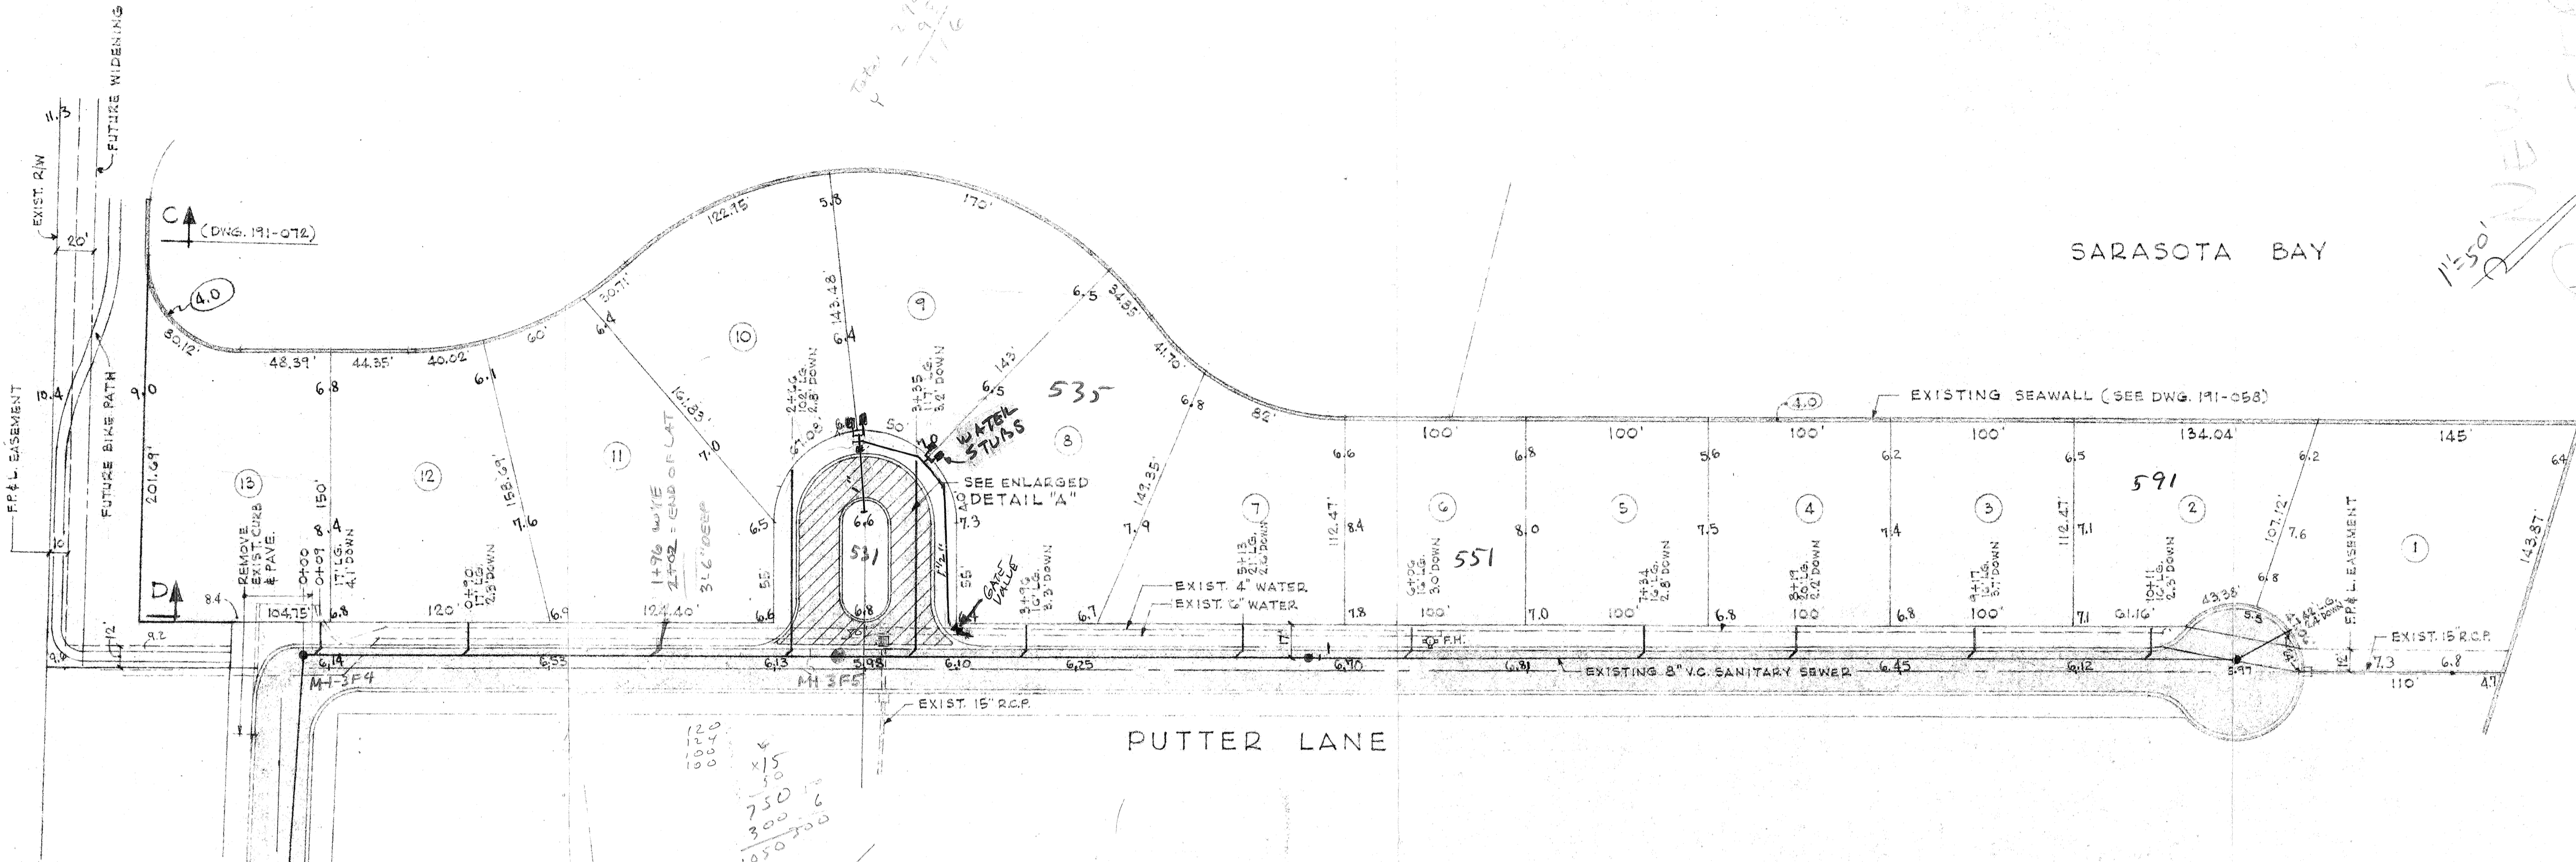



GULF OF MEXICO DRIVE ↑ C

SARASOTA BAY

11'-50" REVISION
REVISION
REVISION

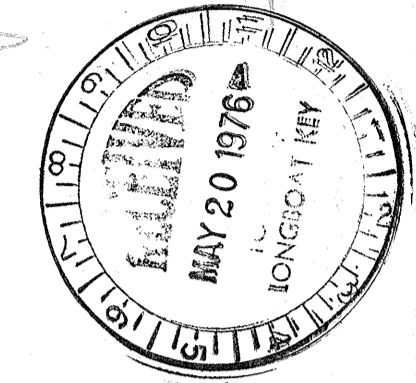


DETAIL "A"
SCALE: 1"=1'-0"

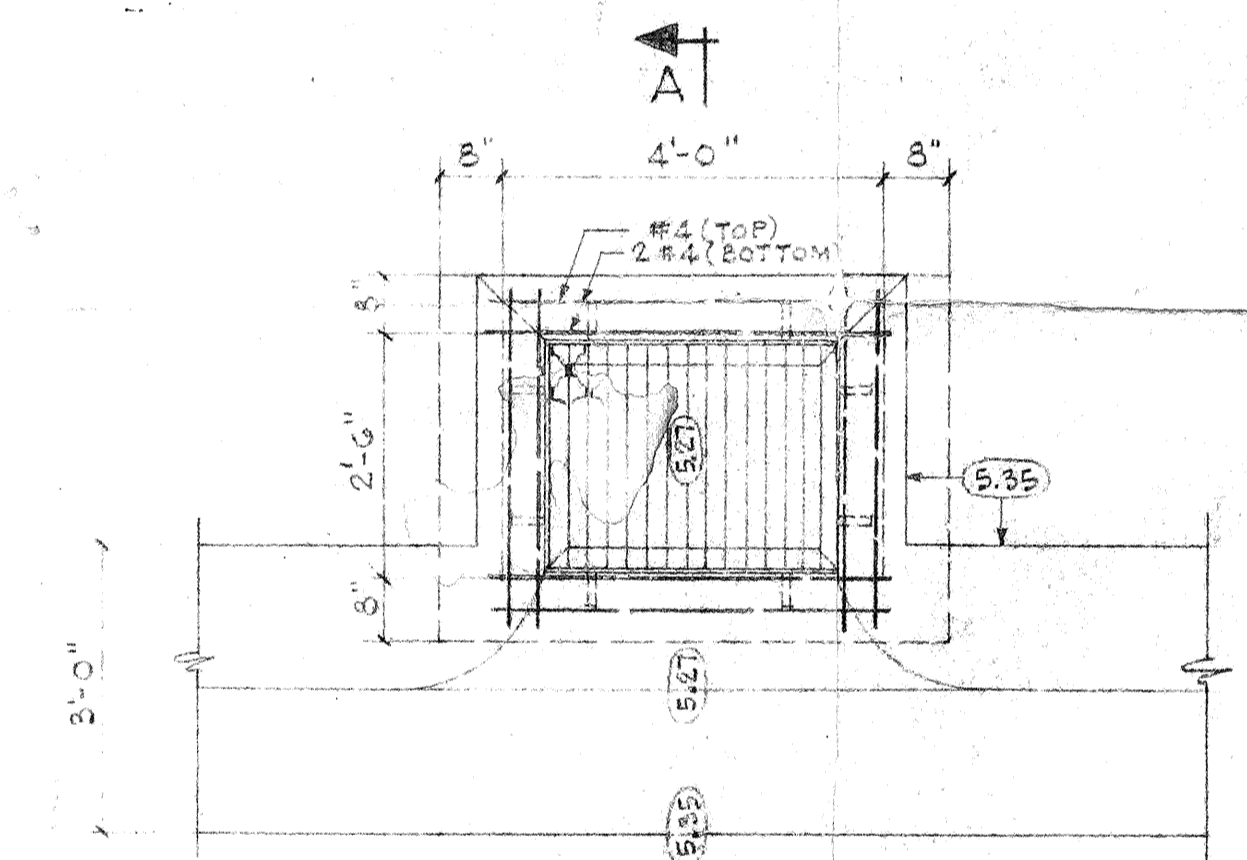


SECTION A-A
SCALE: 1/2"=1'-0"




DETAIL "B"
SCALE: 1/2"=1'-0"

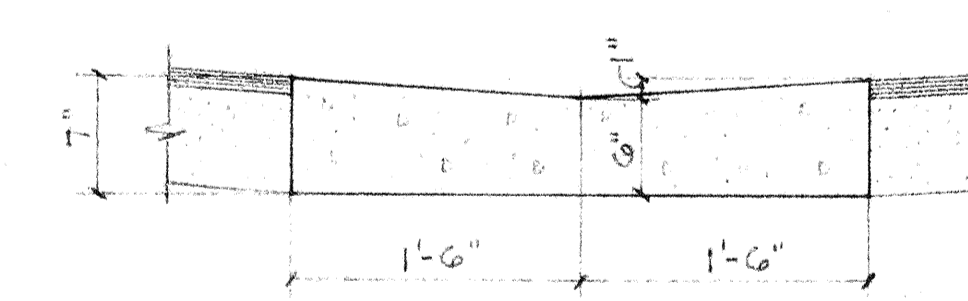

VALLEY CURB
SCALE: 1"=1'-0"

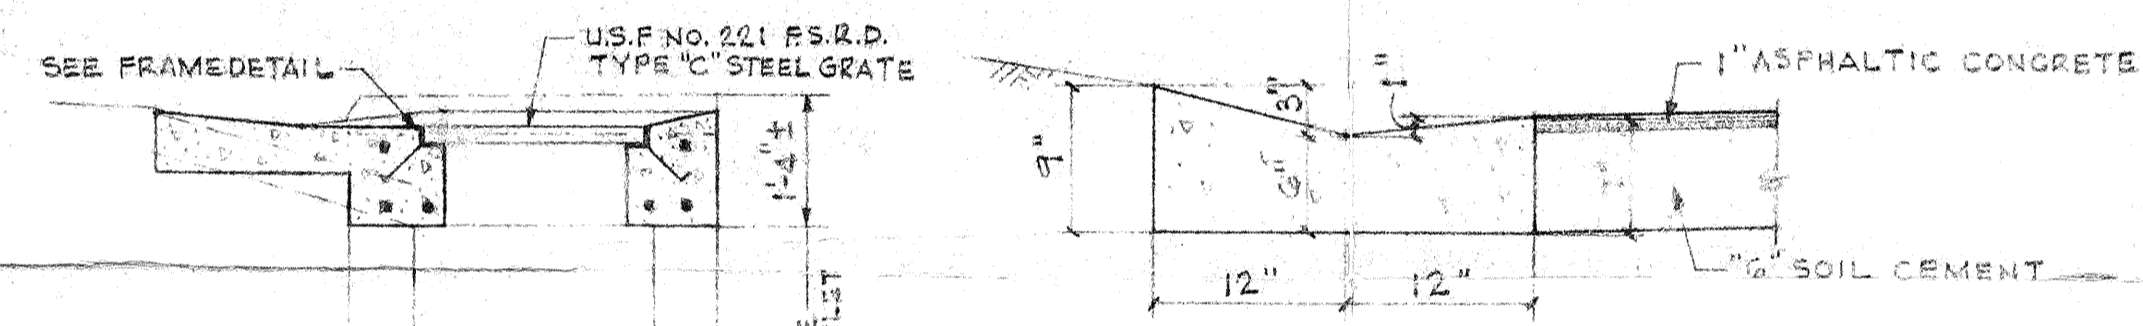

MIAMI CURB
SCALE: 1"=1'-0"

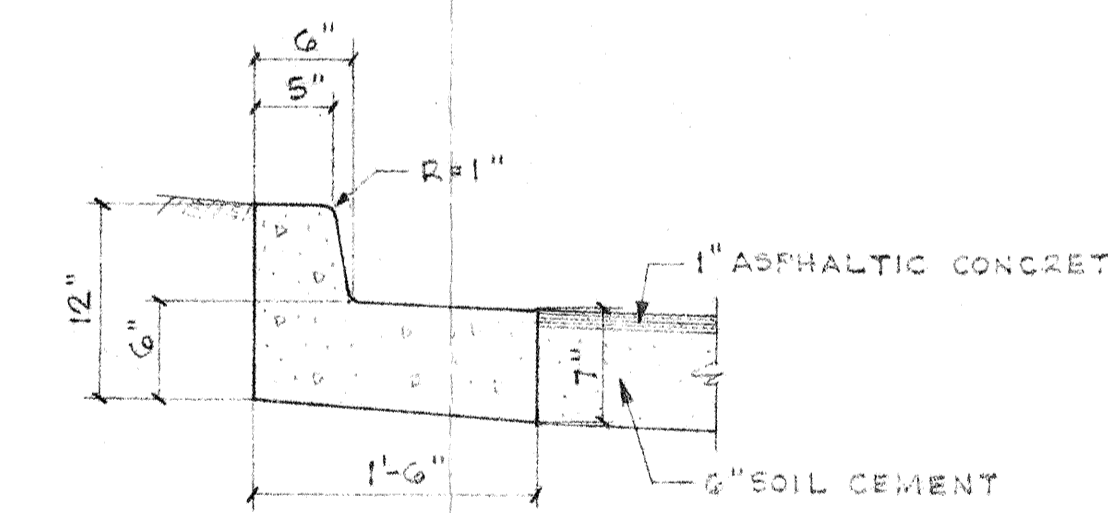

TYPE "H" CURB
SCALE: 1"=1'-0"

LEGEND

	EXISTING PAVEMENT
	PROPOSED PAVEMENT
	EXISTING GRADE
	PROPOSED GRADE

ARVIDA CORPORATION
COUNTRY CLUB SHORES UNIT FIVE, SECTION 4
CONSTRUCTION PLAN

BENNETT & BISHOP
CONSULTING ENGINEERS & SURVEYORS
FLORIDA
SARASOTA

DATE	SCALE	BY	DESCRIPTION
8-1-75	AS BUILT	S.L.B.	
1-15-76	REVISION	S.L.B.	
5-20-78	REVISION	S.L.B.	

1000