
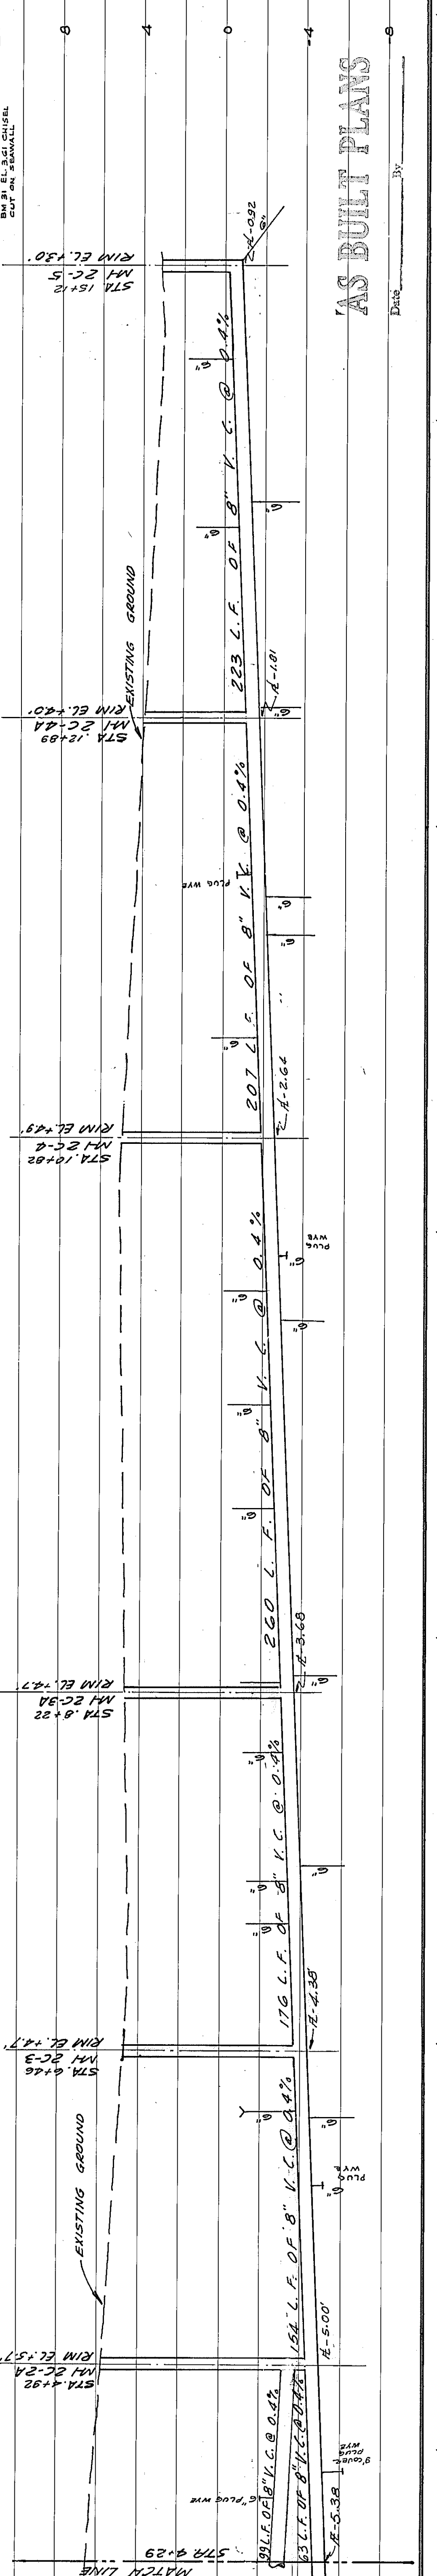
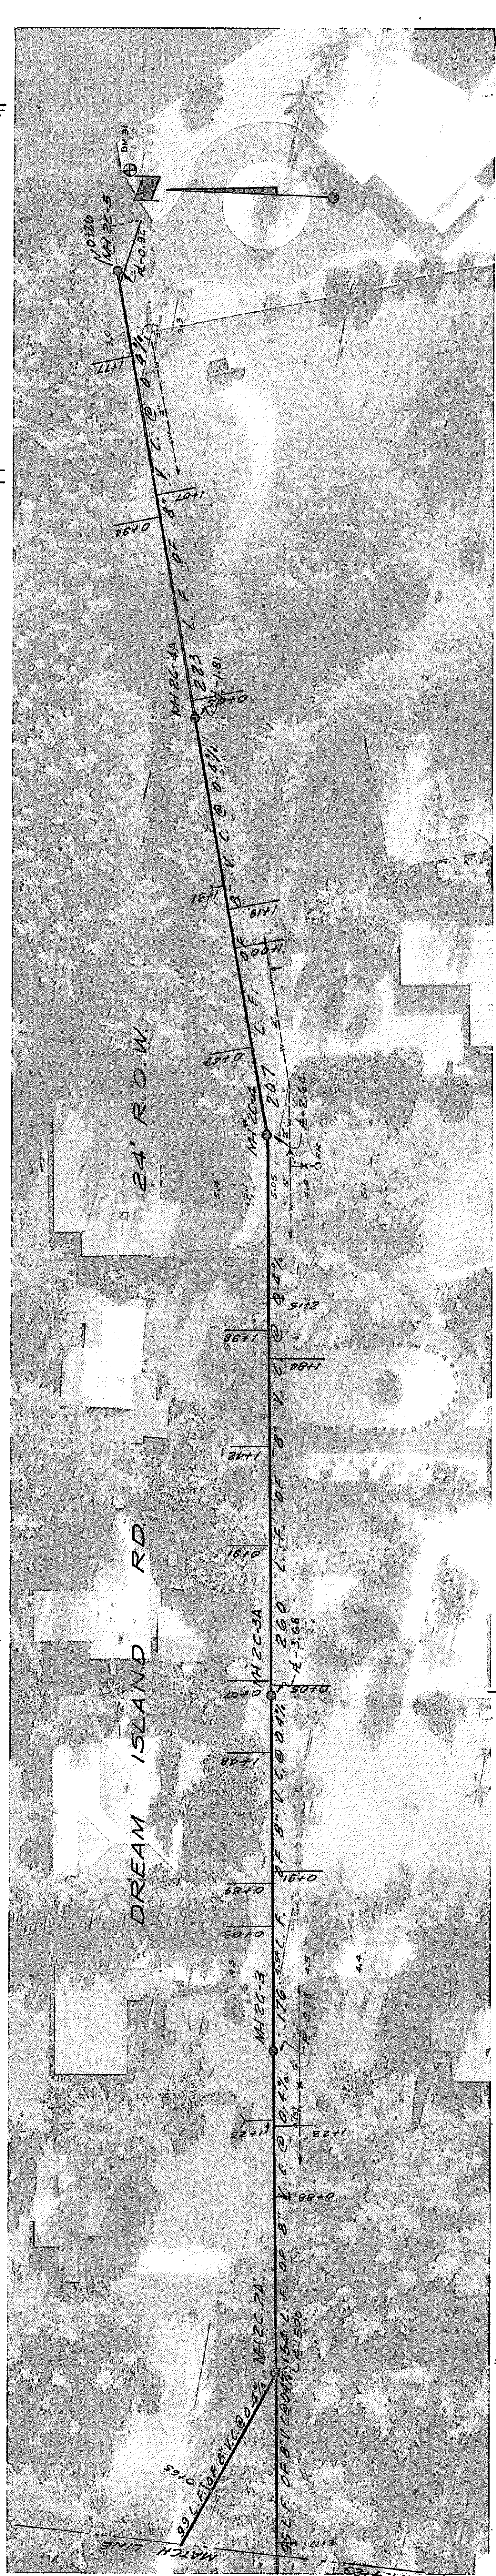
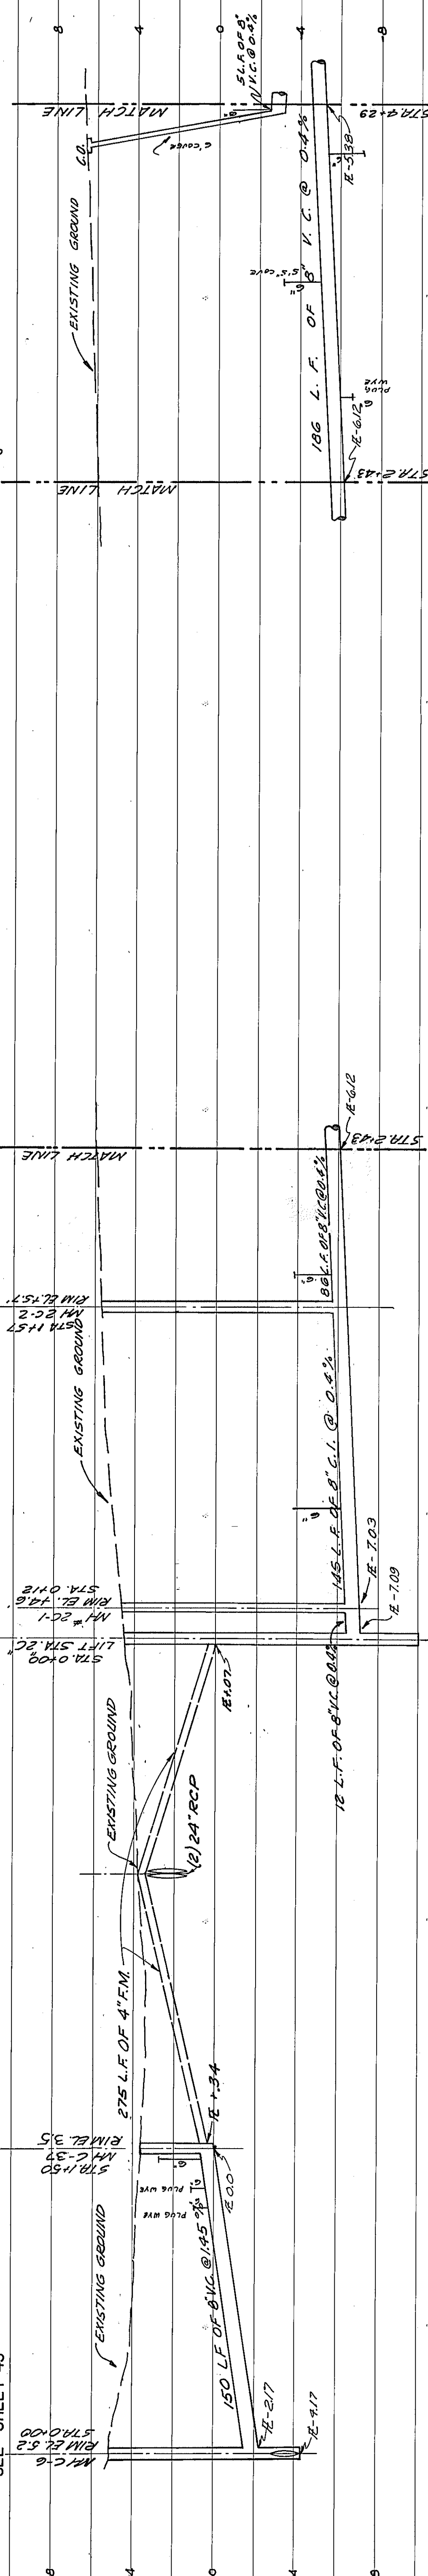


| | | | | |
|---------------|----------|---------------|-----------------------------|---------------------|
| DATE: 8/21/73 | BY: M.J. | SCALE: 1"=40' | DESIGNED BY: J.D.W., E.M.N. | APPROVED BY: J.D.W. |
| DATE: 4-13-73 | BY: M.J. | SCALE: 1"=40' | DESIGNED BY: J.D.W., E.M.N. | APPROVED BY: J.D.W. |
| DATE: 1217-S | BY: M.J. | SCALE: 1"=40' | DESIGNED BY: J.D.W., E.M.N. | APPROVED BY: J.D.W. |

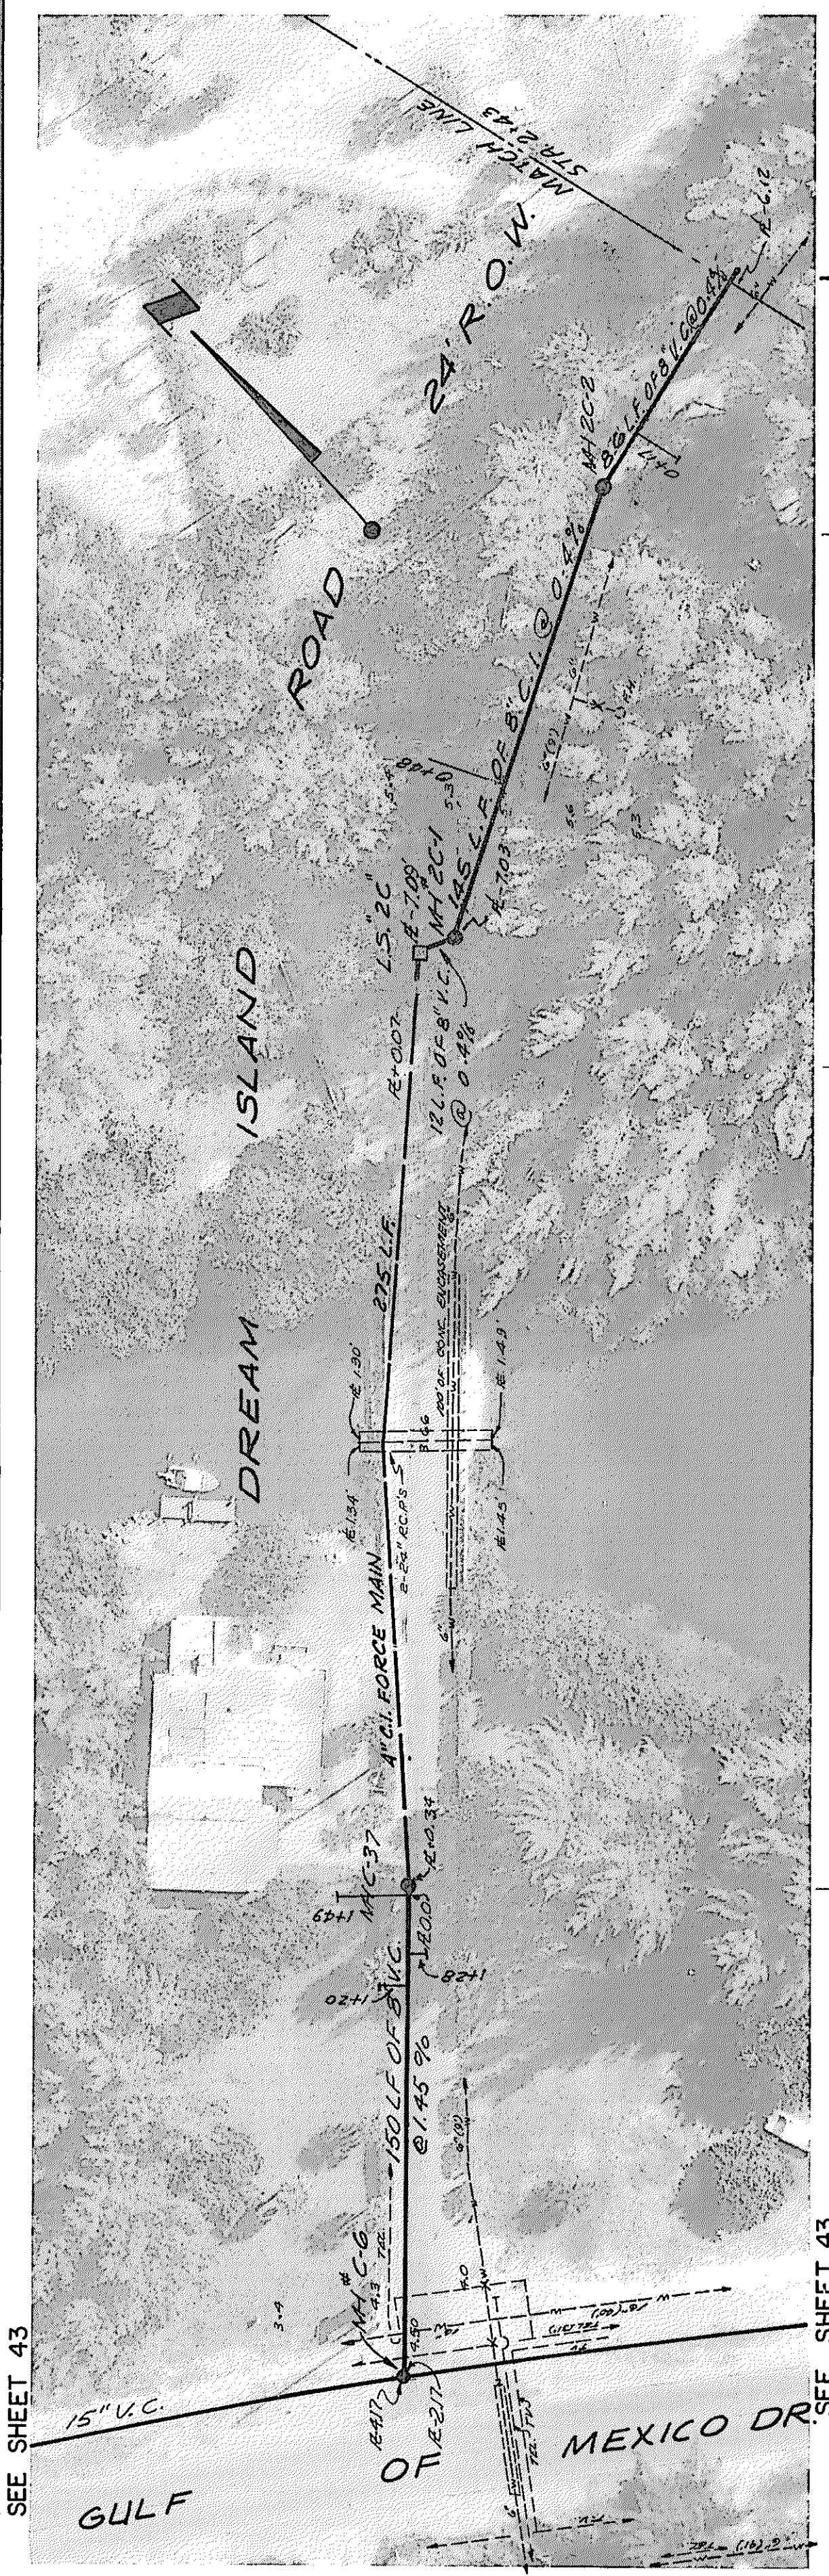

AS BUILT PLANS