
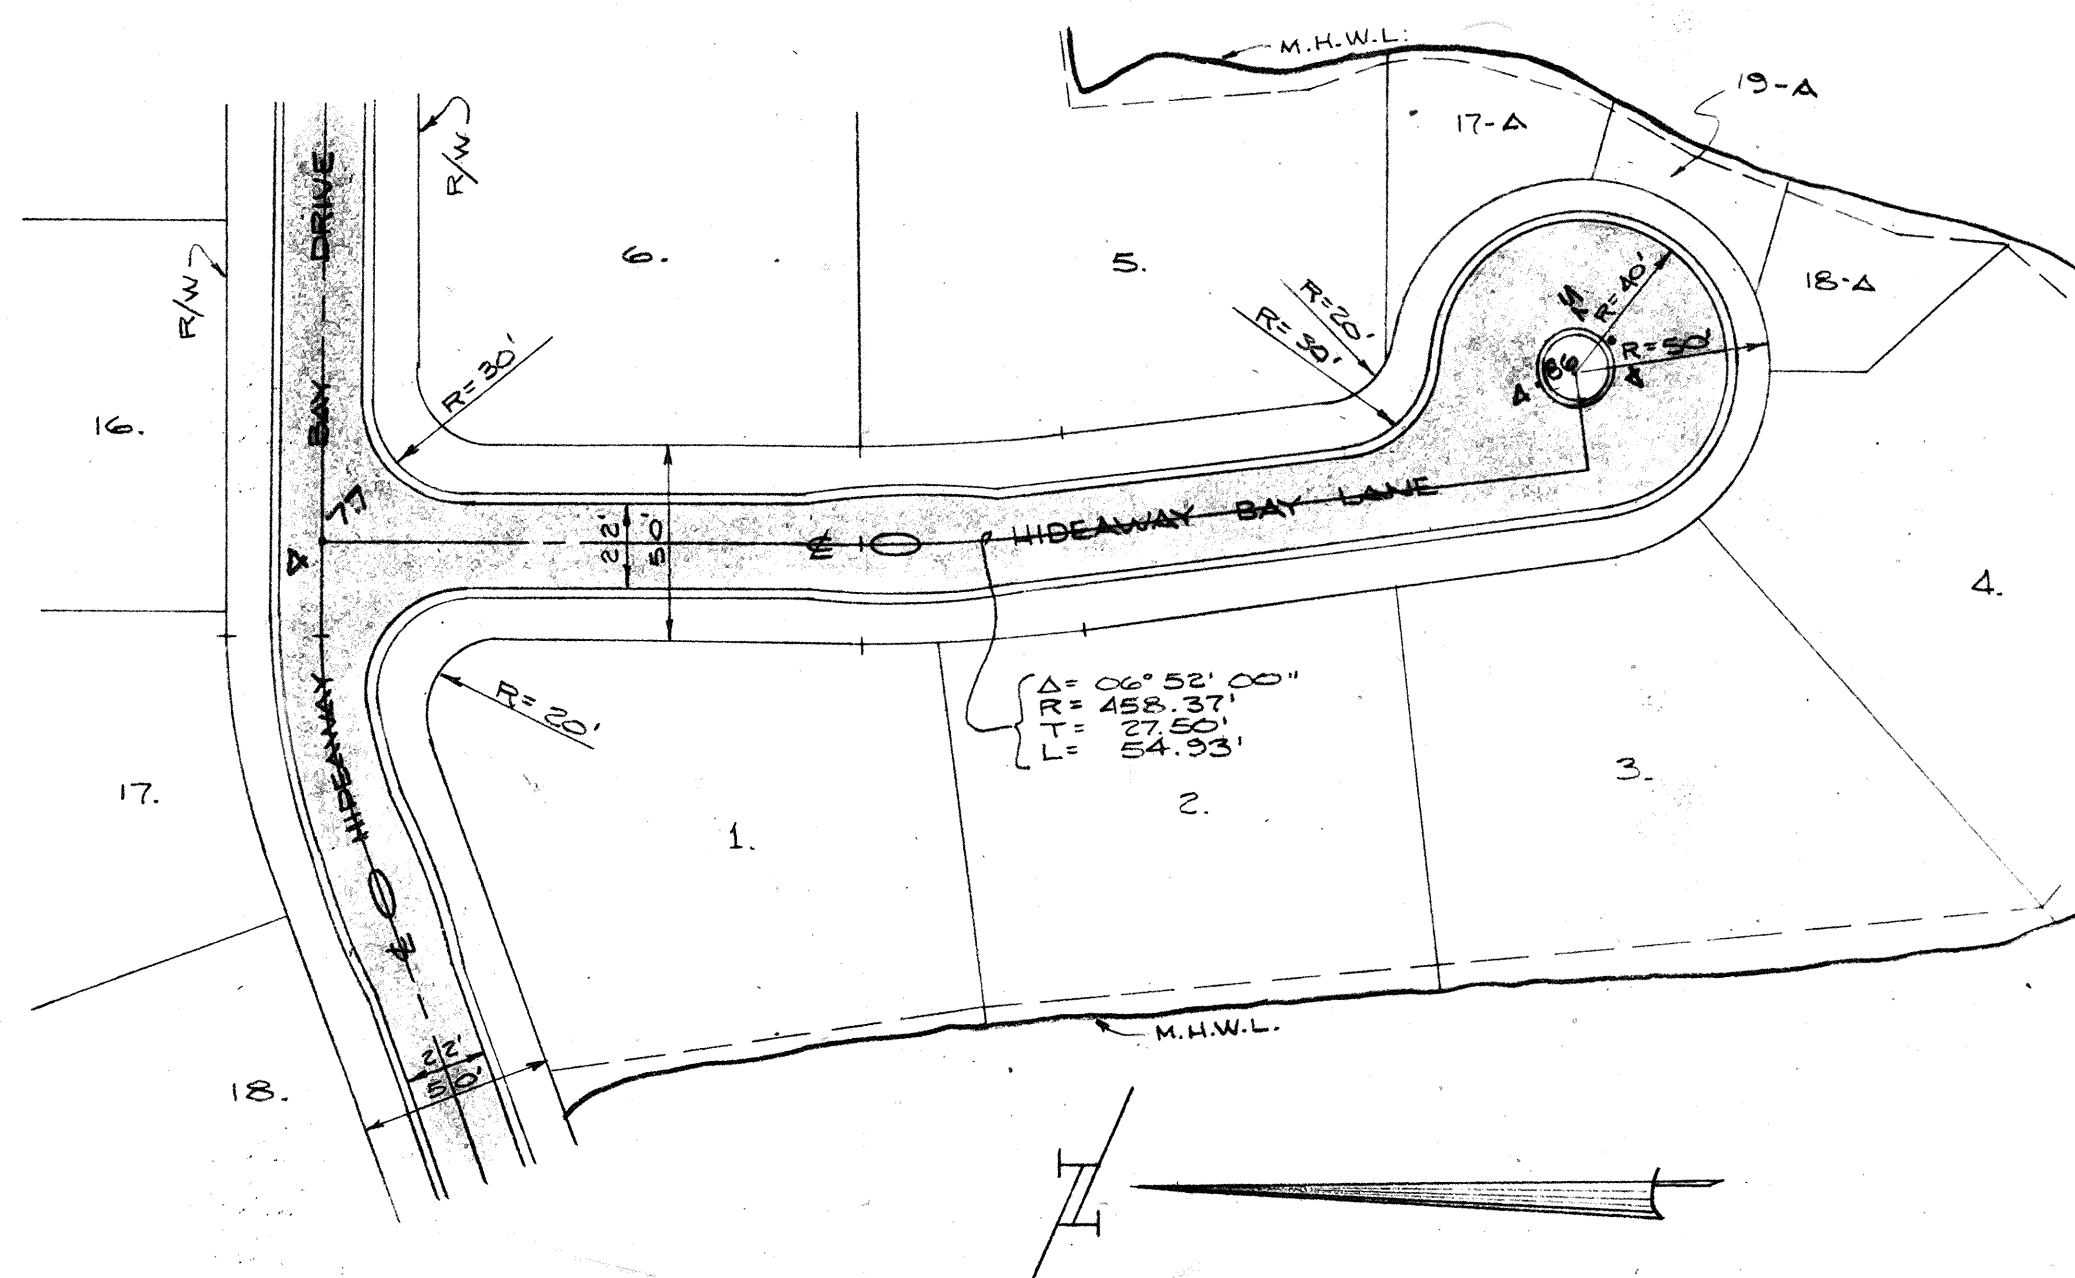


PLAN	DATE
BY	
REVISIONS	
NOTED	
NOTE BOOK	ALIGNMENT CHECKED
No.	FT. OF WAY CHECKED

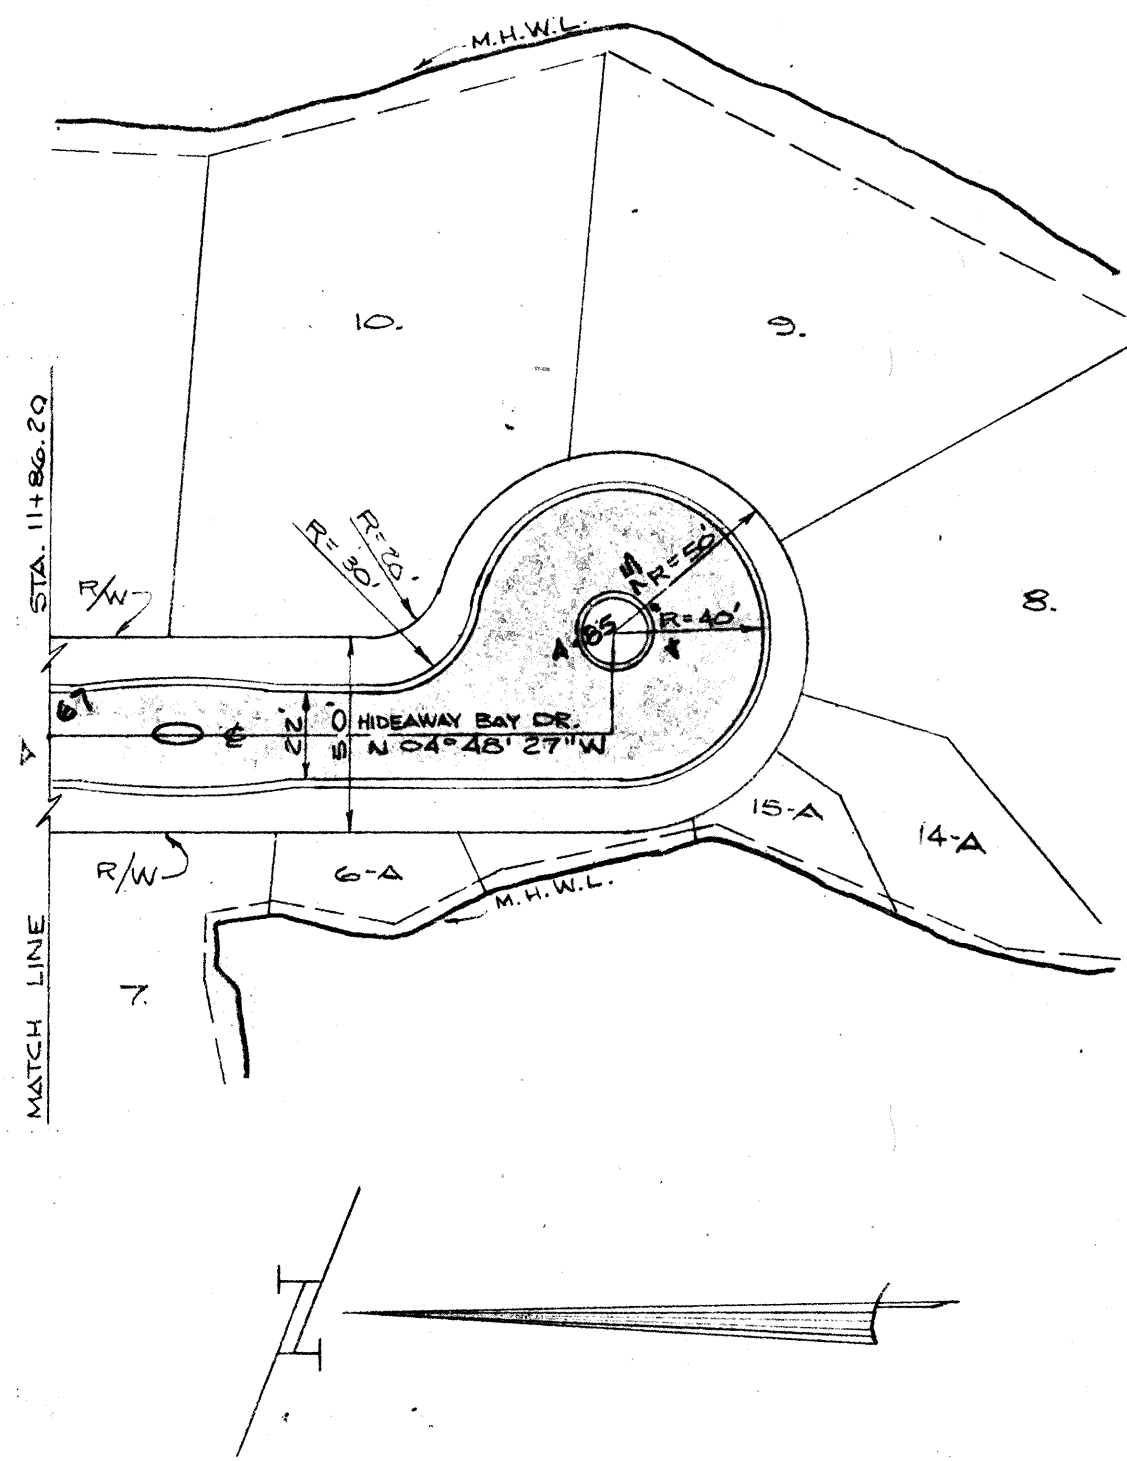

SCALE
 HORZ : 1" = 50'
 VERT : 1" = 2'

PROFILE	DATE
BY	
REVISIONS	
NOTED	
NOTE BOOK	GRADES CHECKED
No.	S. A. 1. NOTED
	STRUCTURE NOTATIONS CHECKED

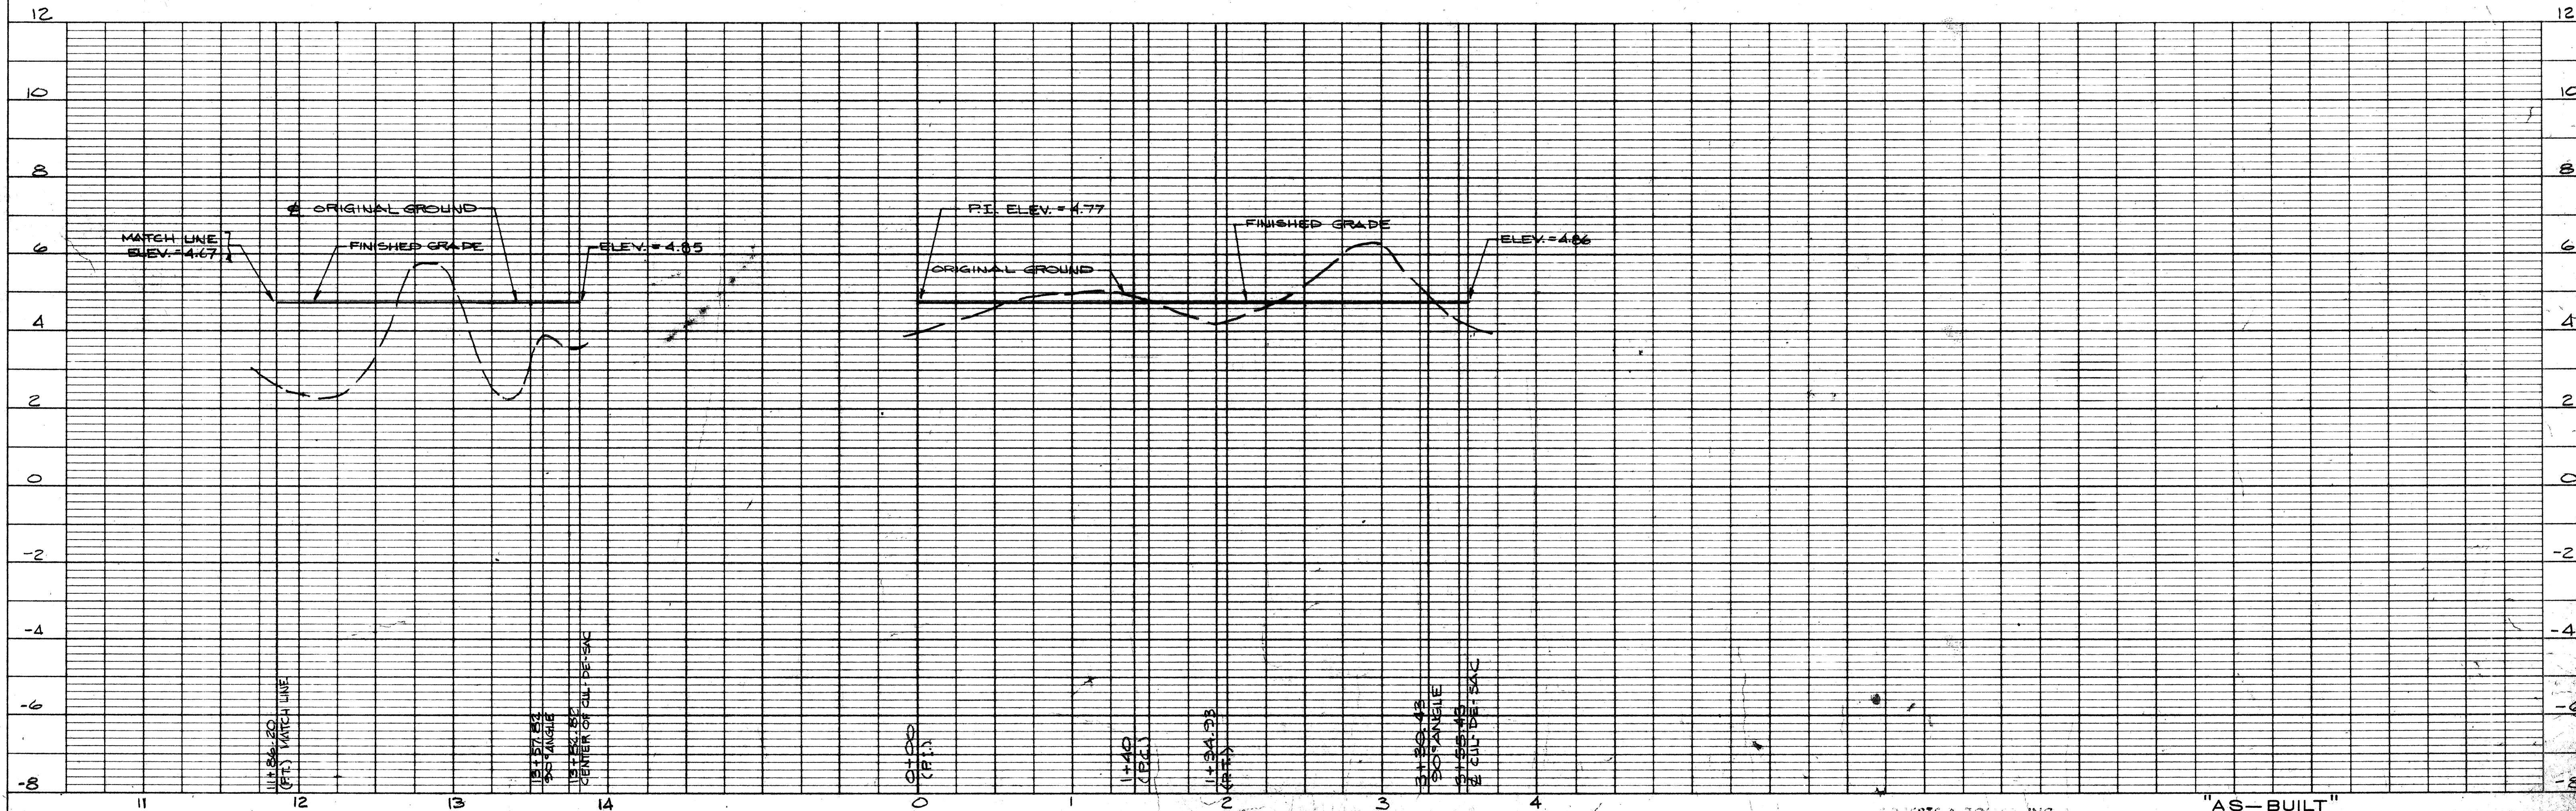


PLATE 1-SINGLE PLAN-PROFILE C. P. R. & R. E. STANDARD
 L. L. BIRDWAY COMPANY, INC.
 100% MADE IN U.S.A.

ROBERTS & ZOLLER, INC.
 CONSULTING ENGINEERS

"AS-BUILT"
 STREET CONSTRUCTION PLAN
 FOR
 HIDEAWAY BAY

(REVISED 1-12-78)

SHEET 3 OF 5