




TYPICAL LOT GRADING PLAN
NO SCALE

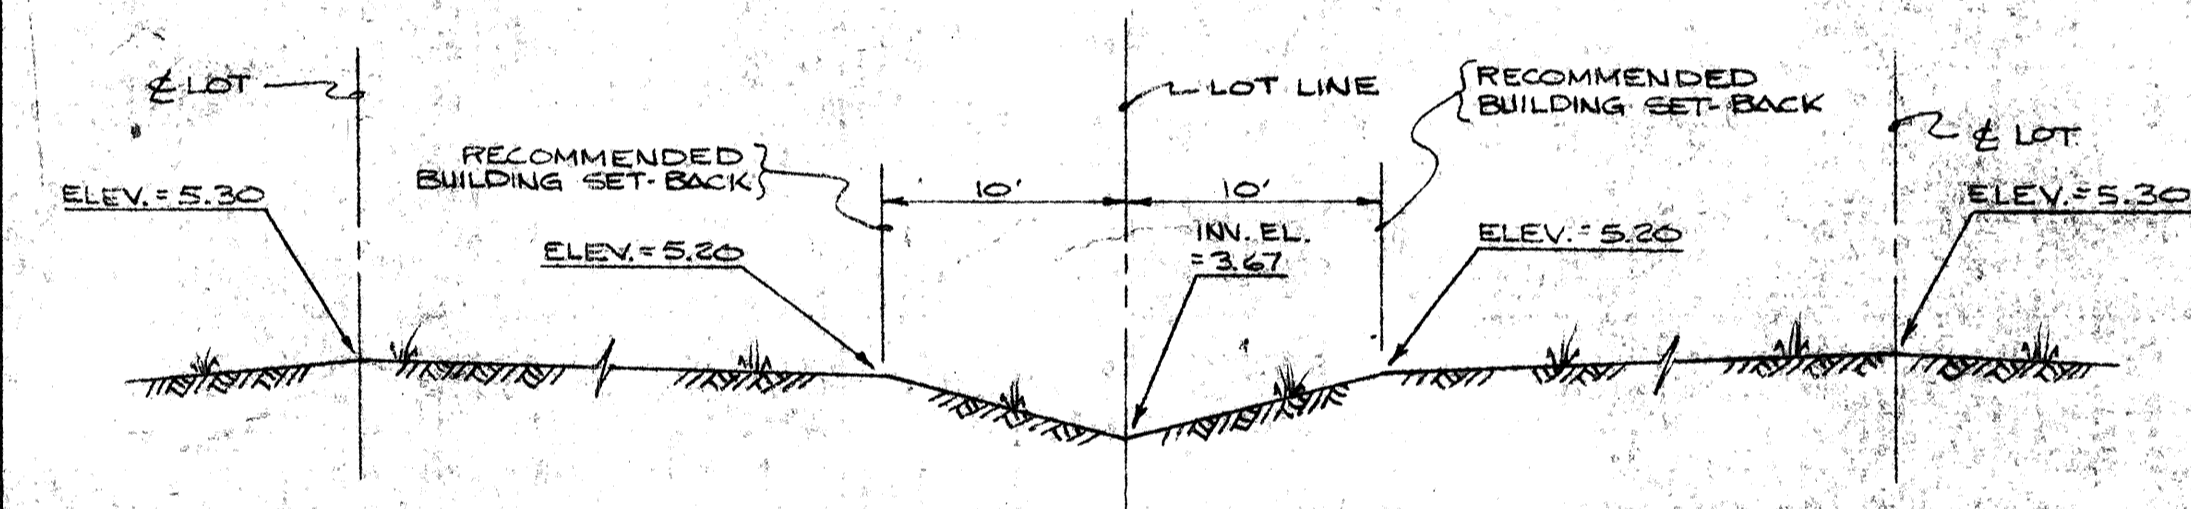


SECTION "A"-A"
TYPICAL LOT GRADING SECTION
NO SCALE

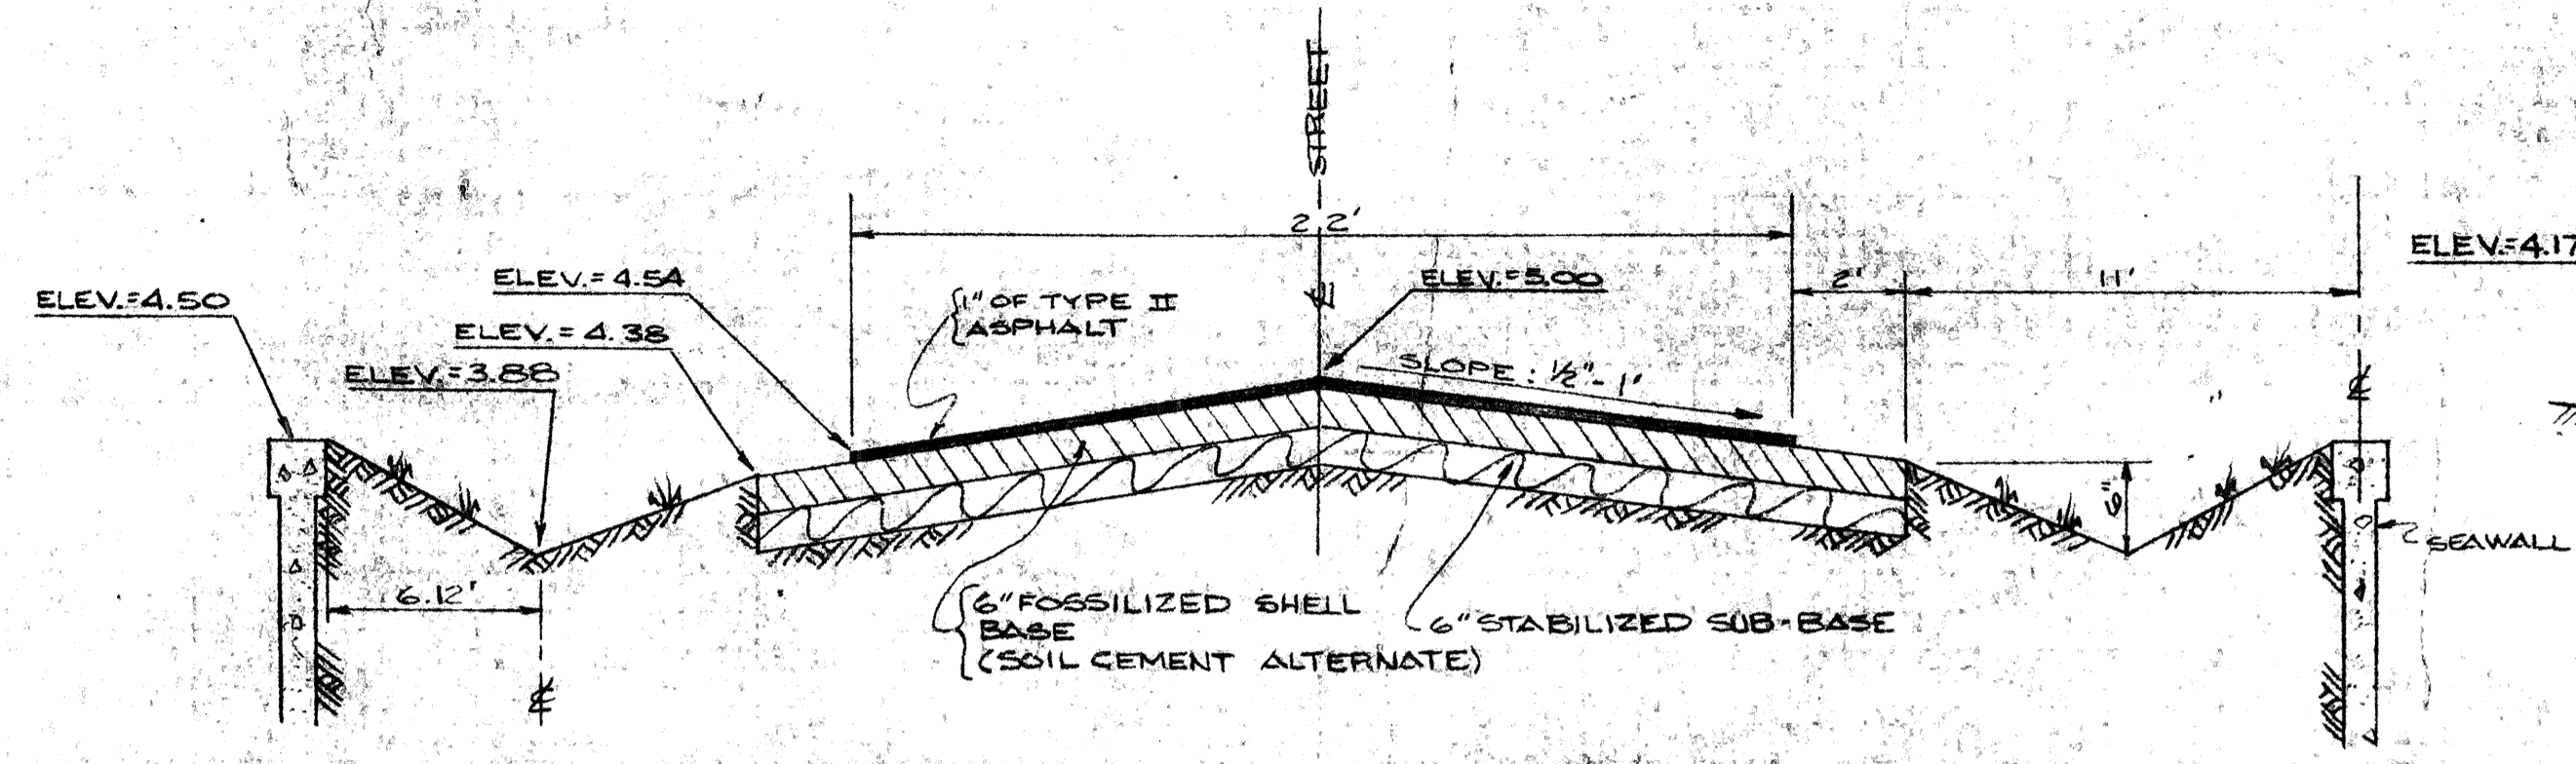


TYPICAL CAUSEWAY SECTION
NO SCALE

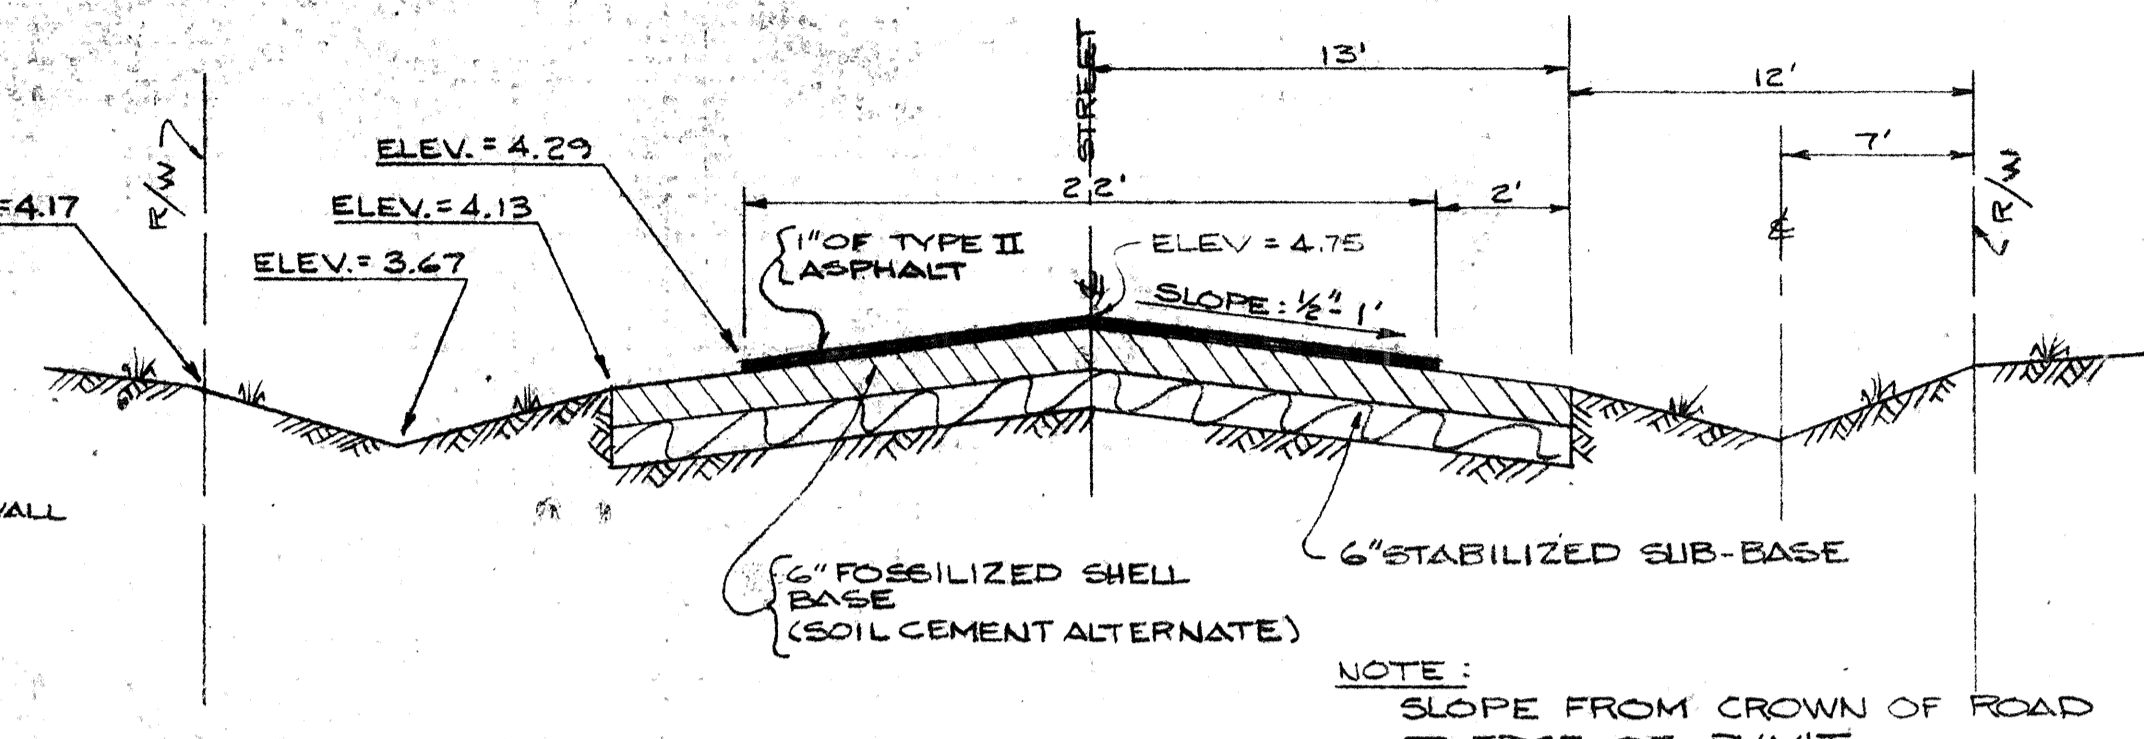

TYPICAL ROADWAY SECTION
NO SCALE

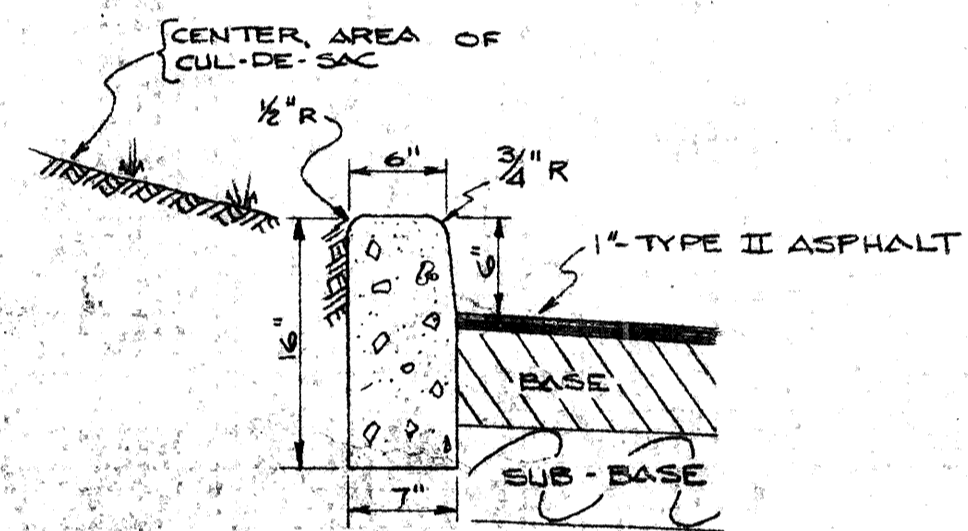


6" STRAIGHT CURB
NO SCALE

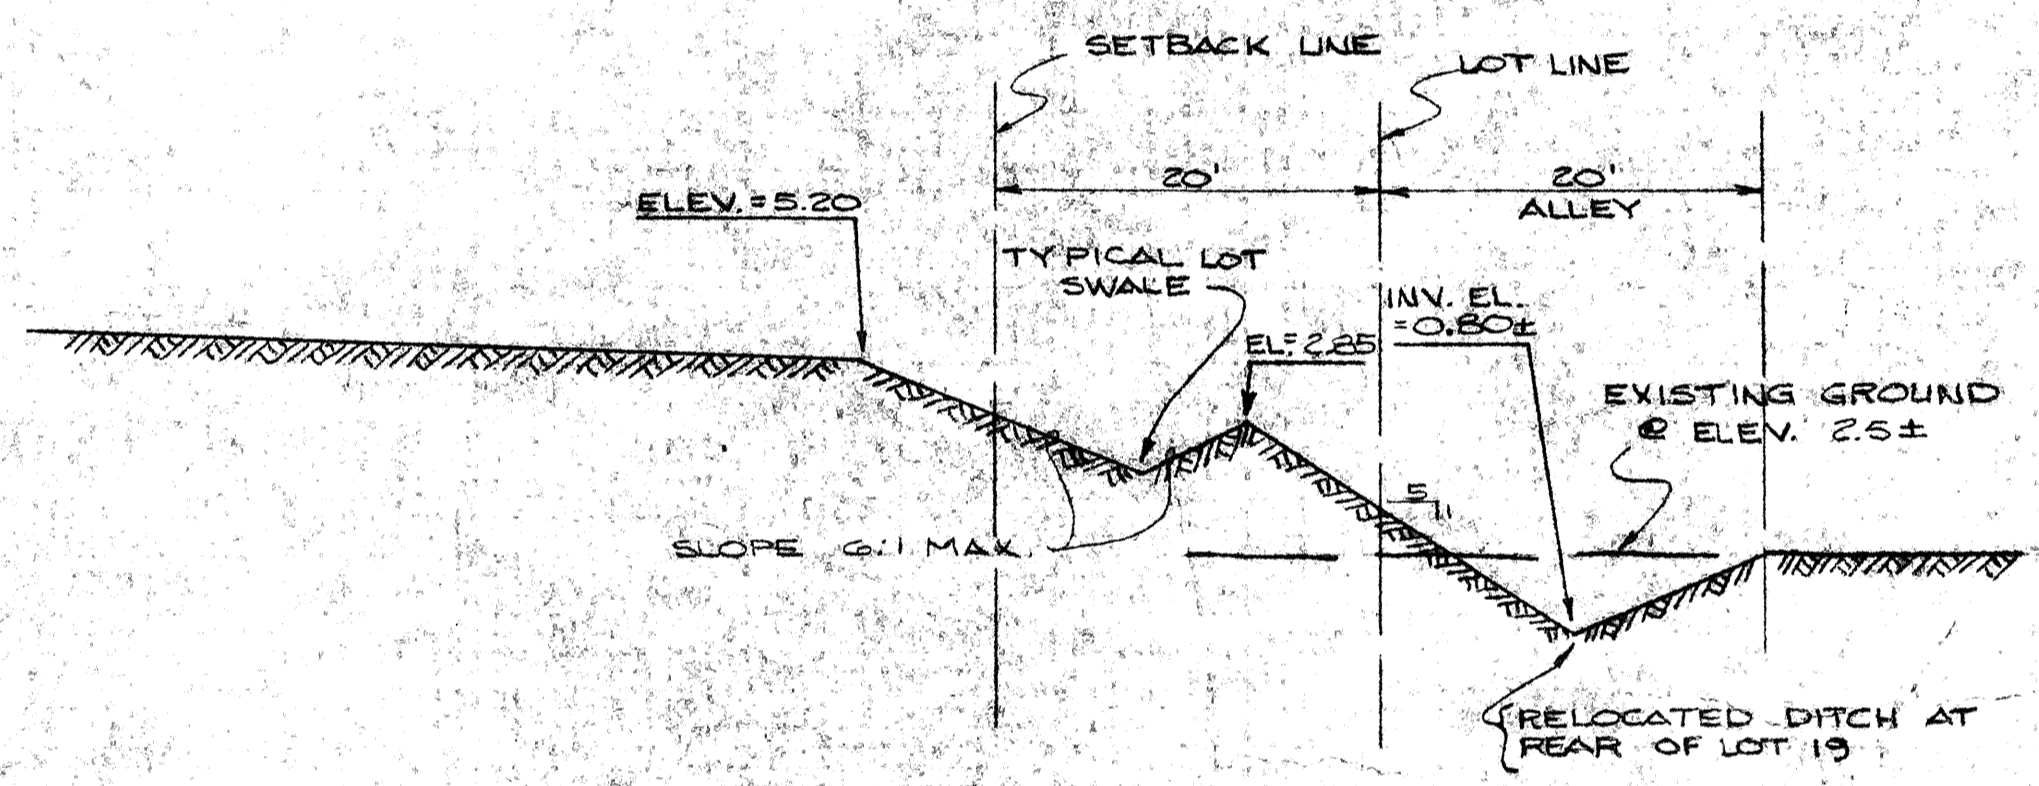


SECTION "C"-C"
NO SCALE

STREETS & GRADING CONSTRUCTION DETAILS


FOR
HIDEAWAY BAY
SUBDIVISION
IN
SEC. 23, TWP. 35 S, RGE. 16 E
MANATEE COUNTY, FLORIDA

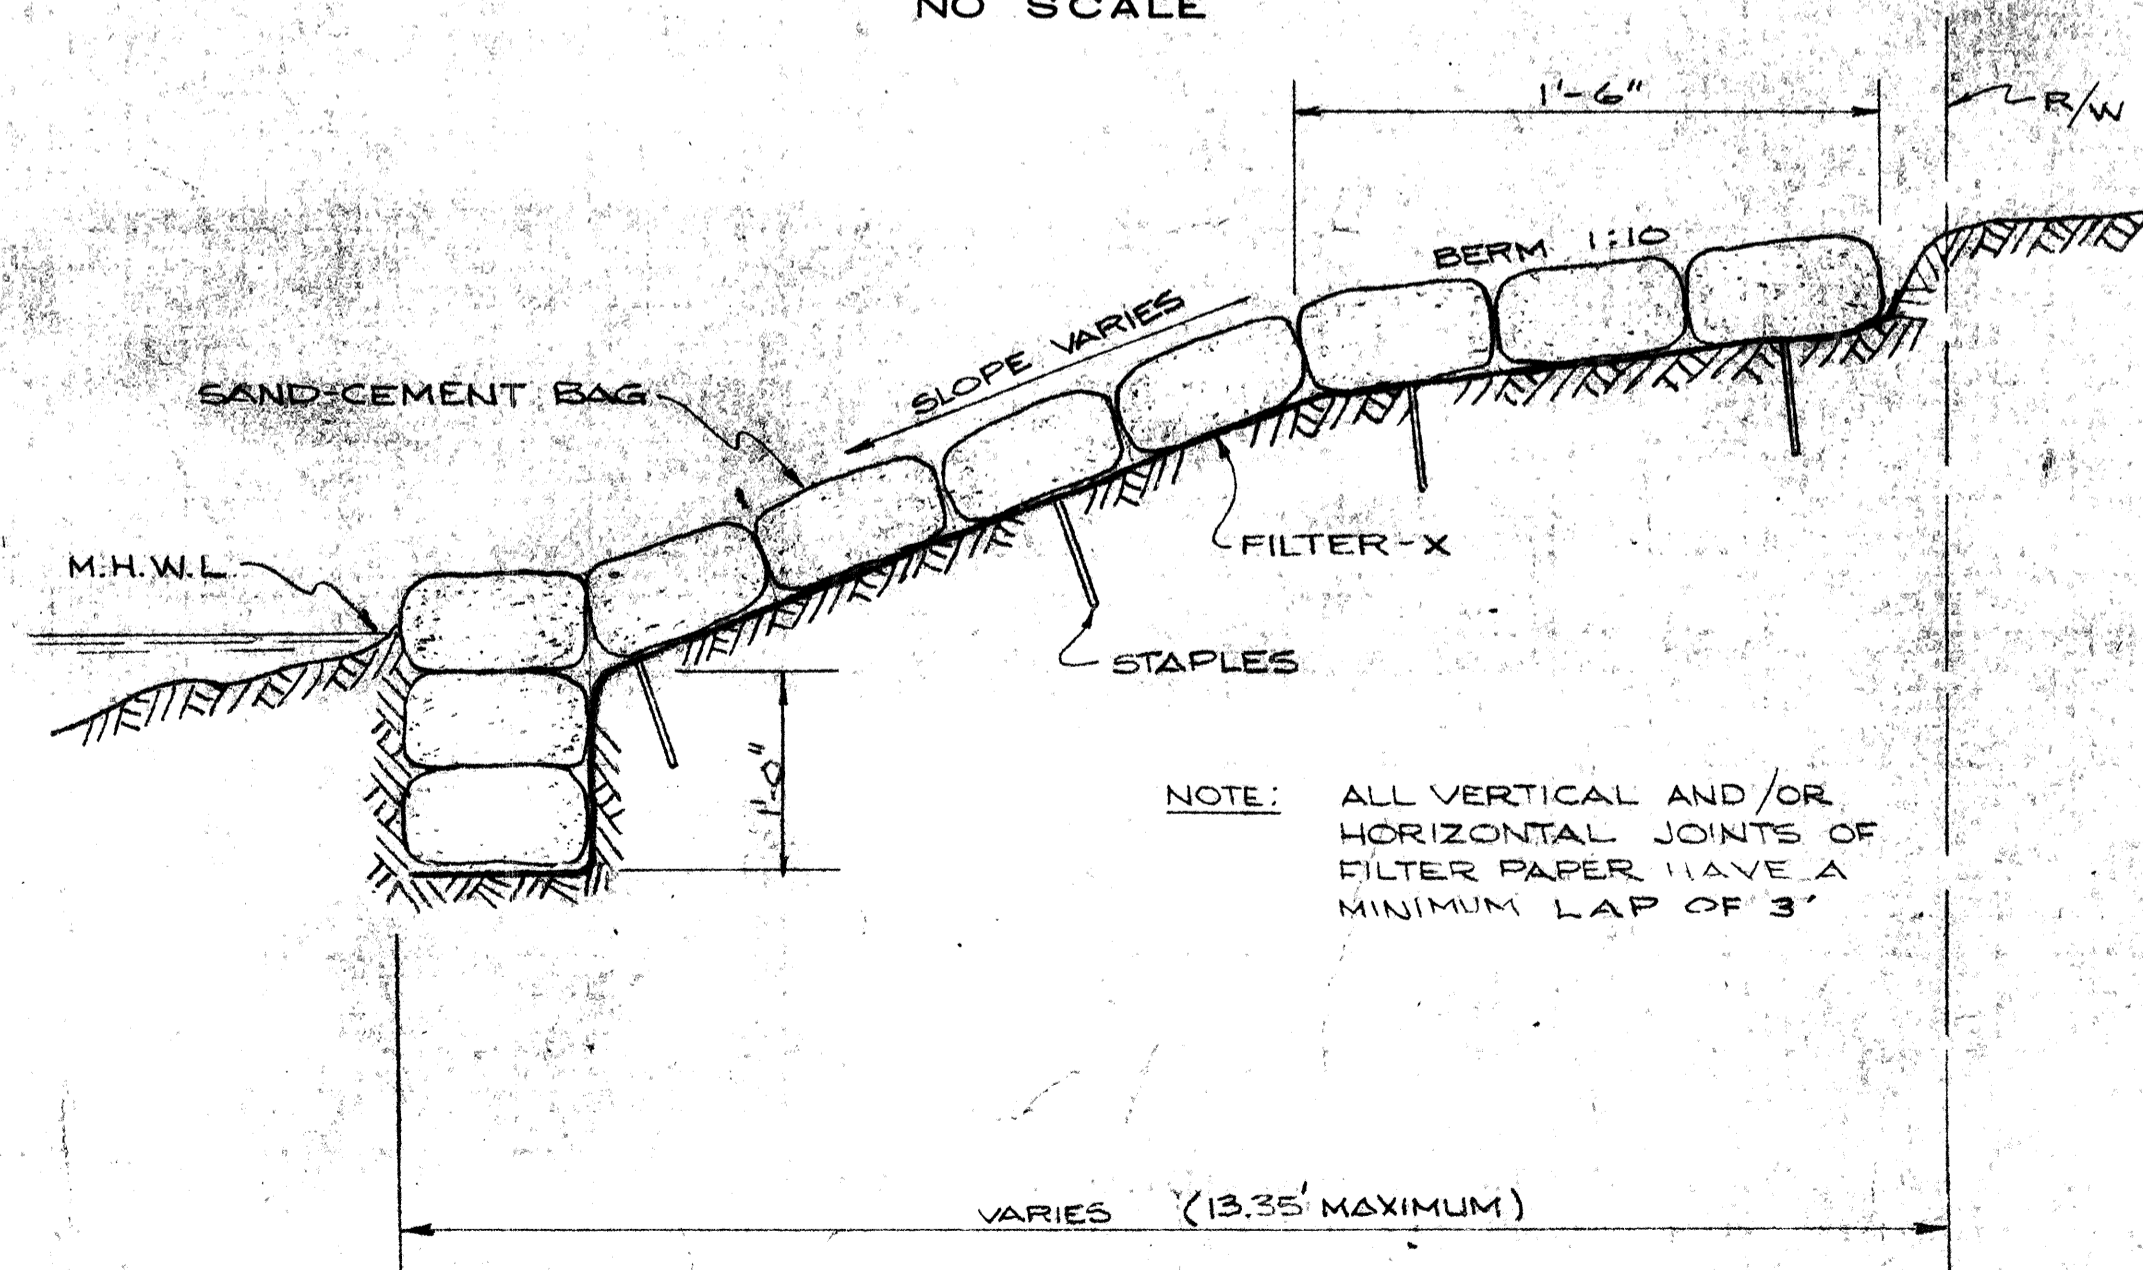

RIP-RAP DETAILS
NO SCALE

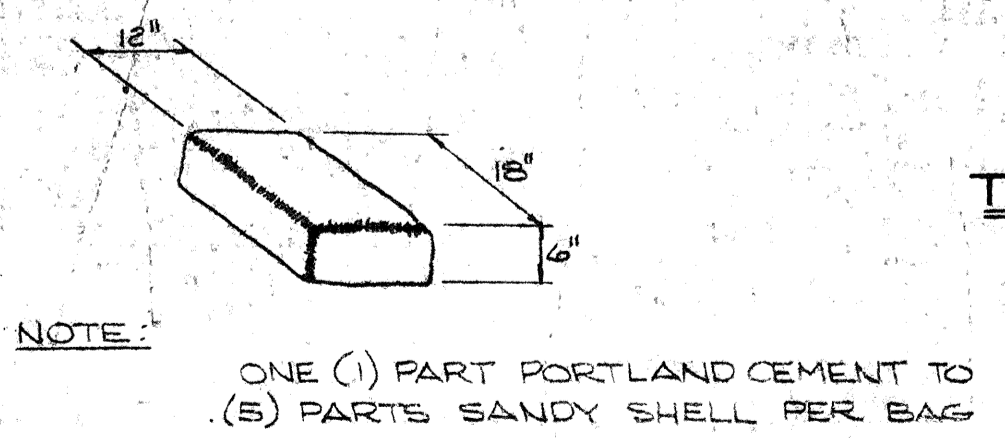

SANDBAG DETAIL

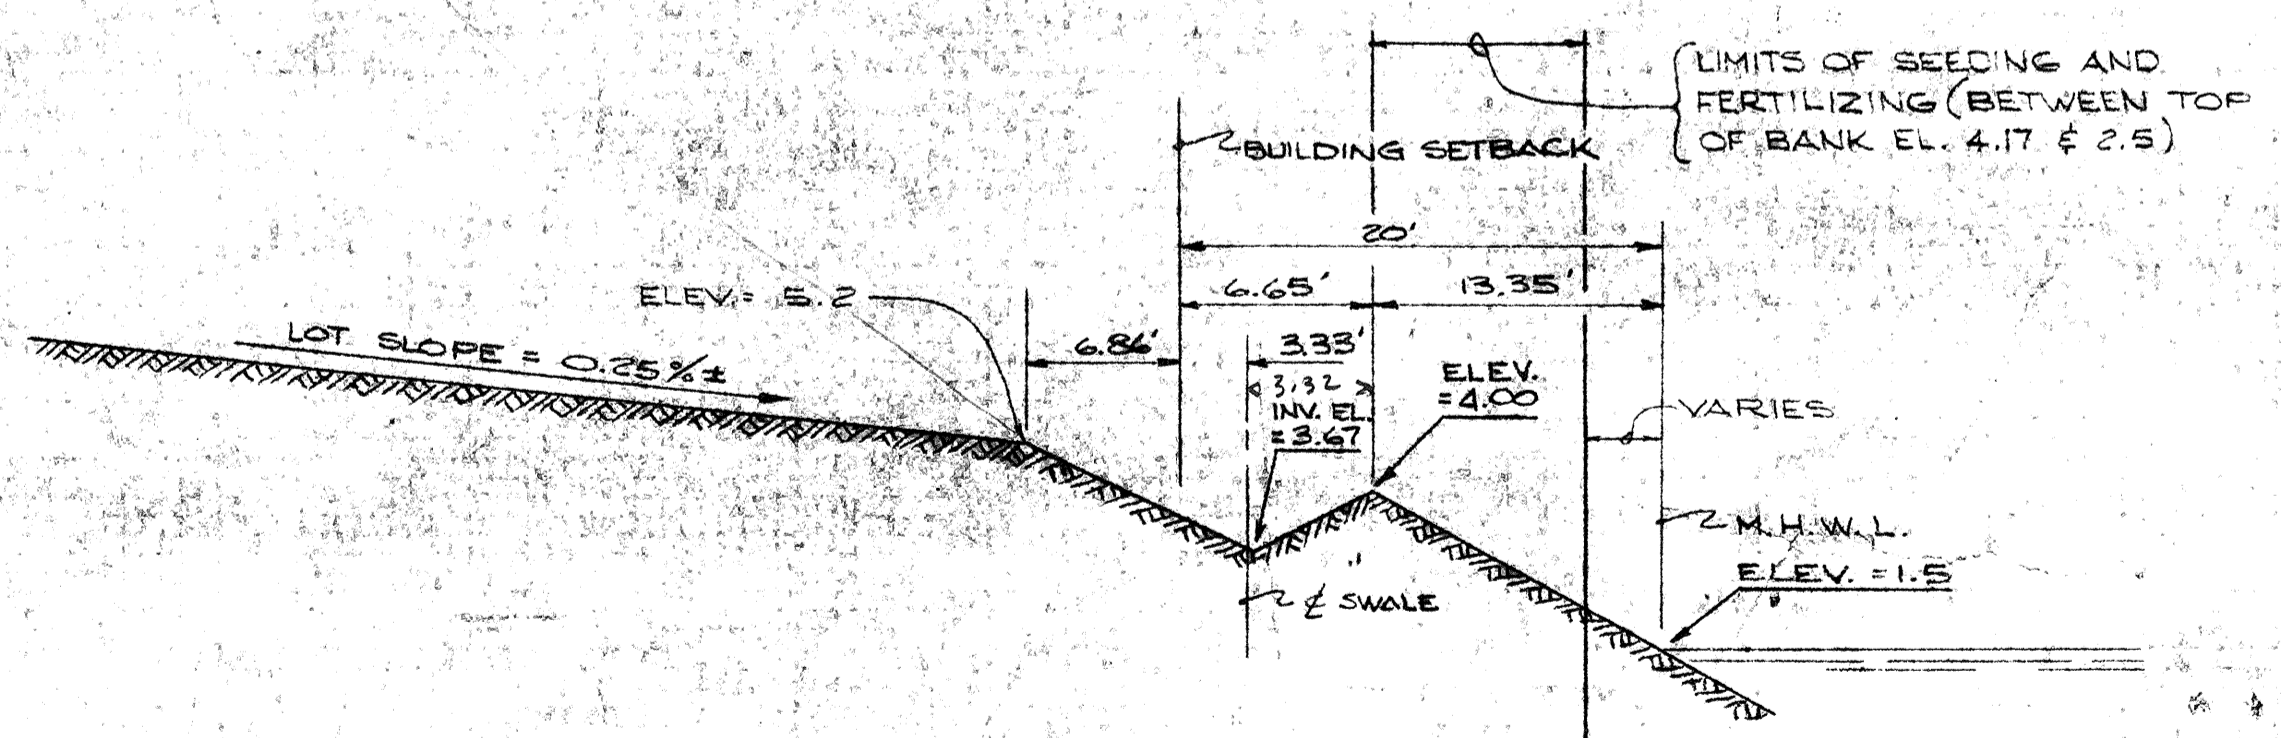

SECTION "B"-B"
TYPICAL BACKLOT GRADING
NO SCALE

DESIGNED	C.B.D.	DATE	10-9-77
DRAWN	A.F.R.	JOB NO.	125
CHECKED	C.B.D. & A.F.R.	SCALE	NONE
APPROVED		SHEET	4 OF 5
REVISED			
1	1-12-78	3	
2		4	

ROBERTS & ZOLLER, INC.
CONSULTING ENGINEERS
ENGINEERING, SURVEYING, PLANNING
P.O. BOX 12
BRADENTON, FLORIDA 33508