



DATE	
BY	K.T.L.
REVISIONS	
NO.	DESCRIPTION
1	AS SHOWN
2	AS NOTED
3	AS NOTED
DATE	
BY	K.T.L.
REVISIONS	
NO.	DESCRIPTION
1	AS SHOWN
2	AS NOTED
3	AS NOTED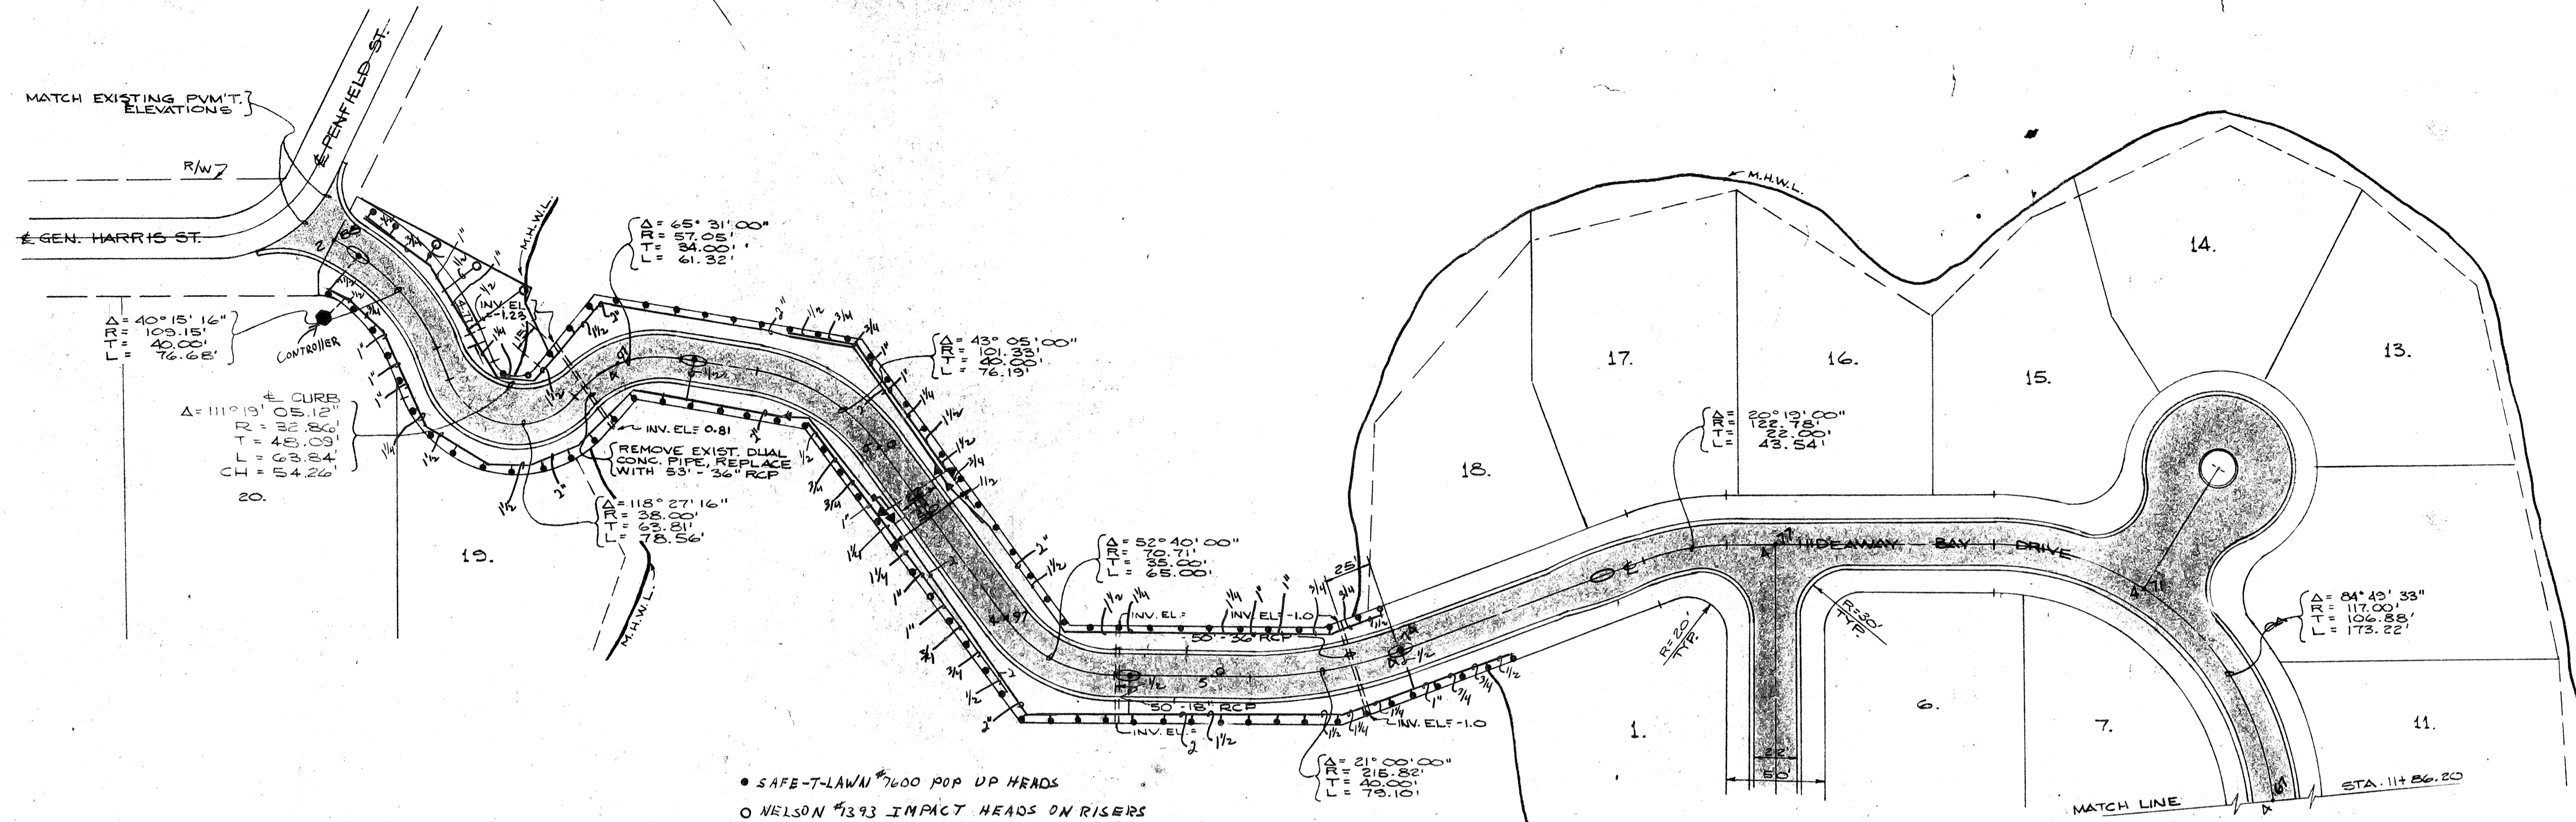
- SAFE-T-LAWN 7600 POP UP HEADS
  - NELSON 1393 IMPACT HEADS ON RISERS
  - ▲ ELECTRIC VALVES
  - METER
  - CONTROLLER
- WIRE FROM VALVES IS RUN IN TRENCHES W/ PIPE TO CONTROLLER

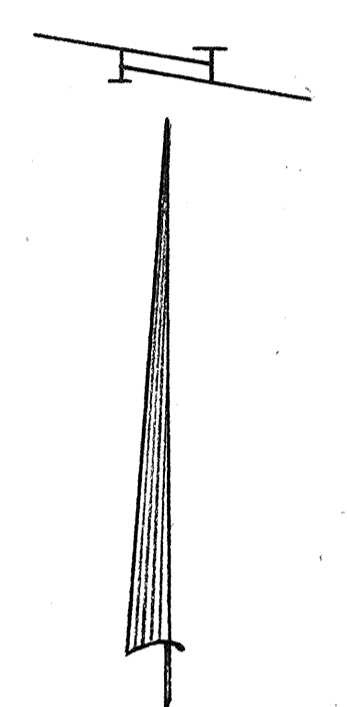

SCALE  
 HORZ: 1" = 50'  
 VERT: 1" = 2'

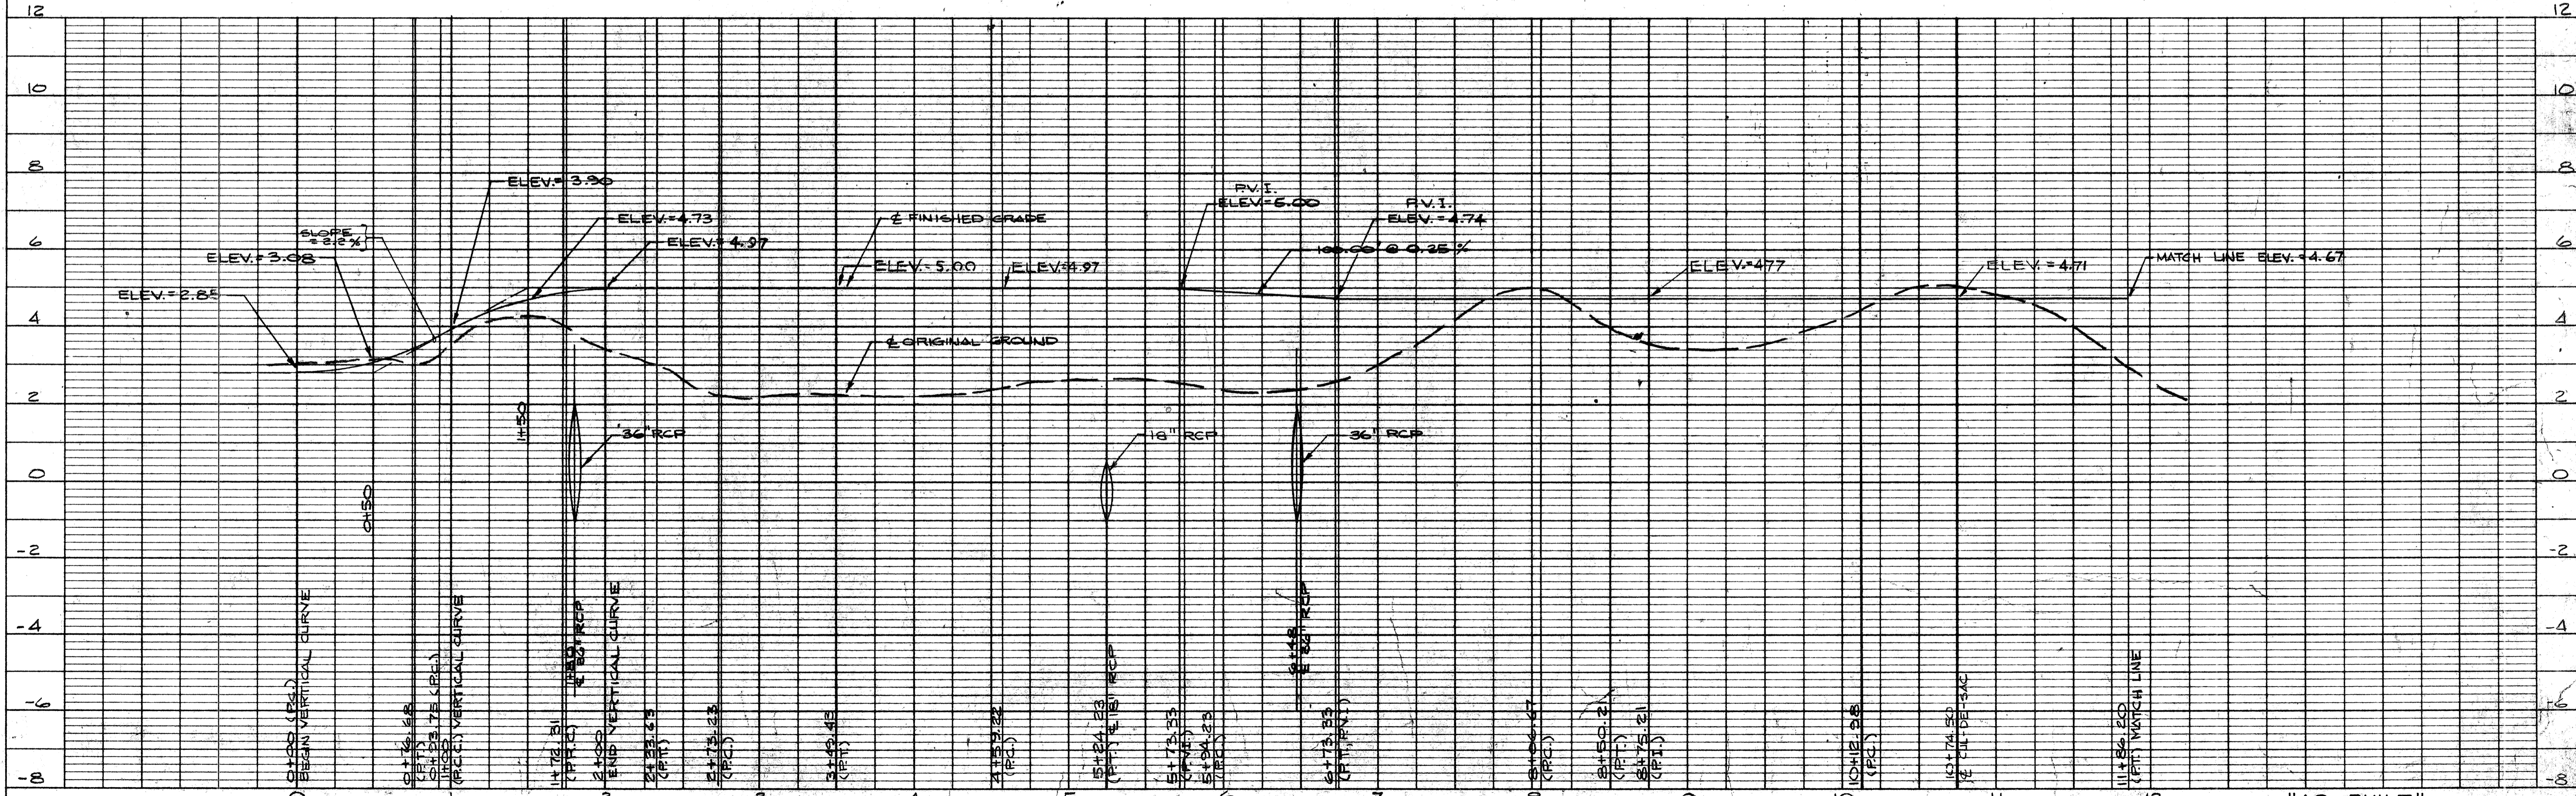


PLATE 1-SINGLE PLAN-PROFILE O.P.R. & R.E. STANDARD  
 L. L. BIRDWAY COMPANY, INC.  
 100% MADE IN U.S.A.

ROBERTS & ZOLLER, INC.  
 CONSULTING ENGINEERS  
 STREET CONSTRUCTION PLAN  
 FOR  
 HIDEAWAY BAY