
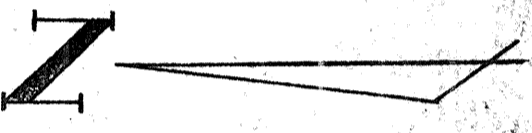
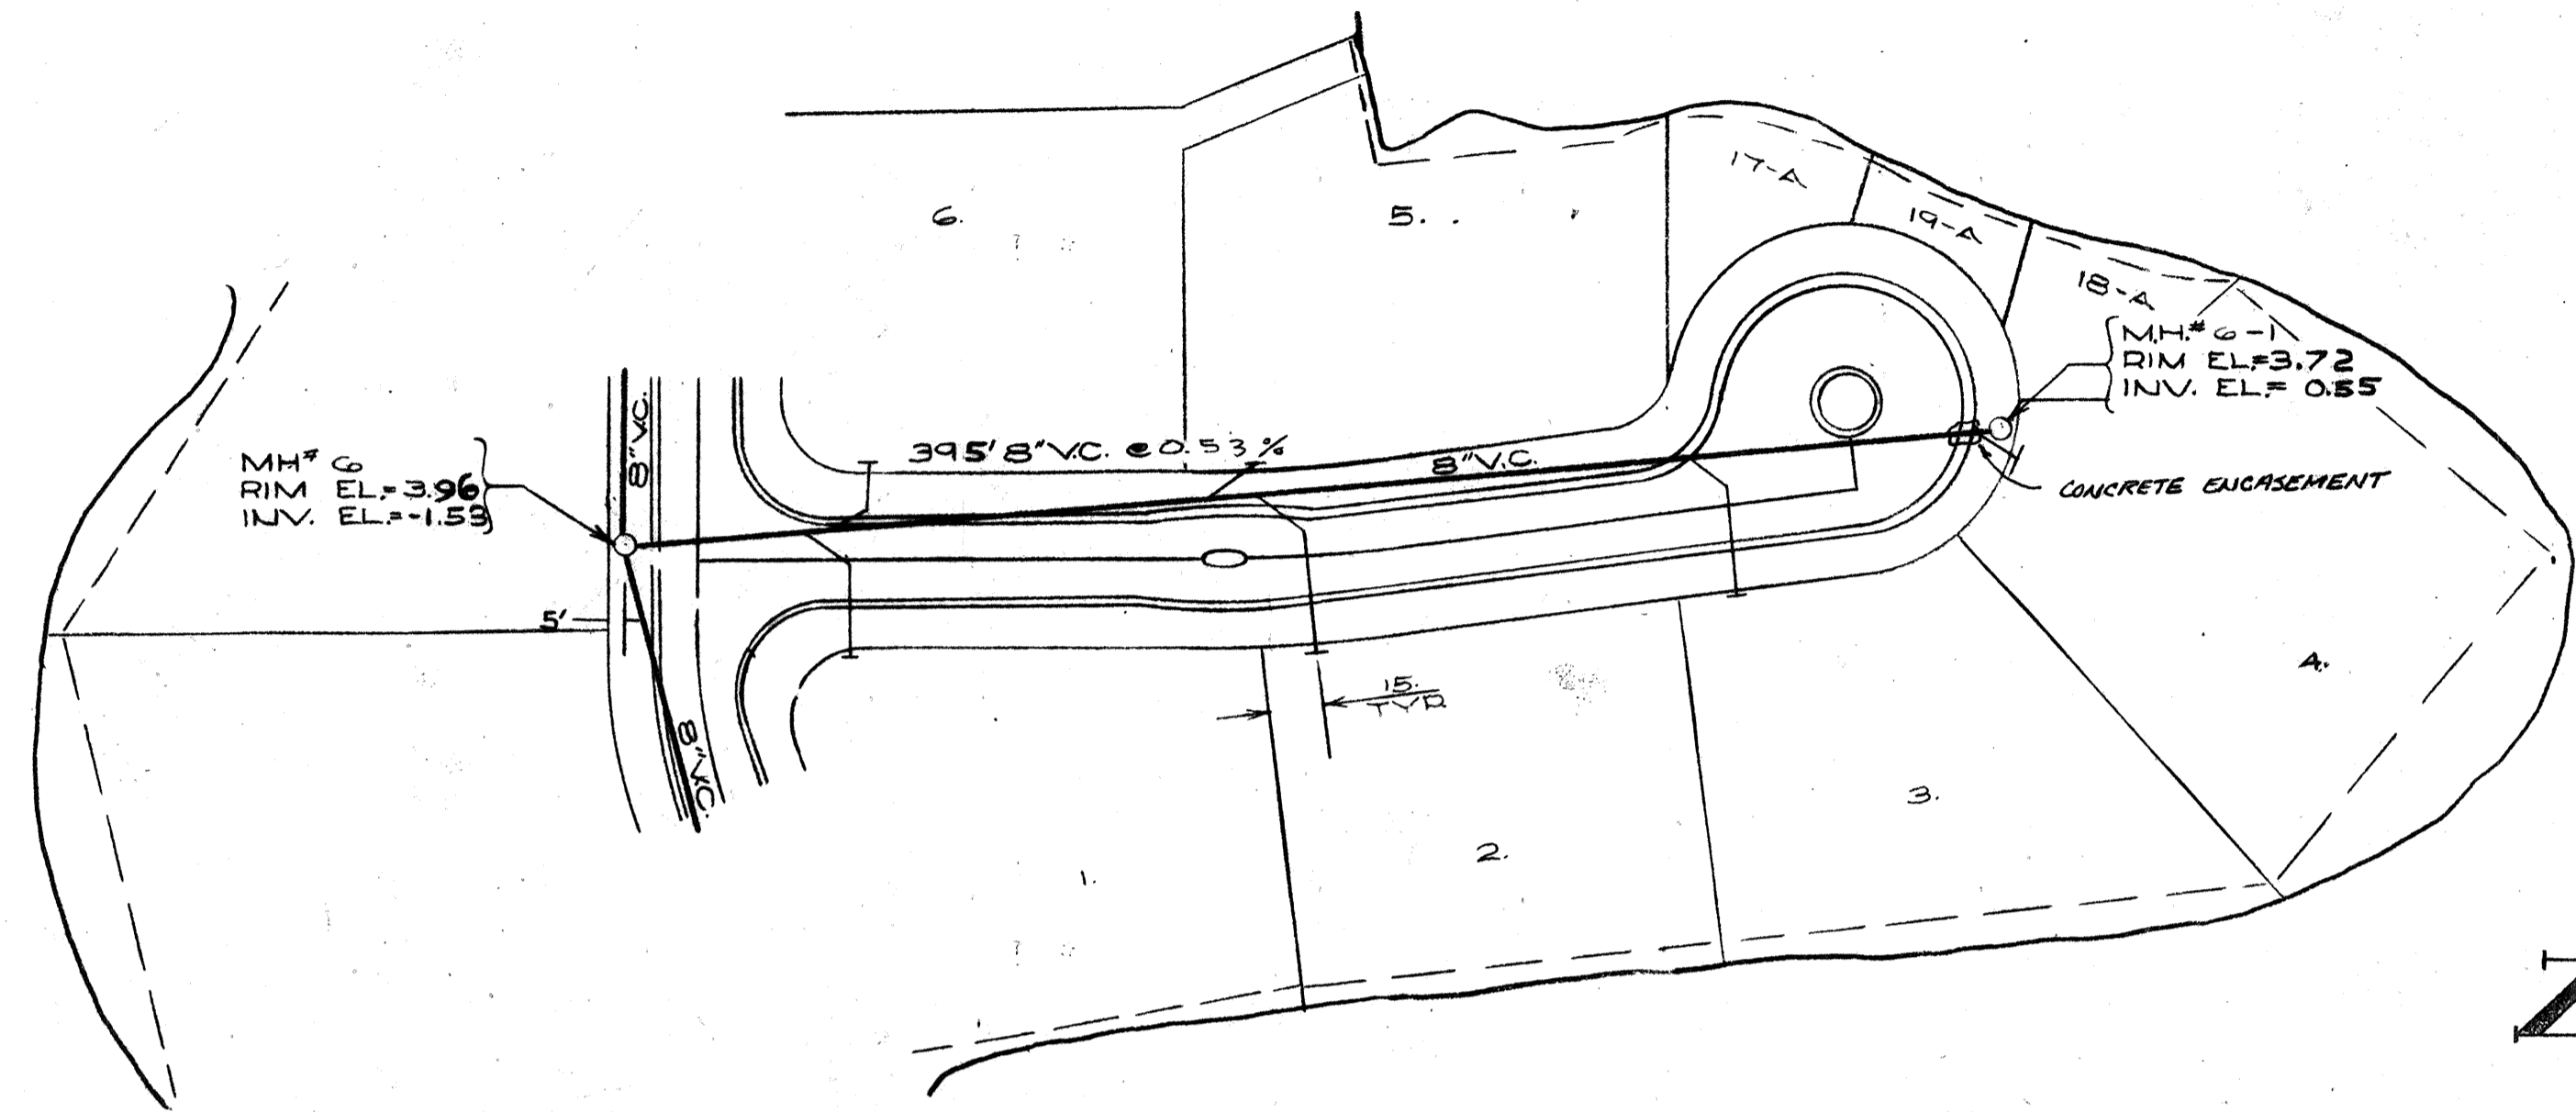


DATE	
BY	
PLAN	
SURVEYED	
PLOTTED	
NOTE BOOK	
ALIGNMENT CHECKED	
FT. OF WAY CHECKED	
No.	

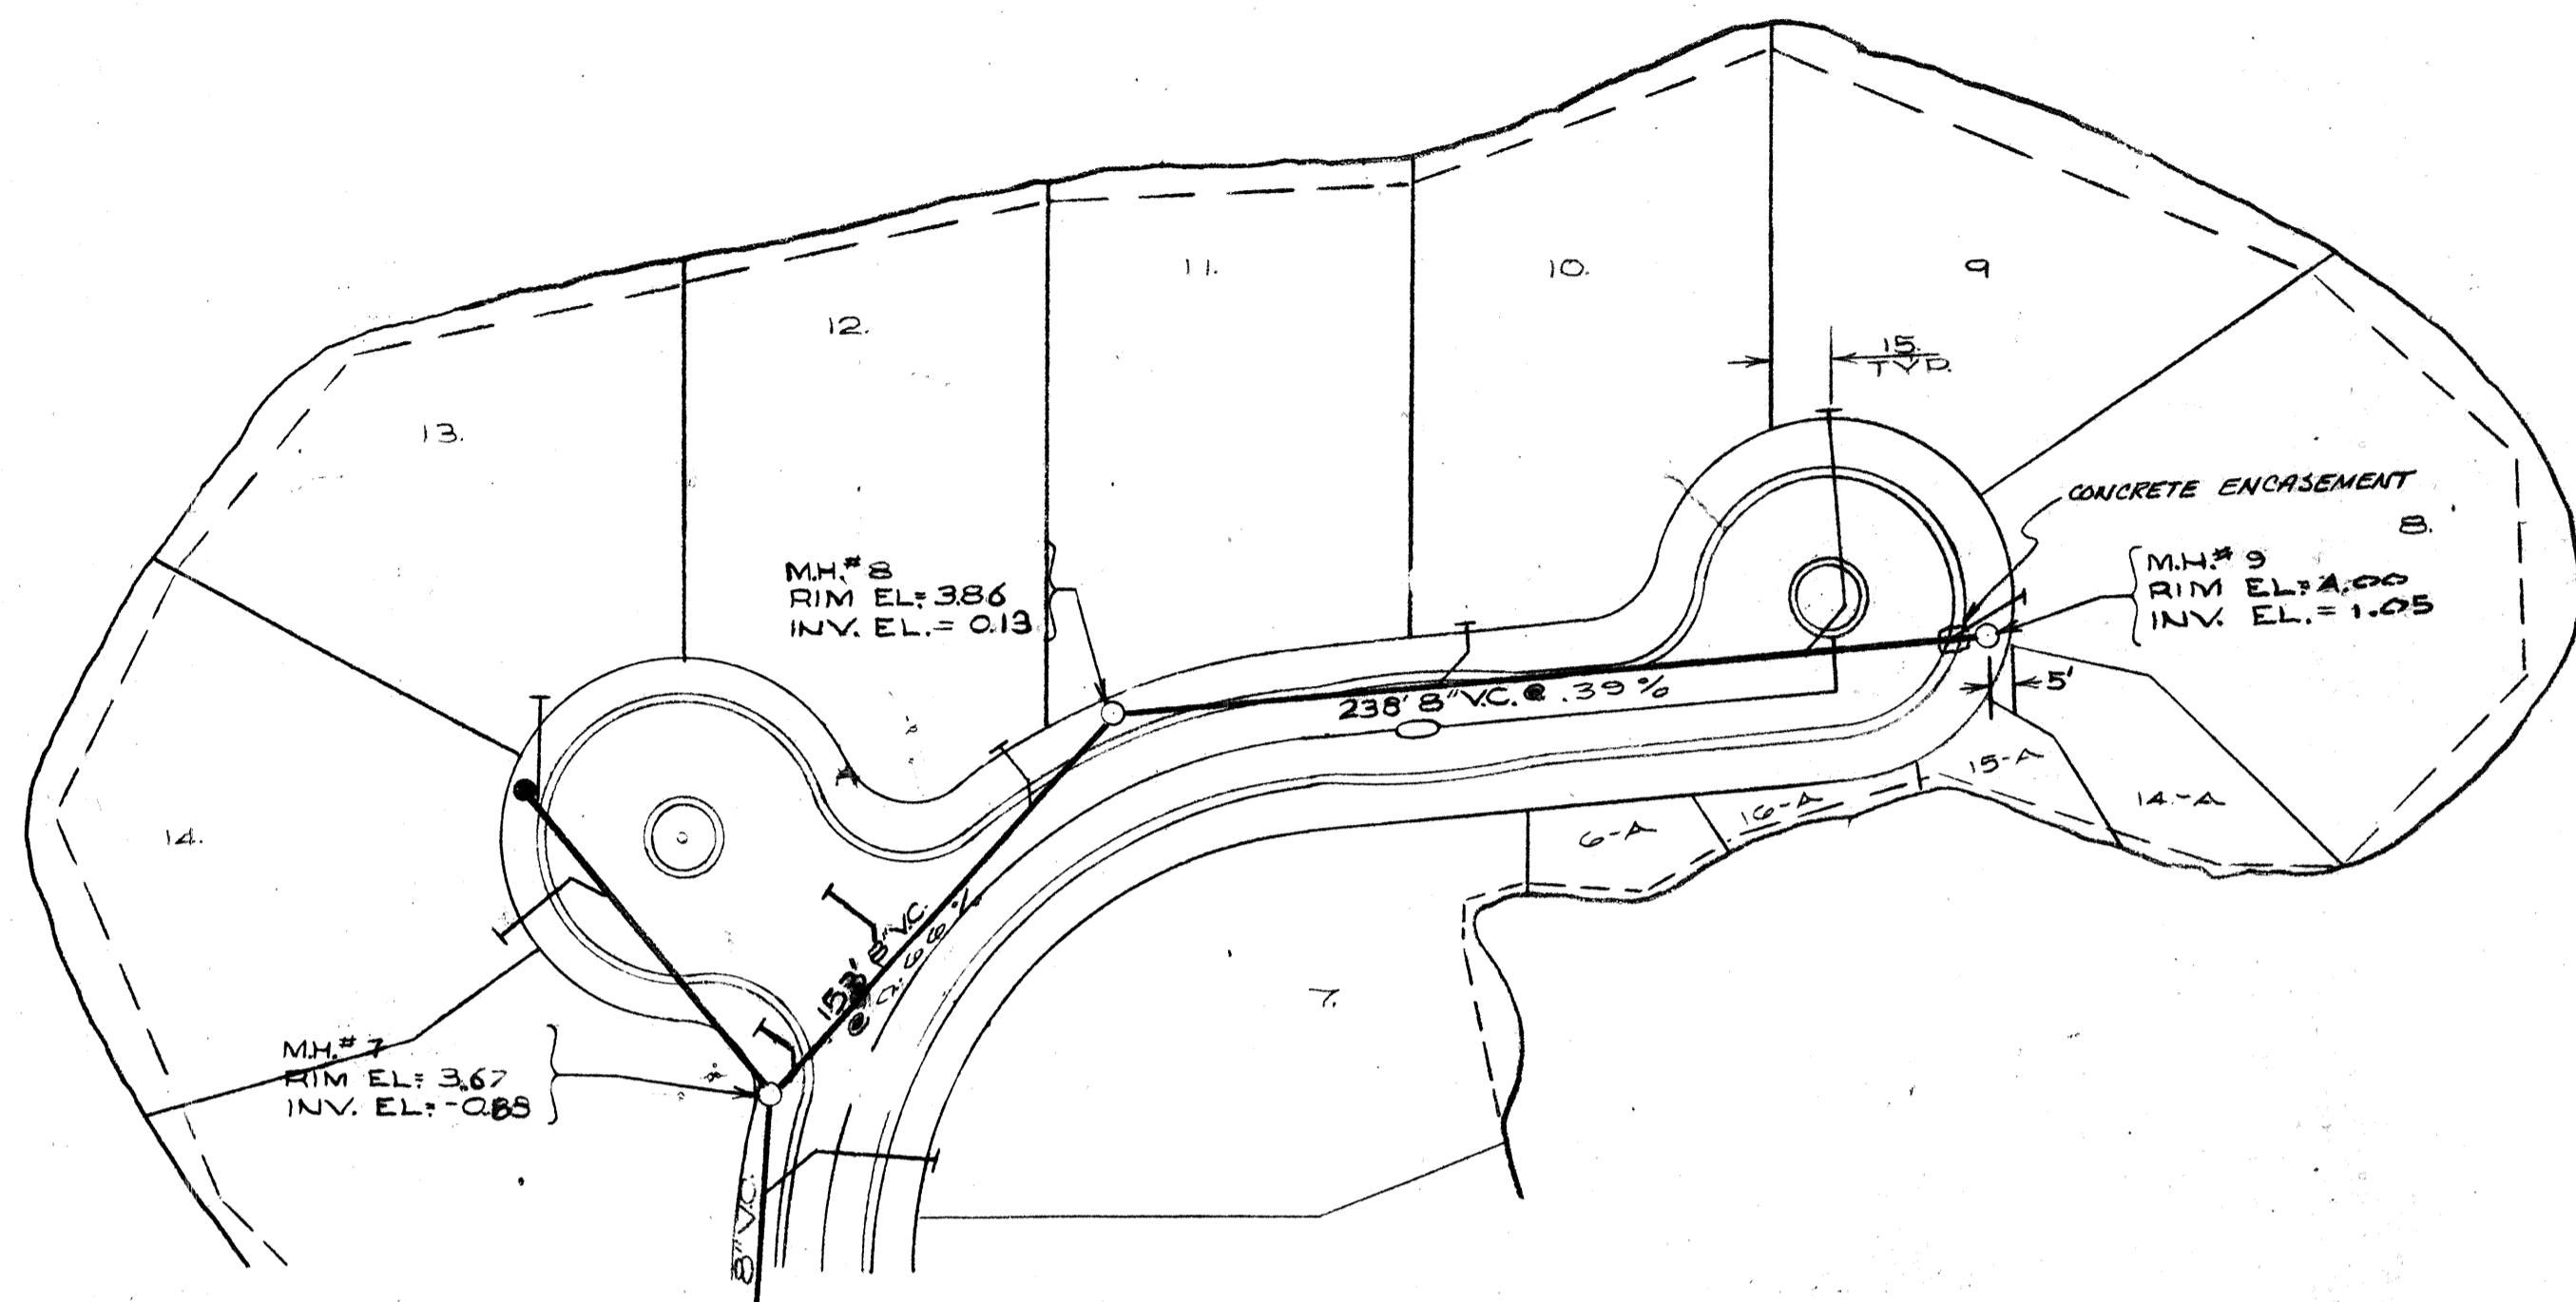

SCALE
 HORIZ: 1" = 50'
 VERT: 1" = 2'

DATE	
BY	
PROFILE	
SURVEYED	
PLOTTED	
NOTE BOOK	
GRADES CHECKED	
INVERT LOCATIONS CHECKED	
No.	

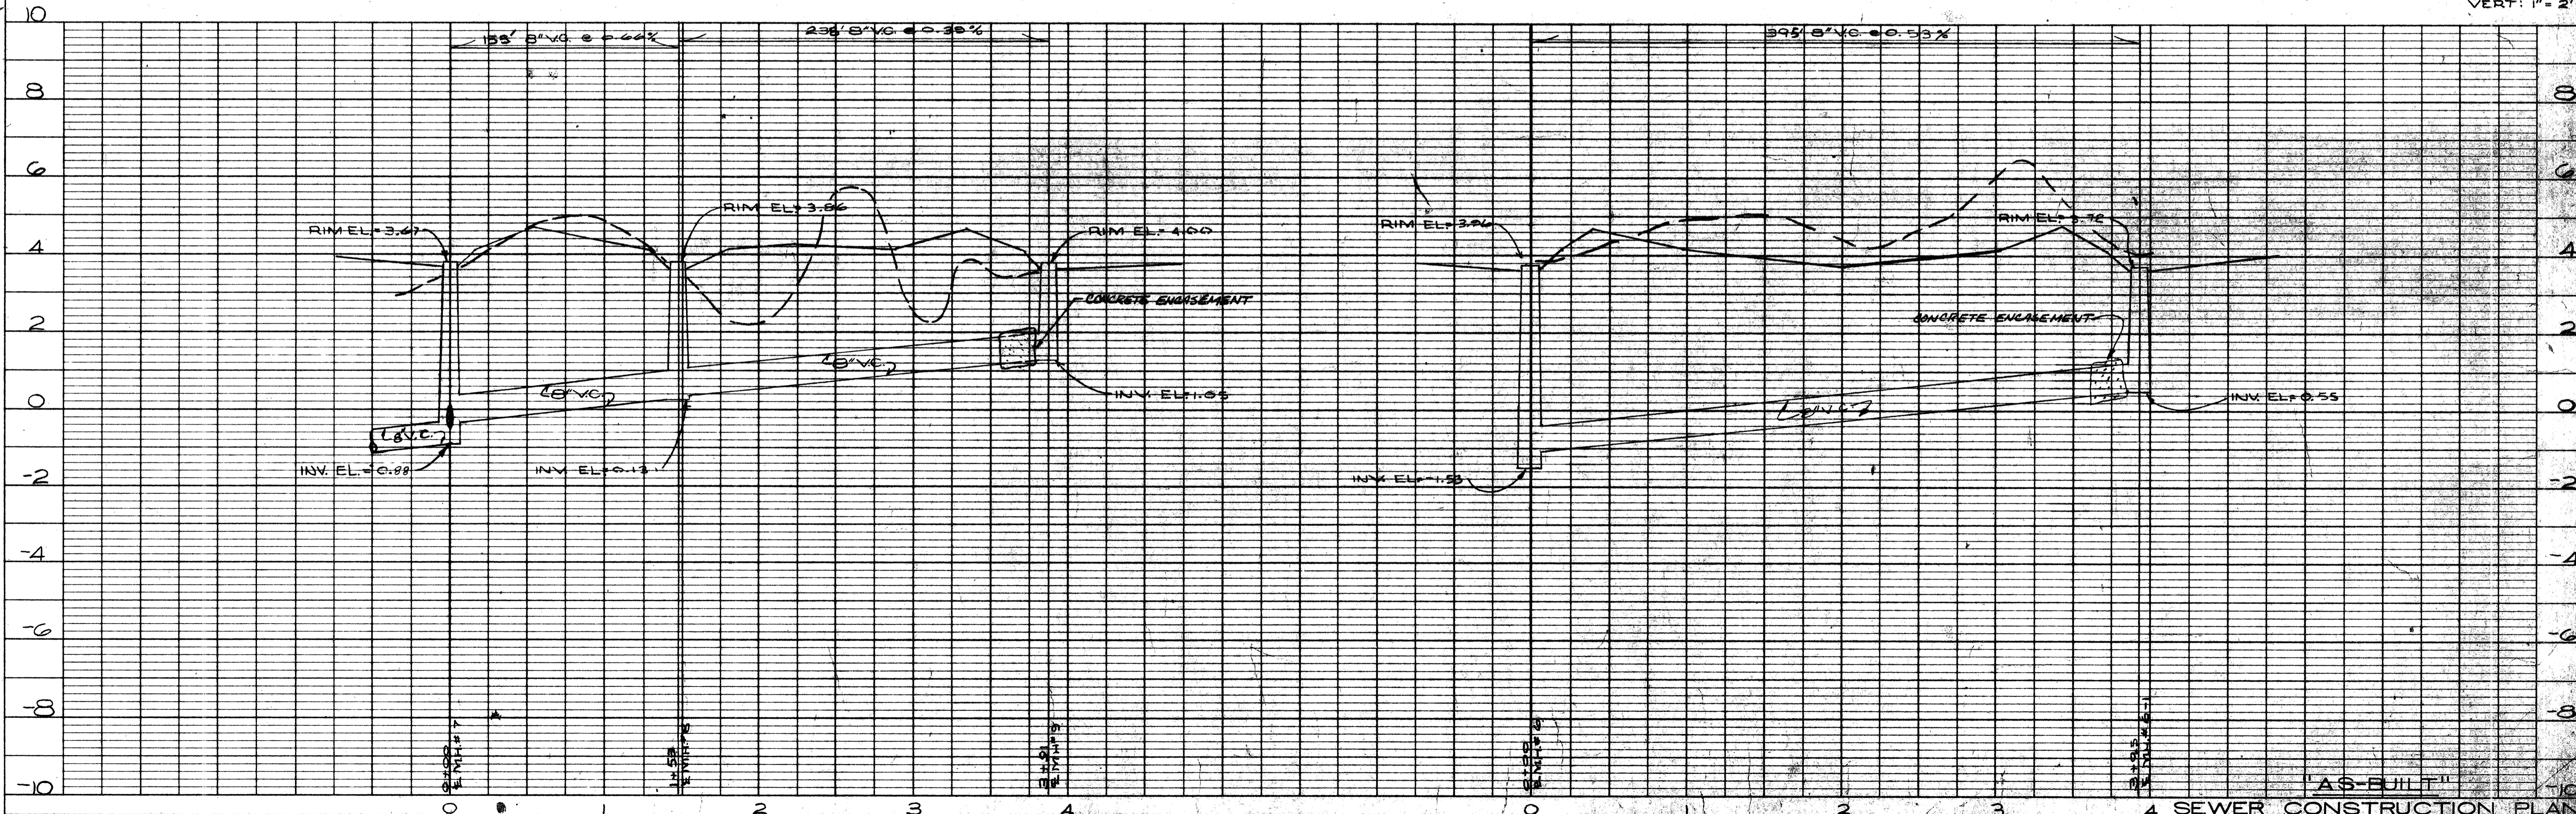


PLATE 1-SINGLE PLAN-PROFILE O.P.R. & R.E. STANDARD
 L. L. RIDGWAY COMPANY, INC.
 100% P&E - MADE IN U.S.A.

"AS-BUILT"
 SEWER CONSTRUCTION PLAN
 FOR
 HIDEAWAY BAY
 SHEET 7 OF 8
 (REVISED 1-12-78)