

PLAN
 SURVEYED _____
 PLOTTED _____
 NOTE BOOK _____
 NO. _____

PROFILE
 SURVEYED _____
 PLOTTED _____
 NOTE BOOK _____
 NO. _____

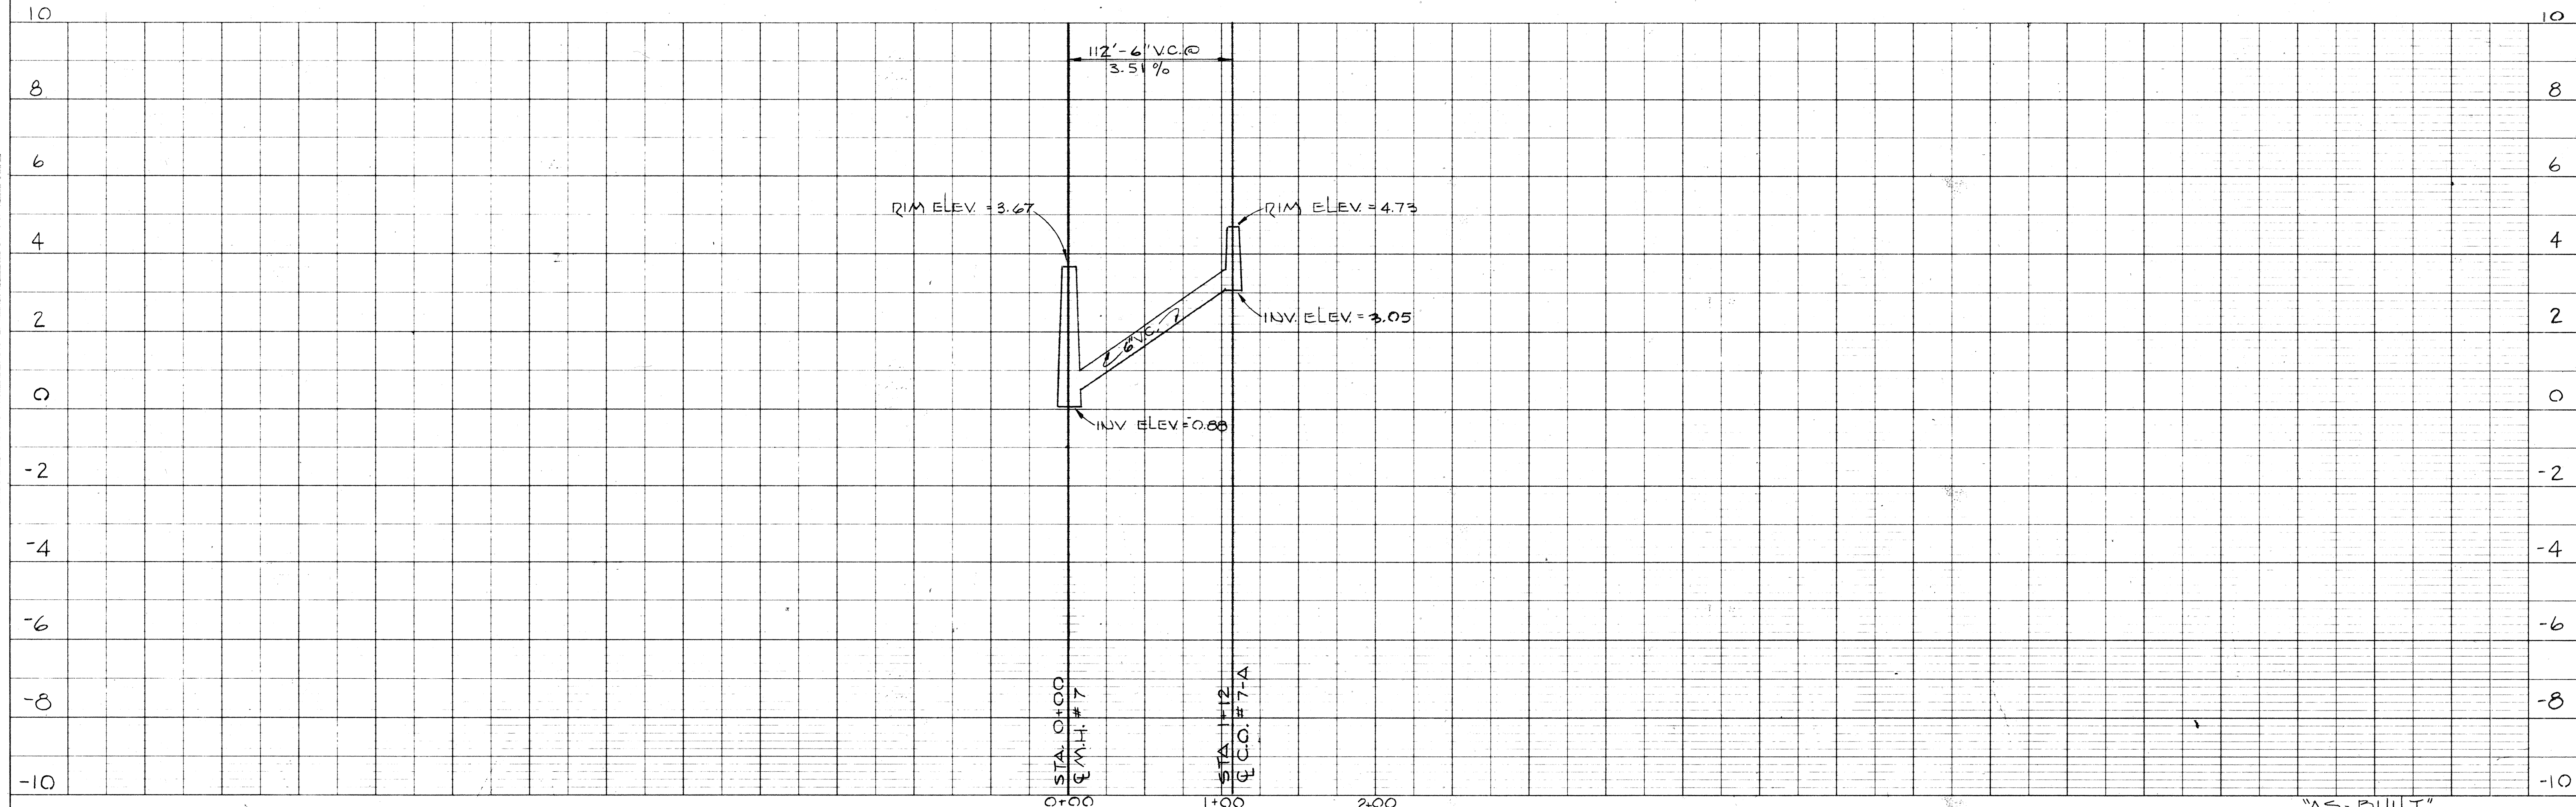
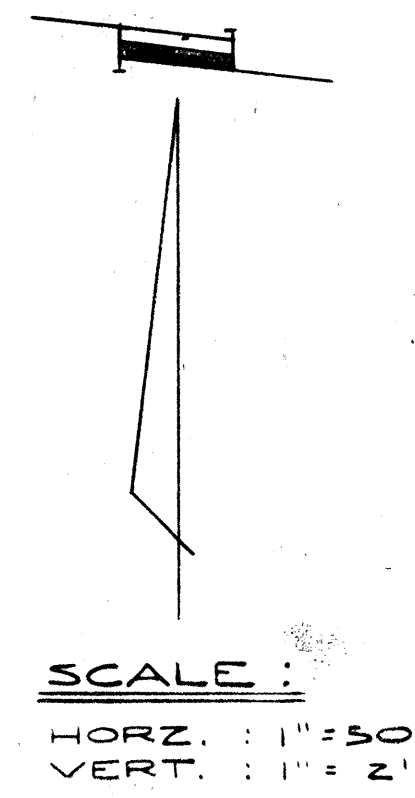
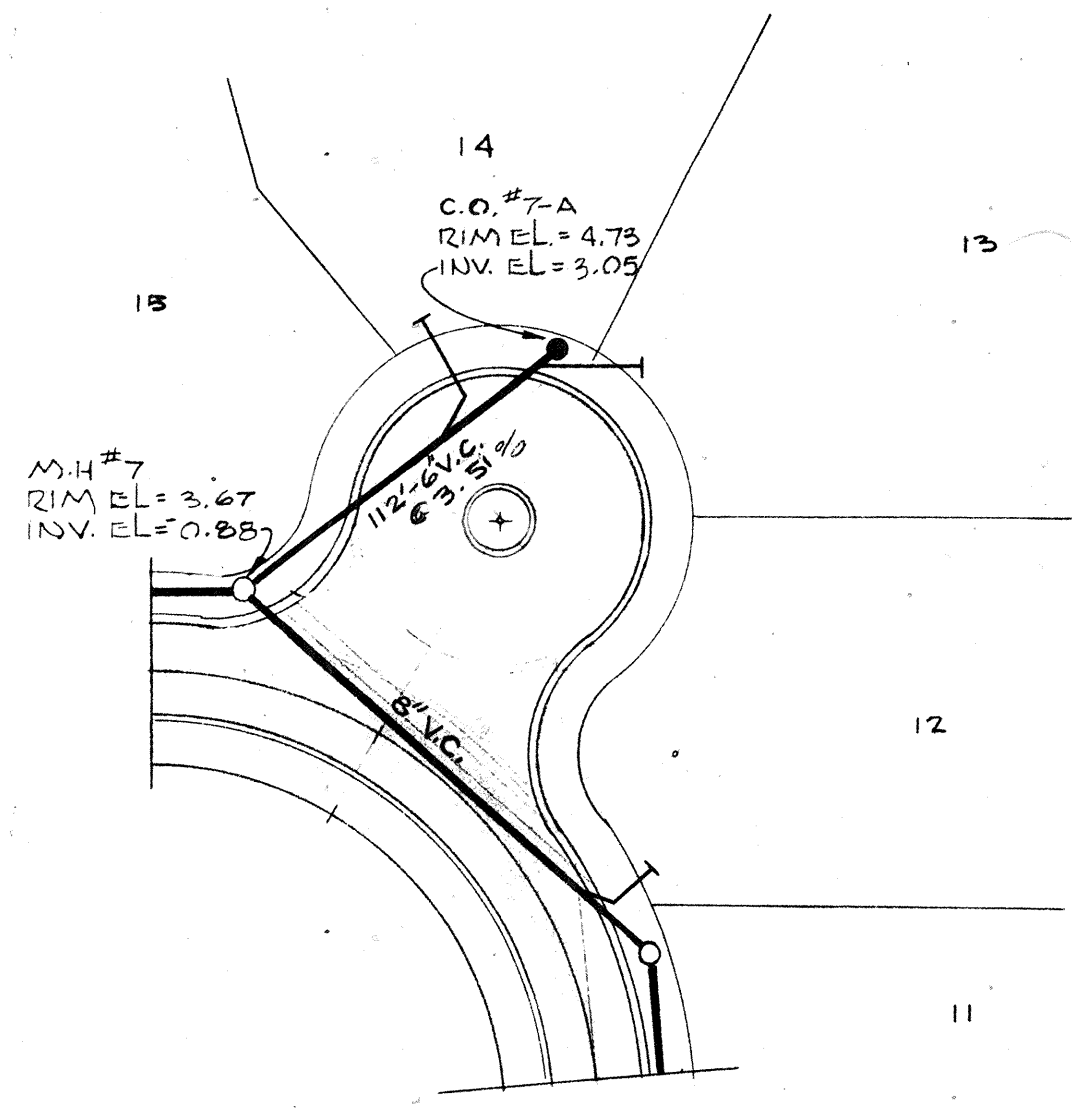


PLATE 1 PLAN-PROFILE O. P. R. & S. E. STANDARD
 100% MAG. AGEPROOF VELLUM—MADE AND PRINTED IN U. S. A.
 EUGENE DIEZGEN CO.

"AS-BUILT"
 SEWER CONSTRUCTION PLAN
 FOR
 HIDEAWAY BAY SHEET 3 OF 3
 (REVISED 1-12-78)