

LONGBOAT KEY GOLF CLUB  
ISLANDSIDE GOLF CLUB

LONGBOAT CLUB ROAD

LAGOON

SANDS POINT CONDOMINIUM

BUILDING No. 6


BUILDING No. 7

SANDS POINT ROAD

LEGEND

- SANITARY SEWER
- STORM SEWER LINE
- WATER MAIN
- PROPANE GAS LINE
- ELECTRICAL CABLE
- MH2H SANITARY MANHOLE
- S7A STORM SEWER MANHOLE
- C.O. CLEAN OUT
- RD-4 ROOF DRAIN
- S13A CATCH BASIN
- x GATE VALVE
- WATER METER
- ELECTRICAL PULL BOX

SANITARY SEWER PROFILE SHEET NO. 251-545 AB  
STORM SEWER PROFILE SHEET NO. 251-509 AB  
SANDS POINT ROAD PROFILE SHEET NO. 251-515 AB

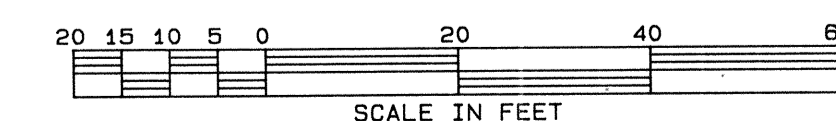

TOWN OF LONGBOAT KEY, FLORIDA		DESIGNED BY PROJECT ENGINEER	
ARVIDA CORPORATION		DATE: 7-7-83	CHECKED BY PROJECT NO.
INN ON THE BEACH — AS BUILT		SCALE: 1" = 20'	DRAWN BY
WATER DISTRIBUTION & SEWAGE COLLECTION		BY	
BENNETT & BISHOP, INC. — CONSULTING ENGINEERS & SURVEYORS — 4509 BEE RIDGE RD. SARASOTA, FLORIDA		REVISION	
ENGINEER & LOCATION		LTR. DATE	
T.L.K. FILE NO.		DATE	
SHEET NUMBER		REVISION	
251-546 AB		DATE	
REVISION		DATE	