


GULF OF MEXICO

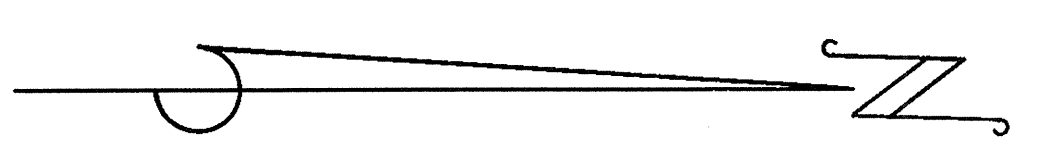

SANITARY SEWER PROFILE
SHEET NO. 251-544 AB
STORM SEWER PROFILE
SHEET NO. 251-509 AB

ENGINEER BY LOCATION	REVISION	L.T.R.	DATE	BY	SCALE:	DATE:	DESIGNED BY
					1" = 40'	12-7-82	PROJECT ENGINEER
T.L.K. FILE NO.	REVISION	L.T.R.	DATE	BY	DRAWN BY	CHECKED BY	PROJECT NO.
					D.H./D.D.	D.H./D.D.	

TOWN OF LONGBOAT KEY, FLORIDA

ARVIDA CORPORATION
INN ON THE BEACH — AS BUILT
WATER DISTRIBUTION & SEWAGE COLLECTION

BENNETT & BISHOP, INC. — CONSULTING ENGINEERS & SURVEYORS — 4509 BEE RIDGE RD. SARASOTA, FLORIDA