



LONGBOAT KEY ISLANDSIDE GOLF CLUB

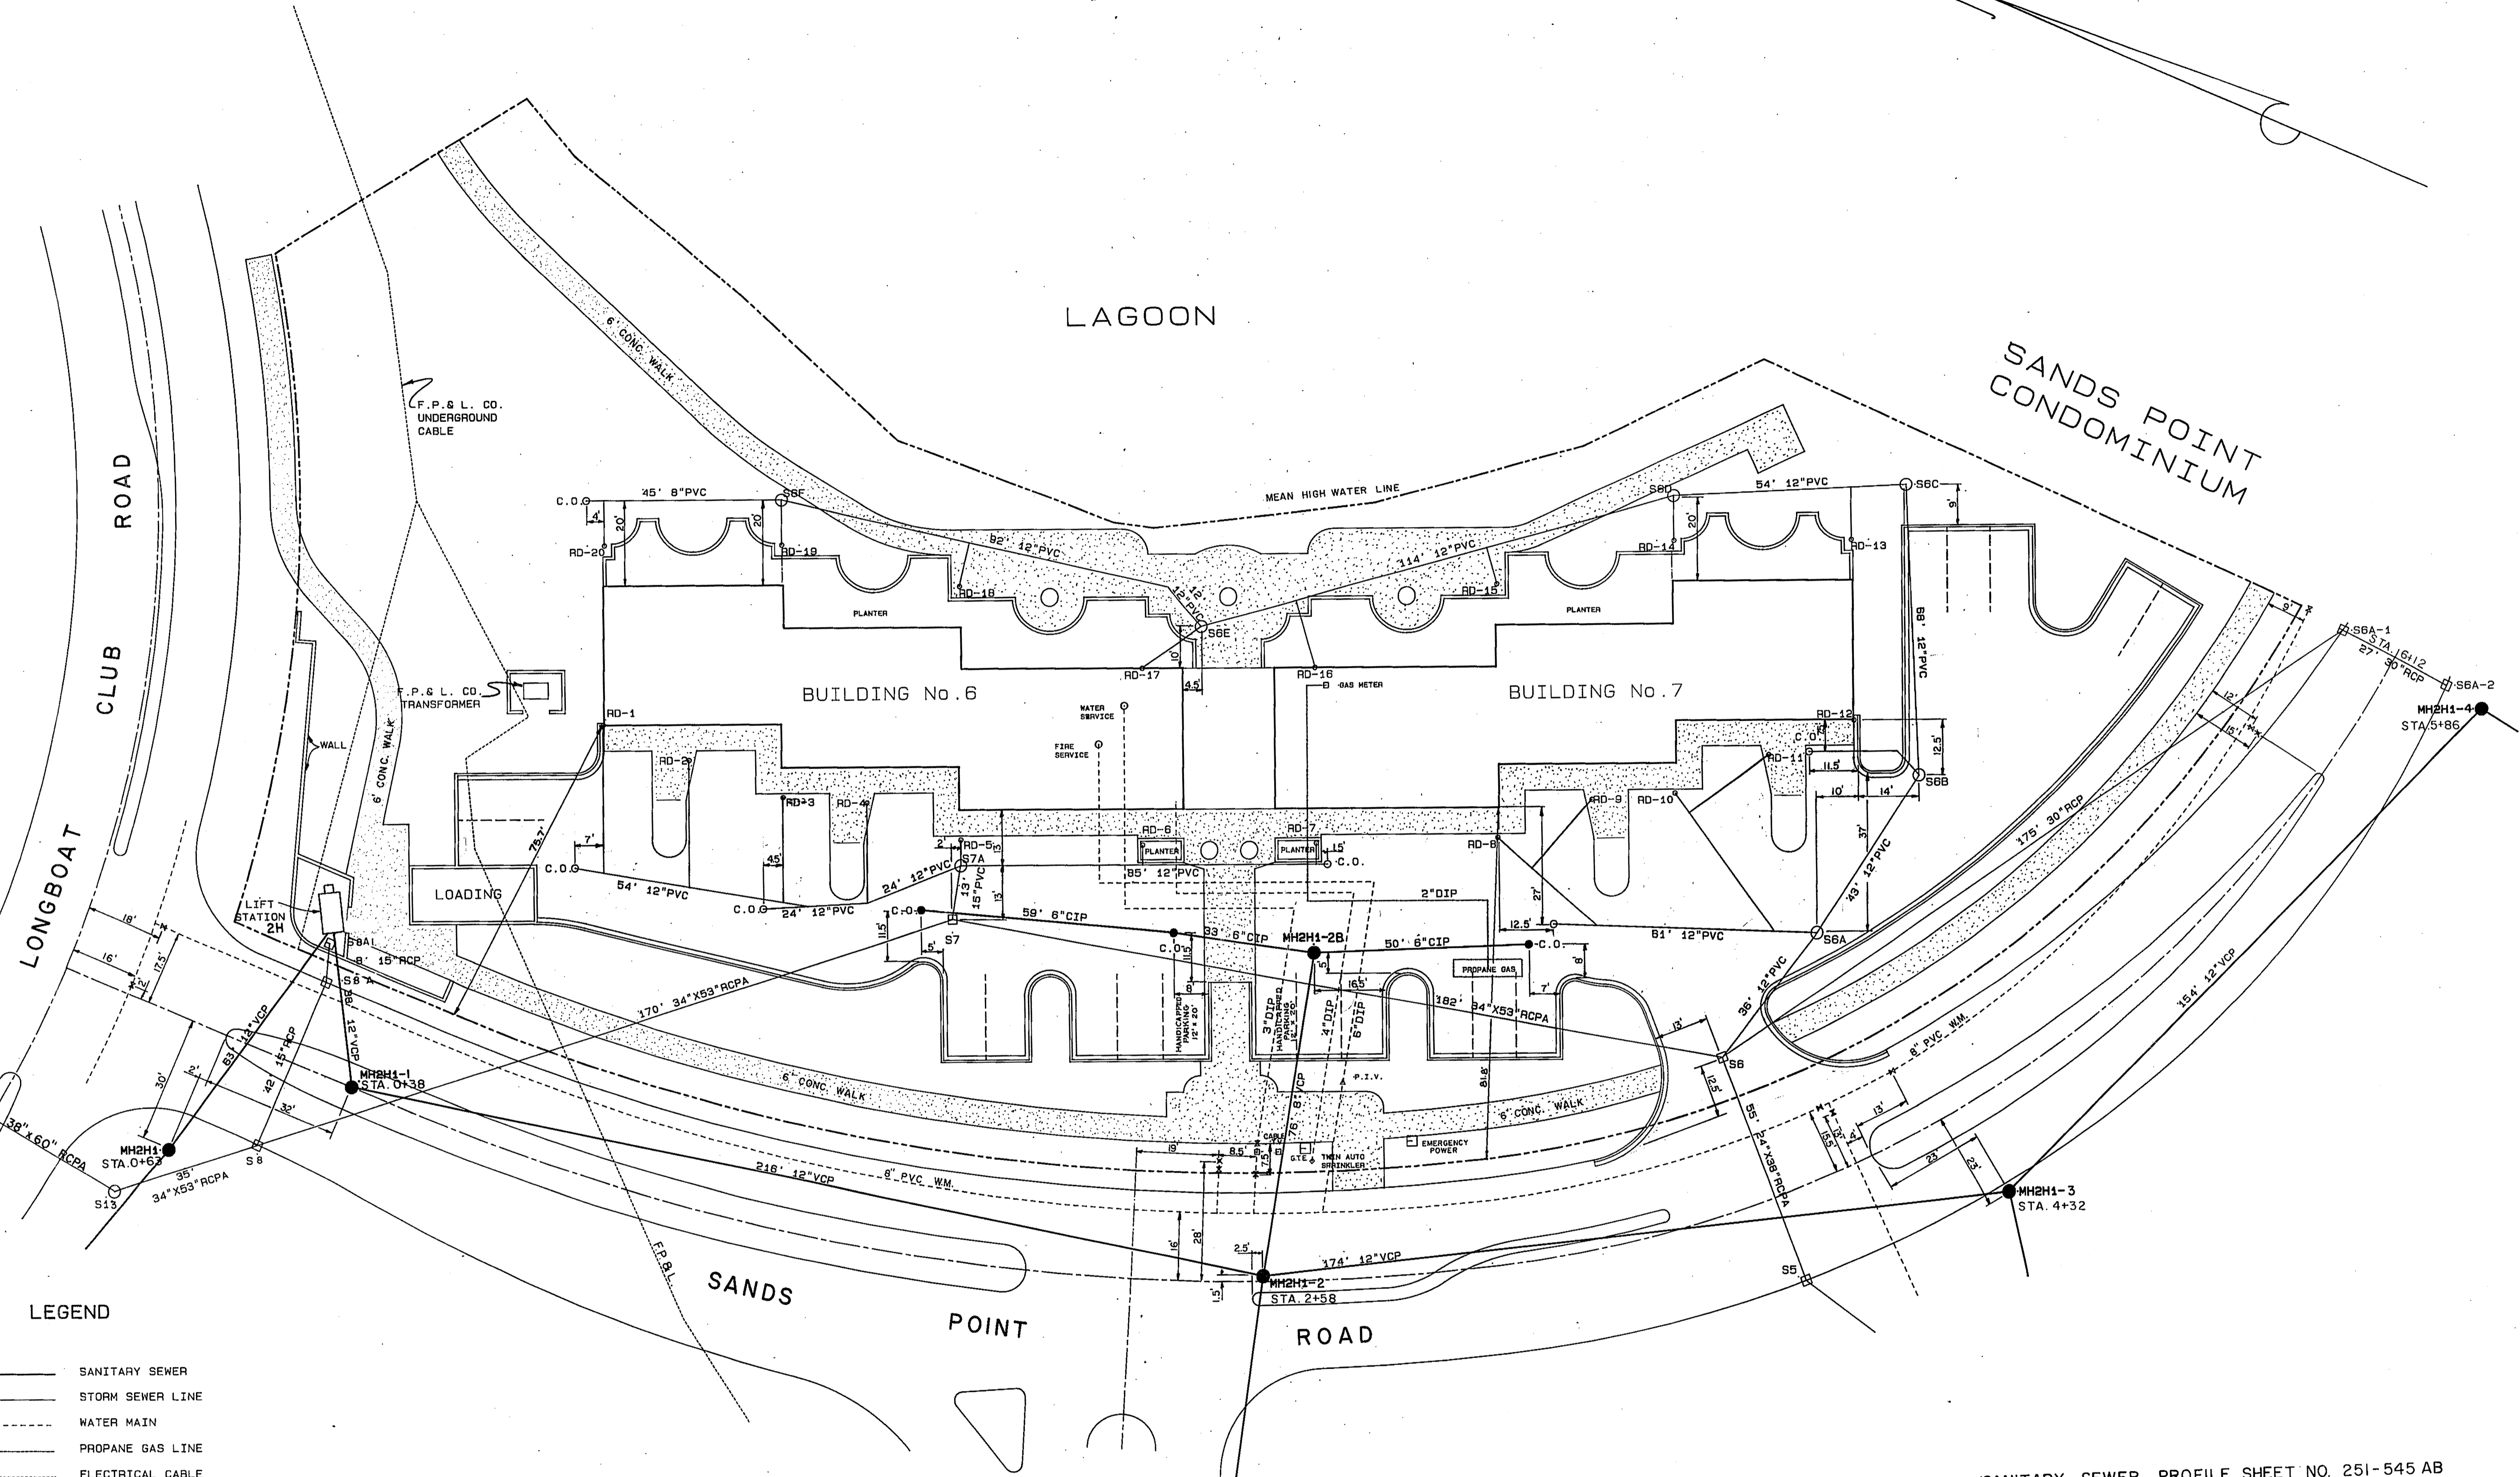

LEGEND

- SANITARY SEWER
- STORM SEWER LINE
- WATER MAIN
- PROPANE GAS LINE
- ELECTRICAL CABLE
- MH2H SANITARY MANHOLE
- S7A STORM SEWER MANHOLE
- C.O. CLEAN OUT
- RD-4 ROOF DRAIN
- S13A DATCH BASIN
- x GATE VALVE
- WATER METER
- ELECTRICAL PULL BOX

SANITARY SEWER PROFILE SHEET NO. 251-545 AB  
 STORM SEWER PROFILE SHEET NO. 251-509 AB  
 SANDS POINT ROAD PROFILE SHEET NO. 251-515 AB

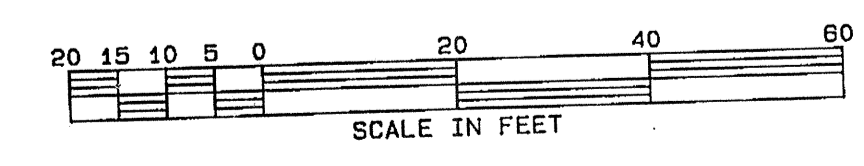

<b>TOWN OF LONGBOAT KEY, FLORIDA</b>		DESIGNED BY PROJECT ENGINEER
ARVIDA CORPORATION		DATE: 7-7-83
INN ON THE BEACH — AS BUILT		SCALE: 1" = 20'
WATER DISTRIBUTION & SEWAGE COLLECTION		DRAWN BY
BENNETT & BISHOP, INC. — CONSULTING ENGINEERS & SURVEYORS — 4509 BEE RIDGE RD. SARASOTA, FLORIDA		CHECKED BY PROJECT NO.
ENGINEER & LOCATION	L.T.R. DATE	BY REVISION
SHEET NUMBER	251-546 AB	
REVISION	T.L.K. FILE NO.	