


PHASE II

"INN ON THE BEACH" PHASE II CONDOMINIUM BOOK 19 PG. 25C

SEE SHEET NO. 251-535 AB

MATCH LINE

MATCH LINE

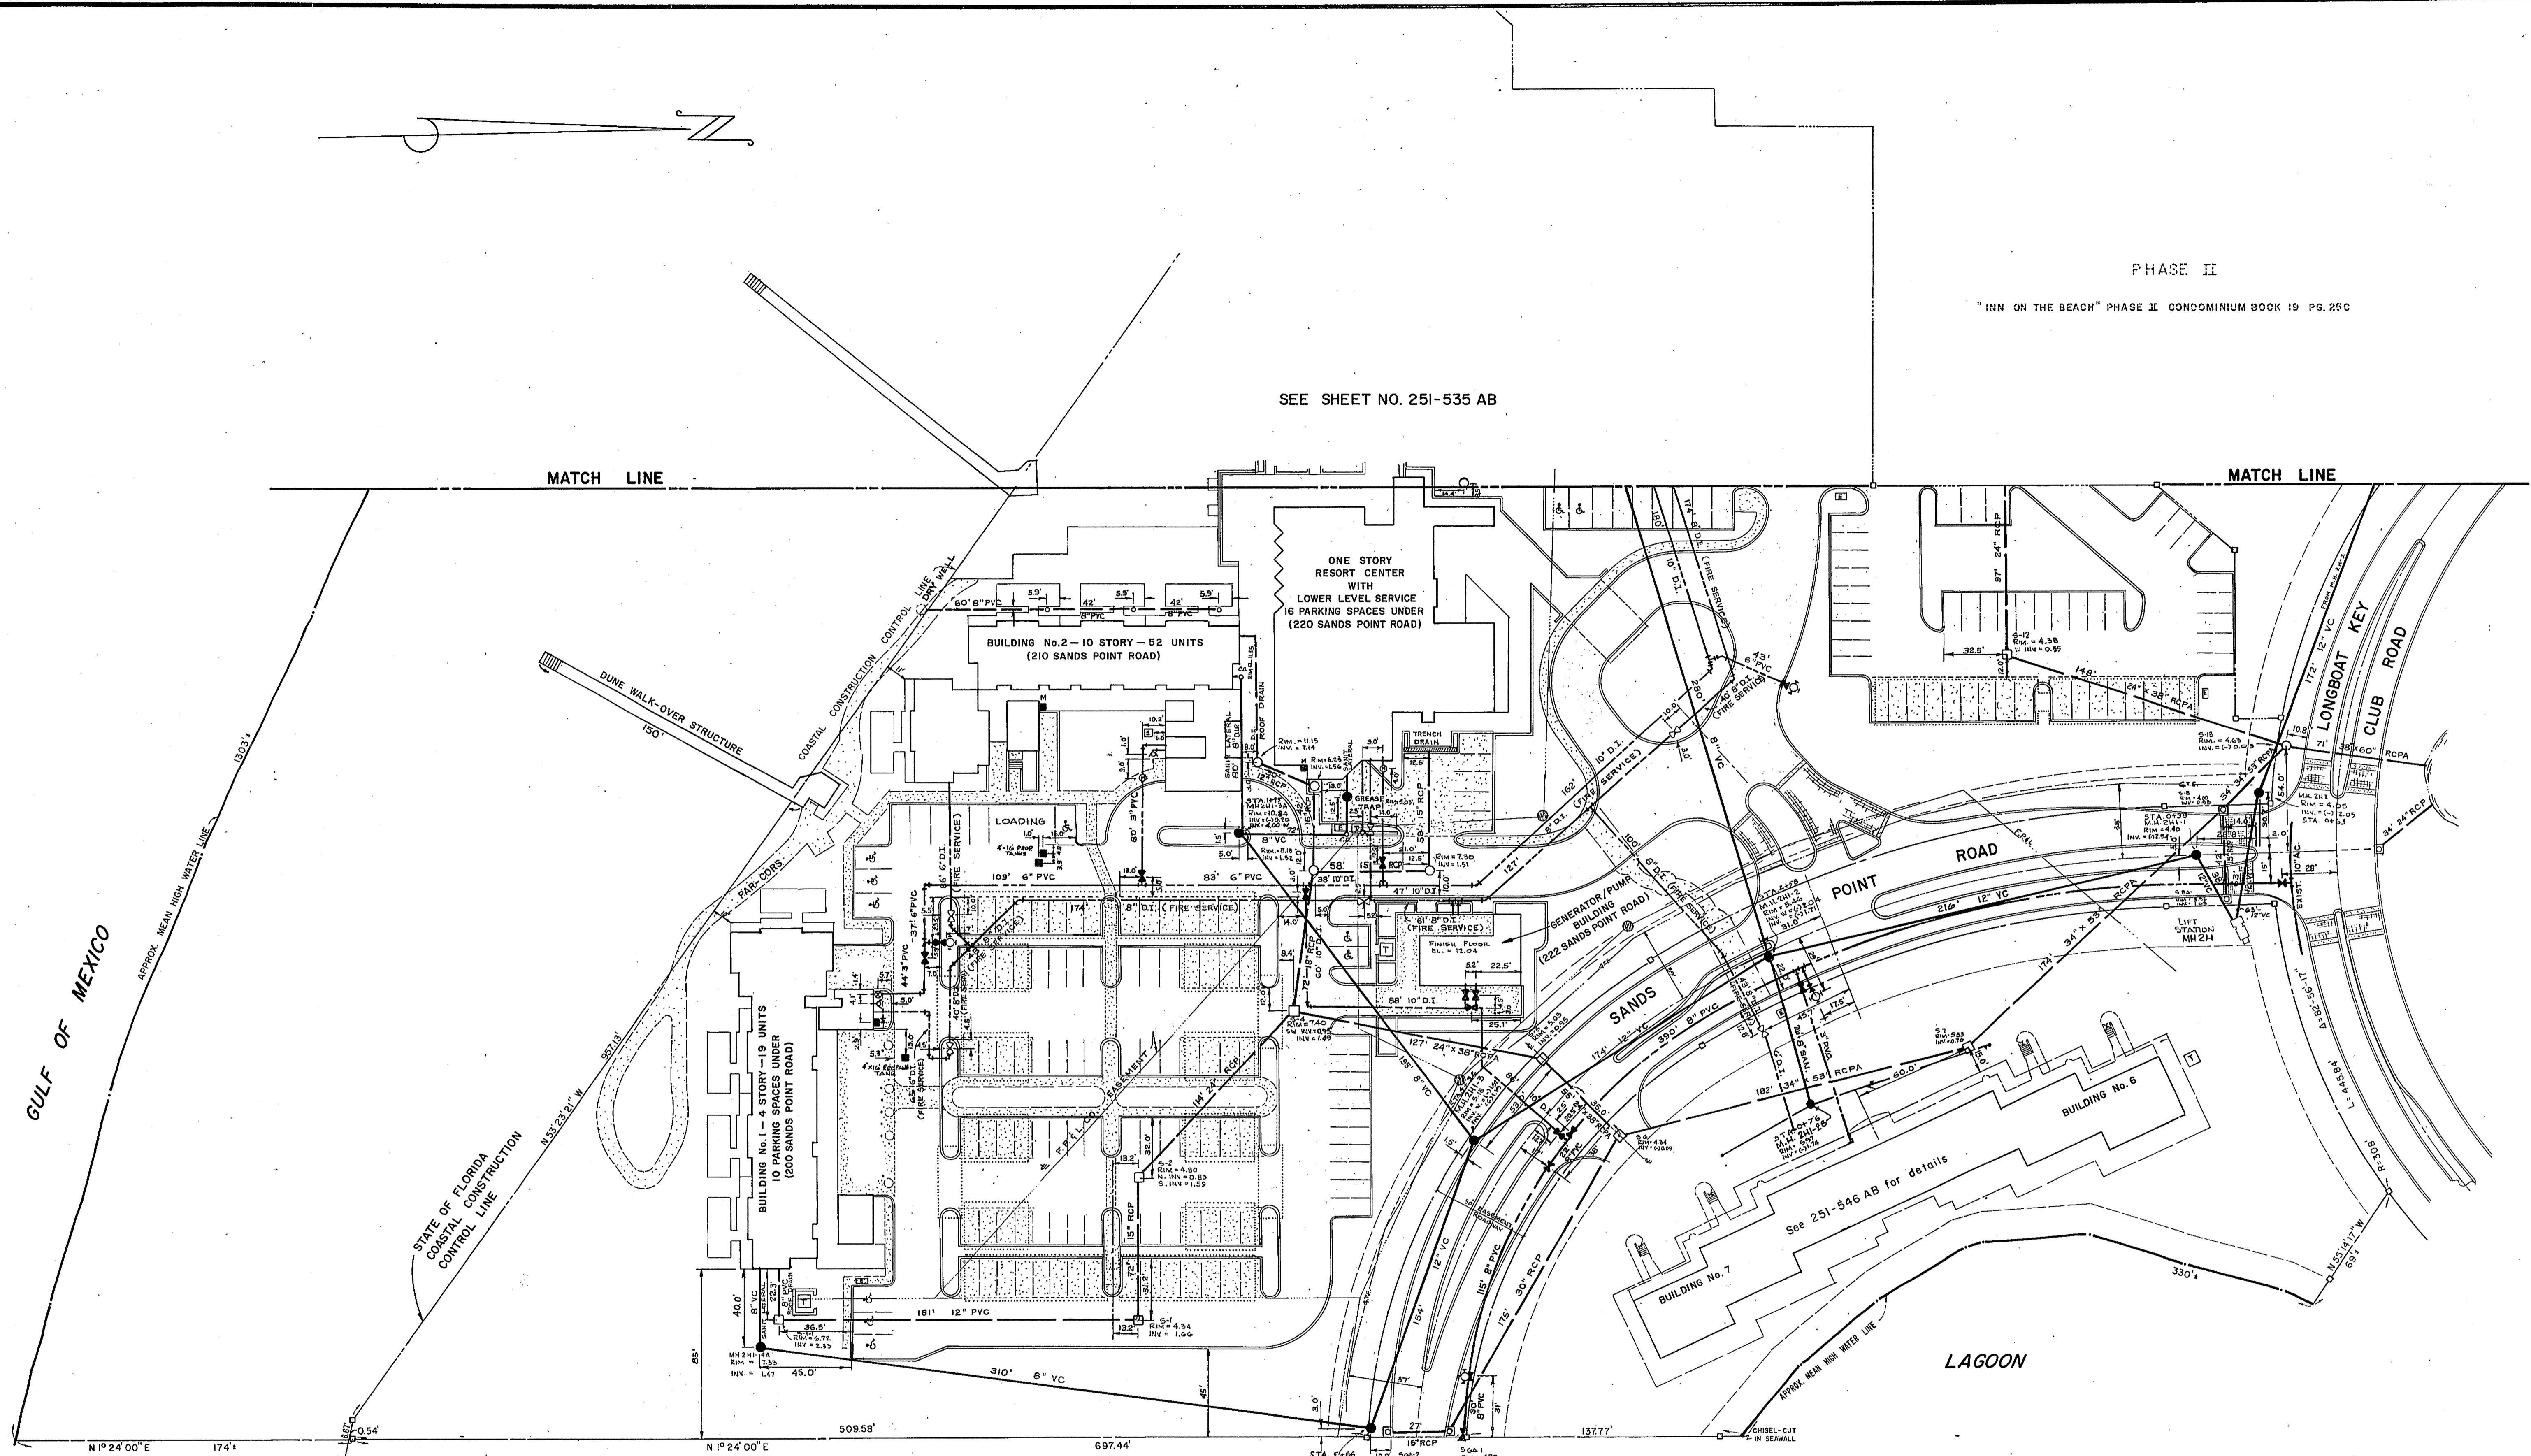

GULF OF MEXICO

LAGOON

LEGEND

- SANITARY SEWERS
- STORM SEWERS
- |— WATER DISTRIBUTION MAINS
- X— GATE VALVES (WATER)
- ◇— PRESSURE INDICATOR VALVE (WATER)
- ⊕— FIRE HYDRANT
- WATER METER
- △— FIRE SERVICE CONNECTION
- PROPANE GAS METER
- PROPANE GAS VALVE
- TRANSFORMER
- MANHOLE, } F.P. & L. Co.
- PULL BOX

| | |
|---|-------------------------|
| DESIGNED BY | PROJECT ENGINEER |
| DATE: | 12 - 7 - 82 |
| SCALE: | 1" = 40' |
| DRAWN BY | D.H./D.D. |
| BY | REVISION |
| LTR. DATE | REVISION |
| TOWN OF LONGBOAT KEY, FLORIDA | |
| ARVIDA CORPORATION | |
| INN ON THE BEACH — AS BUILT | |
| WATER DISTRIBUTION & SEWAGE COLLECTION | |
| BENNETT & BISHOP, INC. — CONSULTING ENGINEERS & SURVEYORS — 4509 BEE RIDGE RD. SARASOTA, FLORIDA | |
| ENGINEER & LOCATION | T.L.K. FILE NO. |
| SHEET NUMBER | 251-534 AB |
| REVISION | REVISION |