


NOTE: THIS PLAN IS FOR USE FOR WATERLINES ONLY

NORTH BUILDING: CONTRACTOR TO REMOVE TEMP. BLOW-OFF & INSTALL ±120 L.F. OF 6" WATER MAIN & FIRE HYDRANT


REFER TO DETAIL AT LEFT & ON DWG. 12 FOR ADDITIONAL INFORMATION

NOTE: DATA IN BRACKETS CONFORM DRAWINGS TO CONSTRUCTION RECORDS BY TRLD SEPTEMBER, 1992

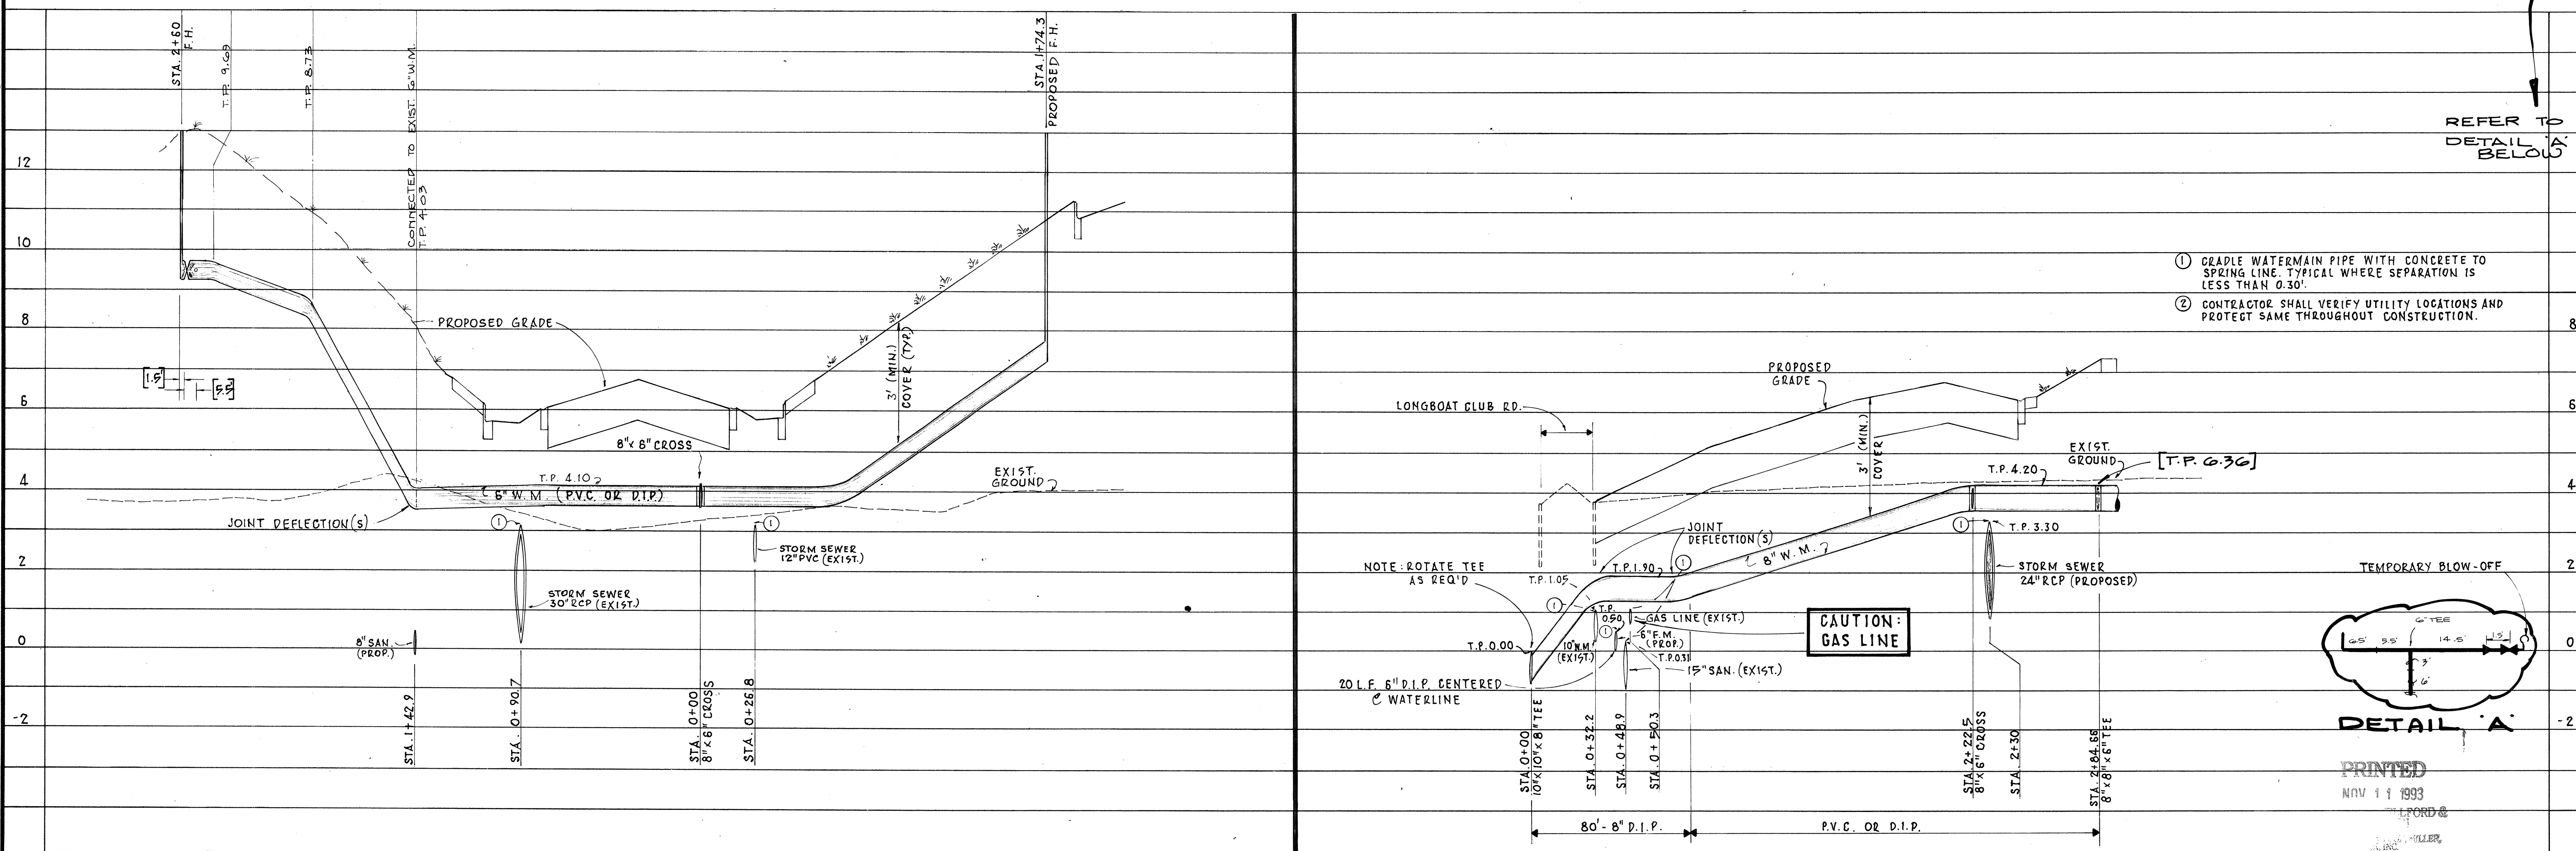

- 1 GRADLE WATERMAIN PIPE WITH CONCRETE TO SPRING LINE TYPICAL WHERE SEPARATION IS LESS THAN 0.30'
- 2 CONTRACTOR SHALL VERIFY UTILITY LOCATIONS AND PROTECT SAME THROUGHOUT CONSTRUCTION.

CAUTION: GAS LINE

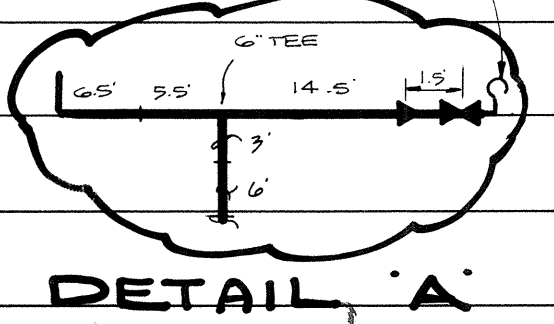

FOR: YALE PROPERTIES	DESIGNED BY: MILLARD J. JODER, P.E.
L'AMBIANCE	DATE: DEC. 1990
WATERLINE PLAN & PROFILE	BY: M. J. J.
SMALLY, WELLFORD & NALVEN, INC.	CHECKED BY: M. J. J.
CONSULTING ENGINEERS & SURVEYORS	DRAWN BY: E.P.
133 SOUTH MCINTOSH RD.	PROJECT NO: 2591
SARASOTA, FLA. 33582	FL. CERT. NO.
INDEX NO. G-2591-031	
REVISION: 1	