


NOTE: THIS PLAN IS INTENDED FOR USE ONLY AS SANITARY SEWER PLAN + PROFILE.

NOTE: DATA IN BRACKETS CONFORM DRAWINGS TO CONSTRUCTION RECORDS BY TRI-D SEPTEMBER 1992

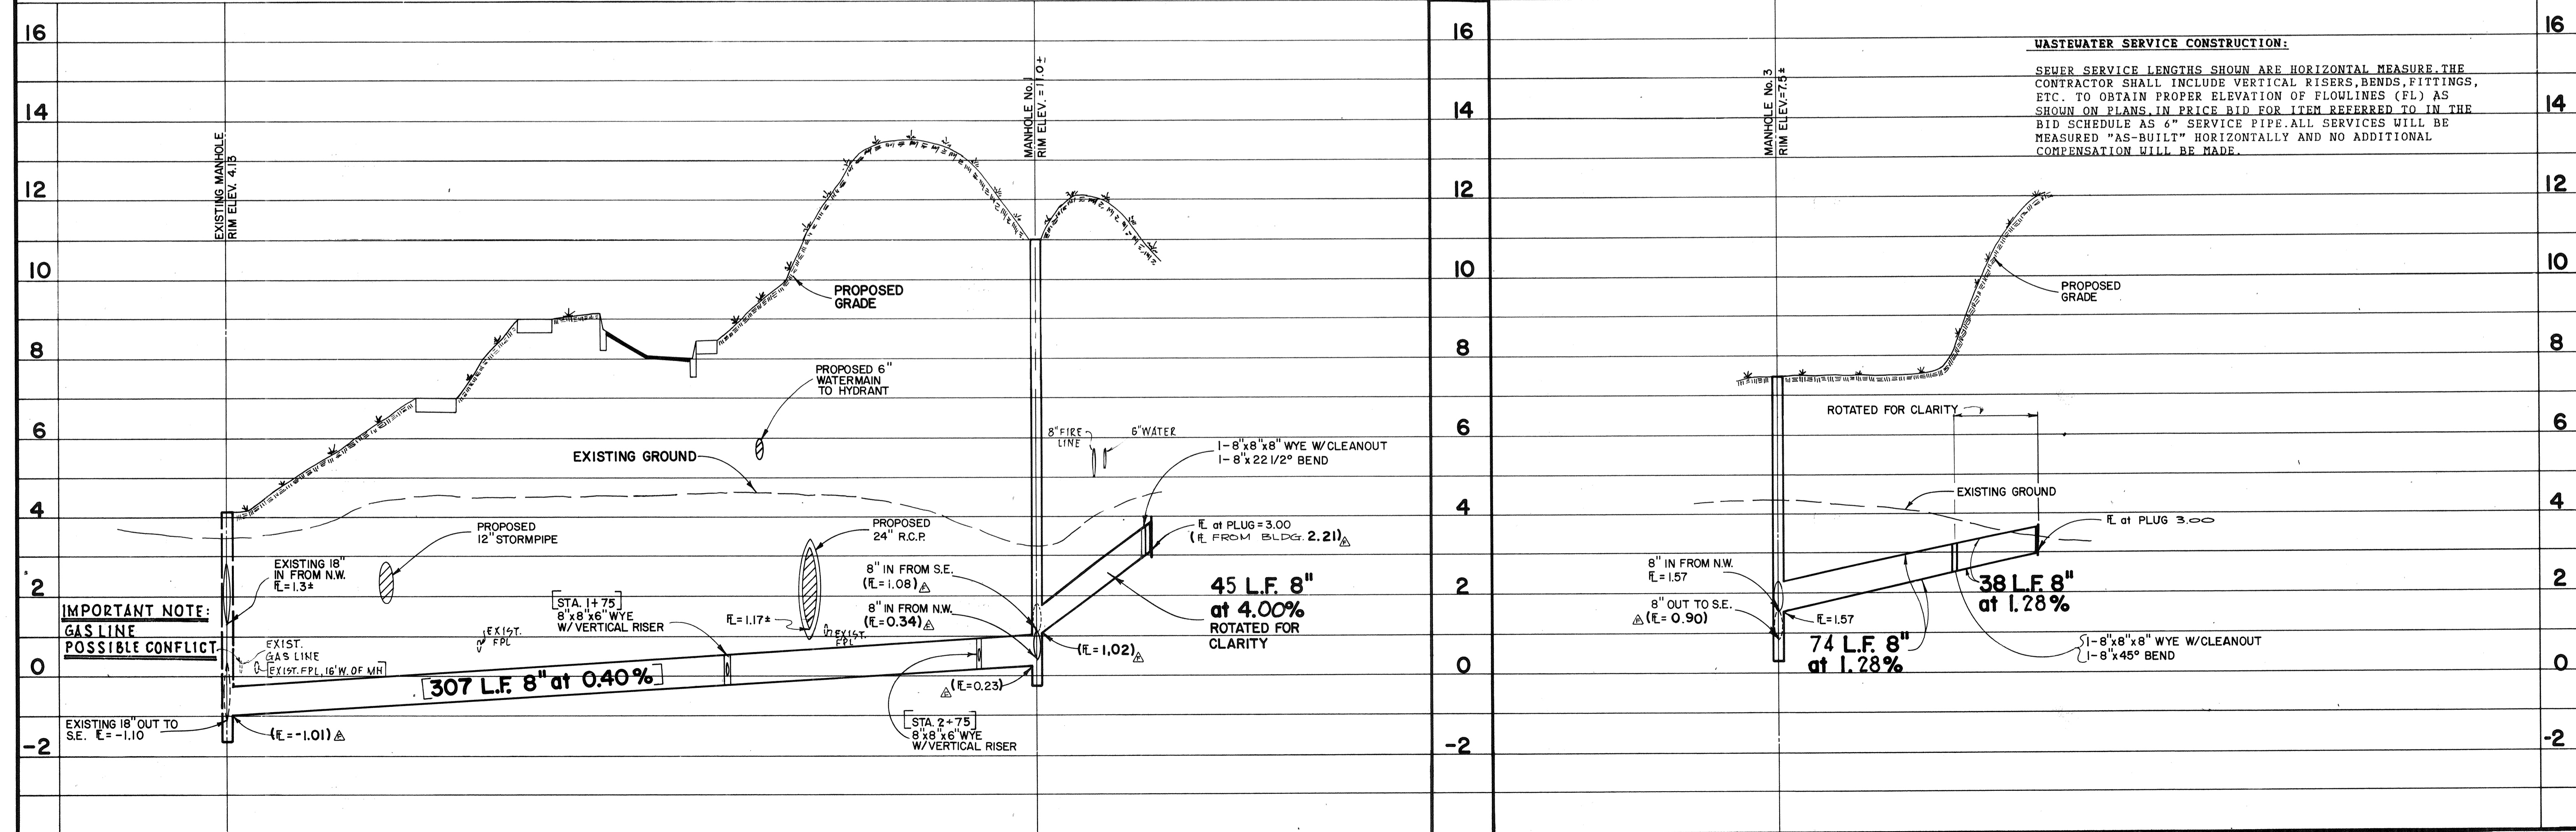

WASTEWATER SERVICE CONSTRUCTION:
SEWER SERVICE LENGTHS SHOWN ARE HORIZONTAL MEASURE. THE CONTRACTOR SHALL INCLUDE VERTICAL RISERS, BENDS, FITTINGS, ETC. TO OBTAIN PROPER ELEVATION OF FLOWLINES (FL) AS SHOWN ON PLANS. IN PRICE BID FOR ITEM REFERRED TO IN THE BID SCHEDULE AS 6" SERVICE PIPE. ALL SERVICES WILL BE MEASURED "AS-BUILT" HORIZONTALLY AND NO ADDITIONAL COMPENSATION WILL BE MADE.

IMPORTANT NOTE:
GAS LINE
POSSIBLE CONFLICT

DATE	10/2/90	DESIGNED BY	J.M.B.
BY	M.T.P.	DATE	7/90
REVISION	1	CHECKED BY	J.M.B.
		DRAWN BY	R.B.K.
		PROJECT NO	2591
		DESIGNED BY	J.M.B.
		CHECKED BY	R.B.K.
		DRAWN BY	R.B.K.
		PROJECT NO	2591
		DESIGNED BY	J.M.B.
		CHECKED BY	R.B.K.
		DRAWN BY	R.B.K.
		PROJECT	