
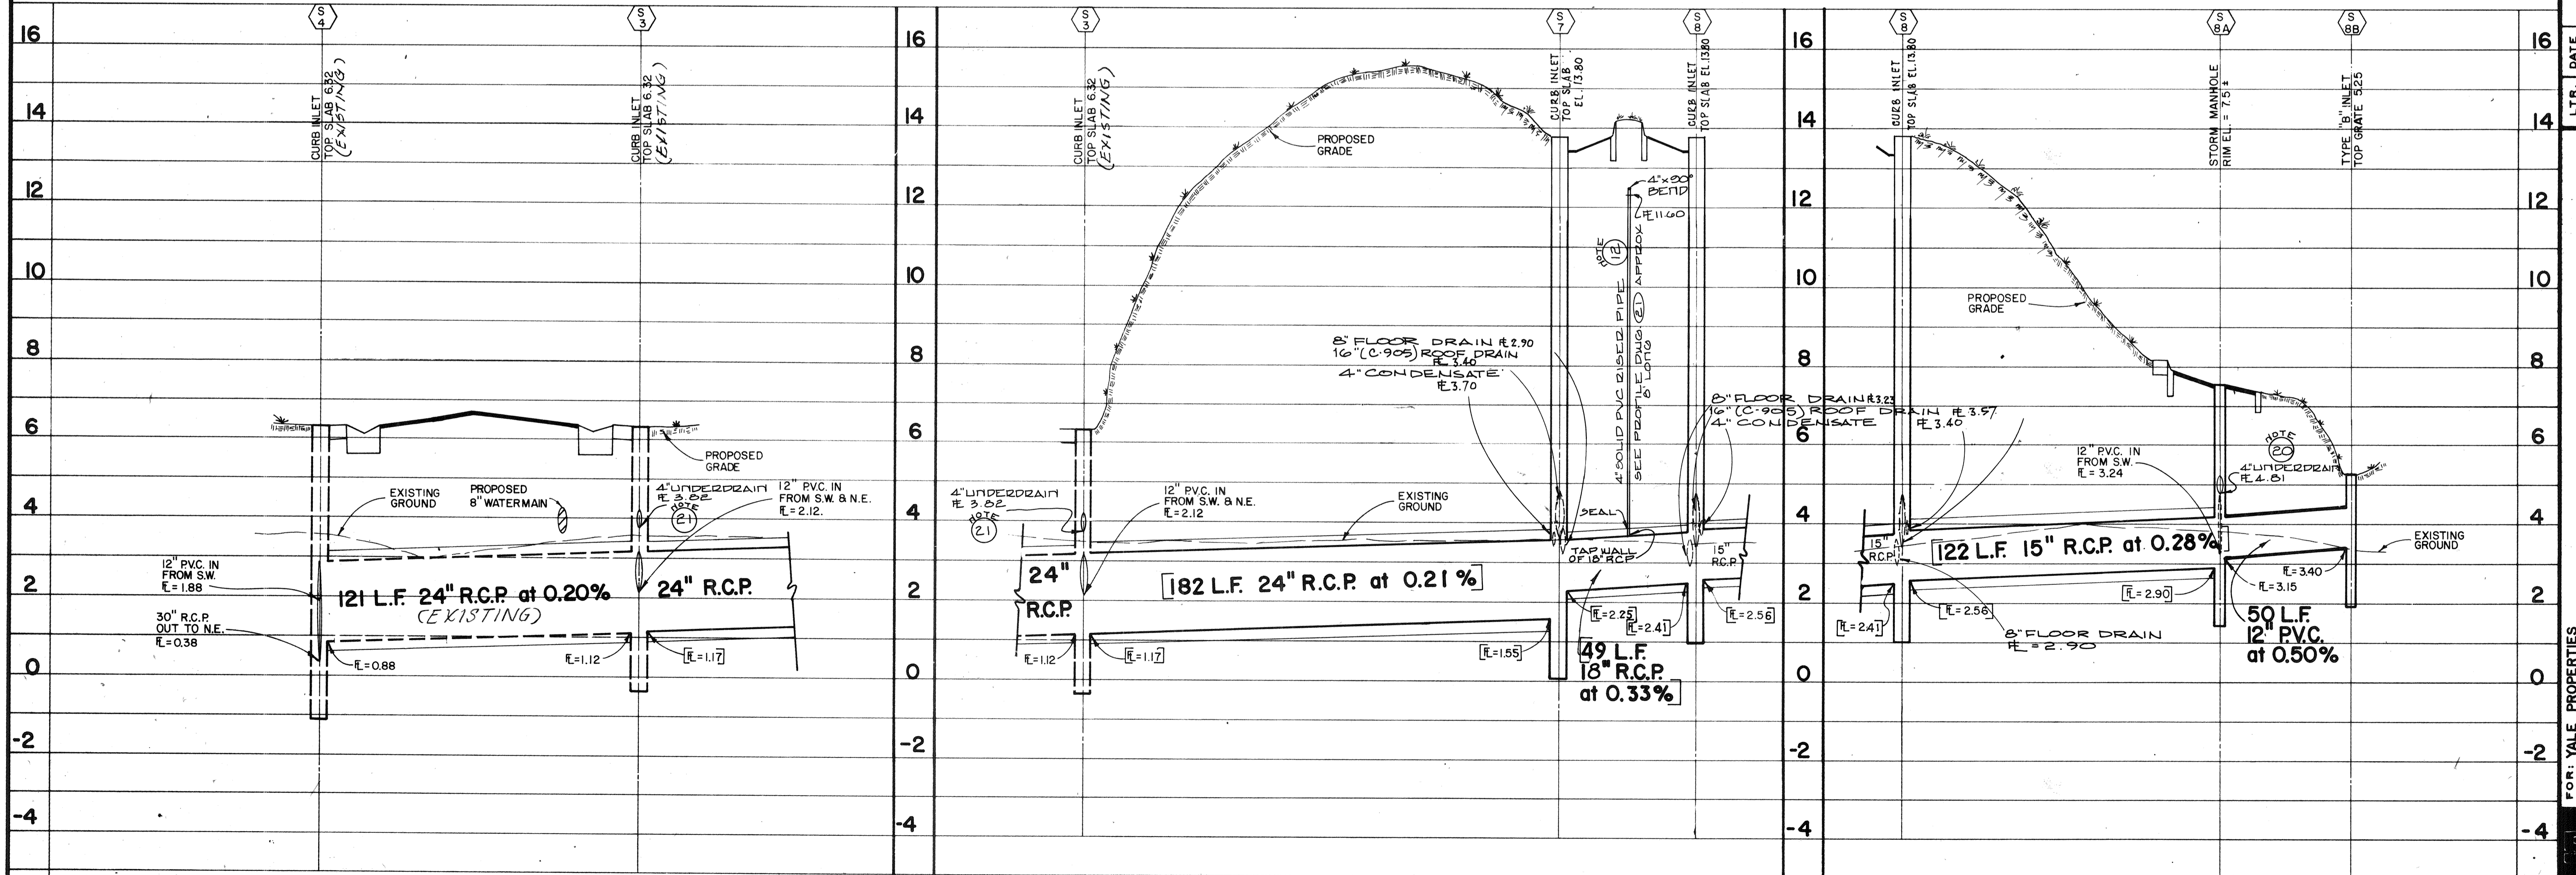
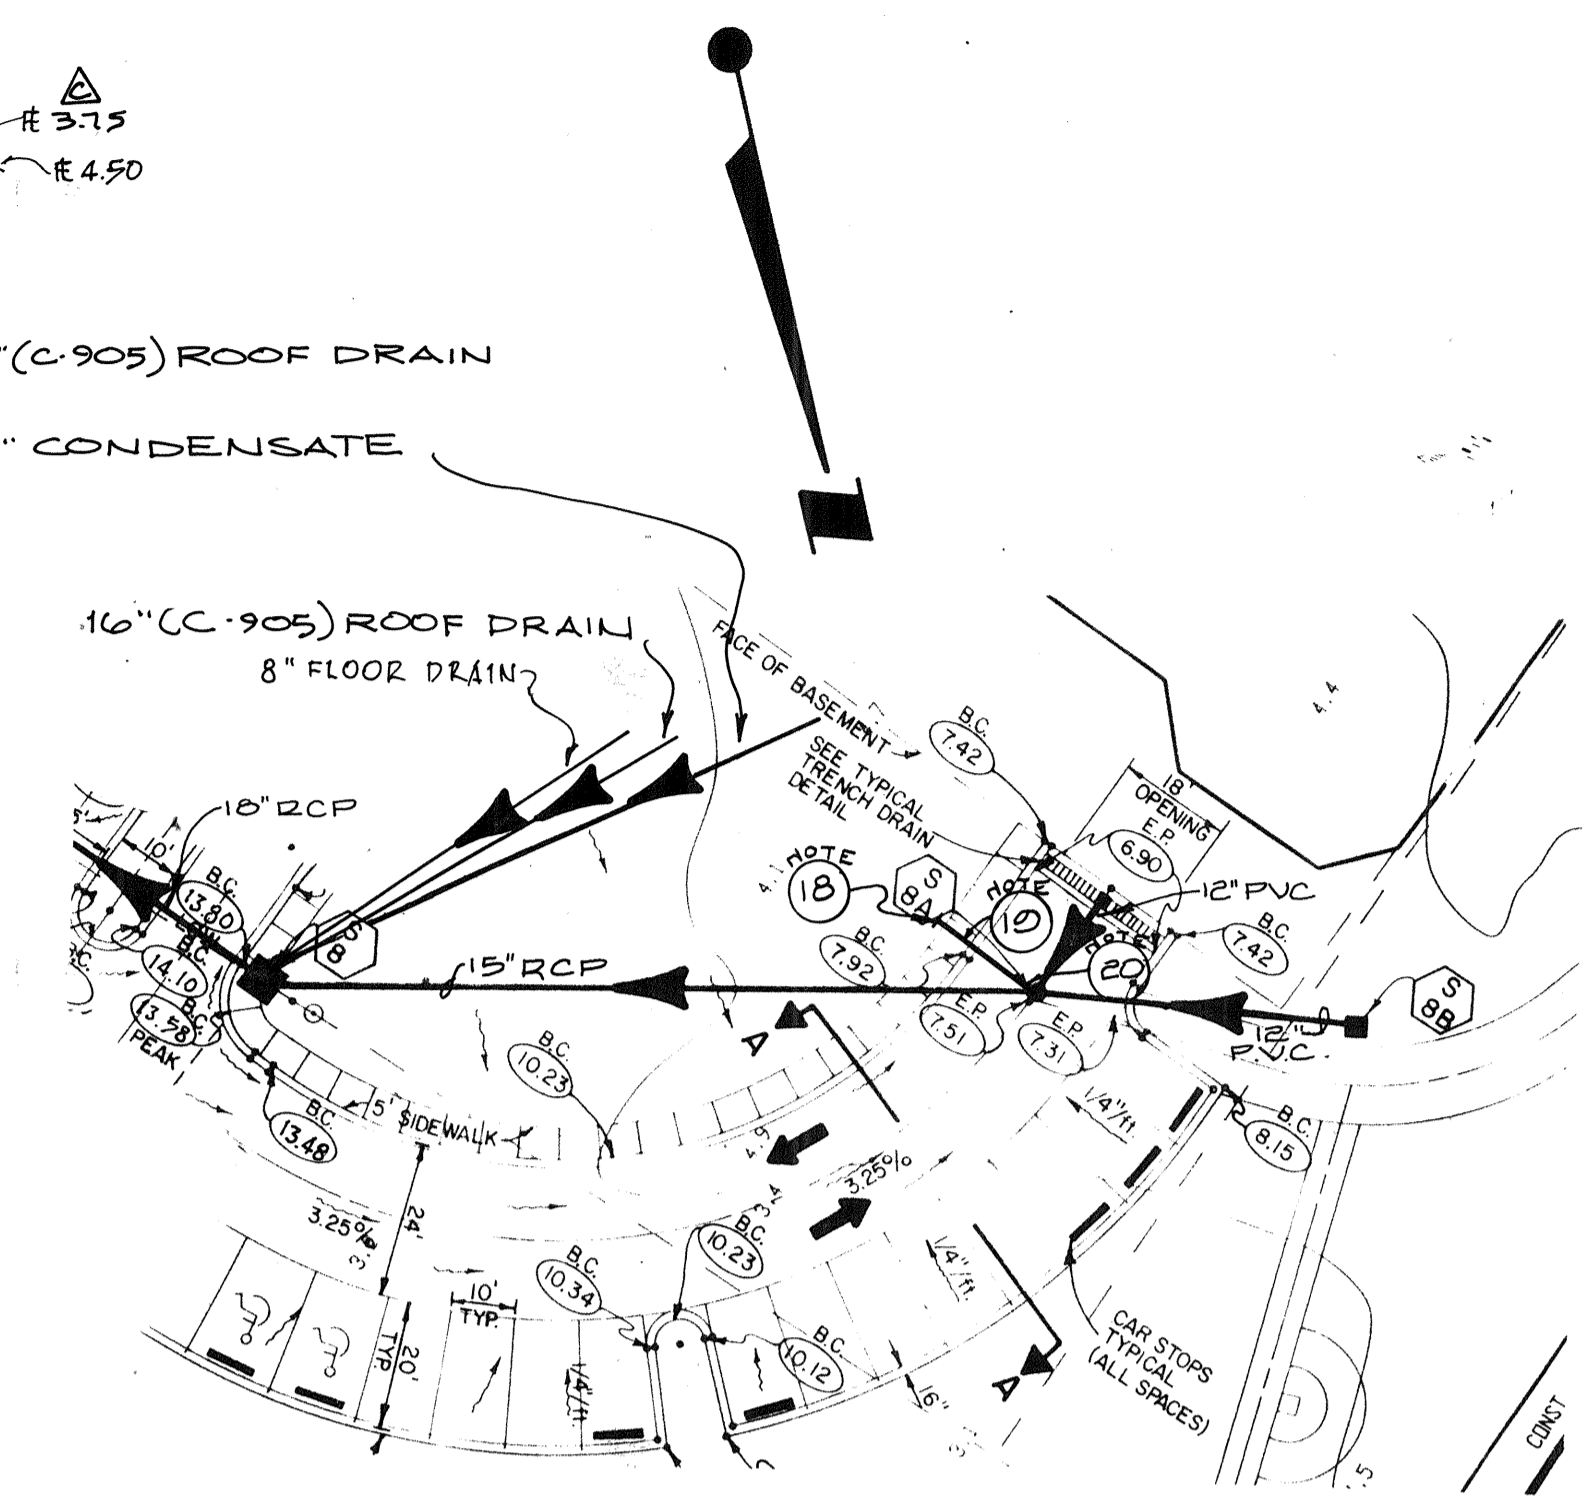
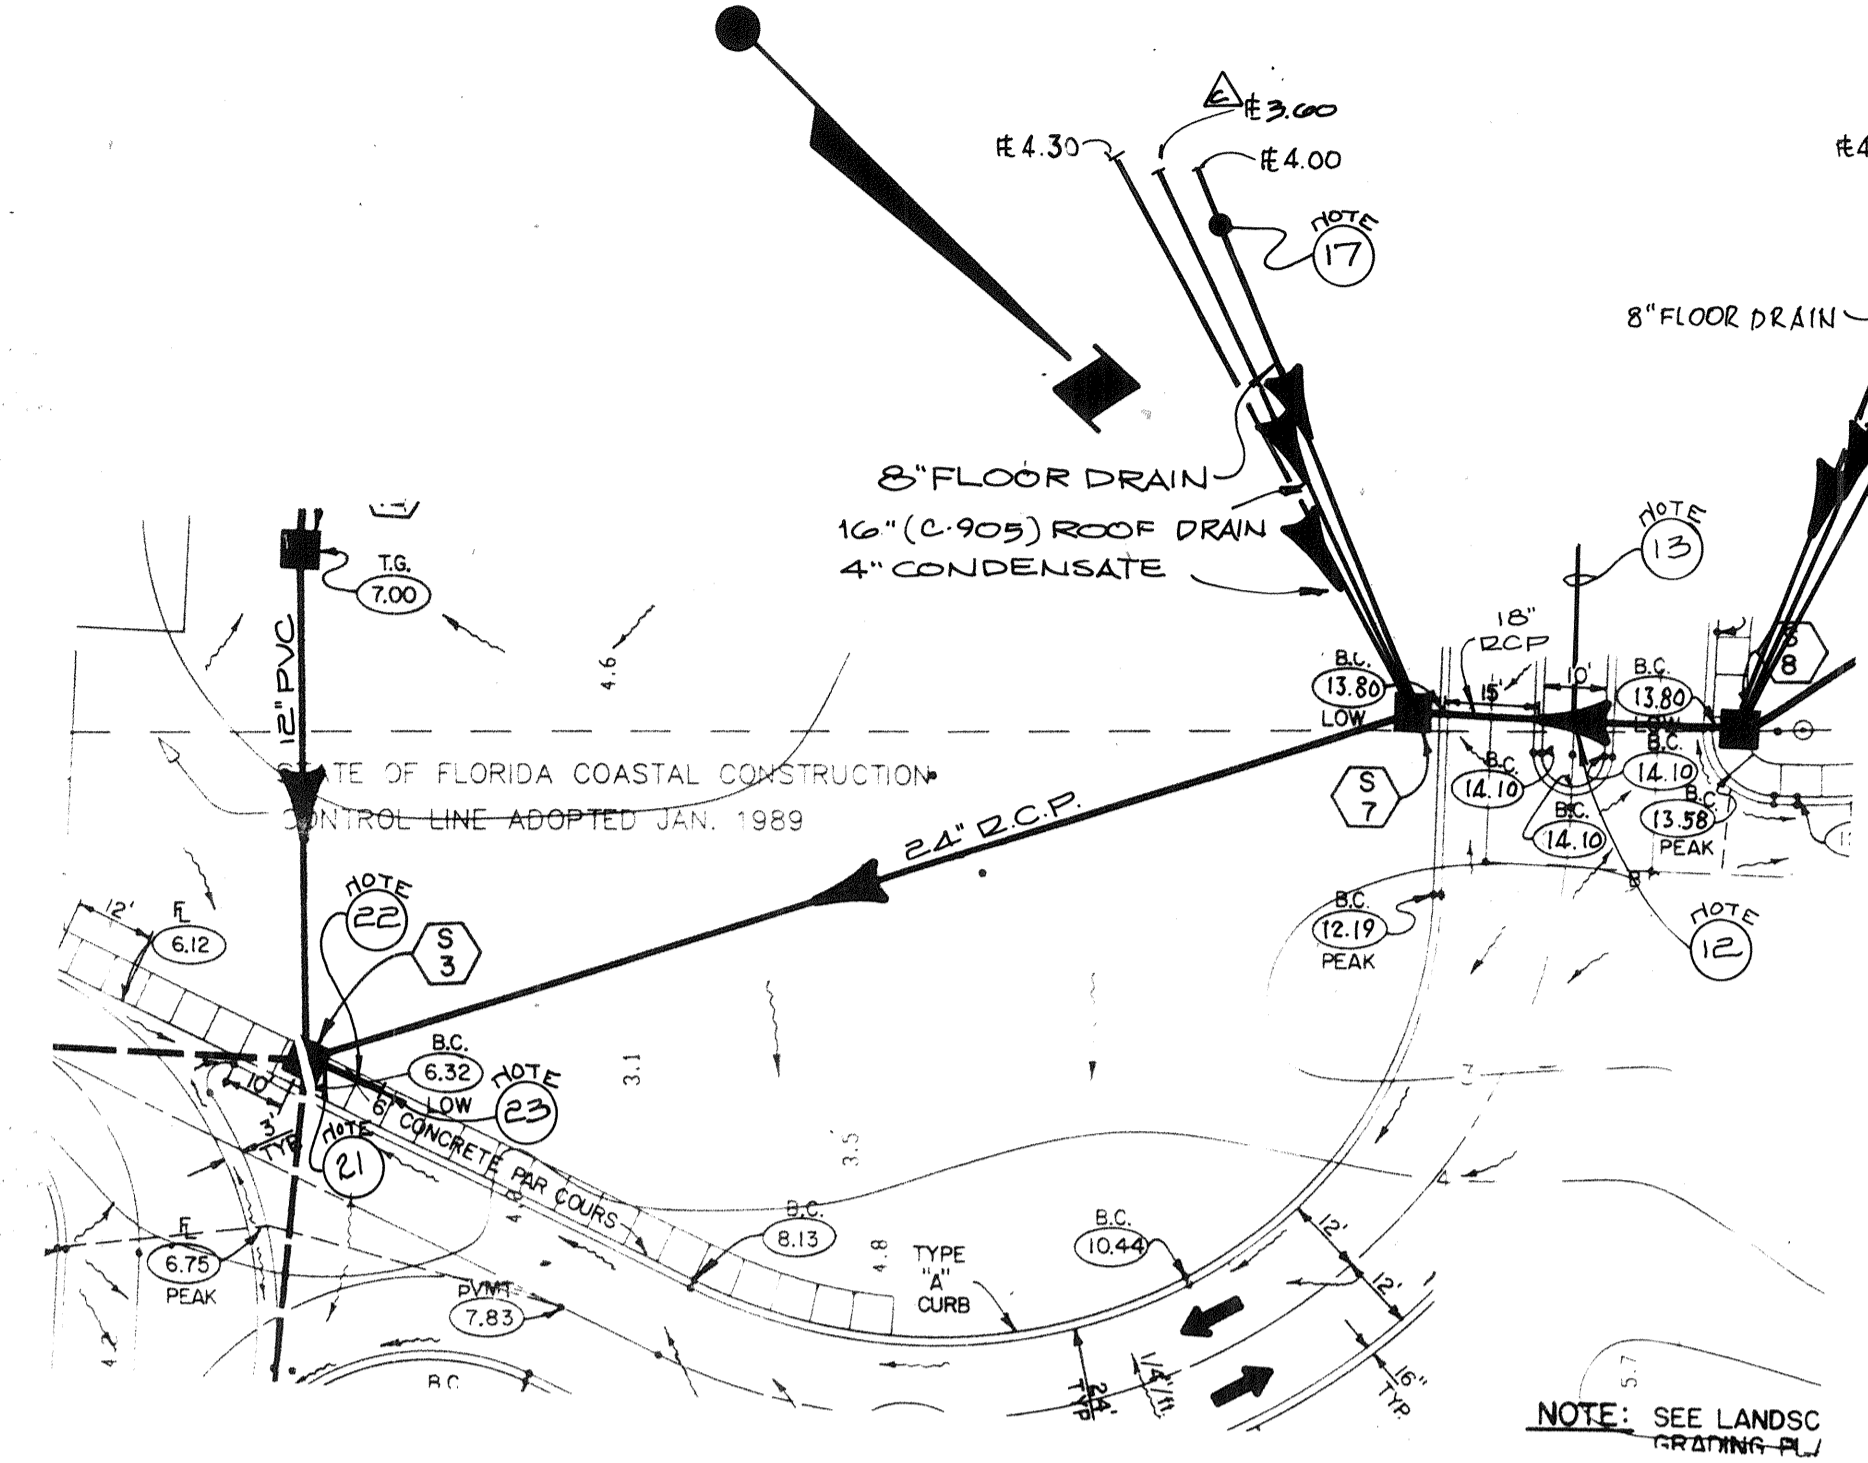


NOTE: THIS PLAN IS FOR STORMWATER ONLY

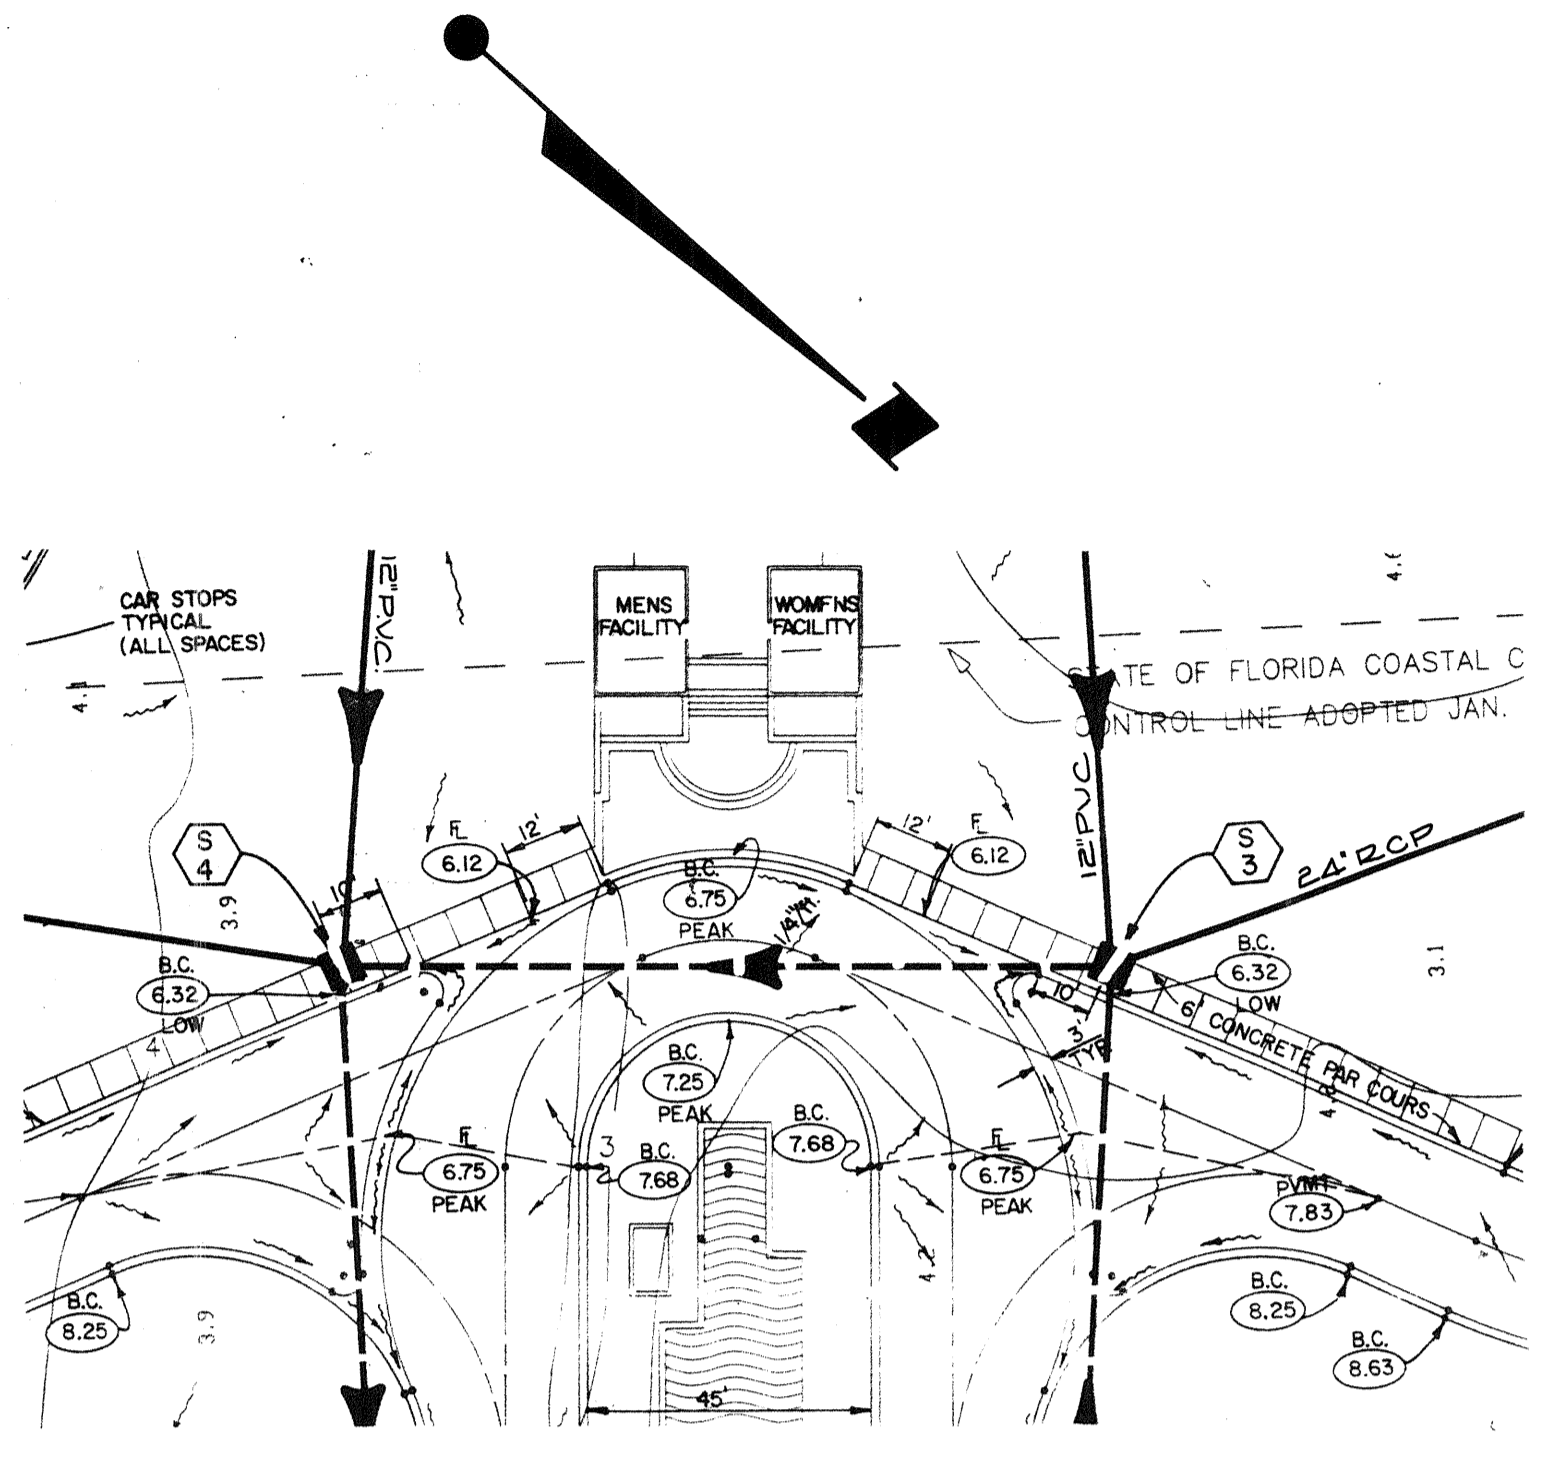

INFORMATION IN BRACKETS PROVIDED BY CONTRACTOR

DESIGNED BY	J.M.B.
DATE	7/90
SCALE	VERT. 1"=20'
BY	R.B.K.
CHECKED BY	2591
PROJECT NO.	
DRAWN BY	
REVISION	
DATE	
L.T.R.	
DATE	
FOR: YALE PROPERTIES	
L'AMBIANCE	
STORM WATER PLAN & PROFILE	
SMALLY, WELLFORD & NALVEN, INC.	
CONSULTING ENGINEERS & SURVEYORS	
133 SOUTH MCINTOSH RD.	
SARASOTA, FLA. 33562	
5

REVISION