


NOTE: THIS PLAN IS INTENDED FOR USE ONLY AS SANITARY SEWER PLAN + PROFILE.

NOTE: DATA IN BRACKETS CONFORM DRAWINGS TO CONSTRUCTION RECORDS BY TRI-D SEPTEMBER 1992

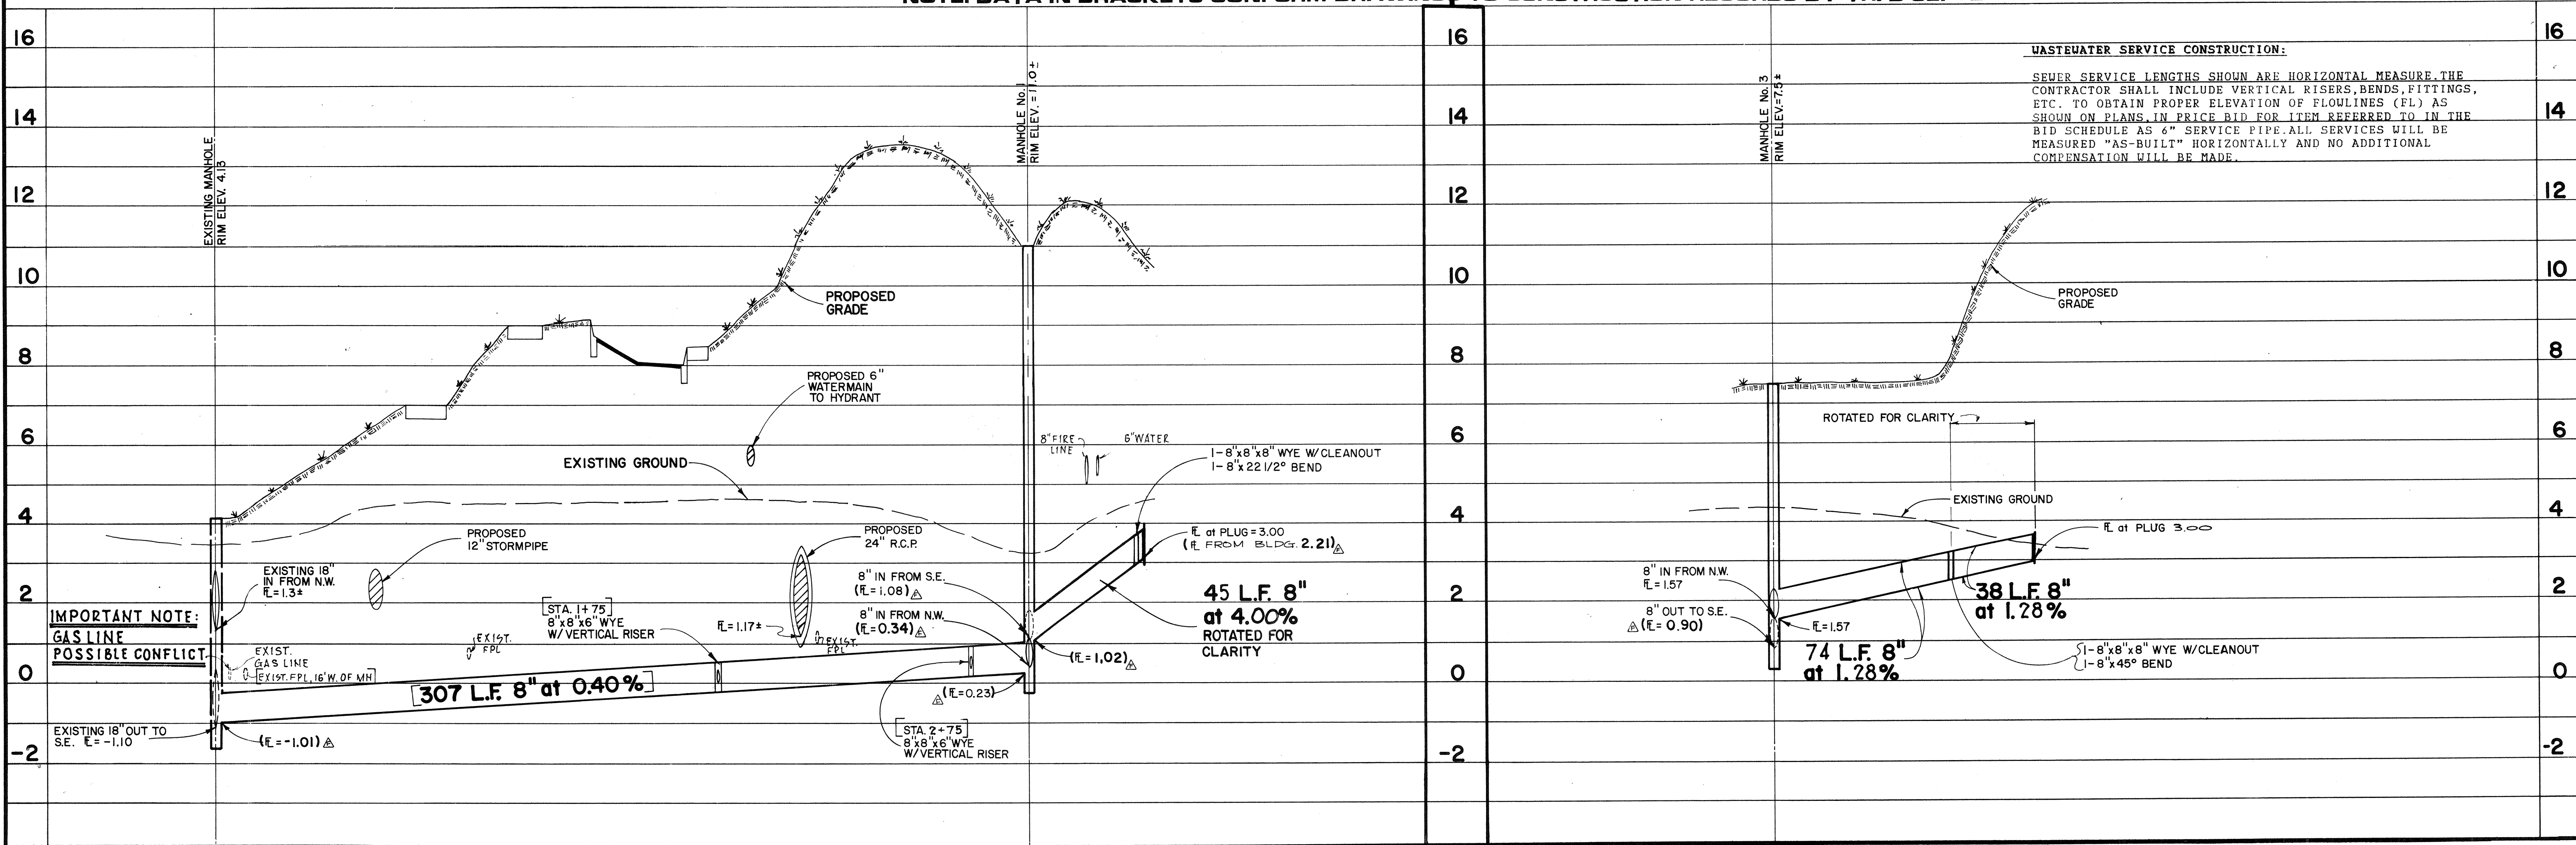

**WASTEWATER SERVICE CONSTRUCTION:**  
SEWER SERVICE LENGTHS SHOWN ARE HORIZONTAL MEASURE. THE CONTRACTOR SHALL INCLUDE VERTICAL RISERS, BENDS, FITTINGS, ETC. TO OBTAIN PROPER ELEVATION OF FLOWLINES (FL) AS SHOWN ON PLANS. IN PRICE BID FOR ITEM REFERRED TO IN THE BID SCHEDULE AS 6" SERVICE PIPE. ALL SERVICES WILL BE MEASURED "AS-BUILT" HORIZONTALLY AND NO ADDITIONAL COMPENSATION WILL BE MADE.

**IMPORTANT NOTE:**  
GAS LINE  
POSSIBLE CONFLICT

FOR: YALE PROPERTIES  
L'AMBIANCE  
SANITARY SEWER PLAN & PROFILE  
SMALLY, WELLFORD & NALVEN, Inc.  
CONSULTING ENGINEERS & SURVEYORS  
133 SOUTH MCINTOSH RD.  
SARASOTA, FLA. 33582

LTR.	DATE	REVISION	BY	SCALE	DATE	DESIGNED BY
1	10/27/92	ADDED GAS LINE TO PLAN & PROFILE	J.M.B.	1" = 30'	7/90	J.M.B.
2	11/12/92	REVISED WATER MAINS TO 6" & 8" BASED UPON FIELD RECORDS FROM 2/14/92 TO 1/10/93	R.B.K.	1" = 30'	7/90	J.M.B.
3	11/12/92	REVISED WATER MAINS TO 6" & 8" BASED UPON FIELD RECORDS FROM 2/14/92 TO 1/10/93	R.B.K.	1" = 30'	7/90	J.M.B.
4	11/12/92	REVISED WATER MAINS TO 6" & 8" BASED UPON FIELD RECORDS FROM 2/14/92 TO 1/10/93	R.B.K.	1" = 30'	7/90	J.M.B.
5	11/12/92	REVISED WATER MAINS TO 6" & 8" BASED UPON FIELD RECORDS FROM 2/14/92 TO 1/10/93	R.B.K.	1" = 30'	7/90	J.M.B.
6	11/12/92	REVISED WATER MAINS TO 6" & 8" BASED UPON FIELD RECORDS FROM 2/14/92 TO 1/10/93	R.B.K.	1" = 30'	7/90	J.M.B.

DRAWING NUMBER: 4  
REVISION: 0