


**AS BUILT
WATER DISTRIBUTION
SYSTEM**

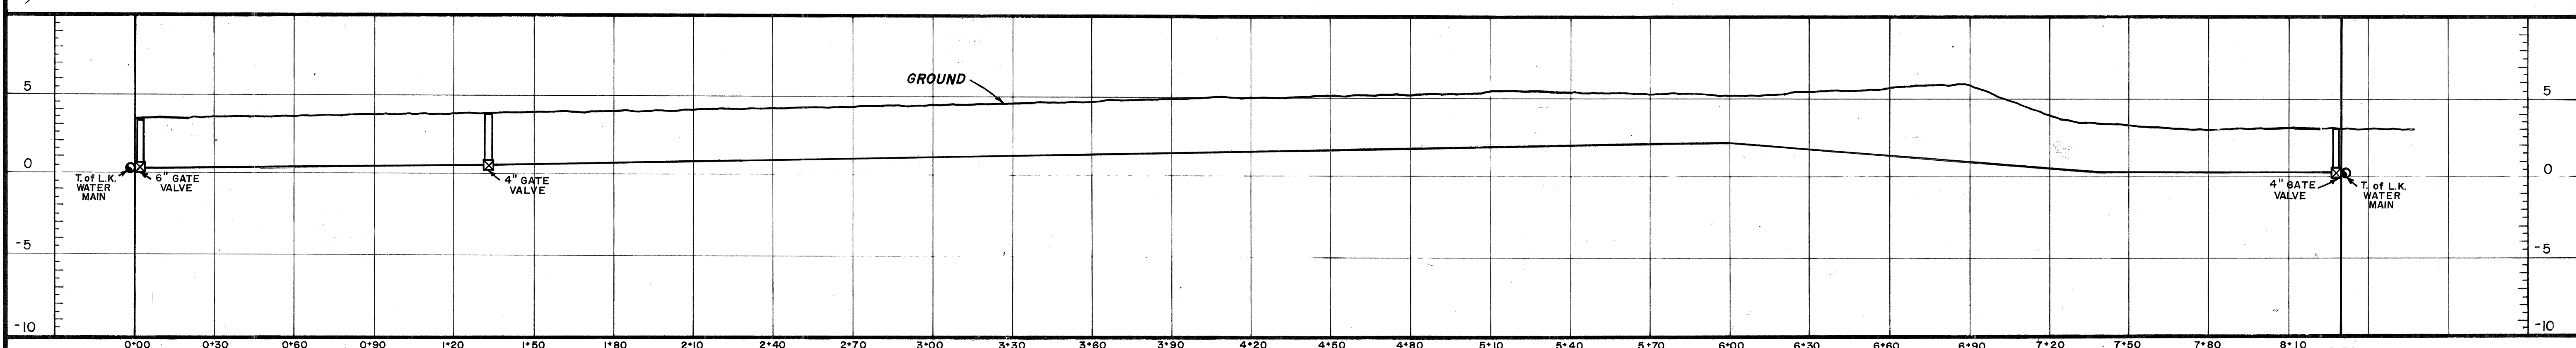

TOWN OF LONGBOAT KEY, FLORIDA		DESIGNED BY PROJECT ENGINEER	
LANDS END		D.A.H.	
REVISION		DATE	CHECKED BY PROJECT NO.
6/19/88 REVISED AND UPDATED SERVICE LOCATIONS		7/7/78	D.A.H. 218
BY		SCALE:	DRAWN BY
D.A.H.		1" = 30'	W.M.G.W.
SHEET NUMBER		T.L.K. FILE NO.	
1		176386	
ENGINEER - DALE A. HAAS / TRIAD TECH., INC. / 6027-17TH STREET EAST / BRADENTON, FLORIDA 33508 / PHONE: (813) 756-6311			