


NOTE:
ALL SERVICE LINES ARE 4" E.S.V.C.
AND A MINIMUM OF 2' IN DEPTH.

AS BUILT
SANITARY SEWER

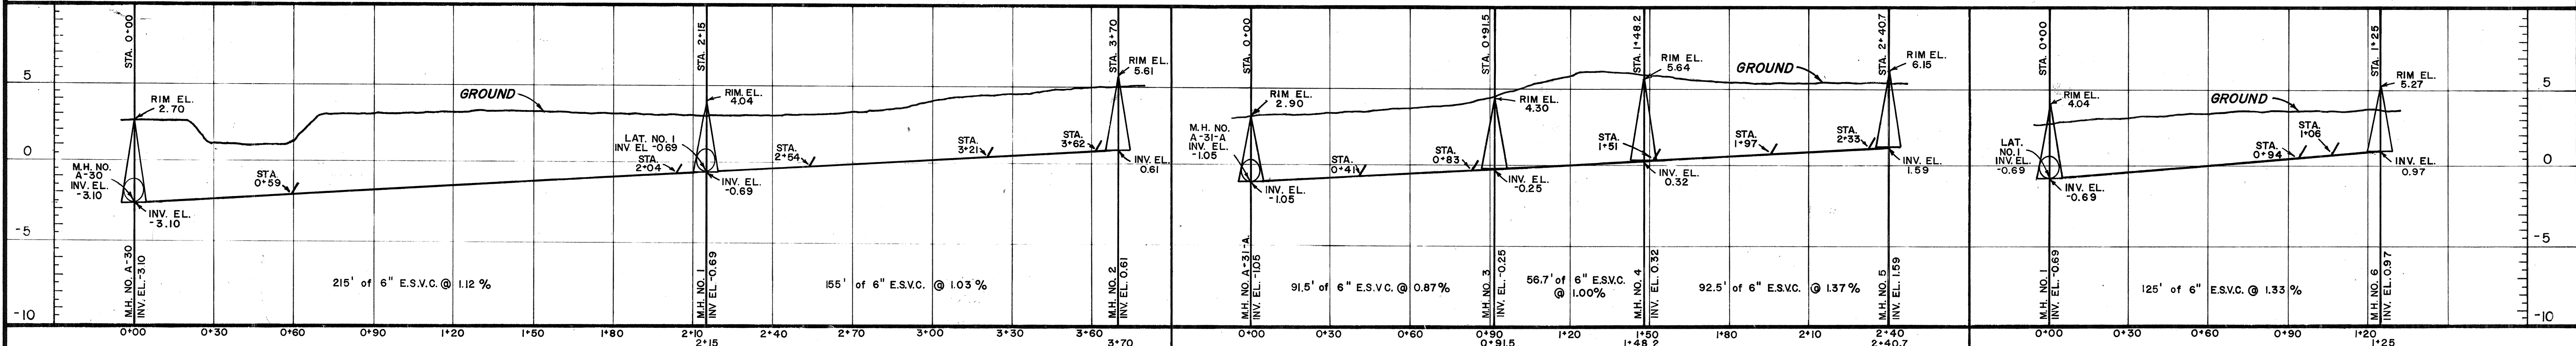

MAIN "A"

MAIN "B"

LAT. NO. 1

PROJECT ENGINEER	DESIGNED BY	DATE	SCALE	BY	REVISION	LTR.	DATE
D.L.O. #42386	D.A.H.	6/9/78	1" = 30'				
	CHECKED BY		DRAWN BY				
	D.A.H.		W.W.G.W.				
	PROJECT NO.						
	218						
TOWN OF LONGBOAT KEY, FLORIDA							
LANDS END							
ENGINEER: DALE A. HAAS/TRIAD TECH, INC. / 6027-17TH STREET EAST / BRADENTON, FLORIDA 33608 / PHONE: (813)756-6311							
SHEET NUMBER							
REVISION							
T.L.K. FILE NO.							