


NOTE:
ALL SERVICE LINES ARE 4" E.S.V.C.
AND A MINIMUM OF 2' IN DEPTH.

AS BUILT
SANITARY SEWER

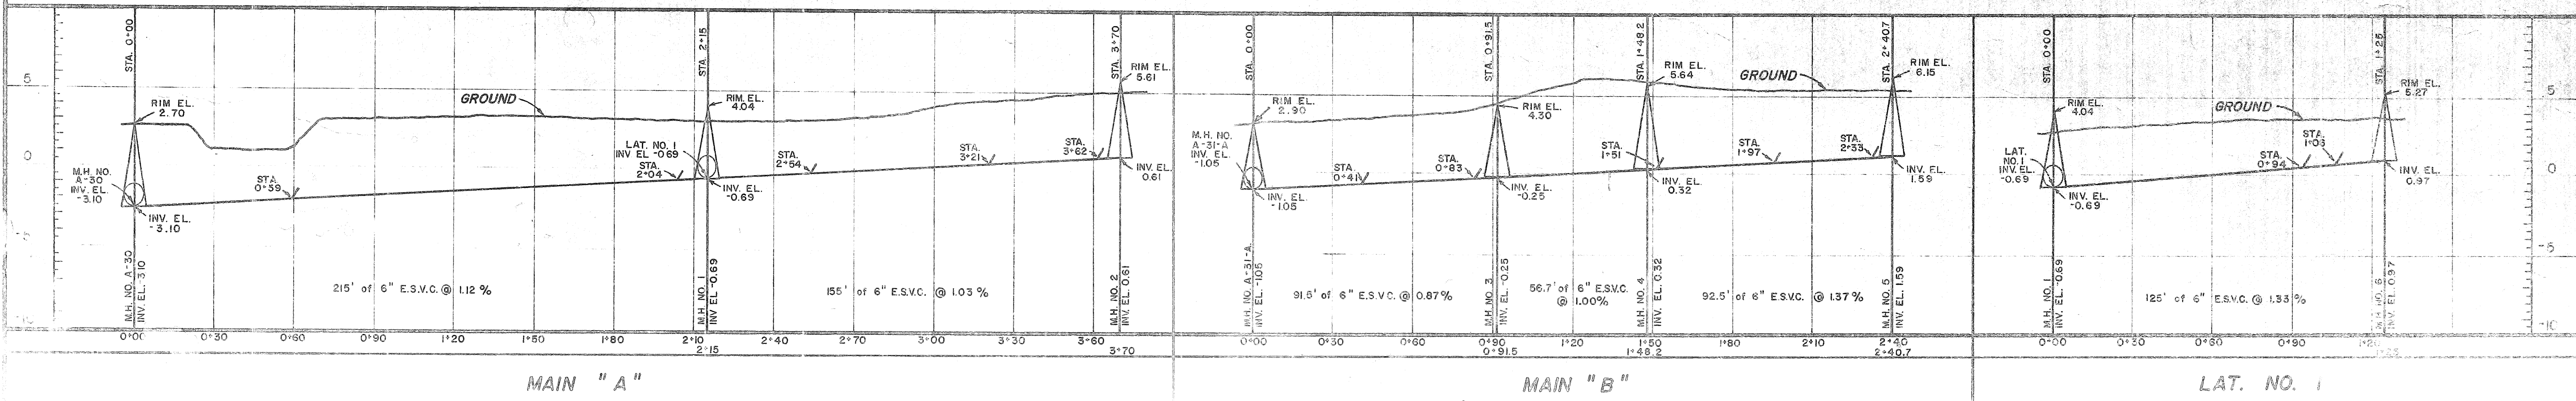

DESIGNED BY	PROJECT ENGINEER
	D.A.H.
DATE	6/9/78
	D.A.H.
SCALE	1" = 30'
	D.A.H.
DRAWN BY	W.W.G.W.
	D.A.H.
CHECKED BY	PROJECT NO. 218
	D.A.H.
REVISION	
L.T.R.	
DATE	
TOWN OF LONGBOAT KEY, FLORIDA	
LANDS END	
470 LOCATION: DALE A. HAAS / TRAD TECH / IND. / 6027 11TH STREET, EAST / BRADENTON, FLORIDA 33908 / PHONE: (813) 756-6811	
FILE NO.	
SHEET 11	