




M.H.W.L.
EL. 1.46'
MARCH 13, 1973

GULF OF MEXICO

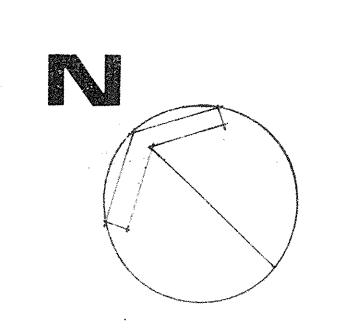

AS BUILT
WATER UTILITY PLAN

1" = 50'

SHEET NUMBER W	REVISION	L.T.R. DATE	REVISION	BY	SCALE:	DATE:	DESIGNED BY
					1" = 50'	9-18-74	D.A.H.
					DRAWN BY	CHECKED BY	PROJECT ENGINEER
					M.M.C.	G.A.H.	53-AIB
TOWN OF LONGBOAT KEY, FLORIDA LONGBEACH VILLAGE NORTH GULF OF MEXICO DRIVE LONGBOAT KEY, FLORIDA ENGINEER & LOCATION JAMES R. KENNEDY TRIAD TECH., INC. 6111 - 15th STREET BRADENTON, FLORIDA 33507 T.L.K. FILE NO.							