


SITE PLAN
SHOWING "AS BUILT" WATER DISTRIBUTION SYSTEM

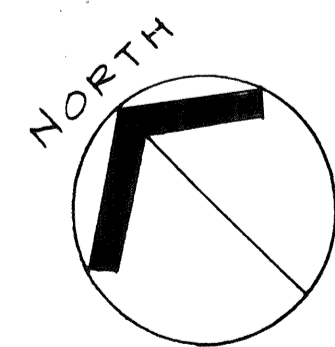

SCALE: 1" = 30'

LEGEND
W.M. WATER METER

SEA PILES
CORNER

PROJECT ENGINEER	DESIGNED BY	DATE:	SCALE:	BY	REVISION	L.T.R.	DATE
DESIGNED BY	CHECKED BY	CHECKED BY	DRAWN BY				
<p>TOWN OF LONGBOAT KEY, FLORIDA LONGBEACH VILLAGE SOUTH 6951 GULF OF MEXICO DRIVE</p>							
ENGINEER & LOCATION	SHEET NUMBER	T.L.K. FILE NO.					
REVISION	G-A						