


BAY ISLANDS UNIT NO. 1  
 PL. 25, PA. 30, 36, 38

TYP. EASEMENT  
 TO TOWN OF  
 LONGBOAT KEY  
 (ALL UTILITIES)

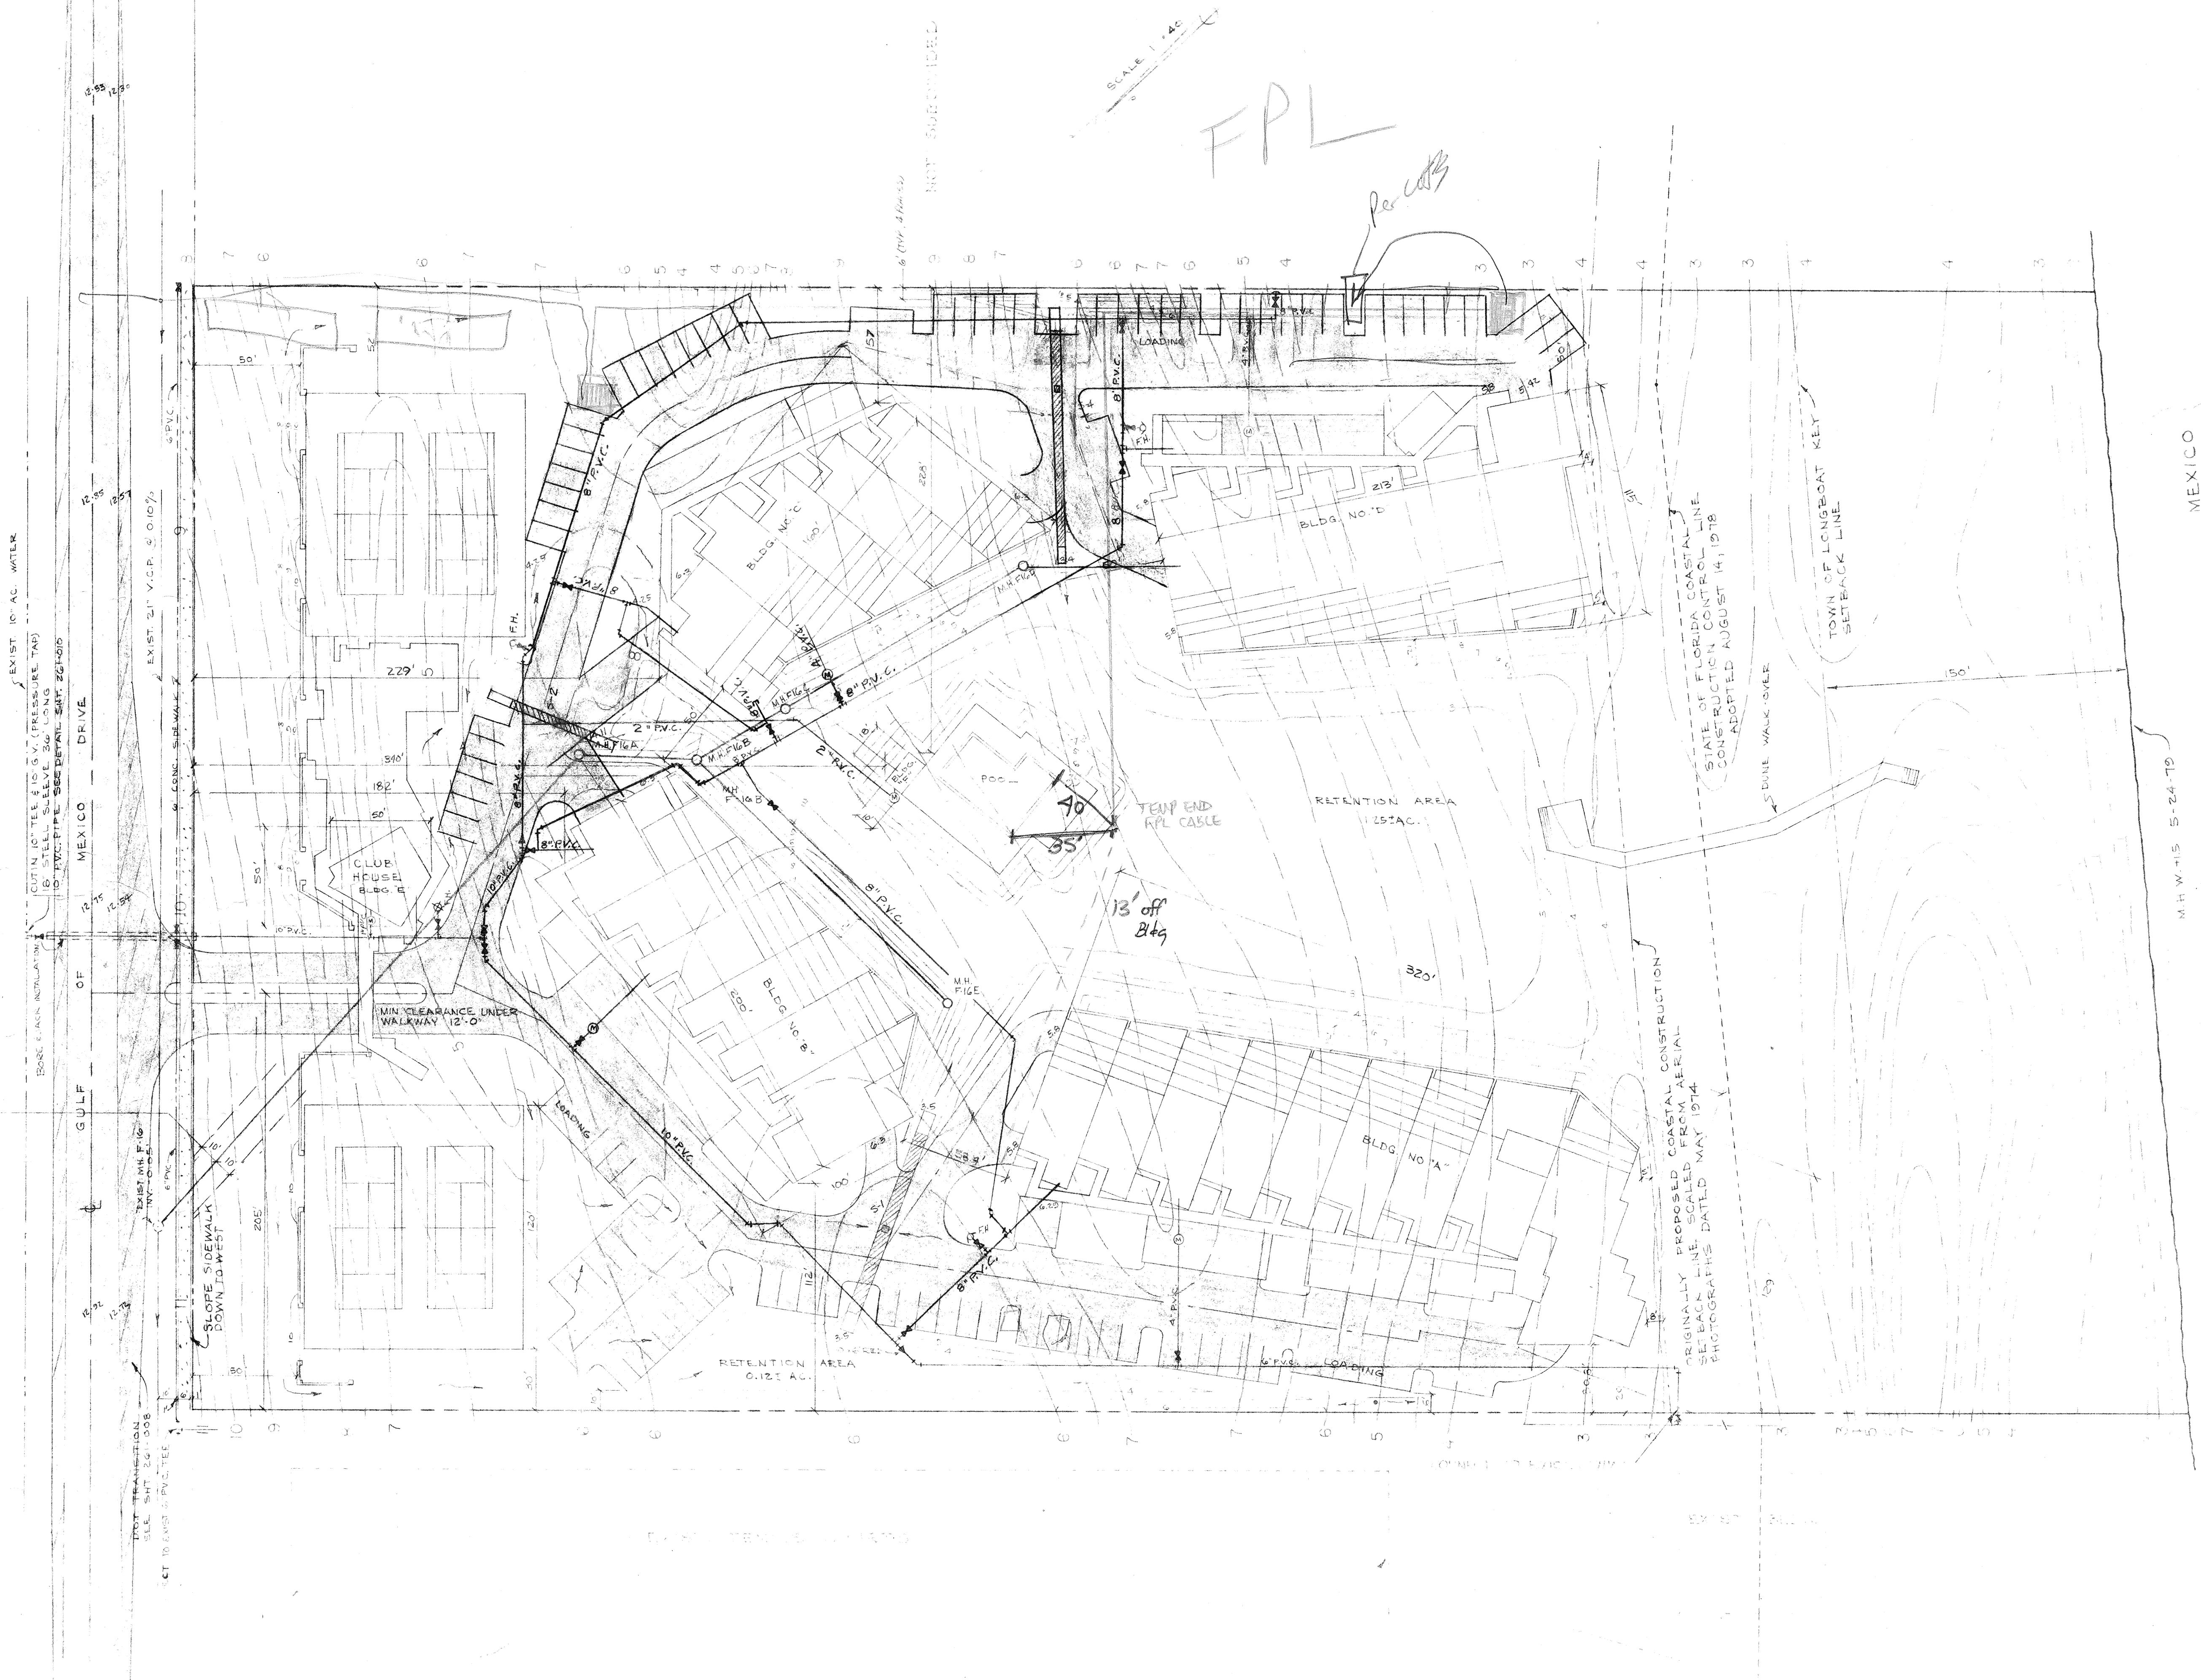

MEXICO

M.H.W. 15 5-24-79

NO.	DATE	DESCRIPTION	BY	CHK.
1	7-27-78	REV. WATER MAIN	MM	MM
2	10-28	REV. WATER MAIN LOC. SHEETS 3-3	MM	MM
3	11-22	ADD 2" X 3" SERVICE TO 2"	MM	MM
4	1-22-80	REV. F.S. ADDS METER WATER L.O.P.	MM	MM
5	3-1-80	ADD NOTE TO SHEETS	MM	MM
6	5-24-79	ADD NOTE TO SHEETS	MM	MM

8-15-79	1" = 40'	DR. H.
---------	----------	--------

FLORIDA

G.U.F.

THE PLAYERS CLUB

DETAIL SITE PLAN

LONGBOAT KEY

261-003

BENNETT & BISHOP

COLORED BY PRALIN & TENNIS, LLC  
 5.17.16 2.12.F