
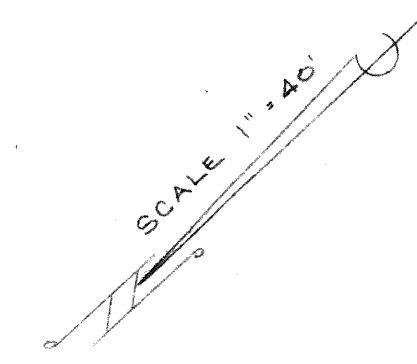
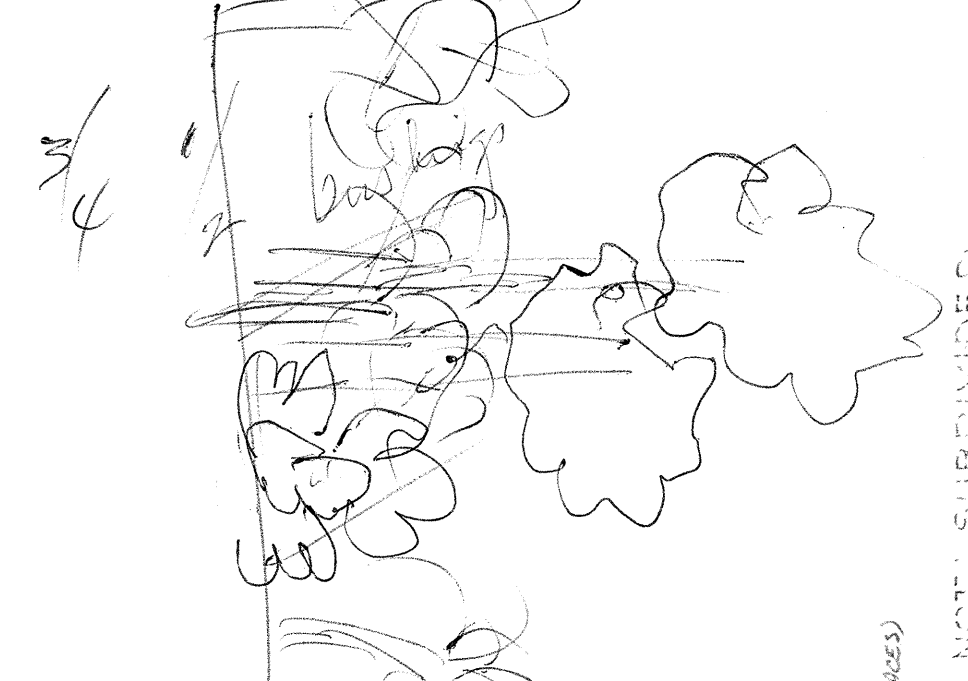


BAY ISLES UNIT NO. 1  
REV. 02, 03, 05, 06, 08

TYPEASMENT TO TOWN OF LONGBOAT KEY (ALL UTILITIES)

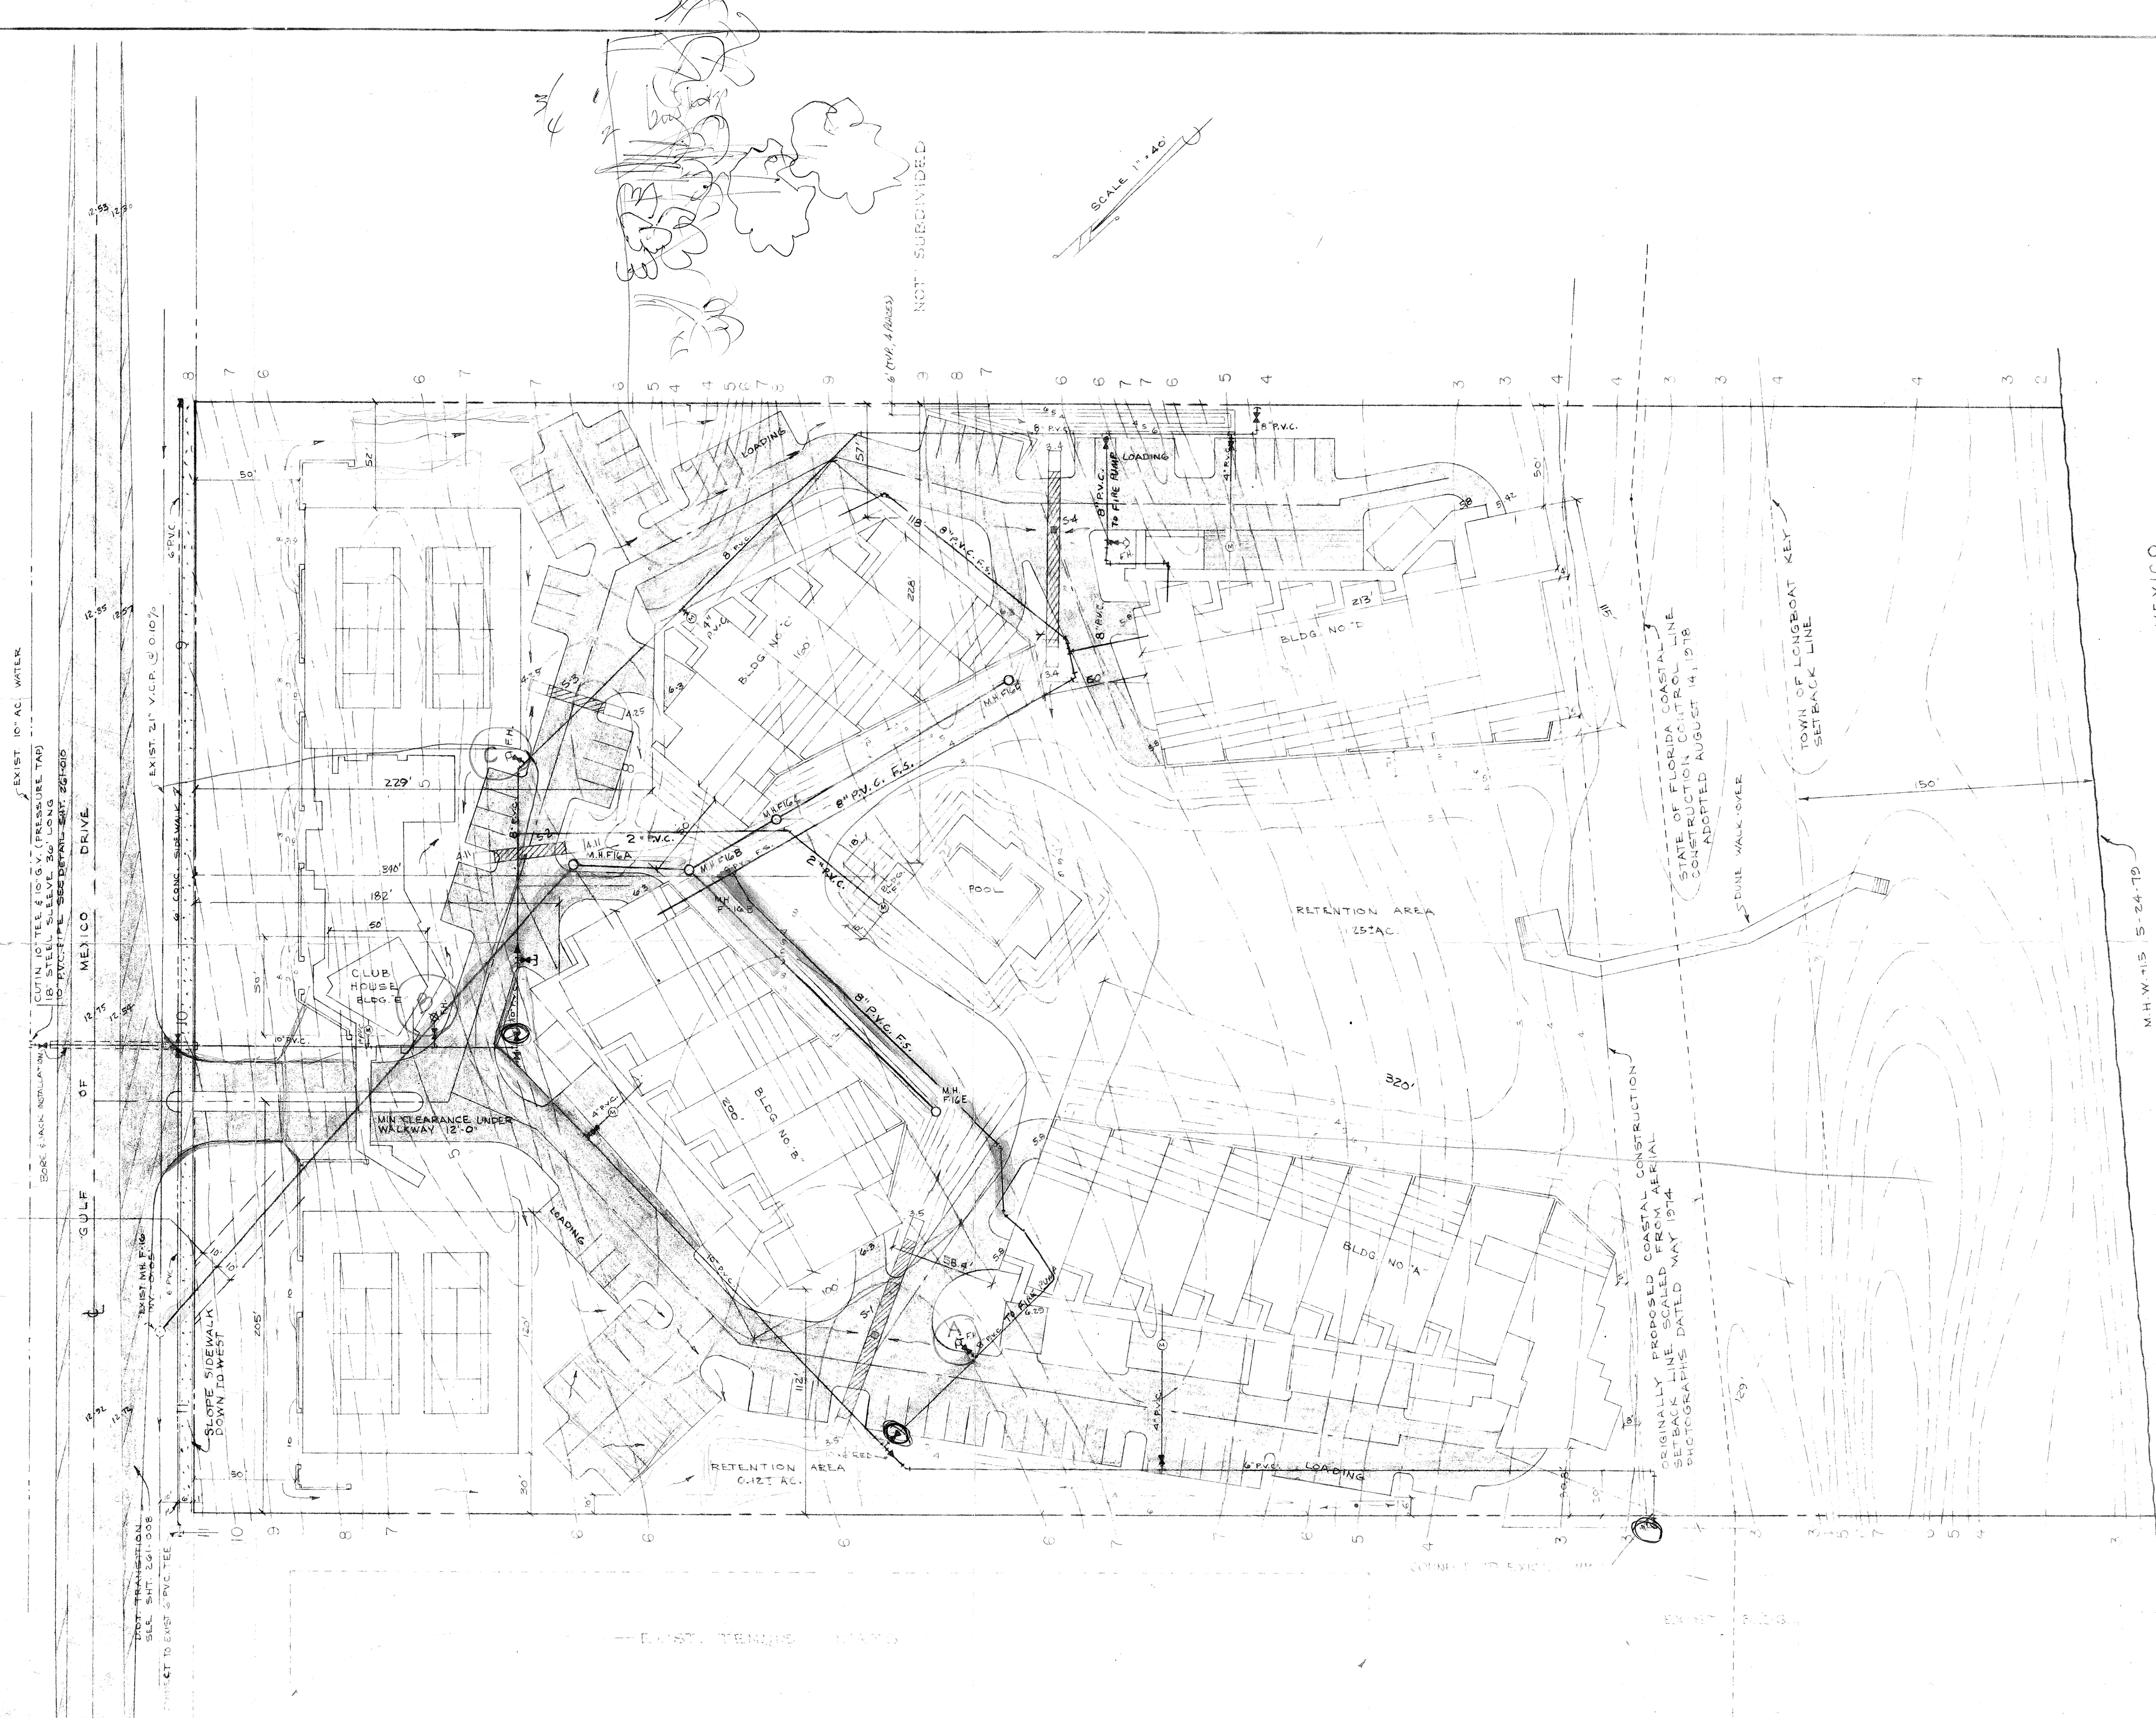

3453  
GMD

MEXICO

M.H.W. 115 5-24-75

GULF

OF

THE PLAYERS CLUB  
DETAIL SITE PLAN

BENNETT & BISHOP

7-11-80	CHG 2 1/2" SERVICES TO 2"	MM
7-29-80	REV. P.S. DOMESTIC WATER LOGS	MM
2-22-80	ADD 2" P.S.V.	MM
2-1-80	ADD NOTE SIDEWALK	MM
12-1-79	REV. P.S. TO 2" DOMESTIC	MM
12-1-79	REV. M.M. SIDEWALK, ELEV. ROAD	MM

LONGBOAT KEY  
FLORIDA