





F.P.L, G.T.E, CABLE AS-BUILT  
 Do NOT REMOVE FROM OFFICE

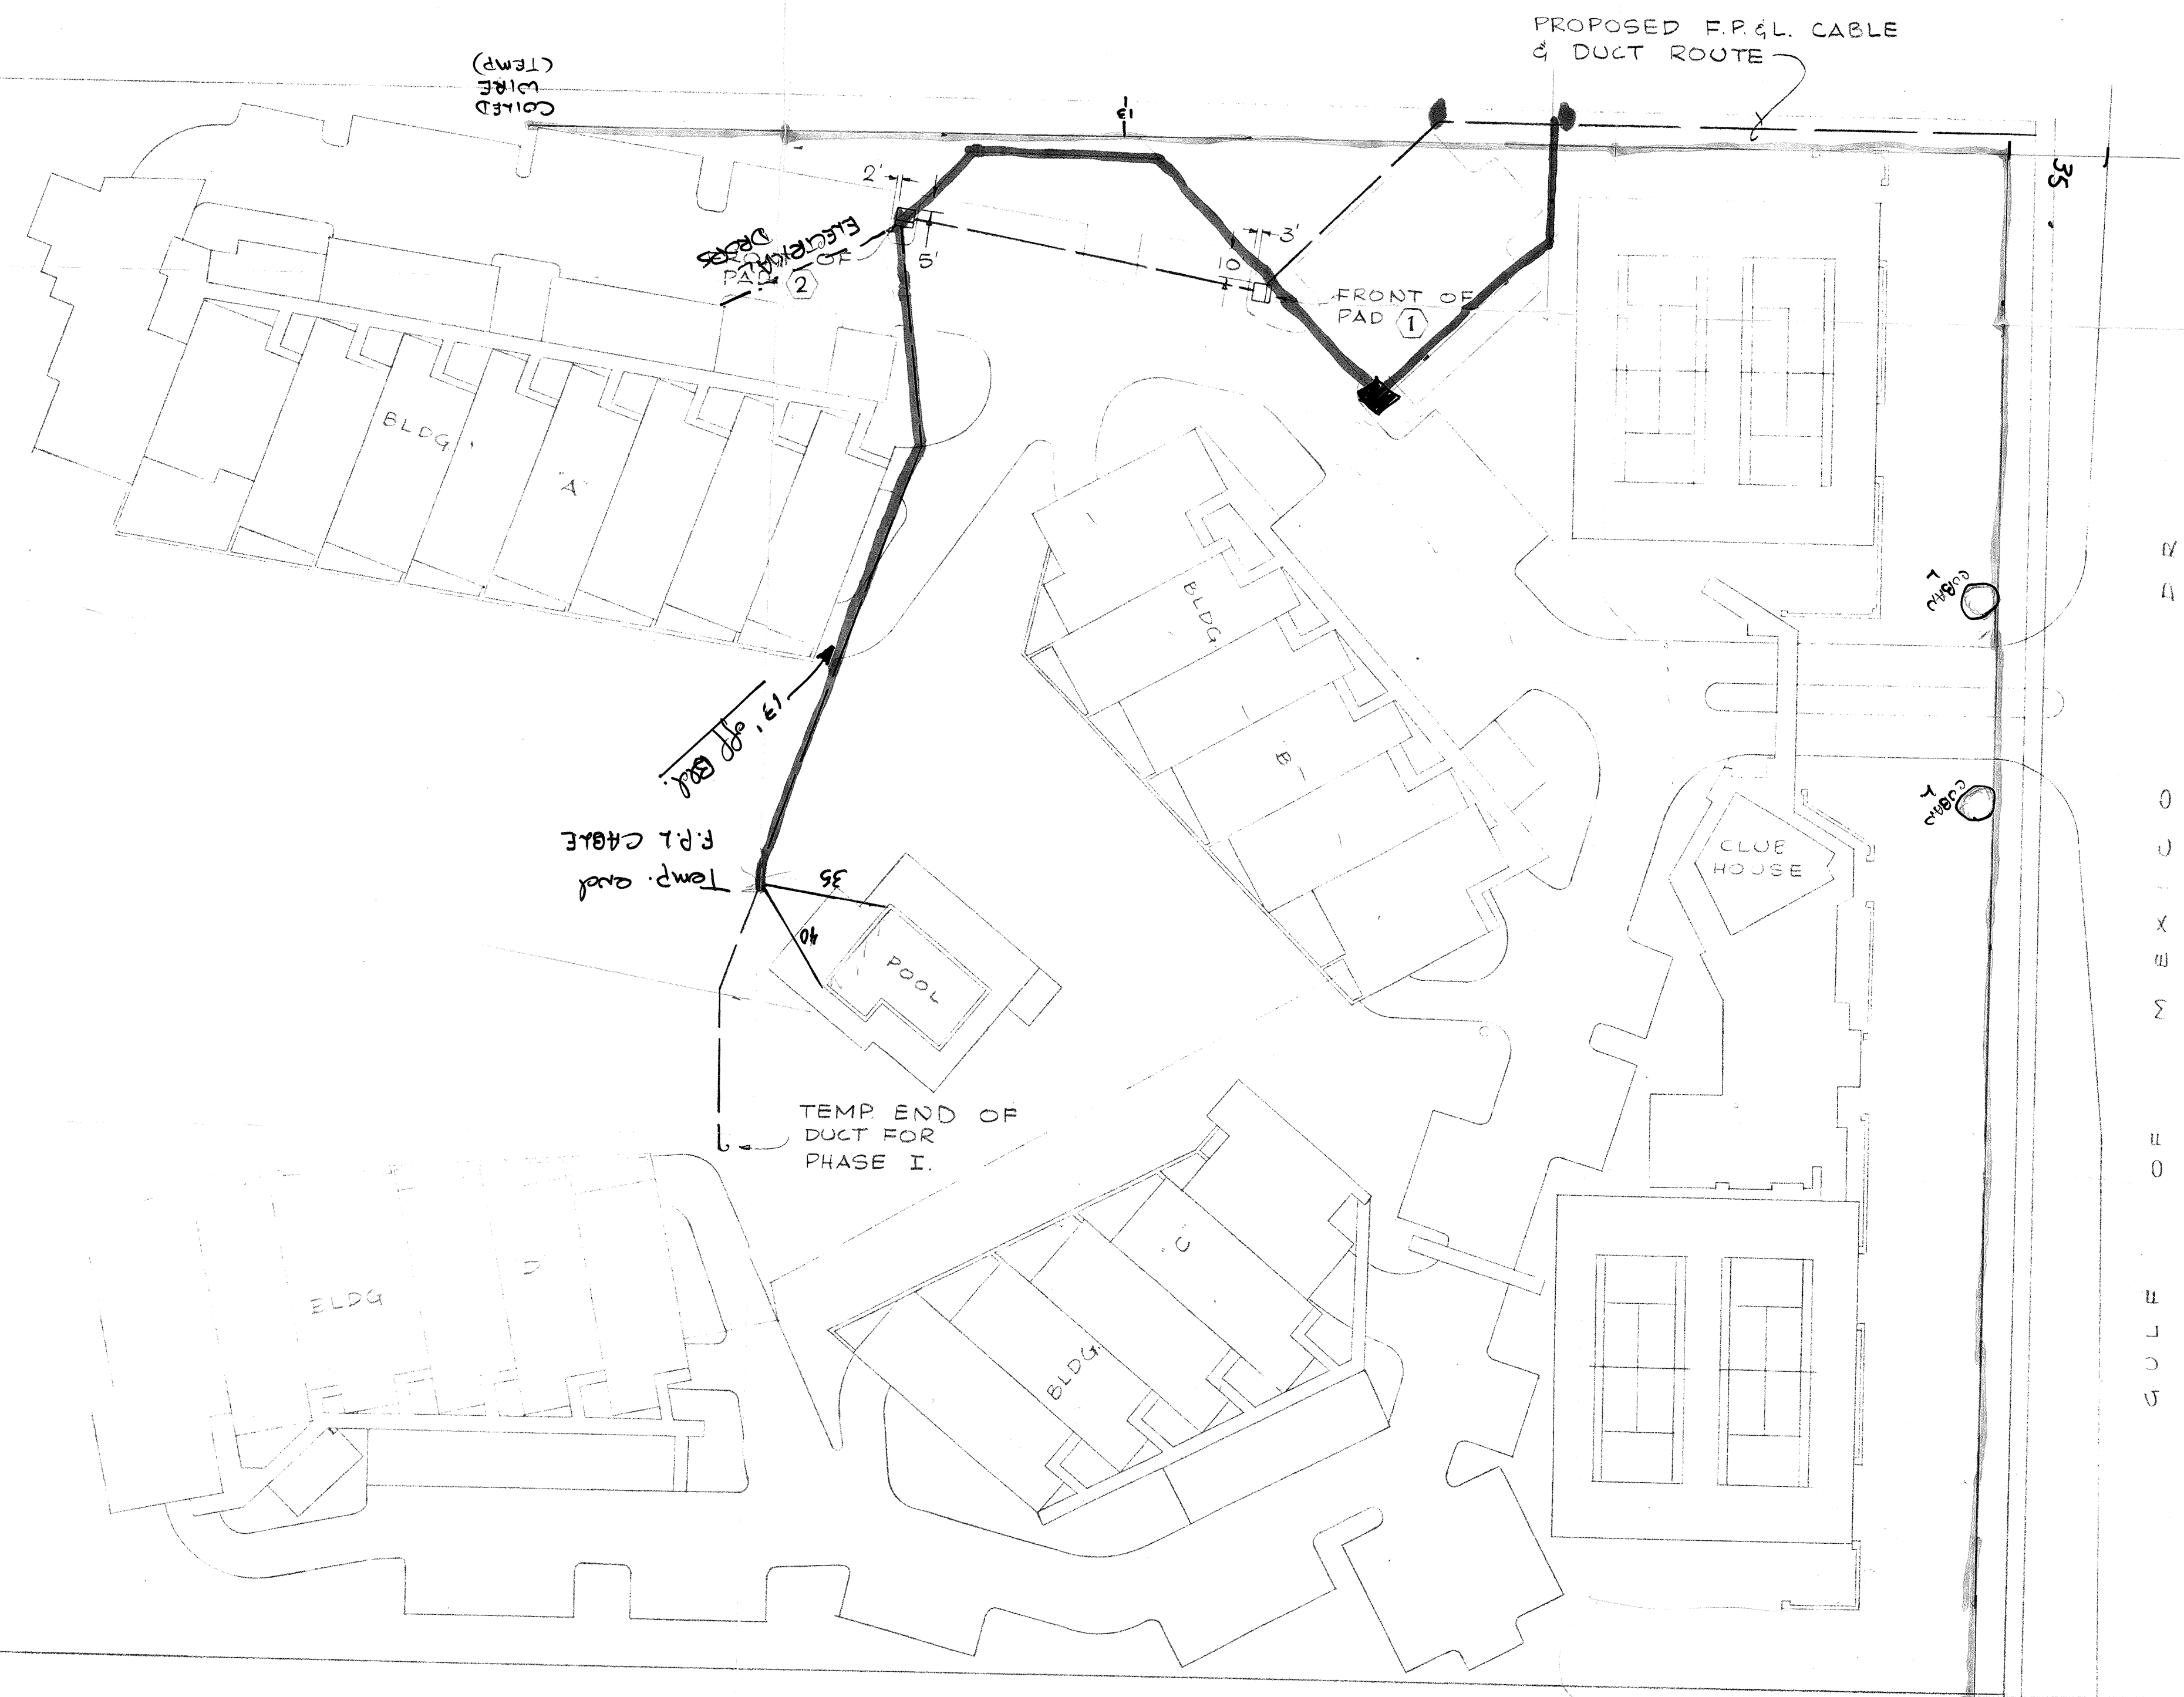

LEGEND:

-  SPACE FOR CUSTOMERS C
-  SPACE FOR F.P.L. CONDUIT.

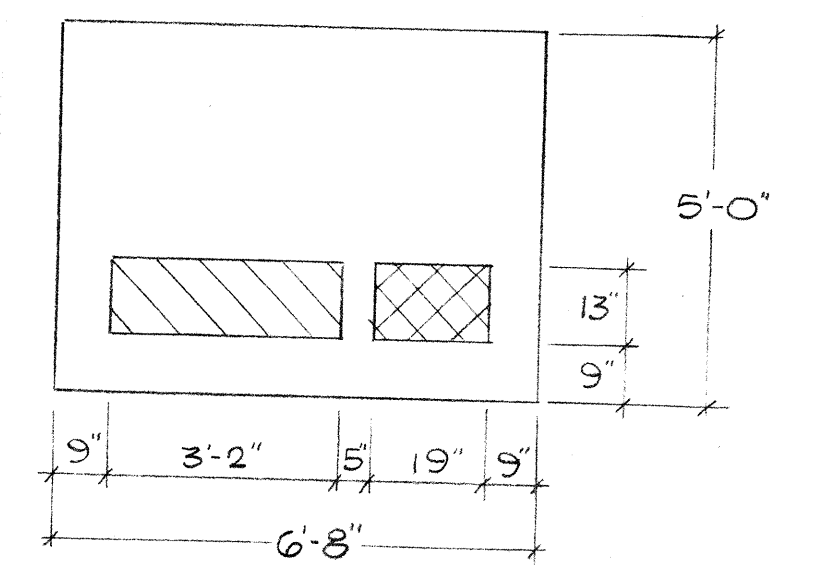

PAD DETAIL

NOTE:  
 PADMOUNT TRANSFORMER ① TO SER BLDG. "B" & CLUBHOUSE.  
 PADMOUNT TRANSFORMER ② TO SER BLDG "A" & POOL AREA.

DATE		SCALE 0 40 80 120	
AUTH		DR CH	
NO.		ER NO.	
DATE		COR	
REVISION		BY CH CORN	

PROPOSED PADMOUNTED TRANSFORMER LOCATIONS & DUCT ROUTE