





A1. Elevator & Stair (2nd Floor) sections & detail
A2. Building "B" wall section details
A3. Building "D" wall section details
A4. Section A-A (see detail)

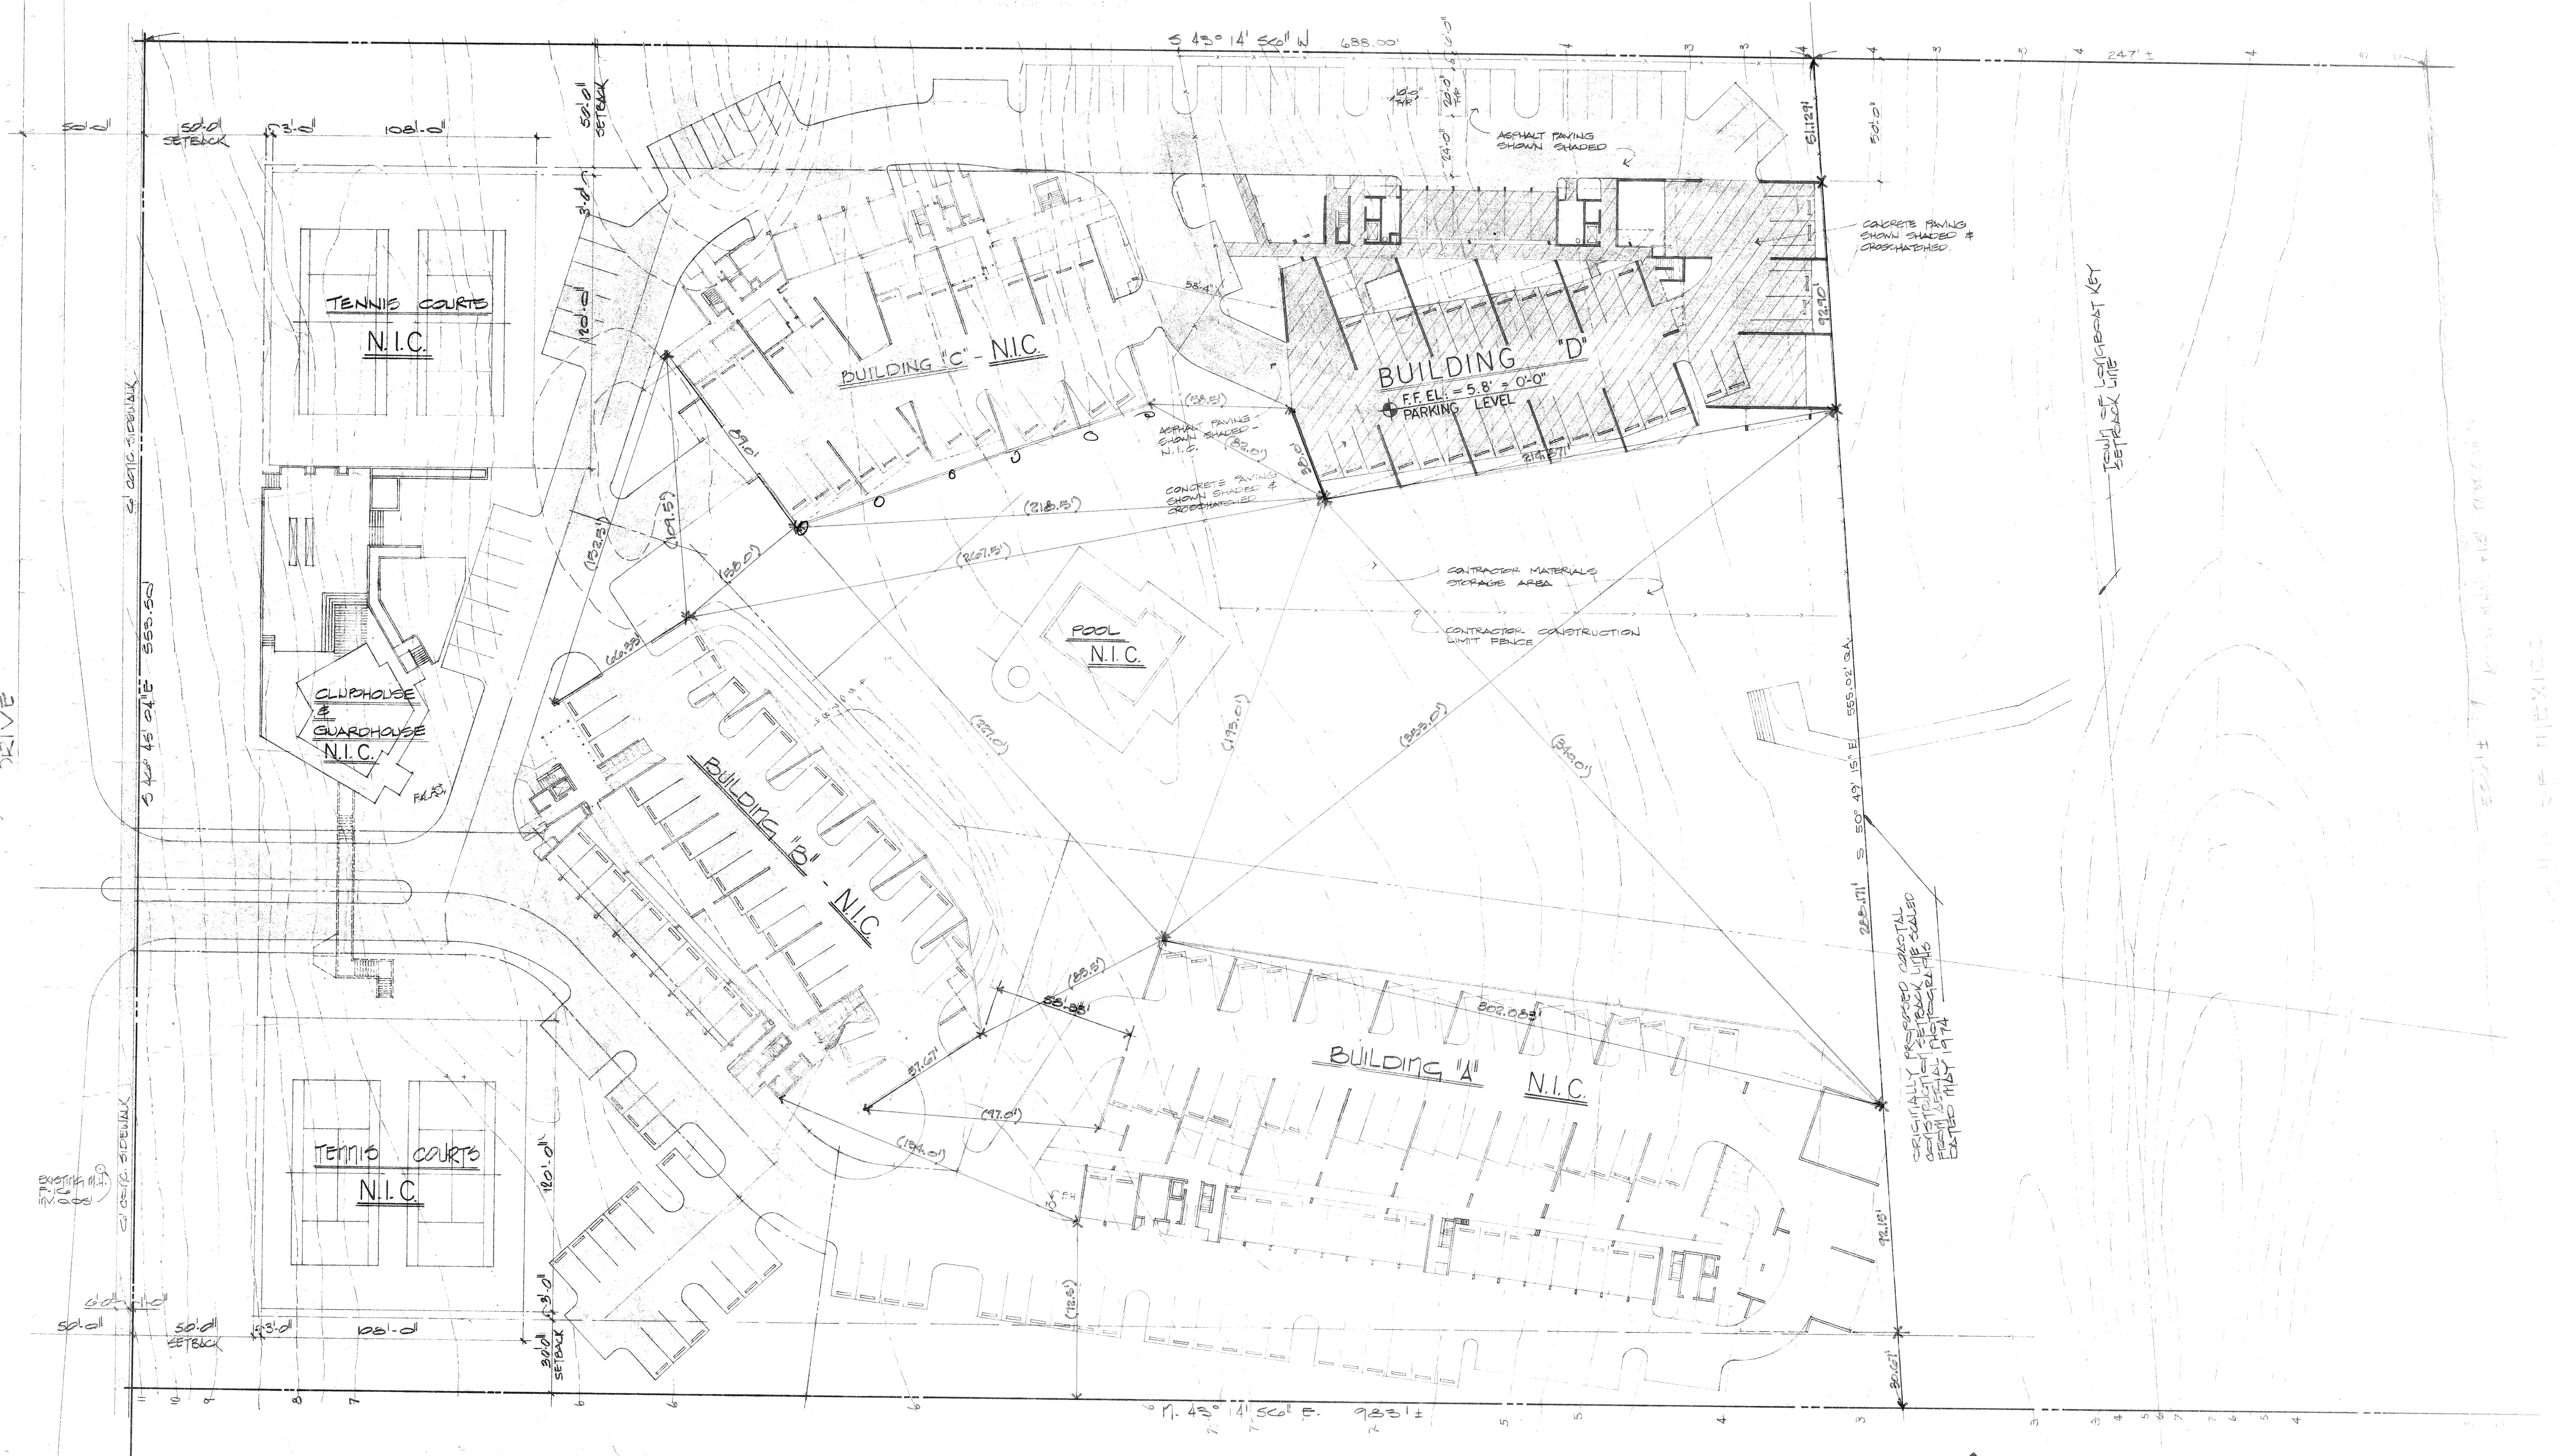

PHASE IV SITE PLAN

1"=30'-0"

LEGEND:
(192.5') = ACTUAL DIMENSIONS BETWEEN POINTS
(92.5') = SCALED DIMENSIONS BETWEEN POINTS

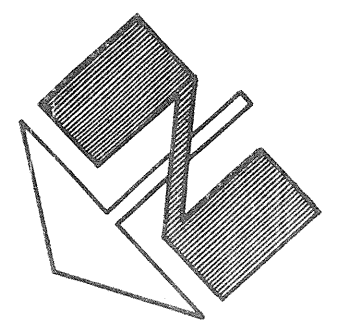

PLAYERS CLUB
BUILDING LOCATION TRIANGULATION.

#01914-04
DATE: 2/28/02
BY: LCL

PLAYERS CLUB MEXICO