


NOTES:

1. PARKING PROVIDED —

REGULAR OUTDOOR	77
HANDICAPPED PKG.	10
INDOOR (COVERED) PKG.	163
	250 TOTAL

- LEGEND
- C.F.P.A.L. EASEMENT
 - WATER MAINS
 - ⊠ GATE VALVE
 - ⊕ FIRE HYDRANT
 - ⊕ TWIN (2) AUTO. SPRINKLER CONN.
 - ⊕ TRIPLE (3) " " "
 - BLC'W OFF
 - SANITARY SEWER MAIN
 - MANHOLE (SANIT.)
 - ⊠ CATCH BASIN
 - ⊠ F.P.A.L. CO TRANSFORMER
 - ⊠ WATER METER
 - ♿ HANDICAPPED PARKING ONLY
 - LENGTH, SIZE & MATERIAL
 - CONTOUR LINES

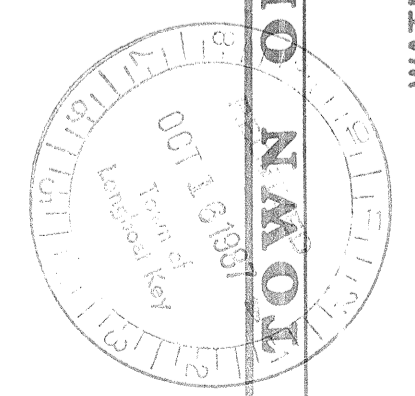

DESIGNED BY PROJECT ENGINEER	
DATE: APRIL, 1983	CHECKED BY PROJECT NO. 261
SCALE: 1" = 40'	DRAWN BY D. DALLAS
BY RMC	REVISION
LTR.	DATE
TOWN OF LONGBOAT KEY, FLORIDA	
THE PLAYERS CLUB	
AS BUILT	
WATER DISTRIBUTION & SEWAGE COLLECTION	
BENNETT & BISHOP, INC. CONSULTING ENGINEERS & SURVEYORS 4309 BEE RIDGE RD. SARASOTA, FLORIDA	
SHEET NUMBER 261-C19-A3	FILE NO.