


JEWELL

DO NOT REMOVE FROM OFFICE

BAY PLANS UNIT NO. 1  
P.E. 25, P.A. 25, 35, 35B

TYP EASEMENT  
TO TOWN OF  
LONGBOAT KEY  
(ALL UTILITIES)

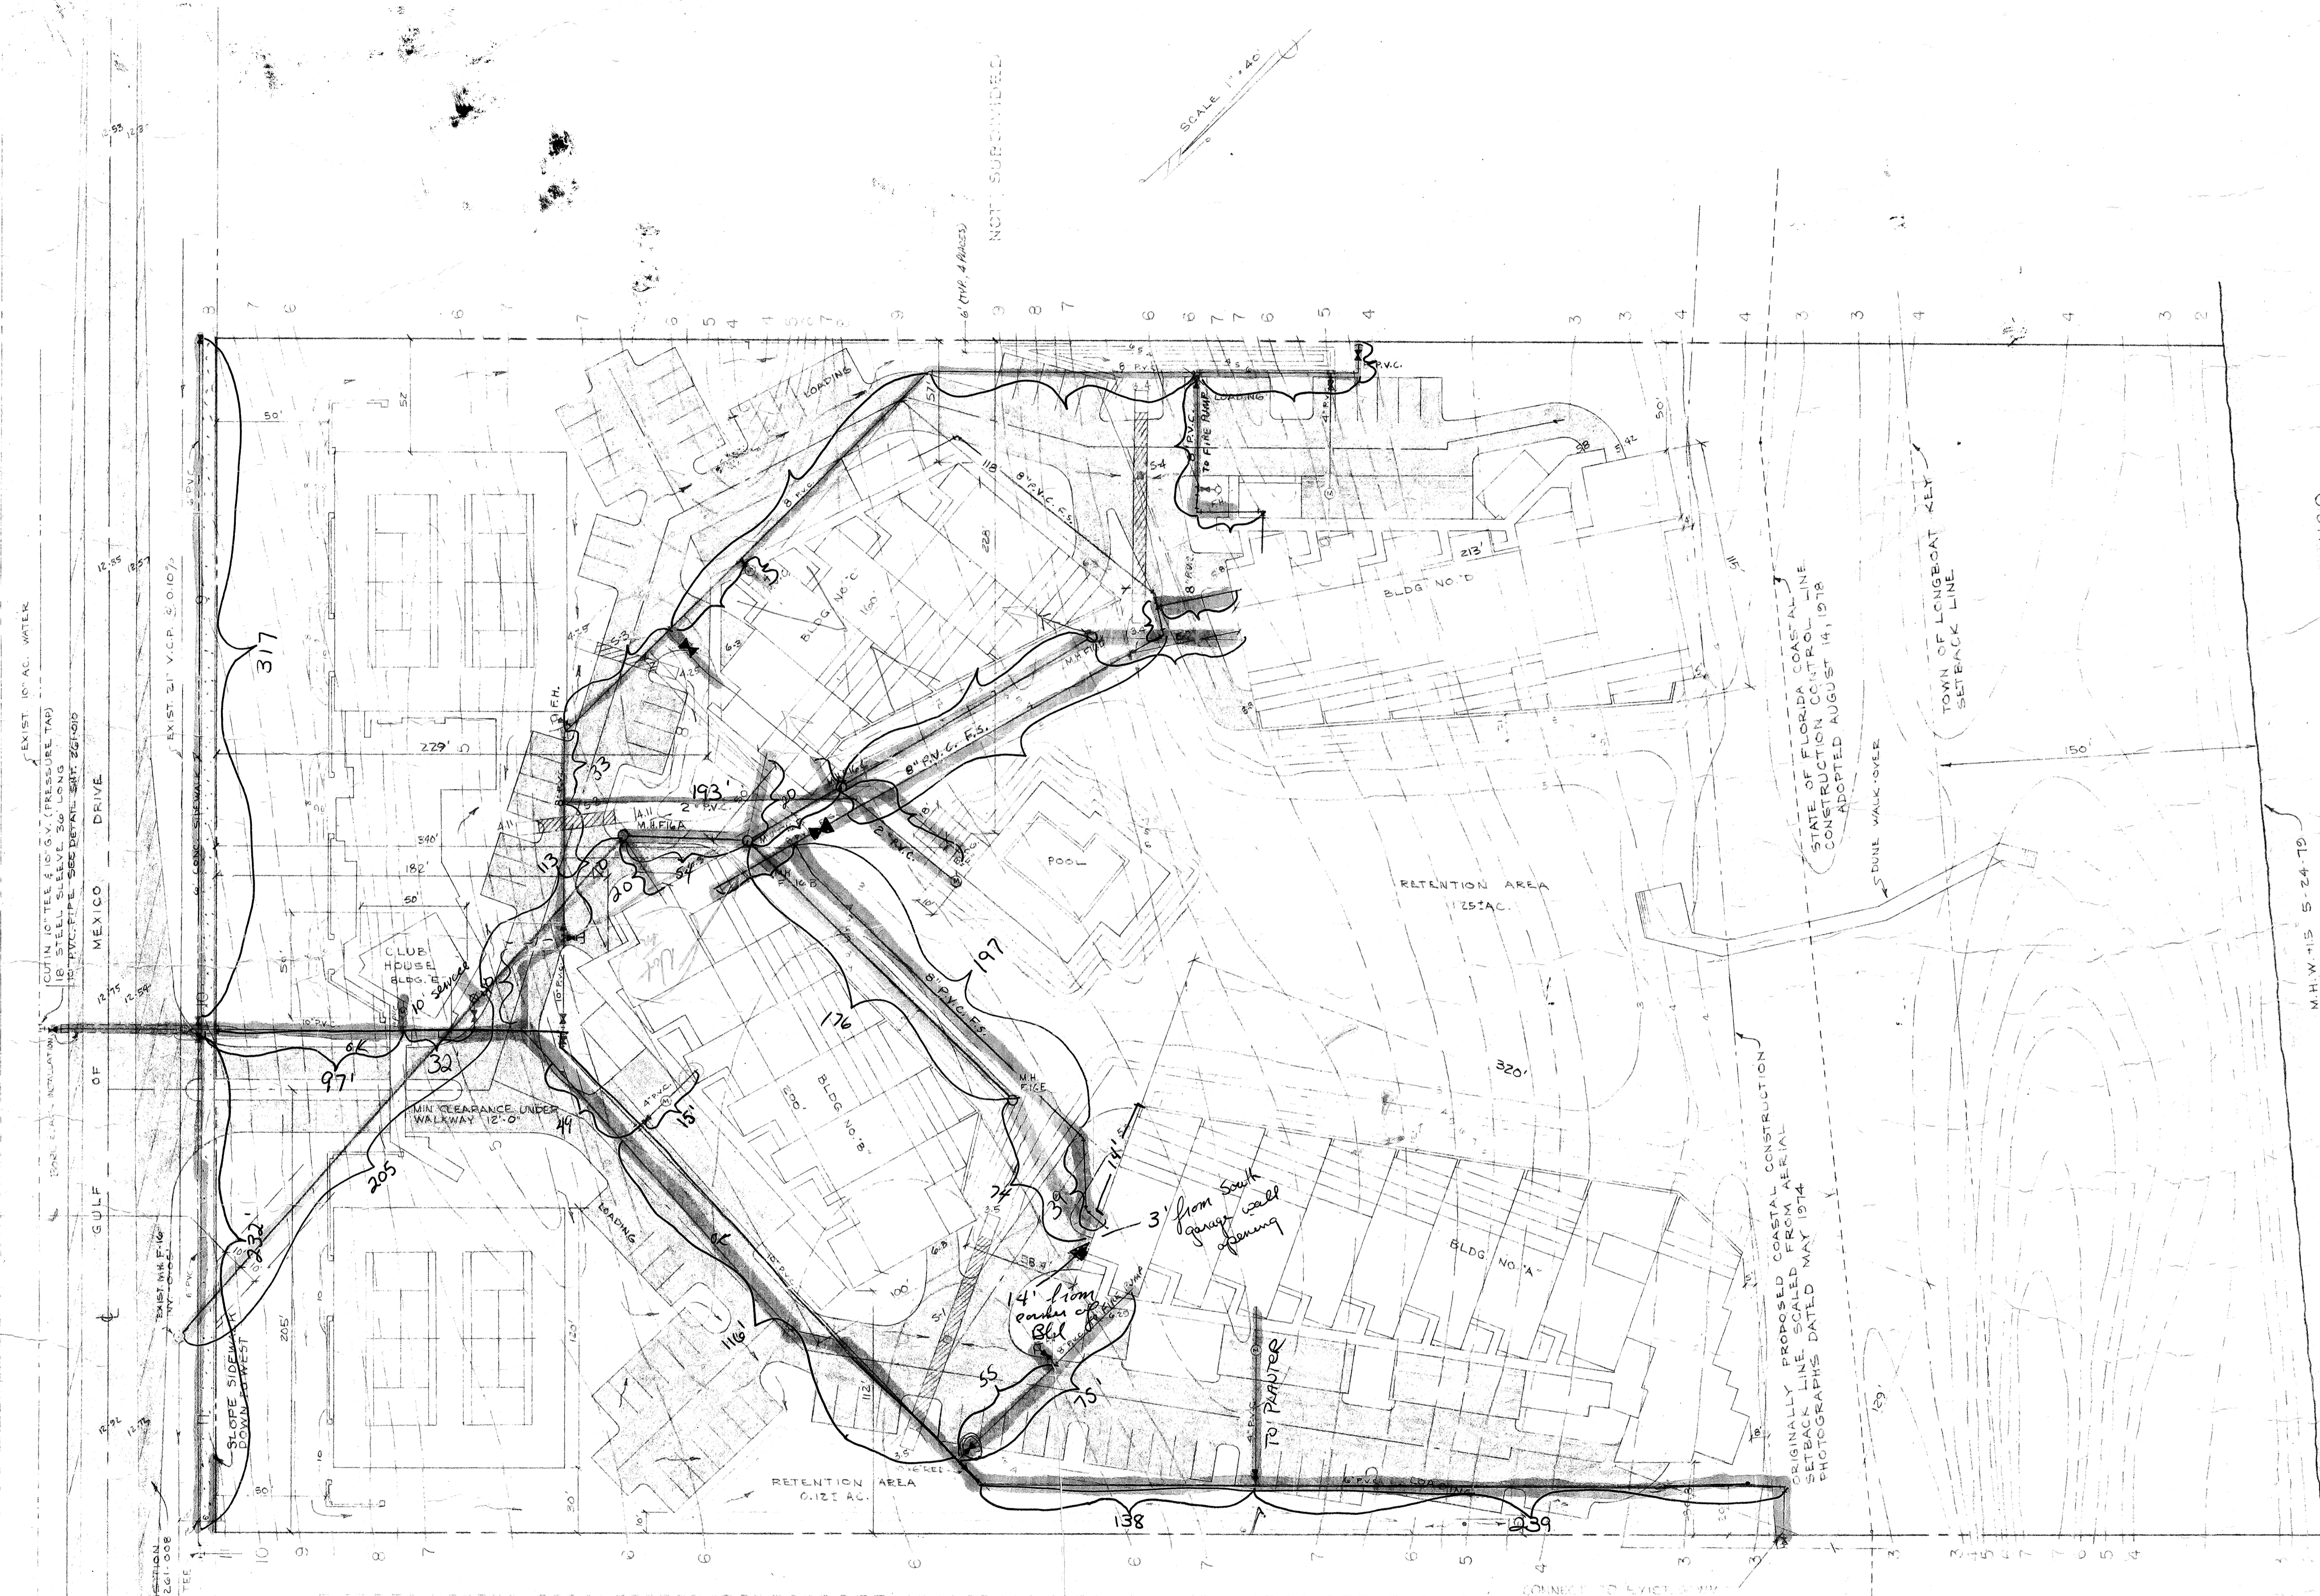

AS B'LT.

Site as built  
4th  
sewer  
etc.

7-11-70	CHIEF 2 1/2" STAVES TO 2"	MM
7-9-70	REV. F.S. & DOMESTIC WATER L.O.P.	MM
2-22-50	ADD 2" R.T.V.	MM
2-1-50	ADD NOTE	MM
12-1-49	REV. PLAN	MM
12-1-49	REV. PLAN	MM

8-15-75	1"=40'	DR.H
---------	--------	------

FLORIDA

GULF

OF

MEXICO

THE PLAYERS CLUB

DETAIL SITE PLAN

BENNETT & BISHOP

INCORPORATED 1914

11-15-70

2-5-1-

PLAYERS CLUB