


SCALE: 1" = 50'

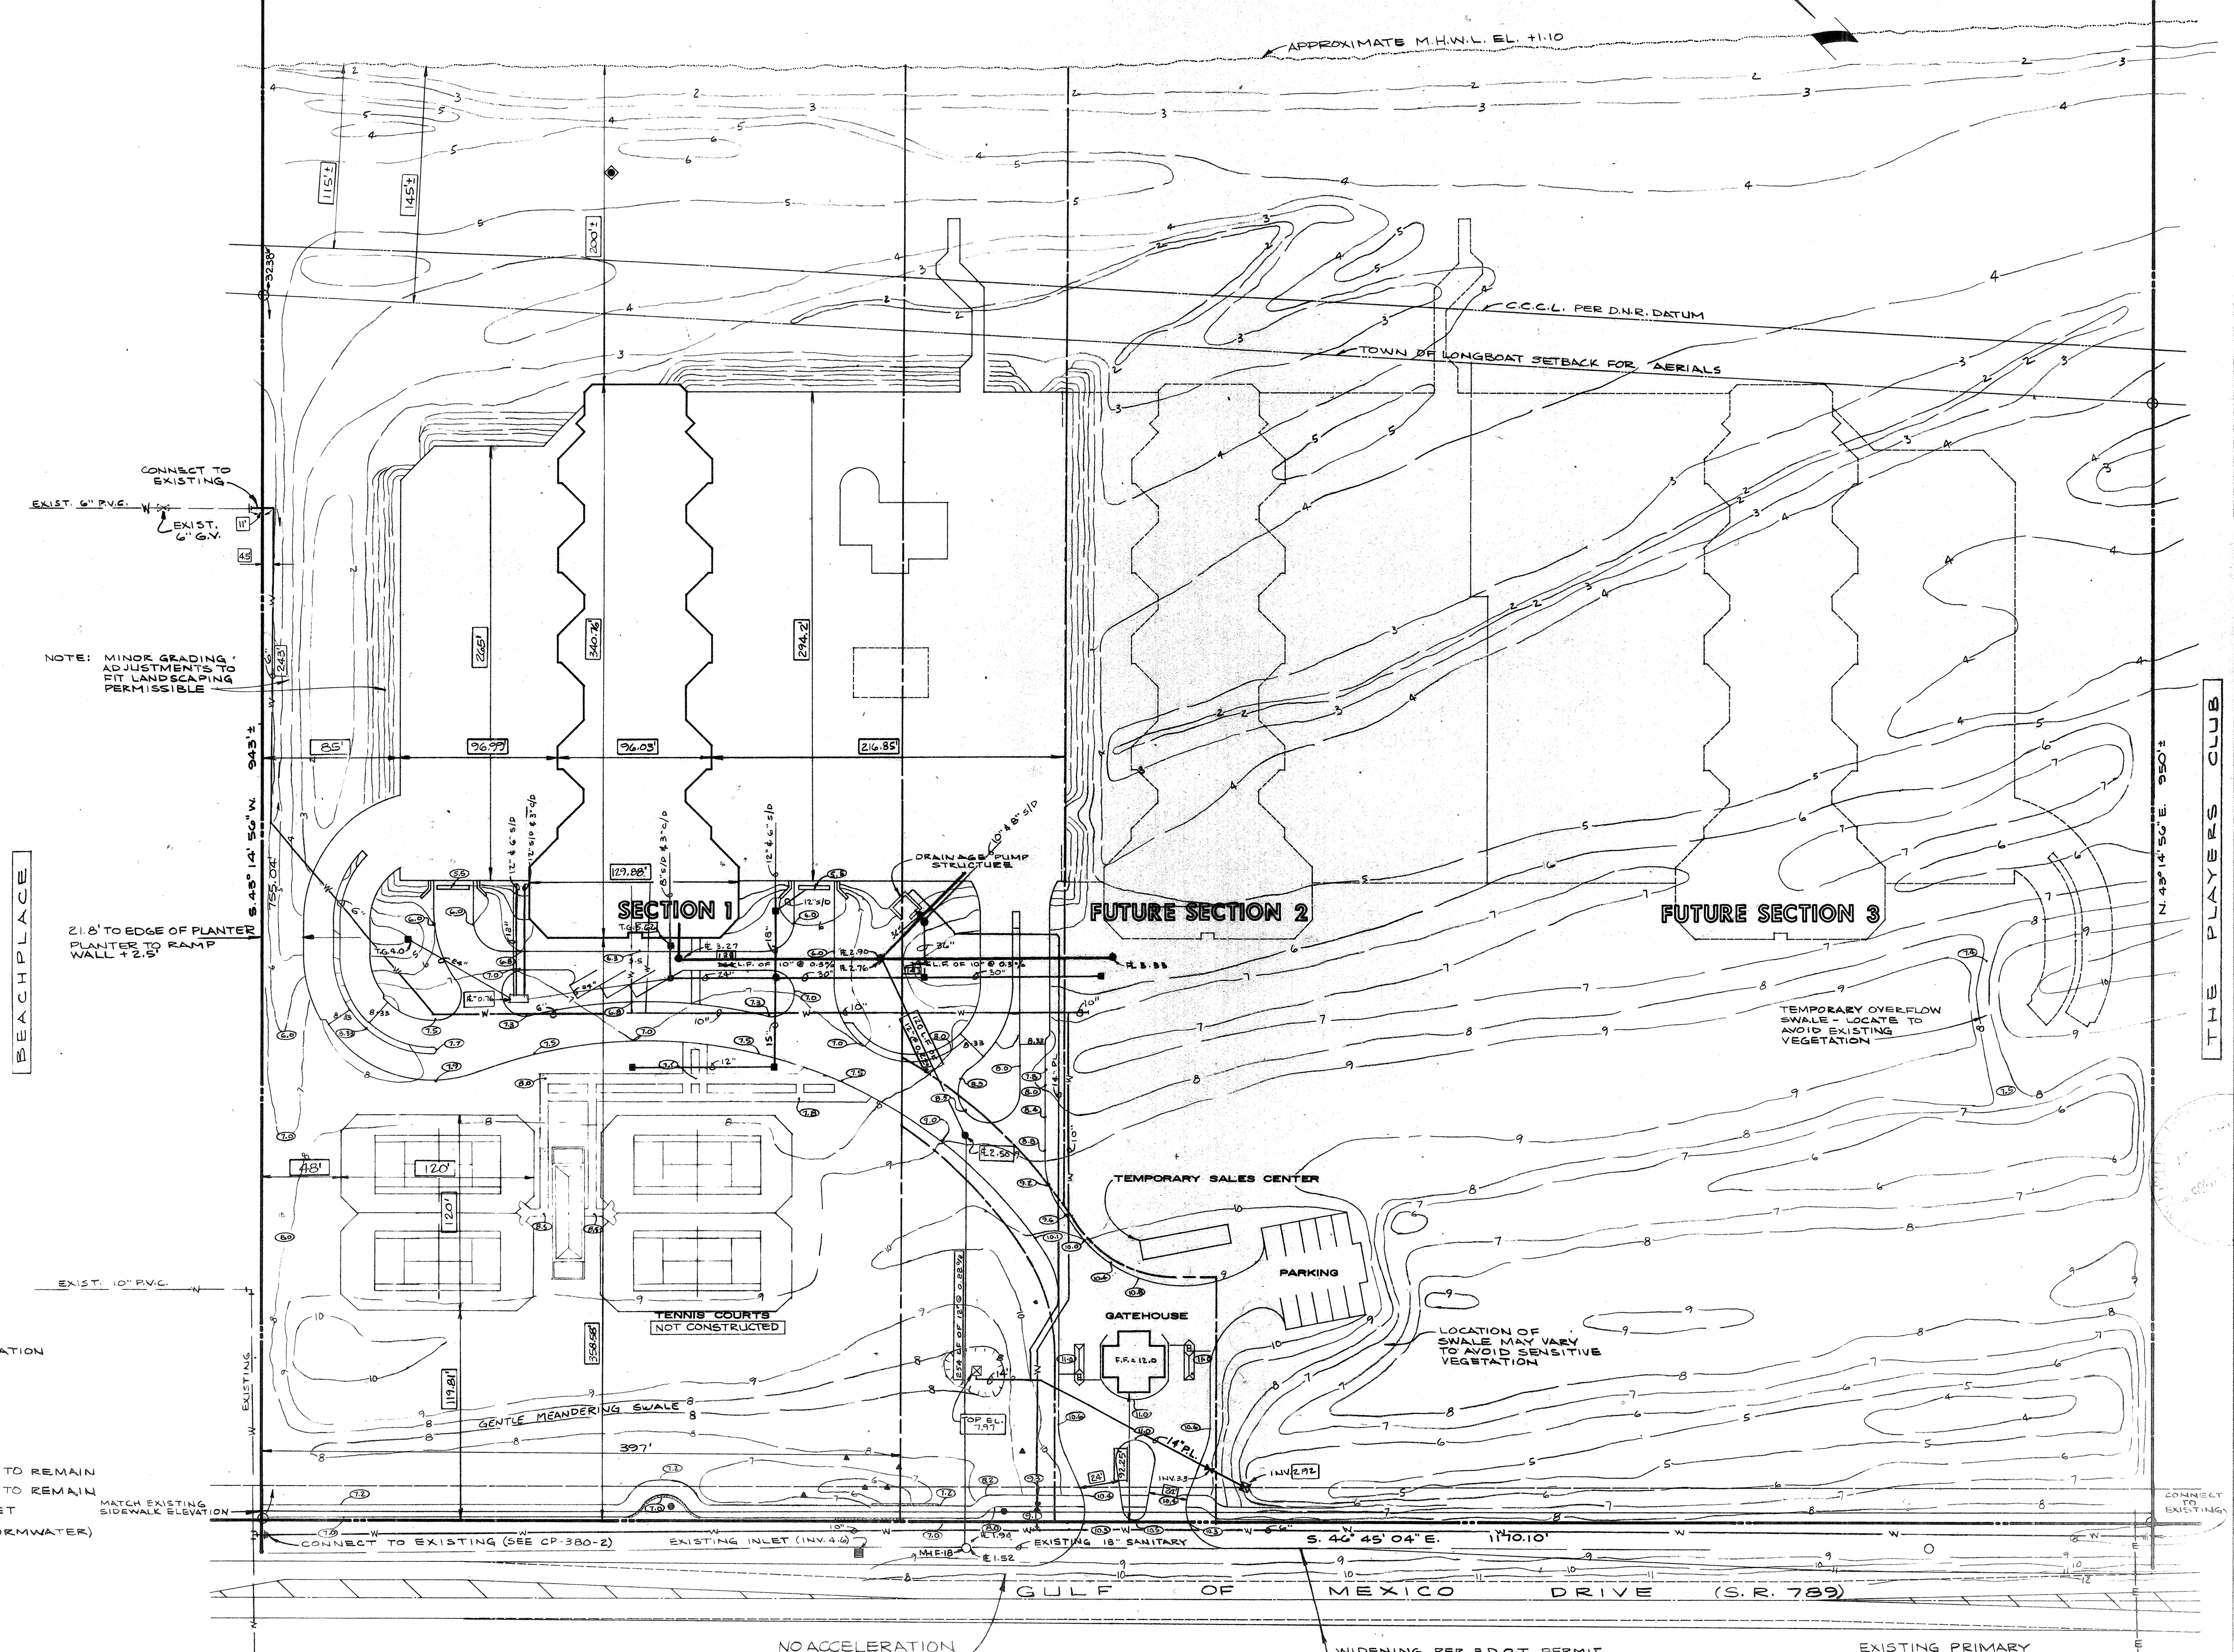

NOTE: MINOR GRADING ADJUSTMENTS TO FIT LANDSCAPING PERMISSIBLE

BEACHPLACE

21.8' TO EDGE OF PLANTER PLANTER TO RAMP WALL +2.5'

**LEGEND**

- GRADING CONTOUR
- PROPOSED SPOT ELEVATION
- S/D STORM DRAIN
- C/D CONDENSATE DRAIN
- MANHOLE
- INLET
- PIPE SIZE
- EXISTING CEDARS TO REMAIN
- ▲ EXISTING TREES TO REMAIN
- ⊠ "BUBBLE-UP" INLET
- PL. PUMPED LINE (STORMWATER)

MATCH EXISTING SIDEWALK ELEVATION

NO ACCELERATION LANE REQUIRED

WIDENING PER P.D.O.T. PERMIT

EXISTING PRIMARY ELECTRICAL CABLE CROSSING CALL FOR LOCATION

THE PLAYERS CLUB

TOWN OF LONGBOAT KEY, FLORIDA		L.T.R. DATE	REVISION	BY	SCALE:	DATE:	DESIGNED BY	PROJECT ENGINEER
PARKSHORE DEVELOPMENT CO., INC.					1" = 50'	11-1-85	LDL	LDL
PROMENADE I - AS BUILT							ALP	
WATER DISTRIBUTION - SEWER COLLECTION - DRAINAGE							LDL	380
PROJECT LOCATION: JOHNSON, COLLINER & LIPPERT, INC. - CONSULTING ENGINEERS - 3905 SOUTH SHADE AVENUE - SARASOTA, FL 35581								
SHEET NO. 380-1								
NOV 06 '85								