
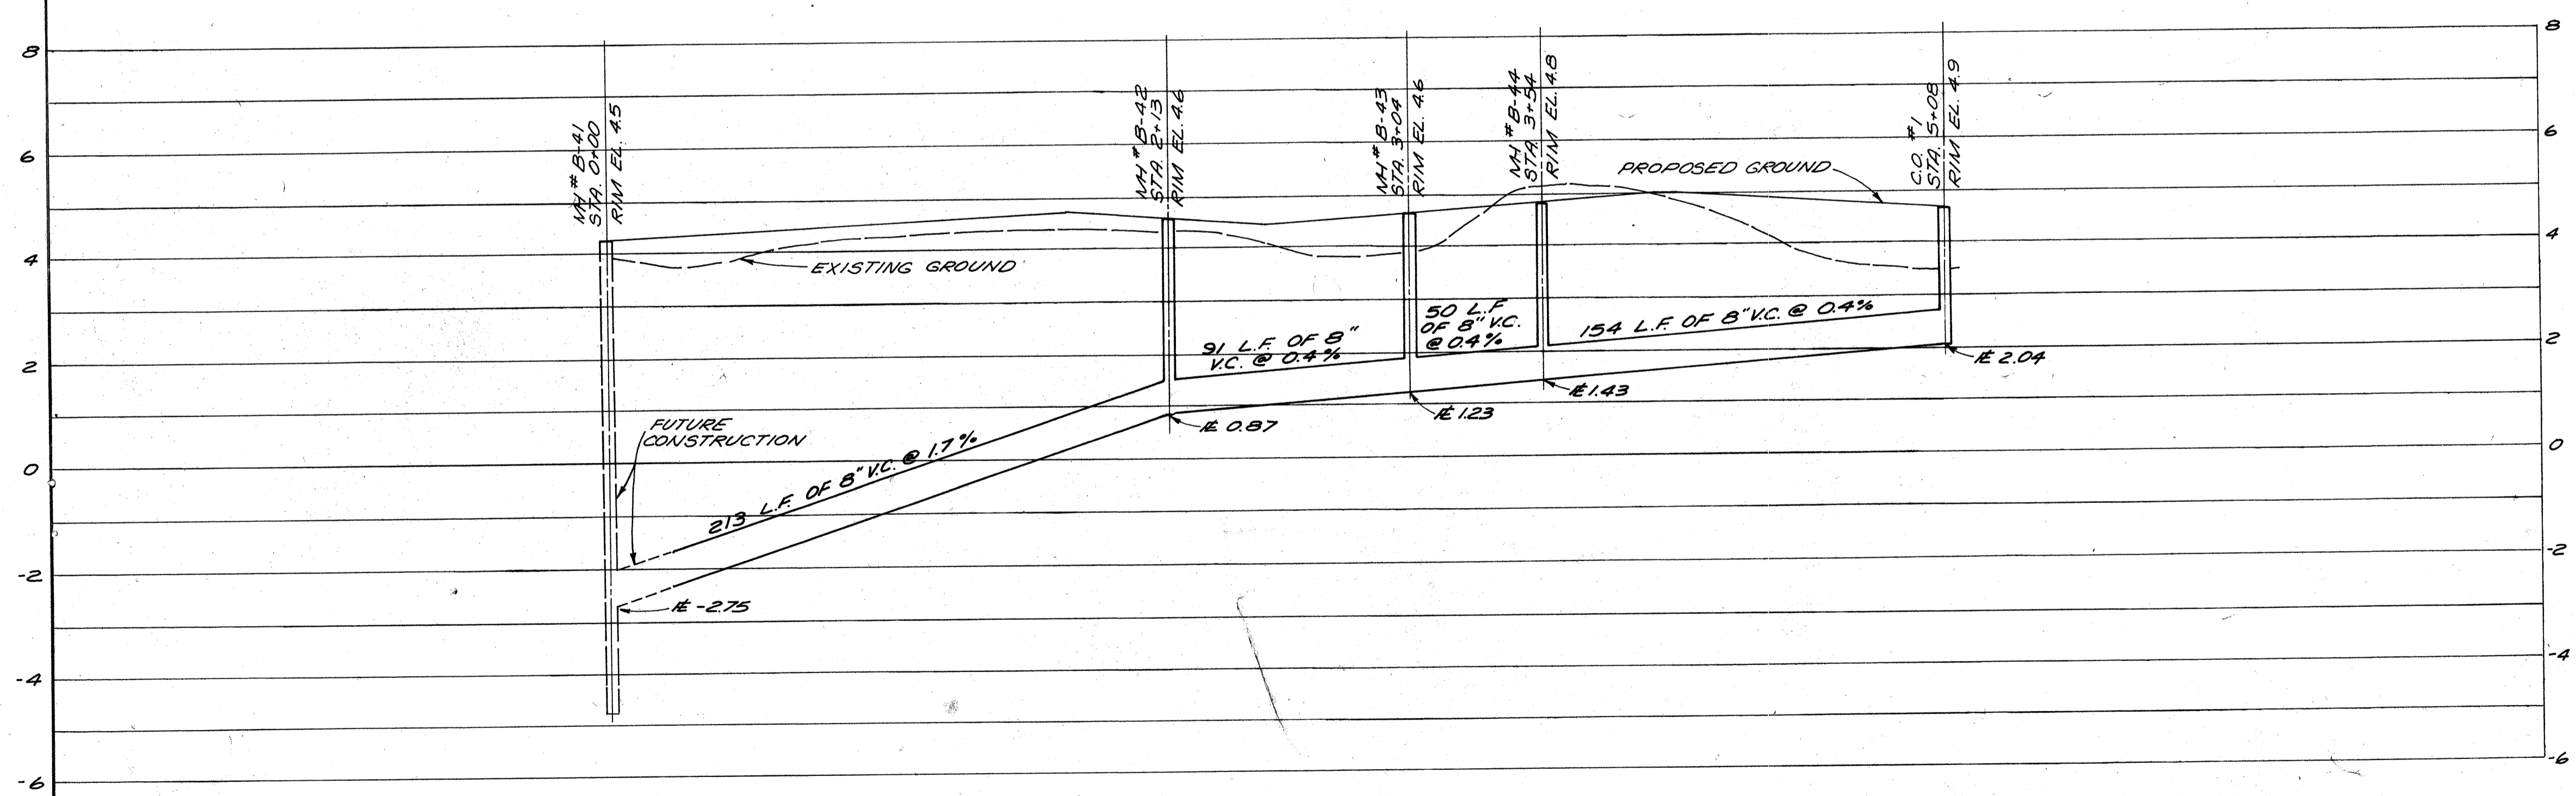


PLAN	SURVEYED	DATE
	FLOTTED	BY
	ALIGNMENT CHECKED	
	RT. OF WAY CHECKED	
NO.		

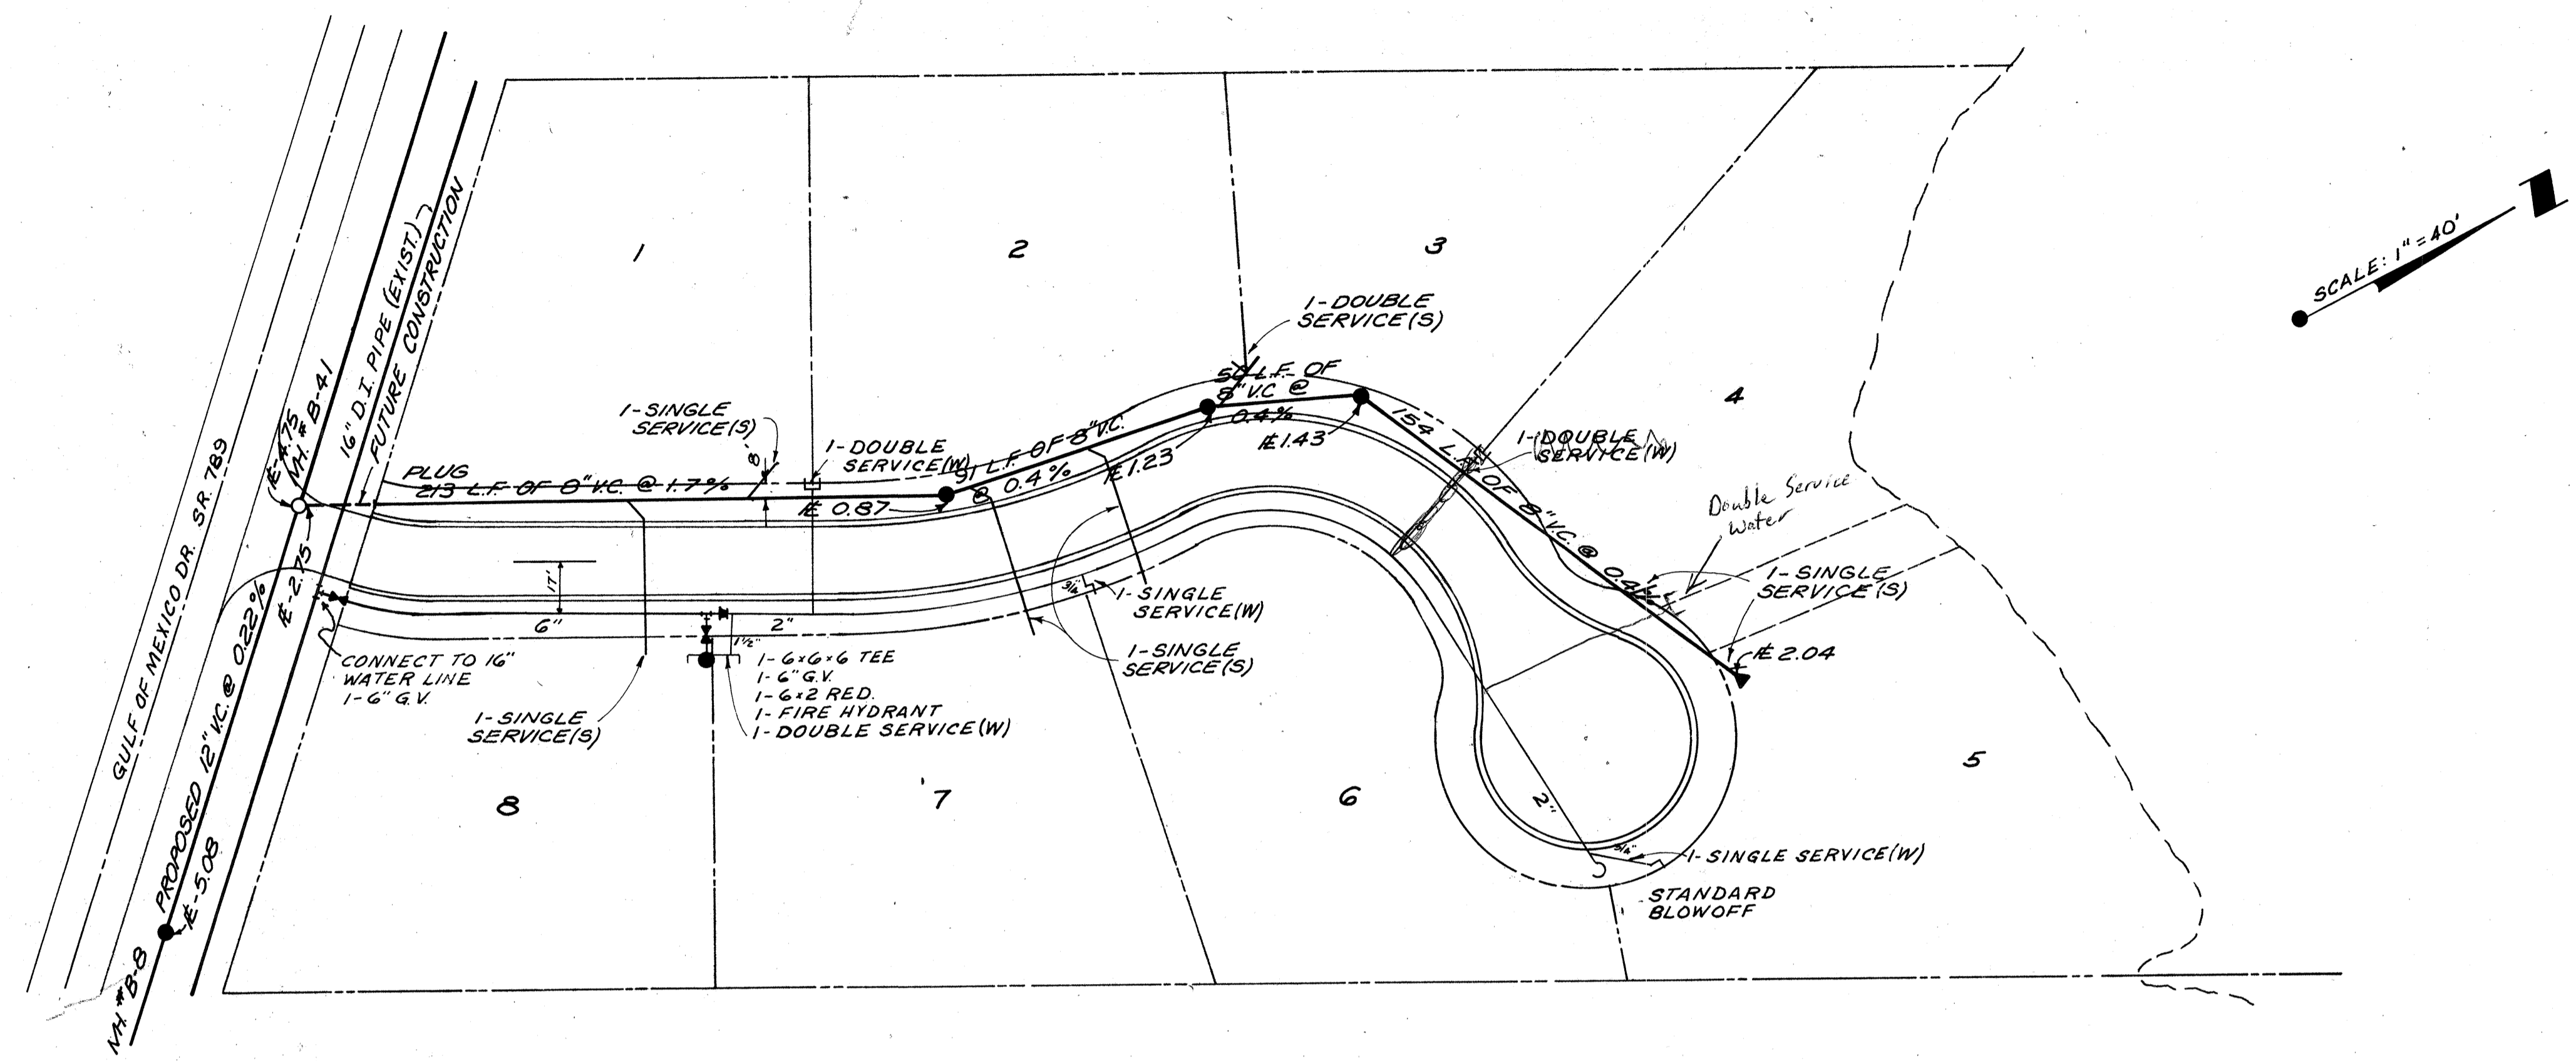

THESE PLANS HAVE BEEN APPROVED BY THE
STATE OF FLORIDA
DEPARTMENT OF POLLUTION CONTROL
APPROVAL DATE _____ SERIAL NO. _____
SMALLY, WELLFORD & NALVEN, CONSULTING ENGINEERS

THESE PLANS HAVE BEEN APPROVED BY
THE FLORIDA STATE BOARD OF HEALTH
BUREAU OF SANITARY ENGINEERING
WATER ONLY
APPROVAL DATE 11 23 71 SERIAL NO. 12540-C
SMALLY, WELLFORD & NALVEN, CONSULTING ENGINEERS

REVISIONS		SCALE: 1" = 40' H 1" = 2' V	DATE: 8-20-71	FOR: HERB FIELD LONGBOAT KEY, FLORIDA
LTR.	DESCRIPTION, DATE AND BY	DESIGNED BY: LDL	DRAWN BY: LDL	WATER DISTRIBUTION & WASTEWATER COLLECTION SYSTEM RECLINATA A SUBDIVISION LONGBOAT KEY, FLORIDA
"A"	CHANGE CUL-DE-SAC ROW TO 100' 110-TITLE	CHECKED BY: J.G.	APPROVED BY: DONALD J. SMALLY, PE FLA. CERT. NO. 5051	
"B"	ADD WASTEWATER COLLECTION SYSTEM PLAN & PROFILE 5-21-73 SLK	PROJECT NO. 1359		DRAWING NUMBER E-1359 (3)
				REVISION B

INSTR. No. E-1359-3