


HORIZONTAL SCALE - 1" = 40'
VERTICAL SCALE - 1" = 2'

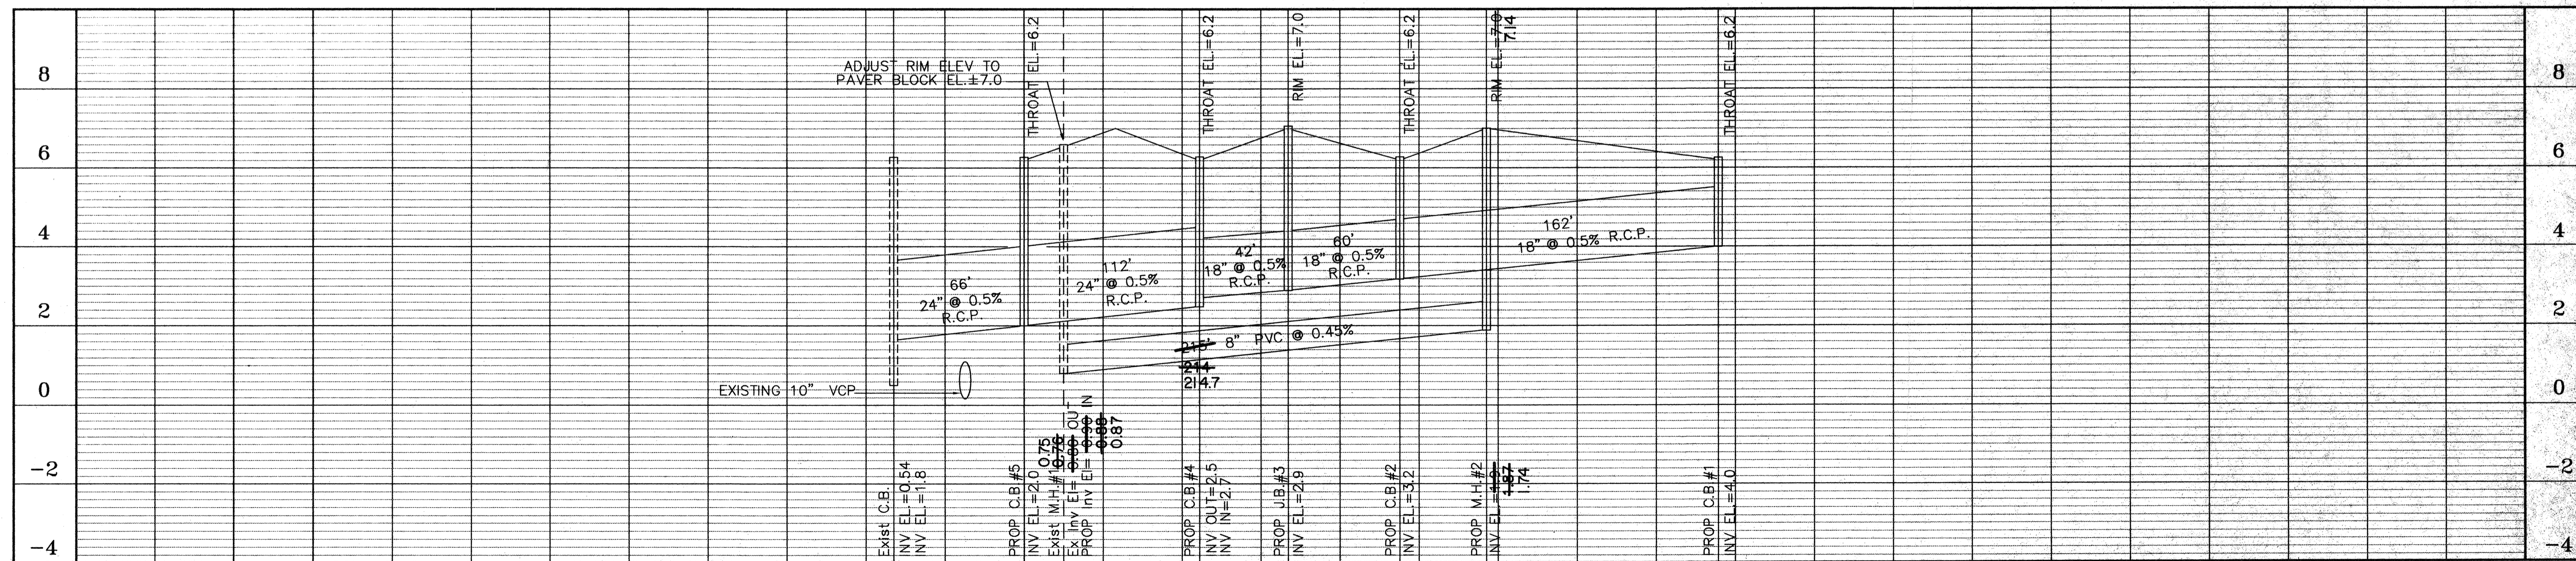

RECORD DRAWING

BISHOP & ASSOCIATES
Consulting Engineers • Surveyors
AN EMPLOYEE OWNED COMPANY
78 SARASOTA CENTER BLVD., SARASOTA, FLORIDA 34240
813/371-6362 • Fax 813/378-3215

BY	DATE	Q.C.	DATE	DESCRIPTION
DNS	7-27-95	PCP	7-27-95	UPDATED RECORD DRAWING
PSN	6-7-94	MAA	6-7-94	ADD RECORD DRAWING INFORMATION
DNS	4/26/94	JTT	4/26/94	ADDED J.B. TO SD-REV. W.M. LOCATION
DNS	1/6/94	JTT	1/6/94	CHANGE DOMESTIC W.M. TO 4" P.V.C.

TASK	INITIALS	DATE
DESIGN	J.J.T.	7/2/93
DRAWN	D.D.E.	7/2/93
CHECKED		
QUALITY CHK.		

1" = 40'

SEAL *Mark A. Collier*
1/8/95
ENGINEER OR SURVEYOR OF RECORD

CLIENT/TITLE
**REGENT PLACE
SANITARY/STORM SEWER PROFILE**

PROJECT NO.
RPC-01

SHEET NO.
4AB

C:\DWG\REGENT\RPC014AB.MXD JUN 6 15:21:03 1994