


SCALE: 1"=30'

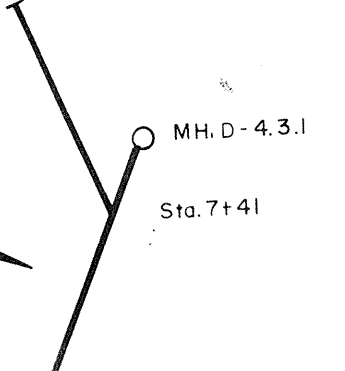

GULF OF MEXICO DRIVE (S. R. 789)

DESIGNED BY PROJECT ENGINEER		DATE: 3-5-86	
DRAWN BY R.W.C.		CHECKED BY PROJECT NO. F.V.	
BY SCALE: 1"=30'		REVISION	
ADDN STATIONING & TIES TO SANITARY SEWER & WATERMAIN		LTR. DATE	
9-3-86			
<b>TOWN OF LONGBOAT KEY, FLORIDA</b>			
P. WALLEBERG DEVELOPMENT CO. INC.			
AS-BUILT SANDHAMN			
ENGINEER & LOCATION: BENNETT & BISHOP INC., 4509 BEE RIDGE ROAD SARASOTA, FLORIDA			
SHEET NUMBER PWAL-0031		FILE NO.	
2			
REVISION			