
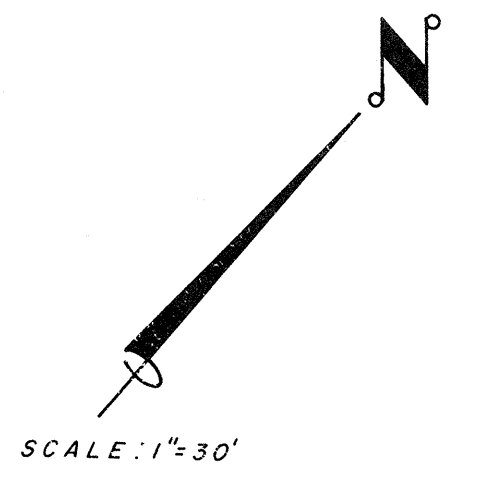


SANDHAM
 WITH

GULF OF MEXICO DRIVE (S.R. 789)

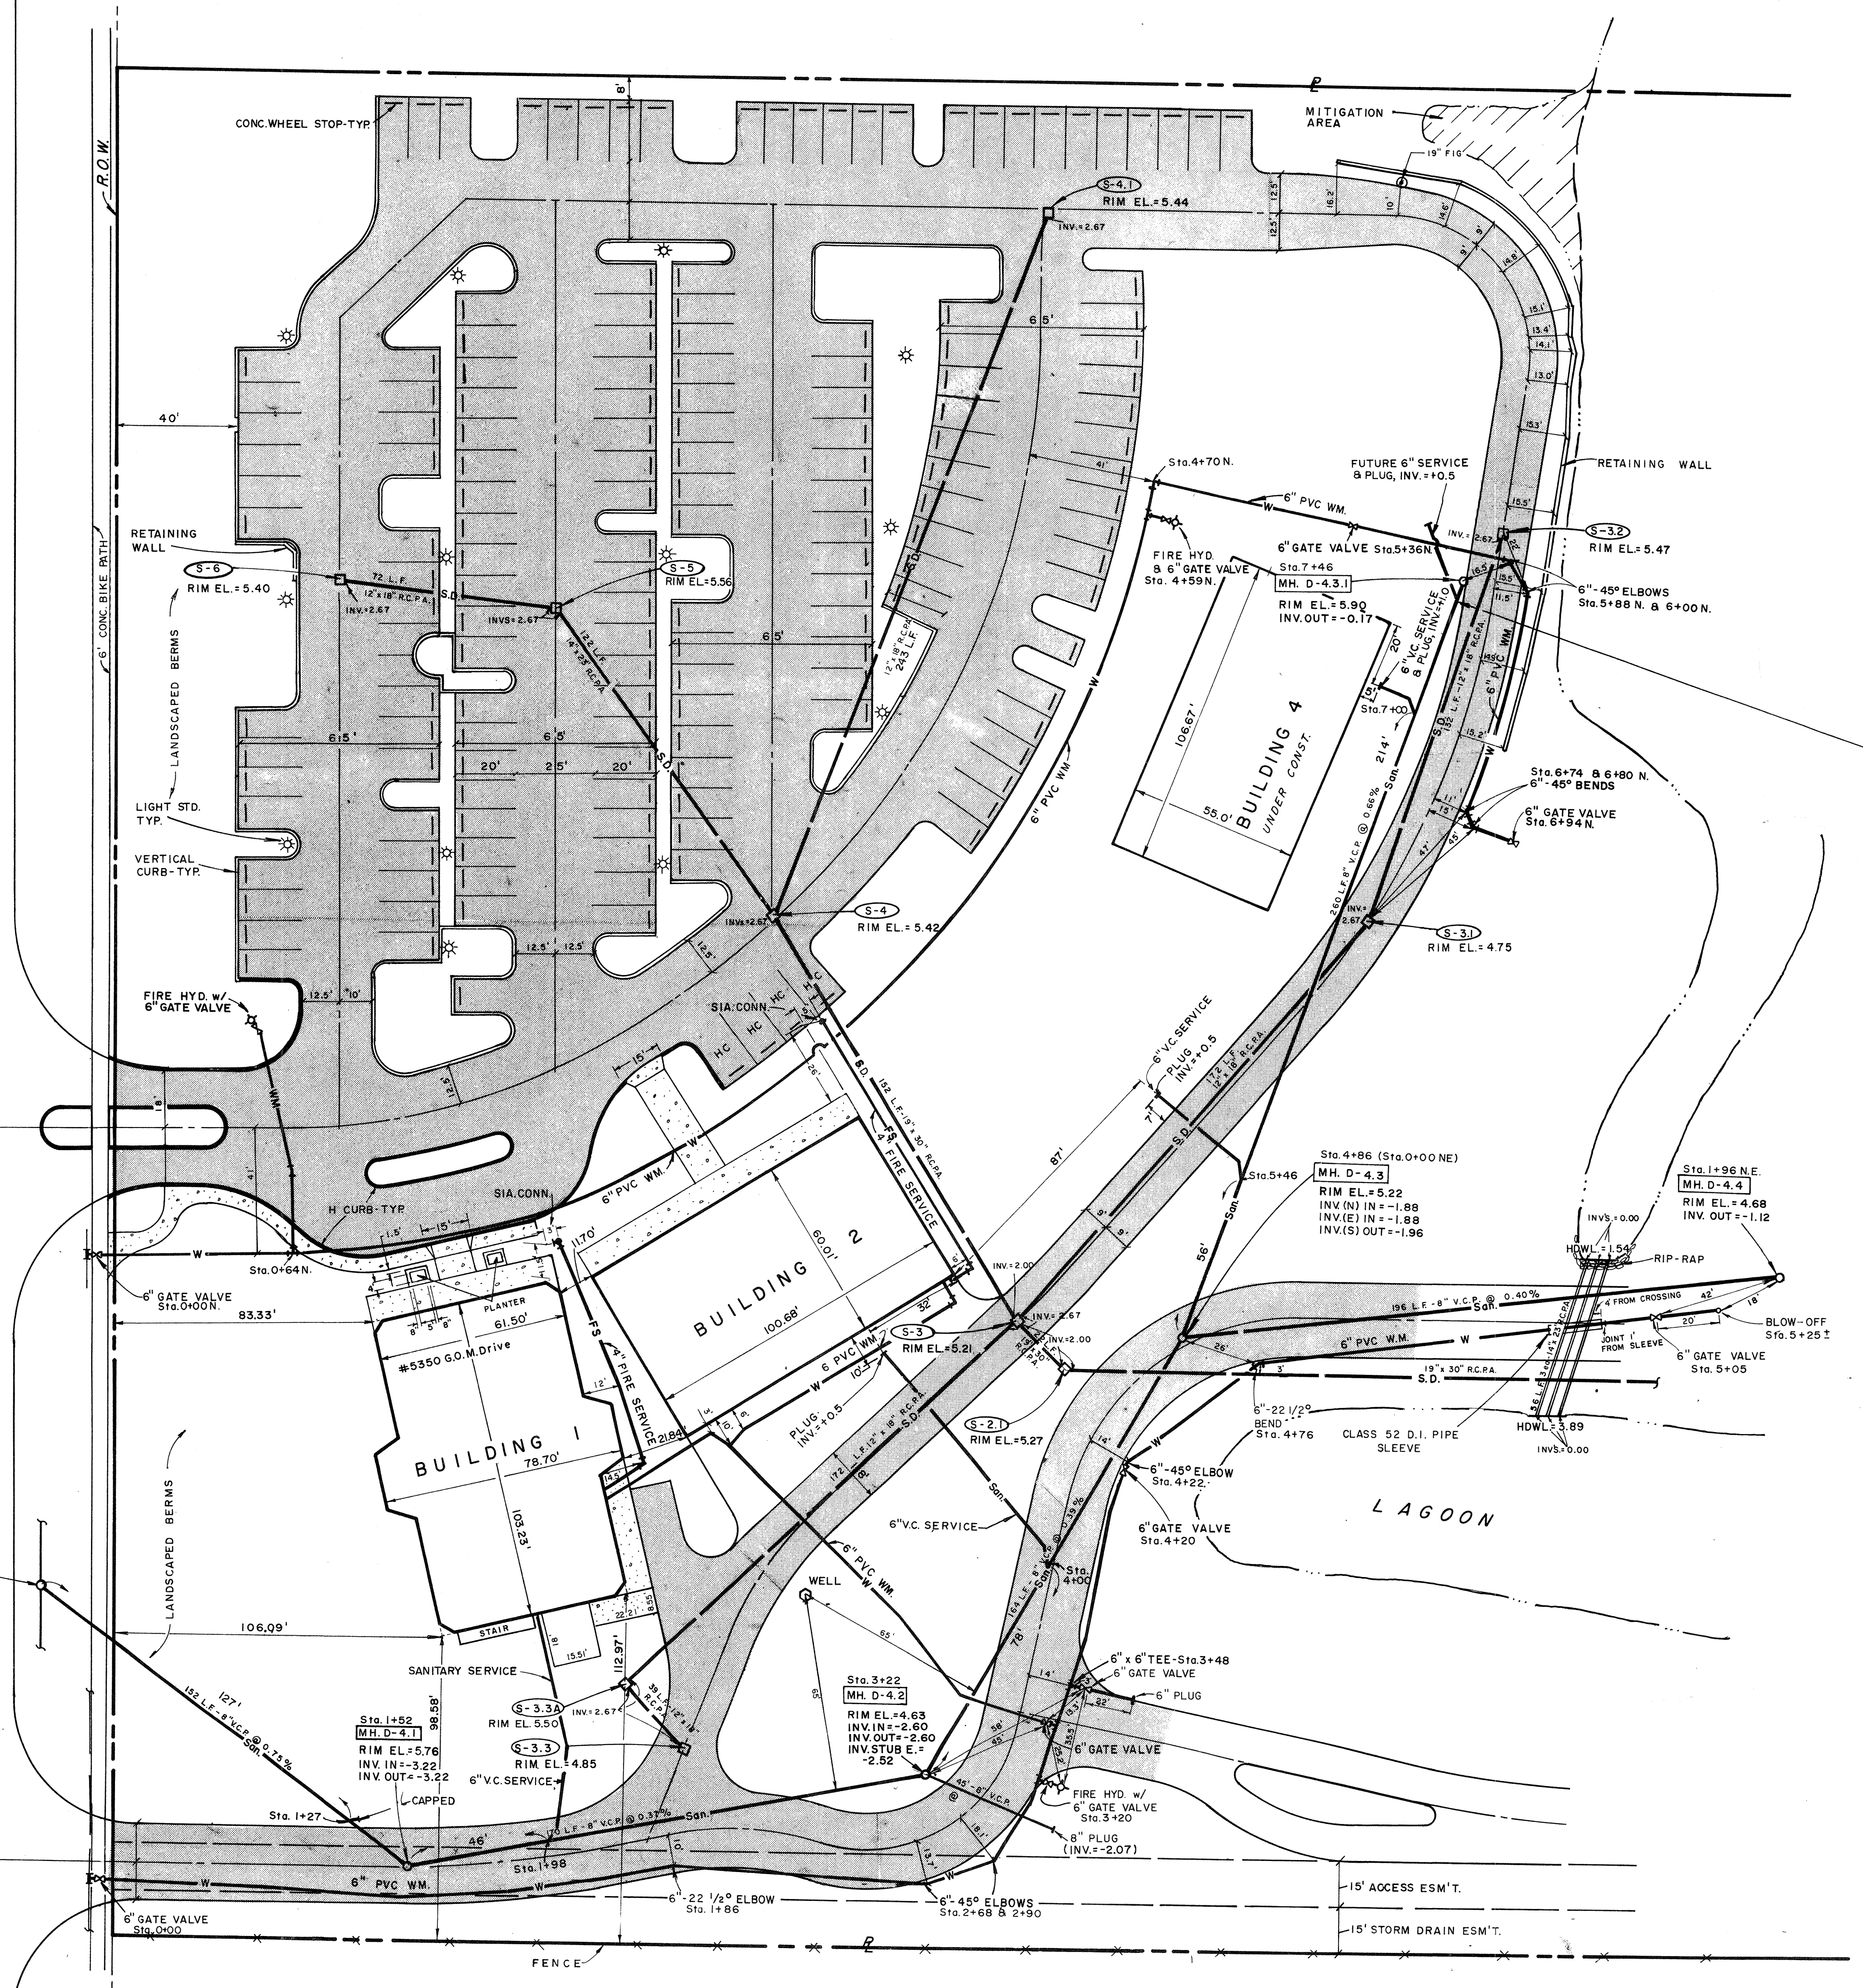

DESIGNED BY P.V.	DATE: 3-5-86	BY R.W.C.	REVISION	LTR. DATE	PROJECT ENGINEER SARASOTA, FLORIDA
	CHECKED BY F.V.		ADDED STATIONING & TIES TO SANITARY SEWER & WATERMAIN 9-3-86		
SCALE: 1"=50'		DRAWN BY R.W.C.		PROJECT NO. #889 E.P.E.	
TOWN OF LONGBOAT KEY, FLORIDA		P. WALLENBERG DEVELOPMENT CO. INC.		SARASOTA, FLORIDA	
AS-BUILT		SANDHAM		BENNETT & BISHOP, INC. 4509 BEE RIDGE ROAD	
ENGINEER & LOCATION		SHEET NUMBER PWAL-0031		REVISION 2	
T.L.K. FILE NO.		15' ACCESS ESM'T.		15' STORM DRAIN ESM'T.	