



GULF OF MEXICO  
 MEAN HIGH WATER LINE  
 22 JANUARY 1972  
 1.46' ABOVE M.S.L.

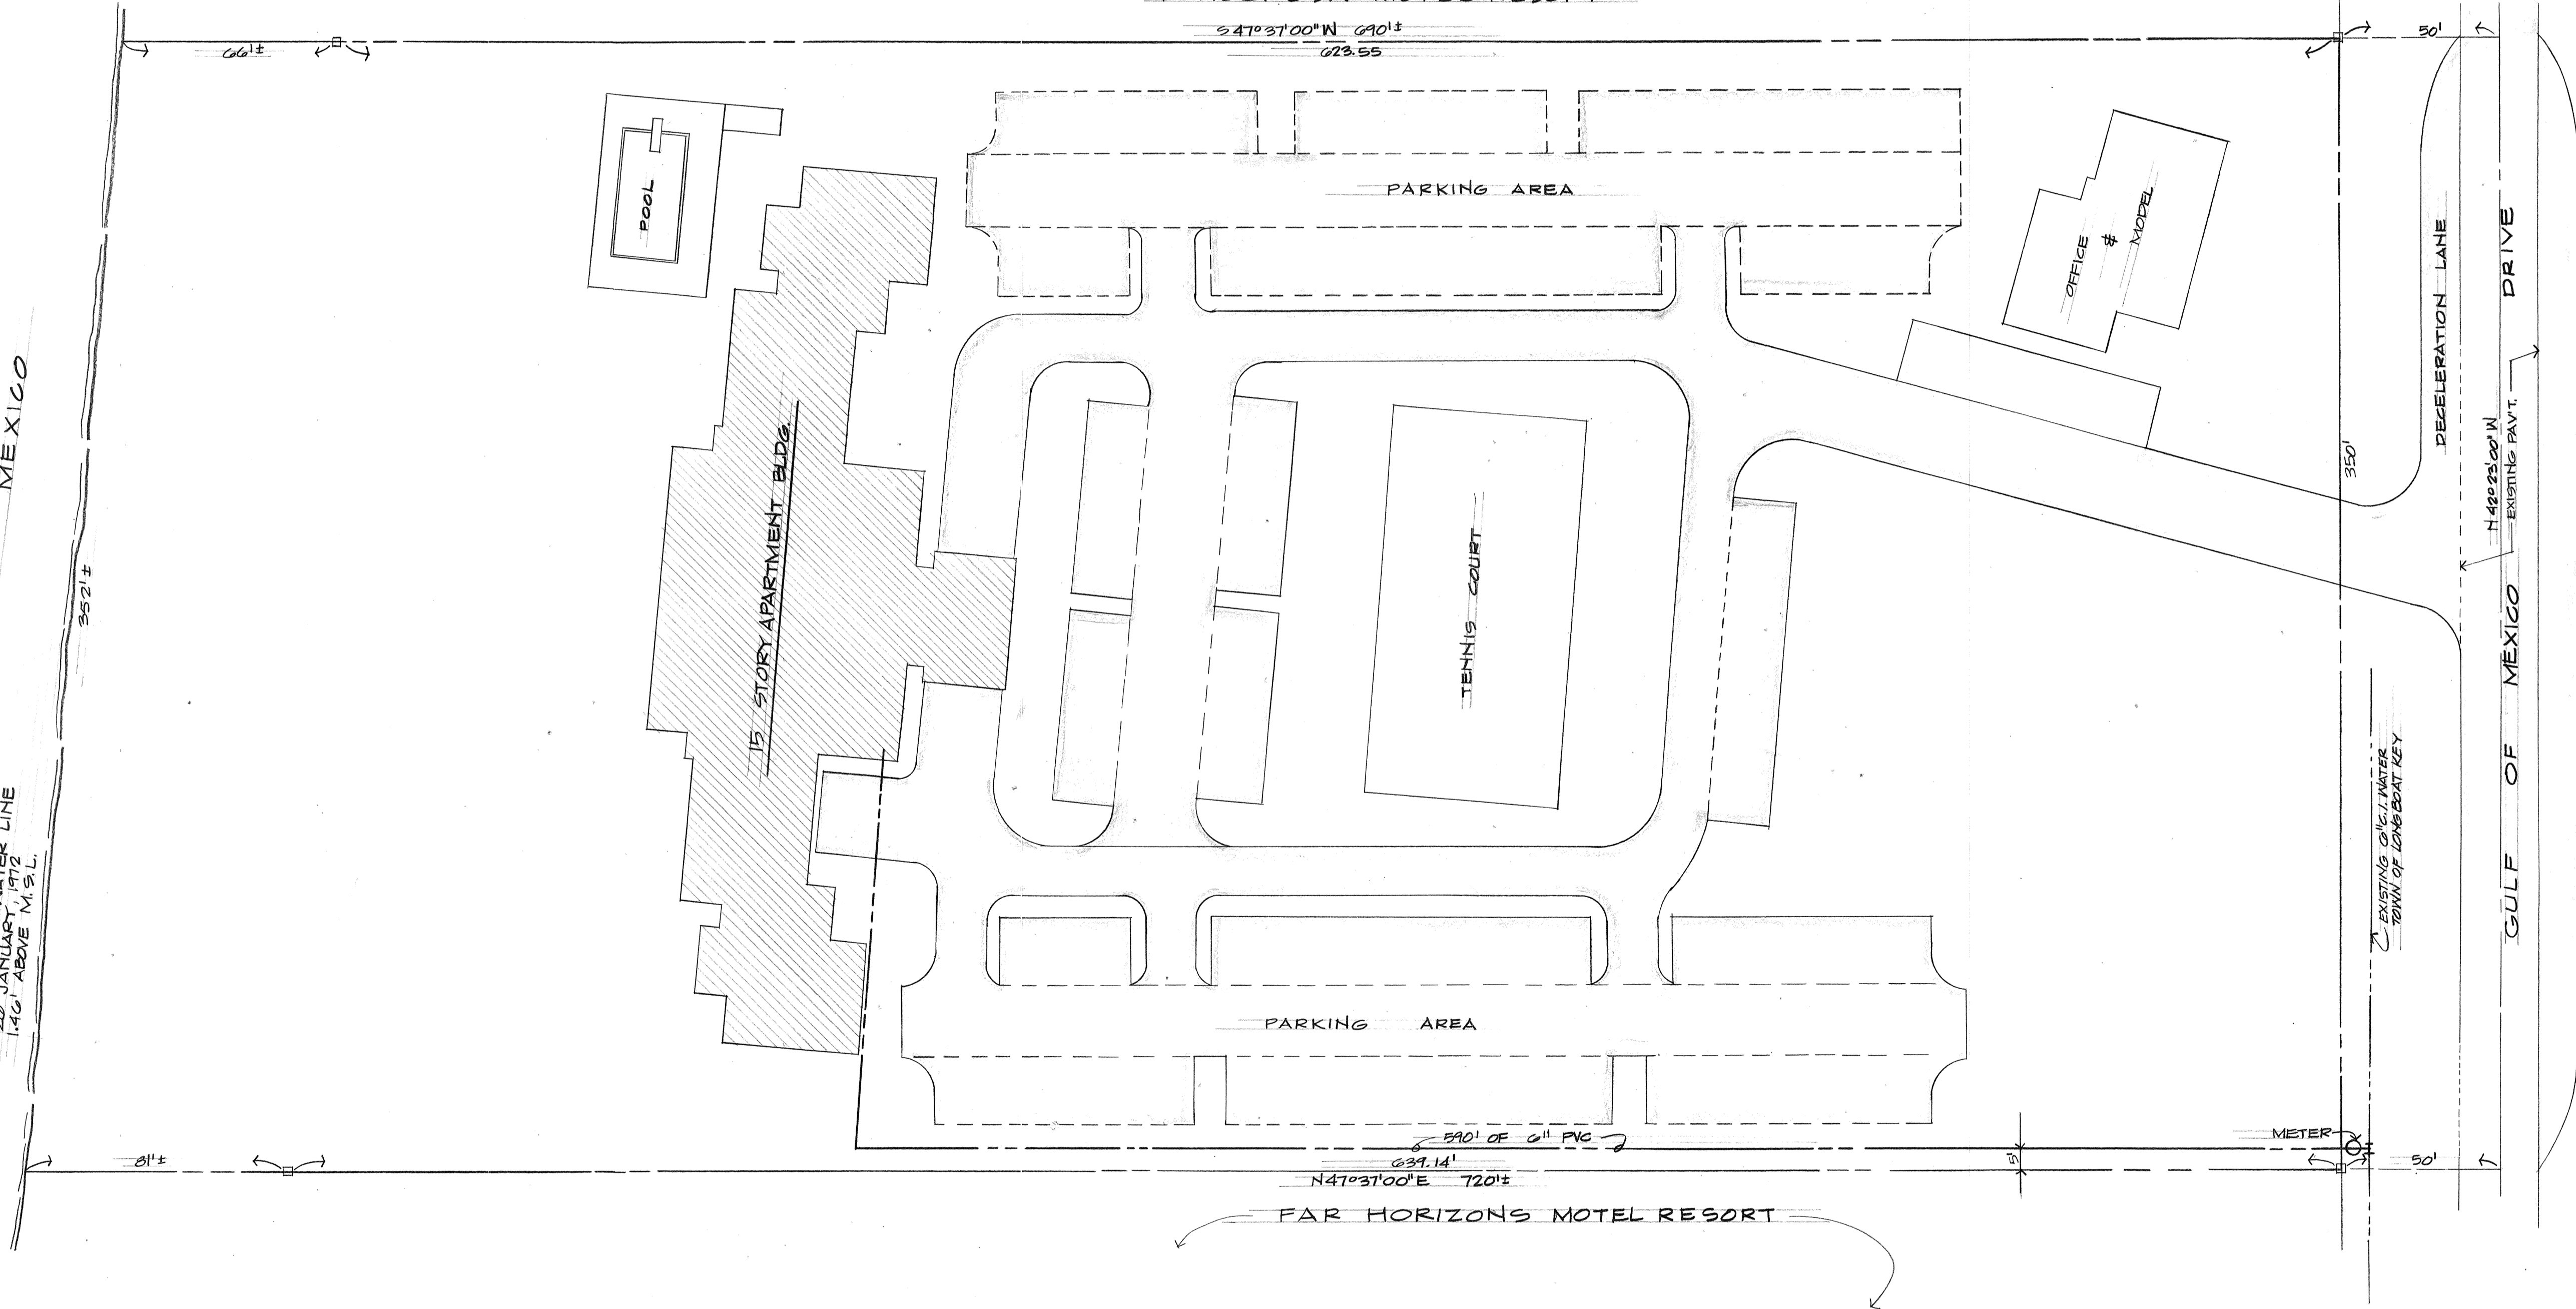

PONDEROSA MOTEL RESORT

FAR HORIZONS MOTEL RESORT

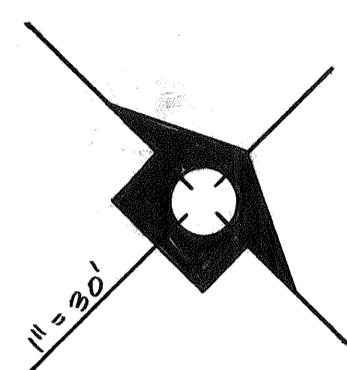

**SITE PLAN**  
 SHOWING "AS BUILT" WATER DISTRIBUTION SYSTEM

REVISION	SHEET NUMBER	ENGINEER & LOCATION	T.L.K. FILE NO.
		TOWN OF LONGBOAT KEY, FLORIDA	
		SEA GATE CLUB	
		GULF OF MEXICO DRIVE	
		SARASOTA, FLORIDA	
BY	DATE	LTR. DATE	DESIGNED BY
			PROJECT ENGINEER
BY	DATE	LTR. DATE	CHECKED BY
			PROJECT NO.
BY	DATE	LTR. DATE	DRAWN BY
BY	DATE	LTR. DATE	SCALE:
BY	DATE	LTR. DATE	REVISION